


FED. ROAD DIST. NO.	STATE	PROJ. NO.	FISCAL YEAR	SHEET NO.	TOTAL SHEETS
HAWAII	HAW.	HWY-H-04-04M	2005	3	6

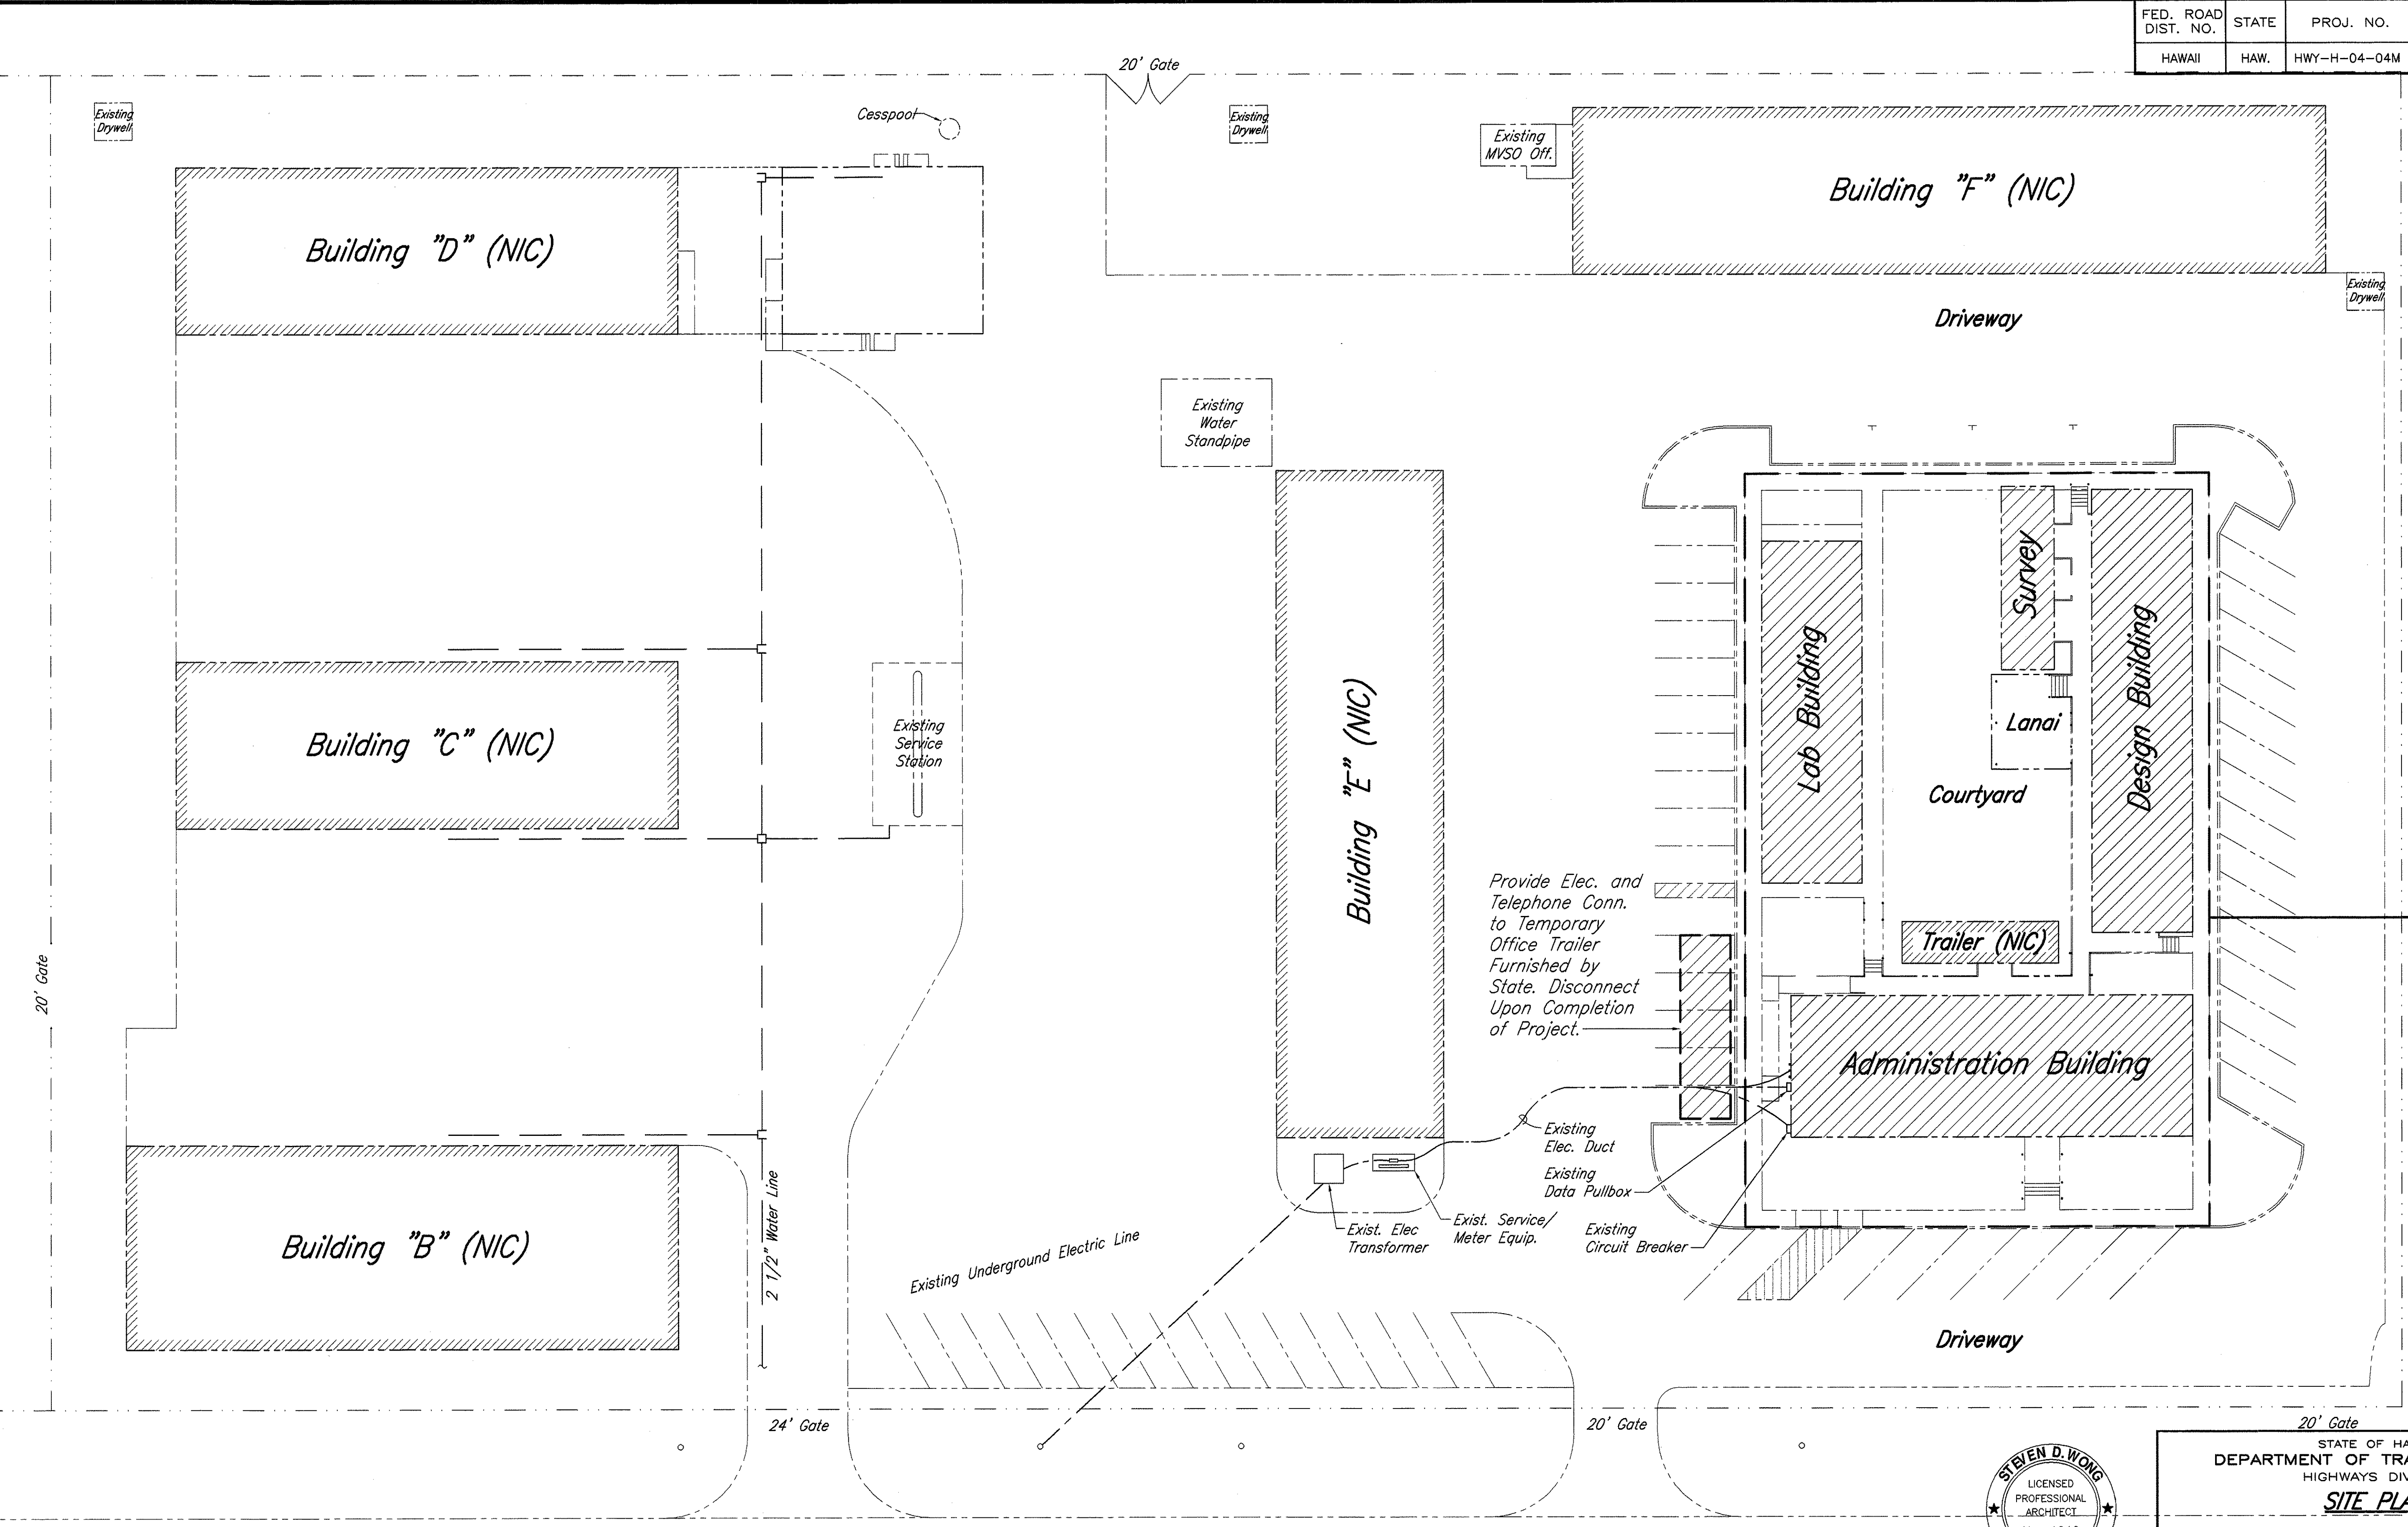


PROJECT BUILDINGS
SEE SHT. A-2
for FLOOR PLANS

ORIGINAL PLAN	DATE
DESIGNED BY	
CHECKED BY	
NO.	

MAKAALA STREET

SITE PLAN
SCALE: 1"=20'-0"

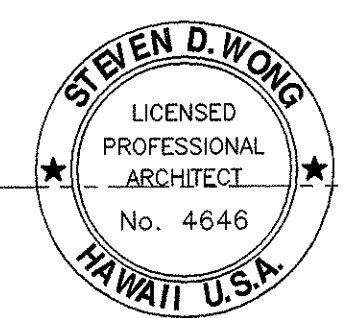


THIS WORK WAS PREPARED BY
ME OR UNDER MY SUPERVISION
Steven D. Wong
MITSUNAGA & ASSOCIATES

STATE OF HAWAII
DEPARTMENT OF TRANSPORTATION
HIGHWAYS DIVISION
SITE PLAN

HILO BASEYARD RENOVATIONS
REPLACE EXISTING ASBESTOS
FLOOR TILES and CARPET
Project No. HWY-H-04-04M
Scale: As Noted Date: March 9, 2005

SHEET No. A-1 OF 6 SHEETS

FED. ROAD DIST. NO.	STATE	PROJ. NO.	FISCAL YEAR	SHEET NO.	TOTAL SHEETS
HAWAII	HAW.	HWY-H-04-04M	2005	4	6

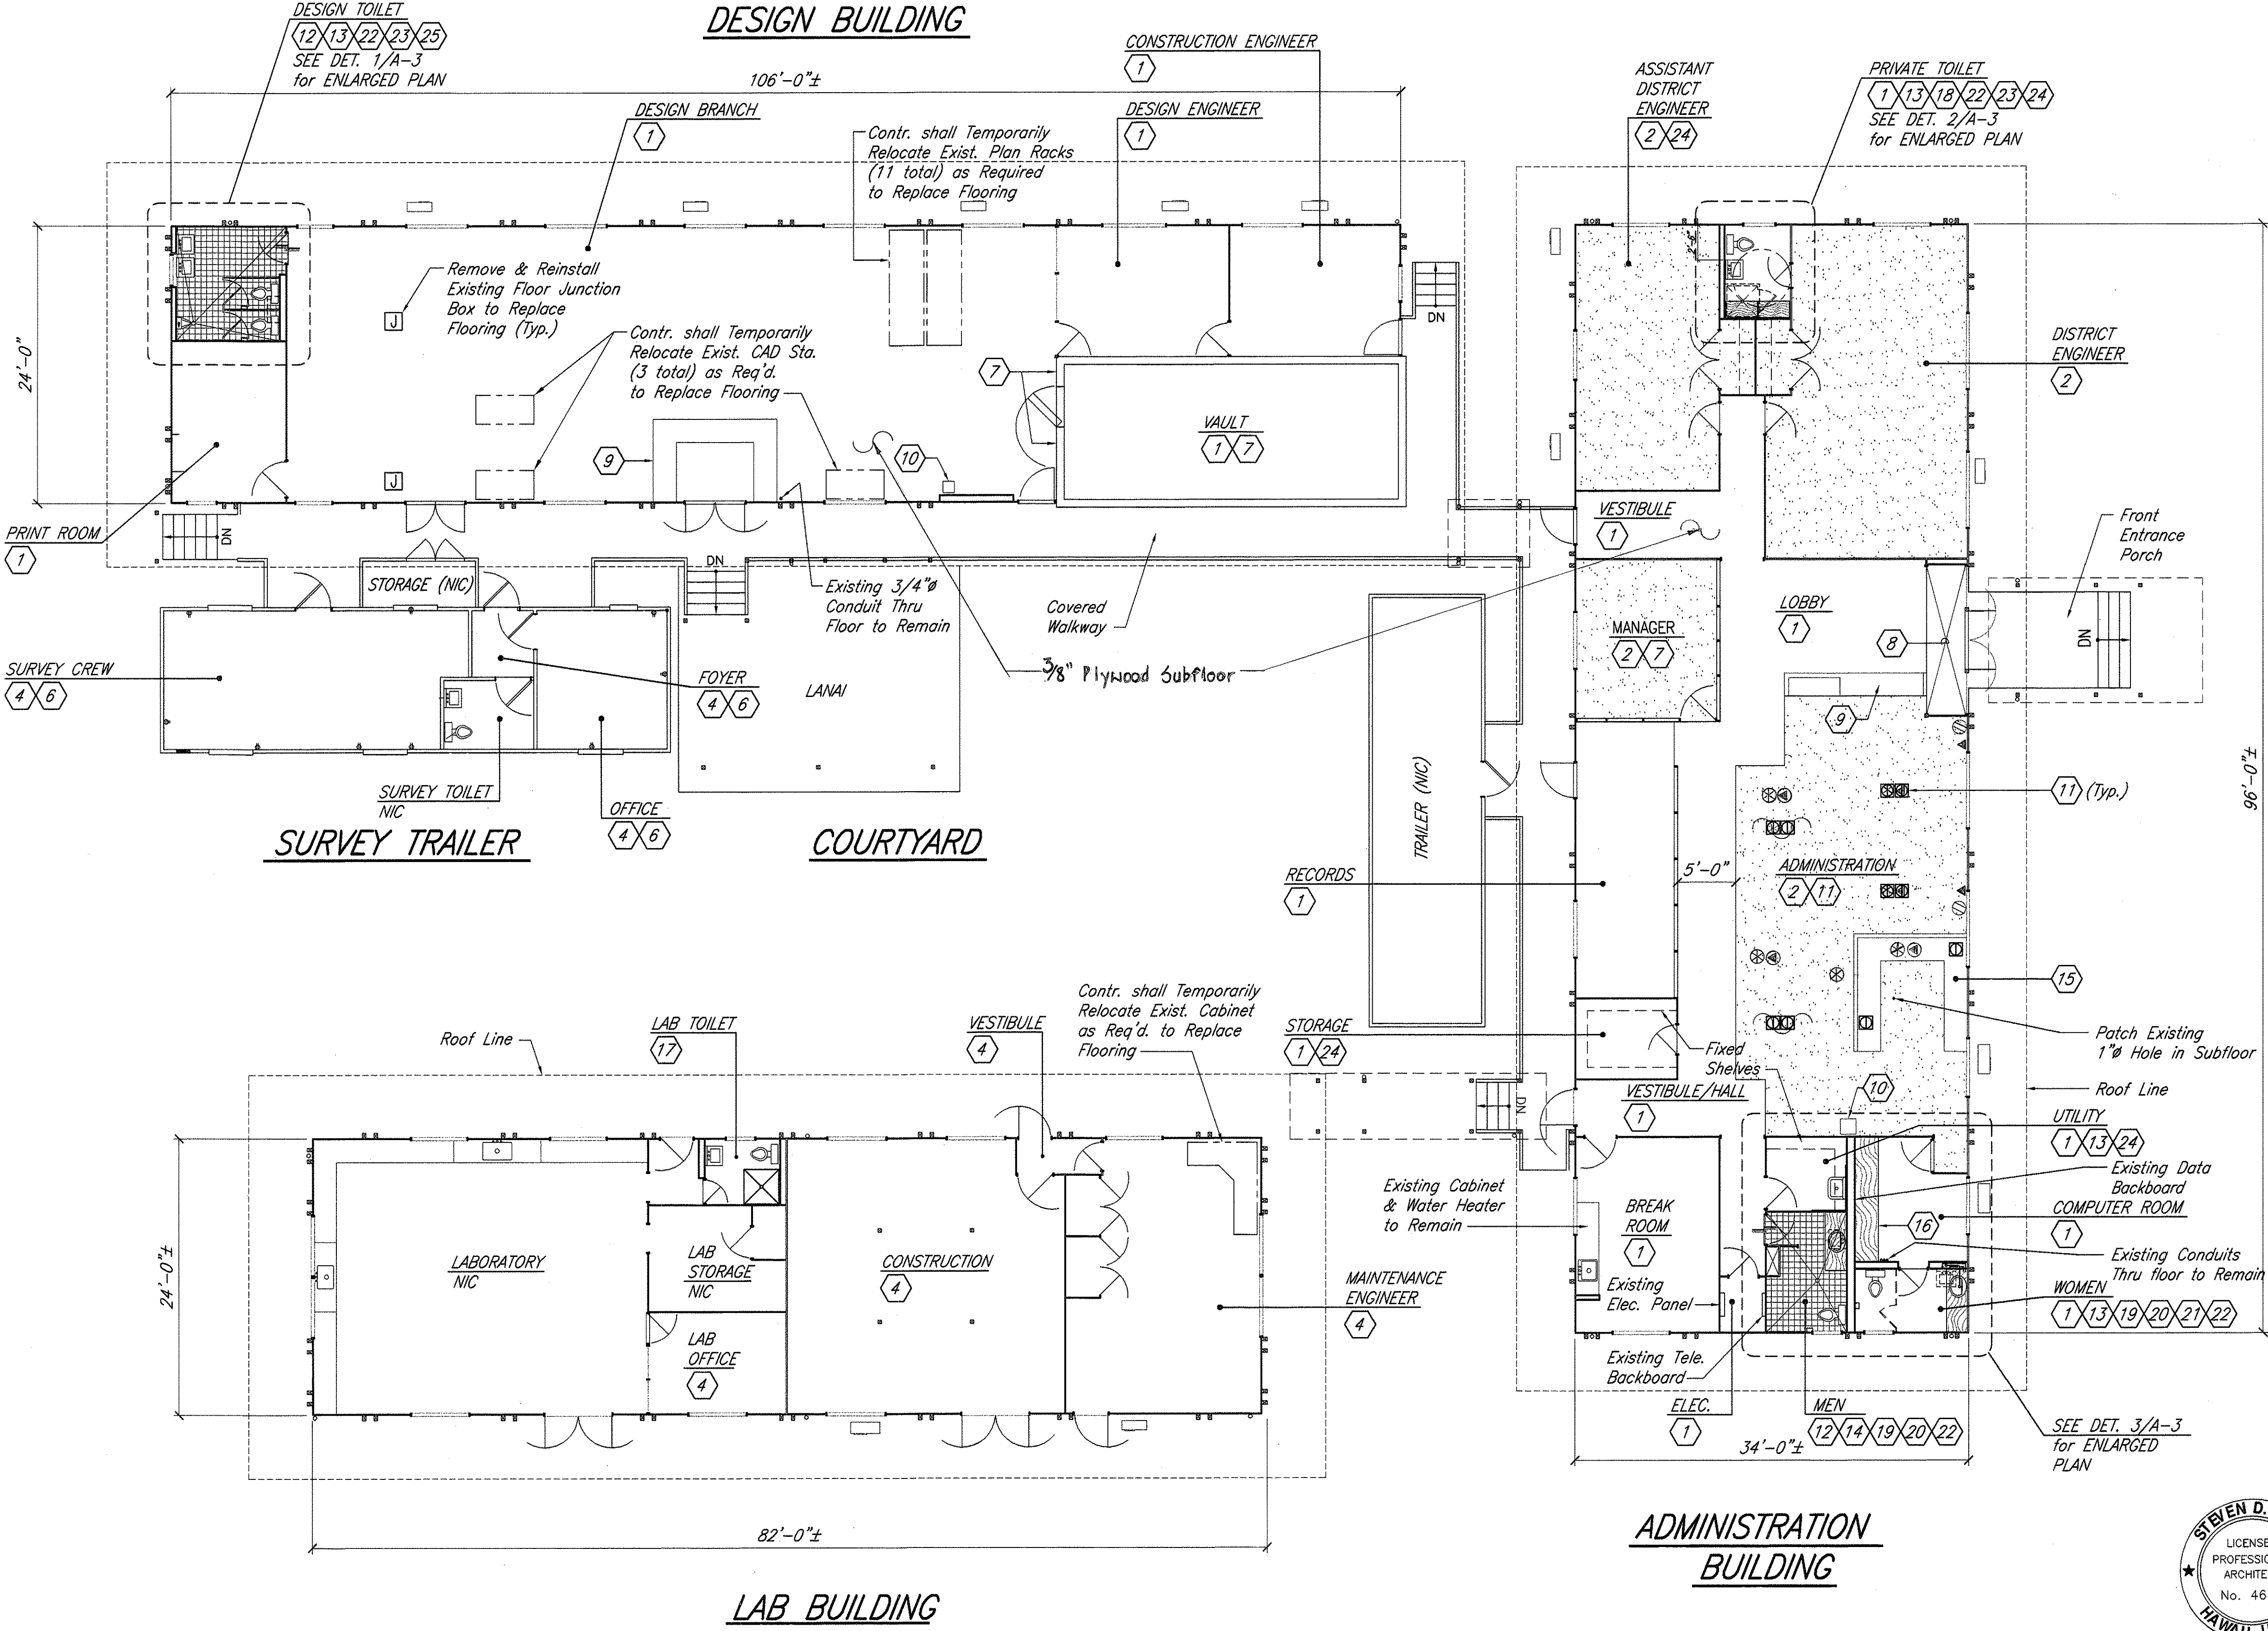

- SCOPE OF WORK KEY:**
- REMOVE 2 LAYERS OF EXISTING FLOORING - VINYL COMPOSITION TILE (VCT) ADHERED TO VINYL ASBESTOS TILE (VAT). PREPARE EXISTING PLYWOOD SUBFLOOR AND INSTALL NEW VCT FLOORING.
 - REMOVE 2 LAYERS OF EXISTING FLOORING - CARPET ADHERED TO VINYL ASBESTOS TILE (VAT). PREPARE EXISTING PLYWOOD SUBFLOOR AND INSTALL NEW CARPET FLOORING.
 - NOT USED
 - REMOVE EXISTING VCT FLOORING AND REPLACE WITH NEW VCT FLOORING.
 - NOT USED
 - REMOVE EXISTING 1/4"x1/2" WOOD BASE AND REPLACE WITH NEW MATCHING WOOD BASE.
 - ADD NEW RUBBER WALL BASE.
 - RAISE EXISTING SUBFLOOR LEVEL TO MATCH LOBBY SUBFLOOR AND ADD NEW VCT FLOORING.
 - REMOVE AND REINSTALL EXISTING SERVICE COUNTER TO REPLACE FLOORING.
 - REMOVE AND REINSTALL EXISTING ELECTRIC WATER COOLER TO REPLACE FLOORING.
 - REMOVE AND REINSTALL EXISTING RAISED FLOOR OUTLETS TO REPLACE FLOORING (TYP.).
 - REMOVE EXISTING CERAMIC TILE FLOOR, INCLUDING MORTAR SETTING BED & WATERPROOFING AND REPLACE WITH NEW, SEE DETAIL 3/A-4.
 - REMOVE EXISTING THIN-SET CERAMIC TILE 4' HIGH WAINSCOT, PREPARE THE EXISTING BASE MATERIAL AND INSTALL NEW 4' HIGH FIBERGLAS REINFORCED PLASTIC (FRP) PANEL WAINSCOT, SEE DETAIL 3/A-4.
 - REMOVE EXISTING VINYL WAINSCOT AND RUBBER BASE AND REPLACE WITH NEW FRP WAINSCOT, SEE DETAIL 3/A-4.
 - REMOVE AND REINSTALL EXISTING CUBICLE WORK COUNTERS TO REPLACE FLOORING.
 - EXISTING BUILT-IN STORAGE CABINET/COUNTER TO BE REMOVED AND REINSTALLED BY OTHERS. REMOVE ASBESTOS TILES BELOW STORAGE CABINET AND REPLACE FLOORING.
 - REMOVE AND REPLACE EXISTING PREFABRICATED SHOWER STALL.
 - REMOVE EXISTING PREFABRICATED SHOWER STALL, CAP PLUMBING, AND ADD NEW SHELVING UNIT. SEE DETAIL 2/A-4.
 - REMOVE EXISTING LAV AND ADD NEW LAV WITH COUNTER AND BASE CABINET.
 - REPLACE EXISTING MIRROR.
 - ADD NEW SARGENT "485 DEADBOLT" LOCK AND "281-0 DOOR CLOSER".
 - REMOVE AND REPLACE EXISTING WATER CLOSET WITH NEW.
 - REMOVE AND REPLACE EXISTING LAVATORY WITH NEW.
 - REMOVE AND REINSTALL EXISTING CLOSET SHELVES AS REQUIRED.
 - REMOVE AND REPLACE EXISTING URINAL WITH NEW.

ORIGINAL PLAN	DATE
NO.	
SURVEY PLOTTED BY	
DRAWN BY	
TRACED BY	
QUANTITIES BY	
CHECKED BY	

FLOOR PLAN
Scale: 1/8"=1'-0"



THIS WORK WAS PREPARED BY
ME OR UNDER MY SUPERVISION
Steven D. Wong
MITSUNAGA & ASSOCIATES






STATE OF HAWAII
DEPARTMENT OF TRANSPORTATION
HIGHWAYS DIVISION
FLOOR PLAN

**HILO BASEYARD RENOVATIONS
REPLACE EXISTING ASBESTOS
FLOOR TILES and CARPET**
Project No. HWY-H-04-04M
Scale: As Noted Date: March 9, 2005

SHEET No. **A-2** OF **6** SHEETS

"AS-BUILT"

FED. ROAD DIST. NO.	STATE	PROJ. NO.	FISCAL YEAR	SHEET NO.	TOTAL SHEETS
HAWAII	HAW.	HWY-H-04-04M	2005	5	6

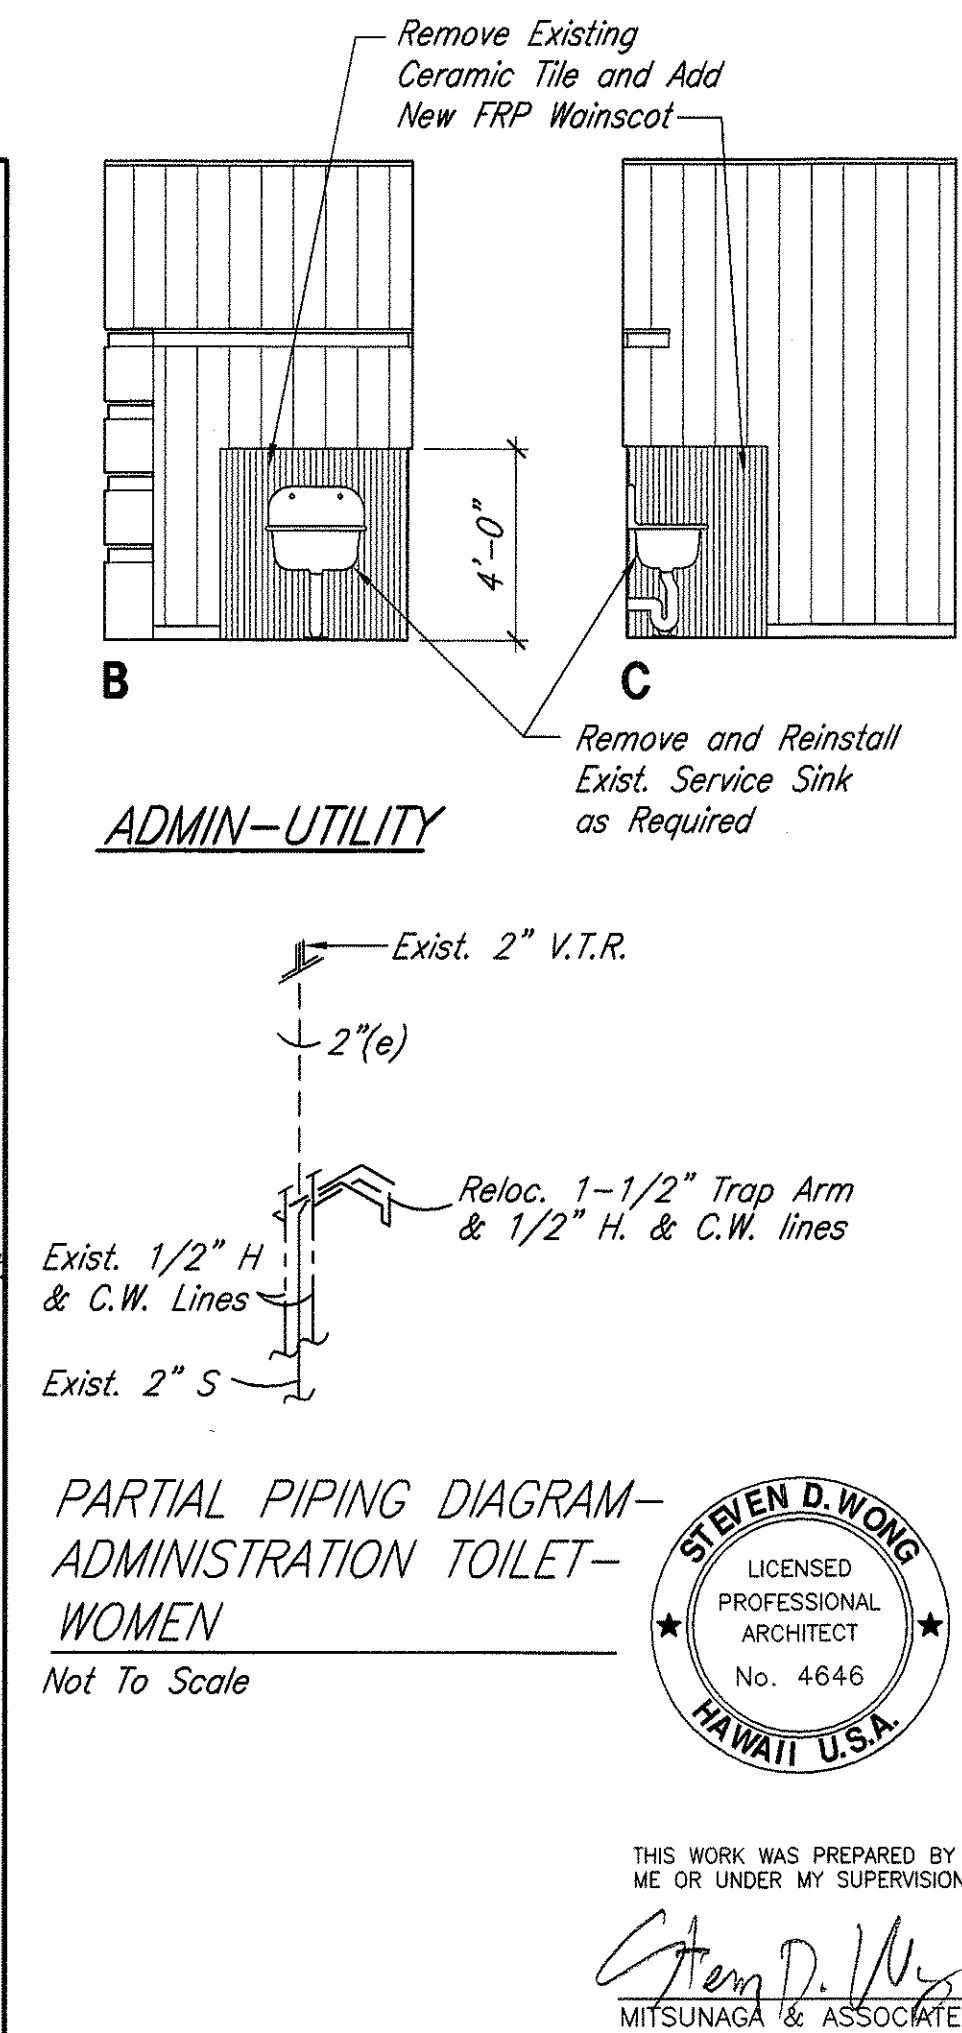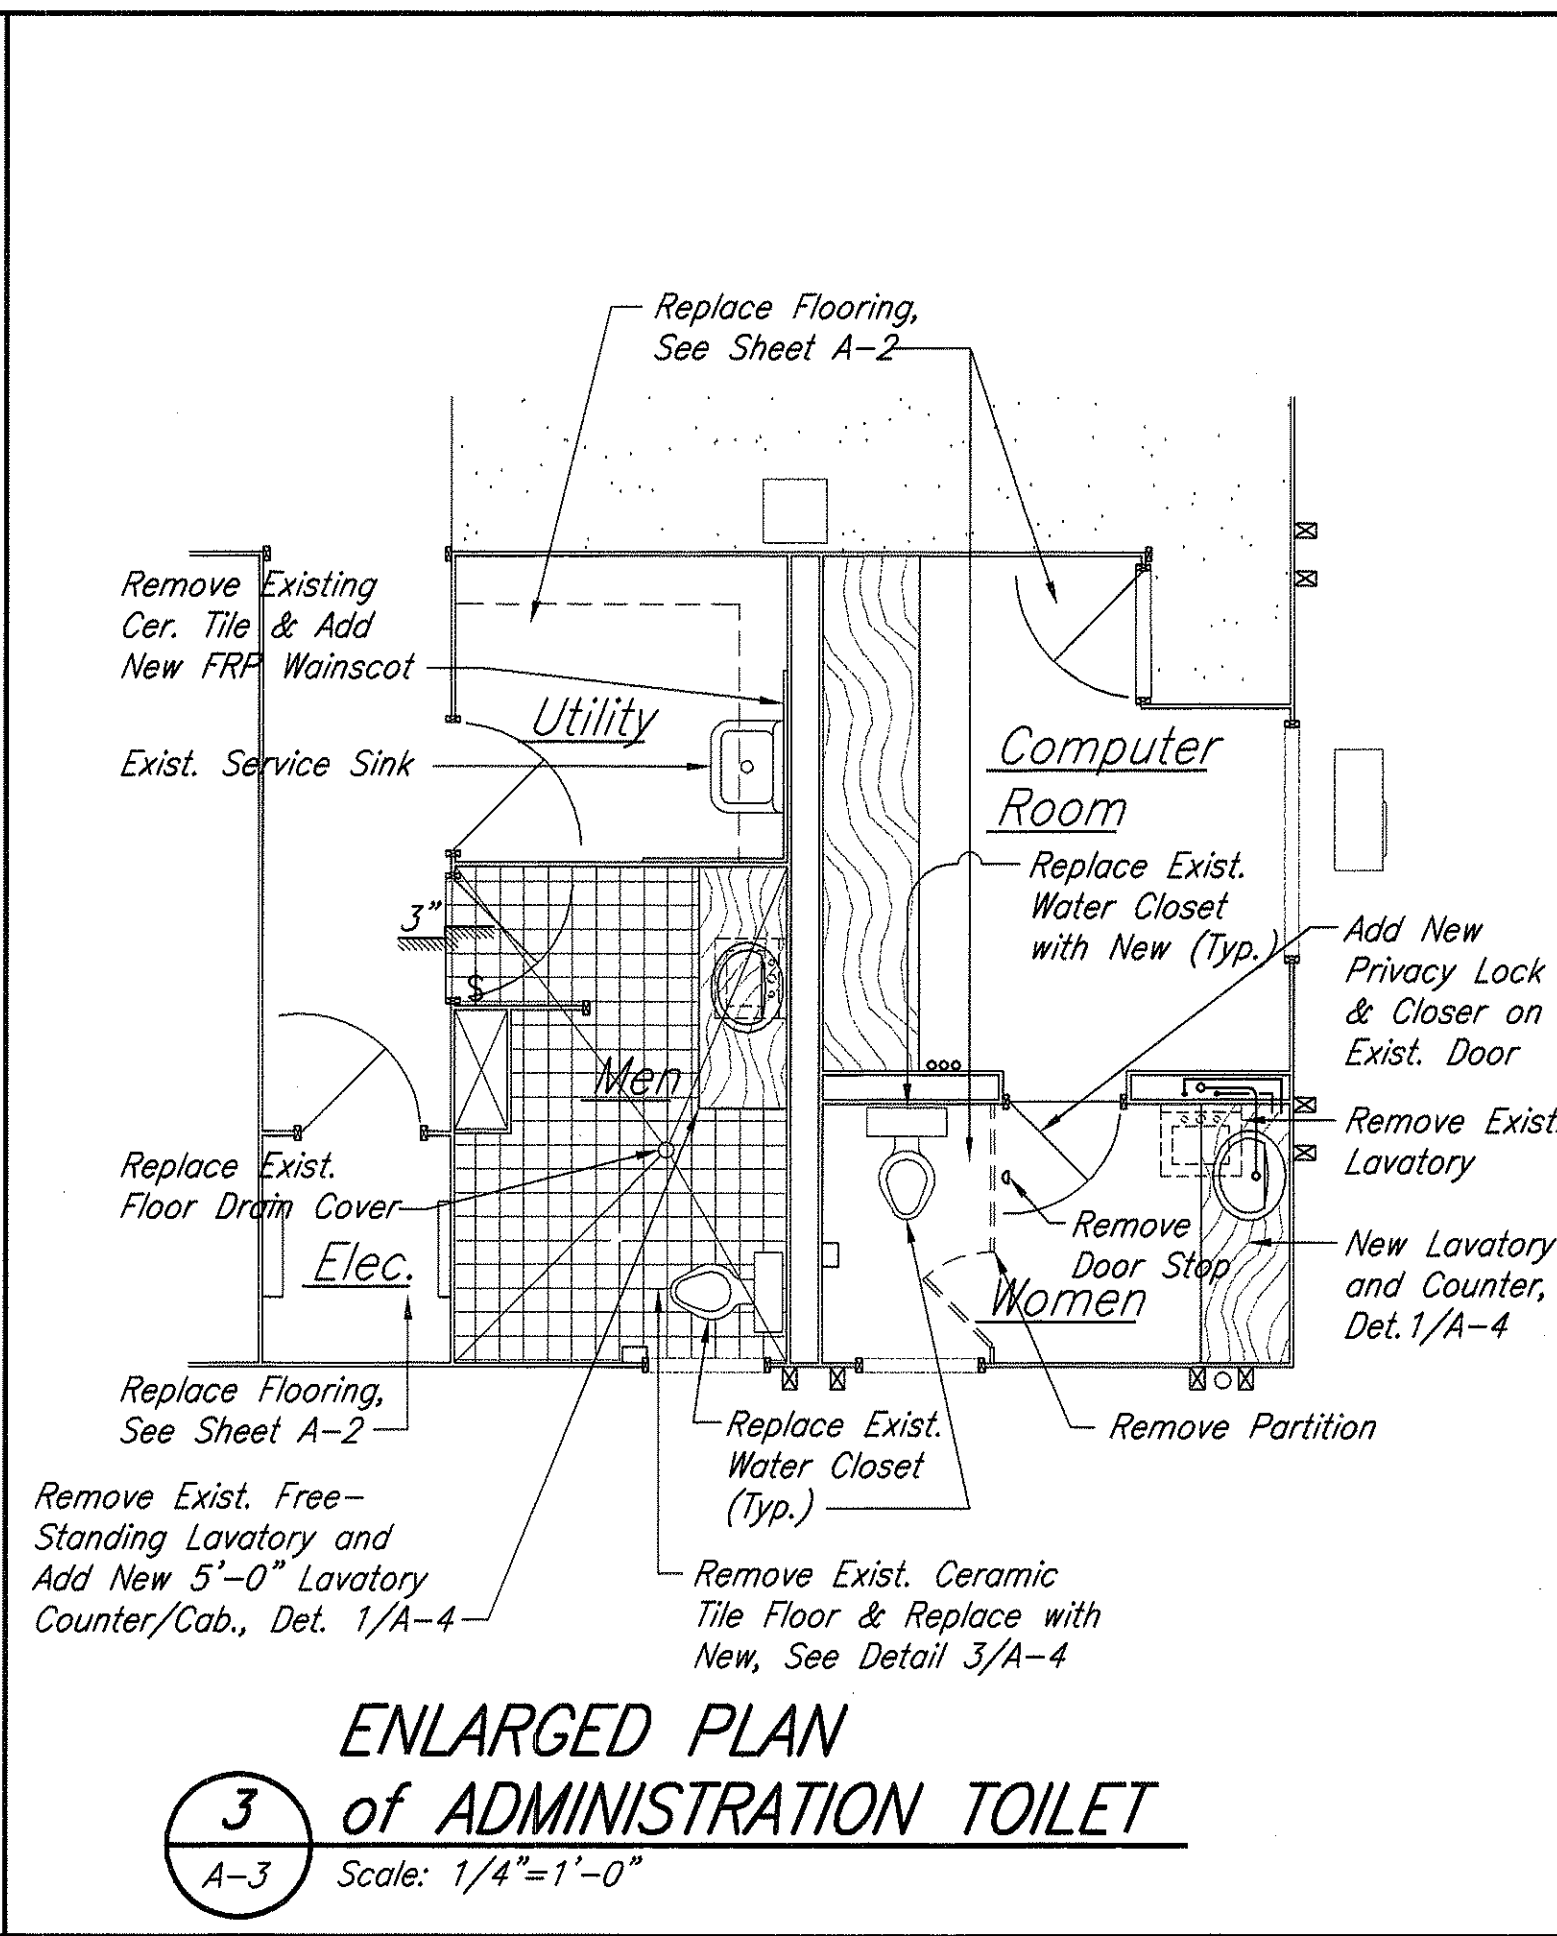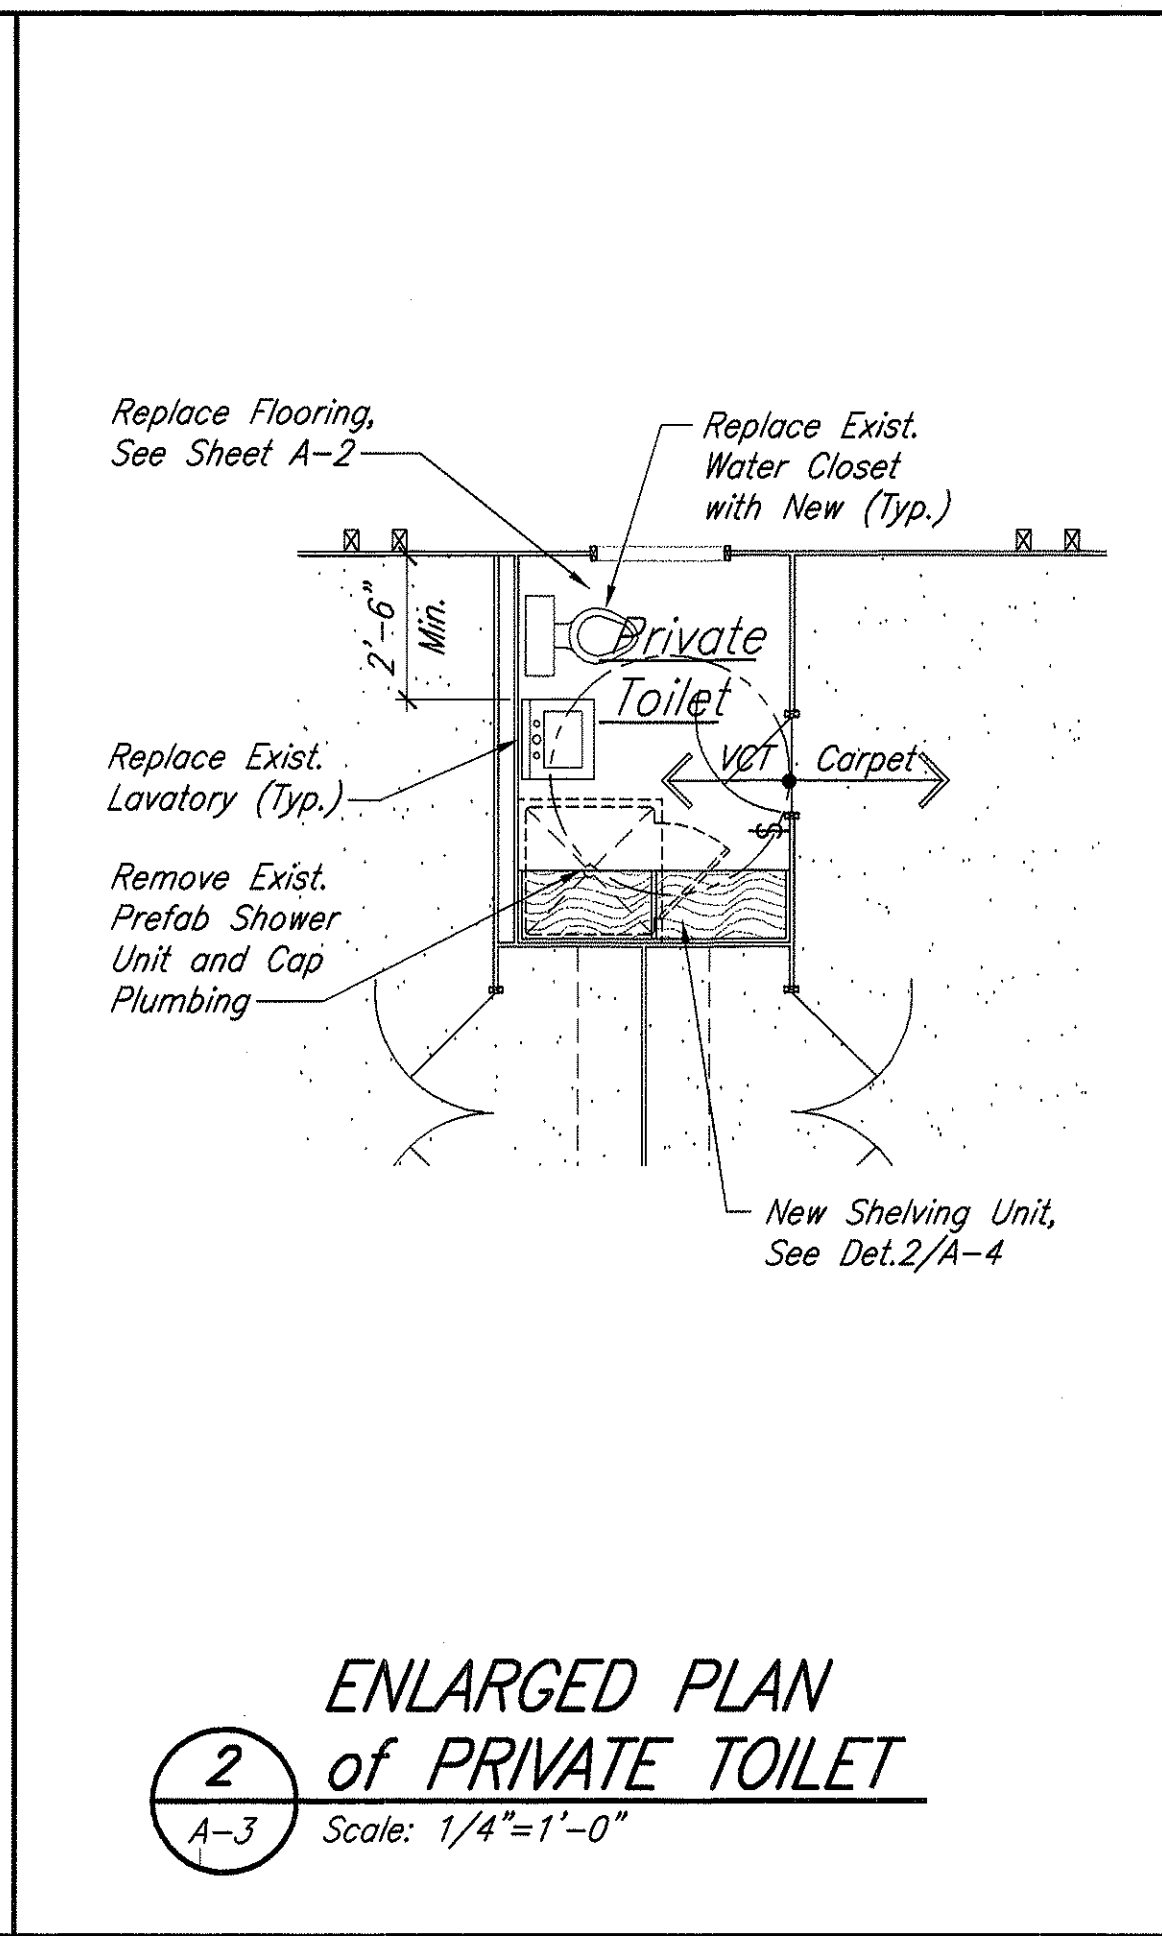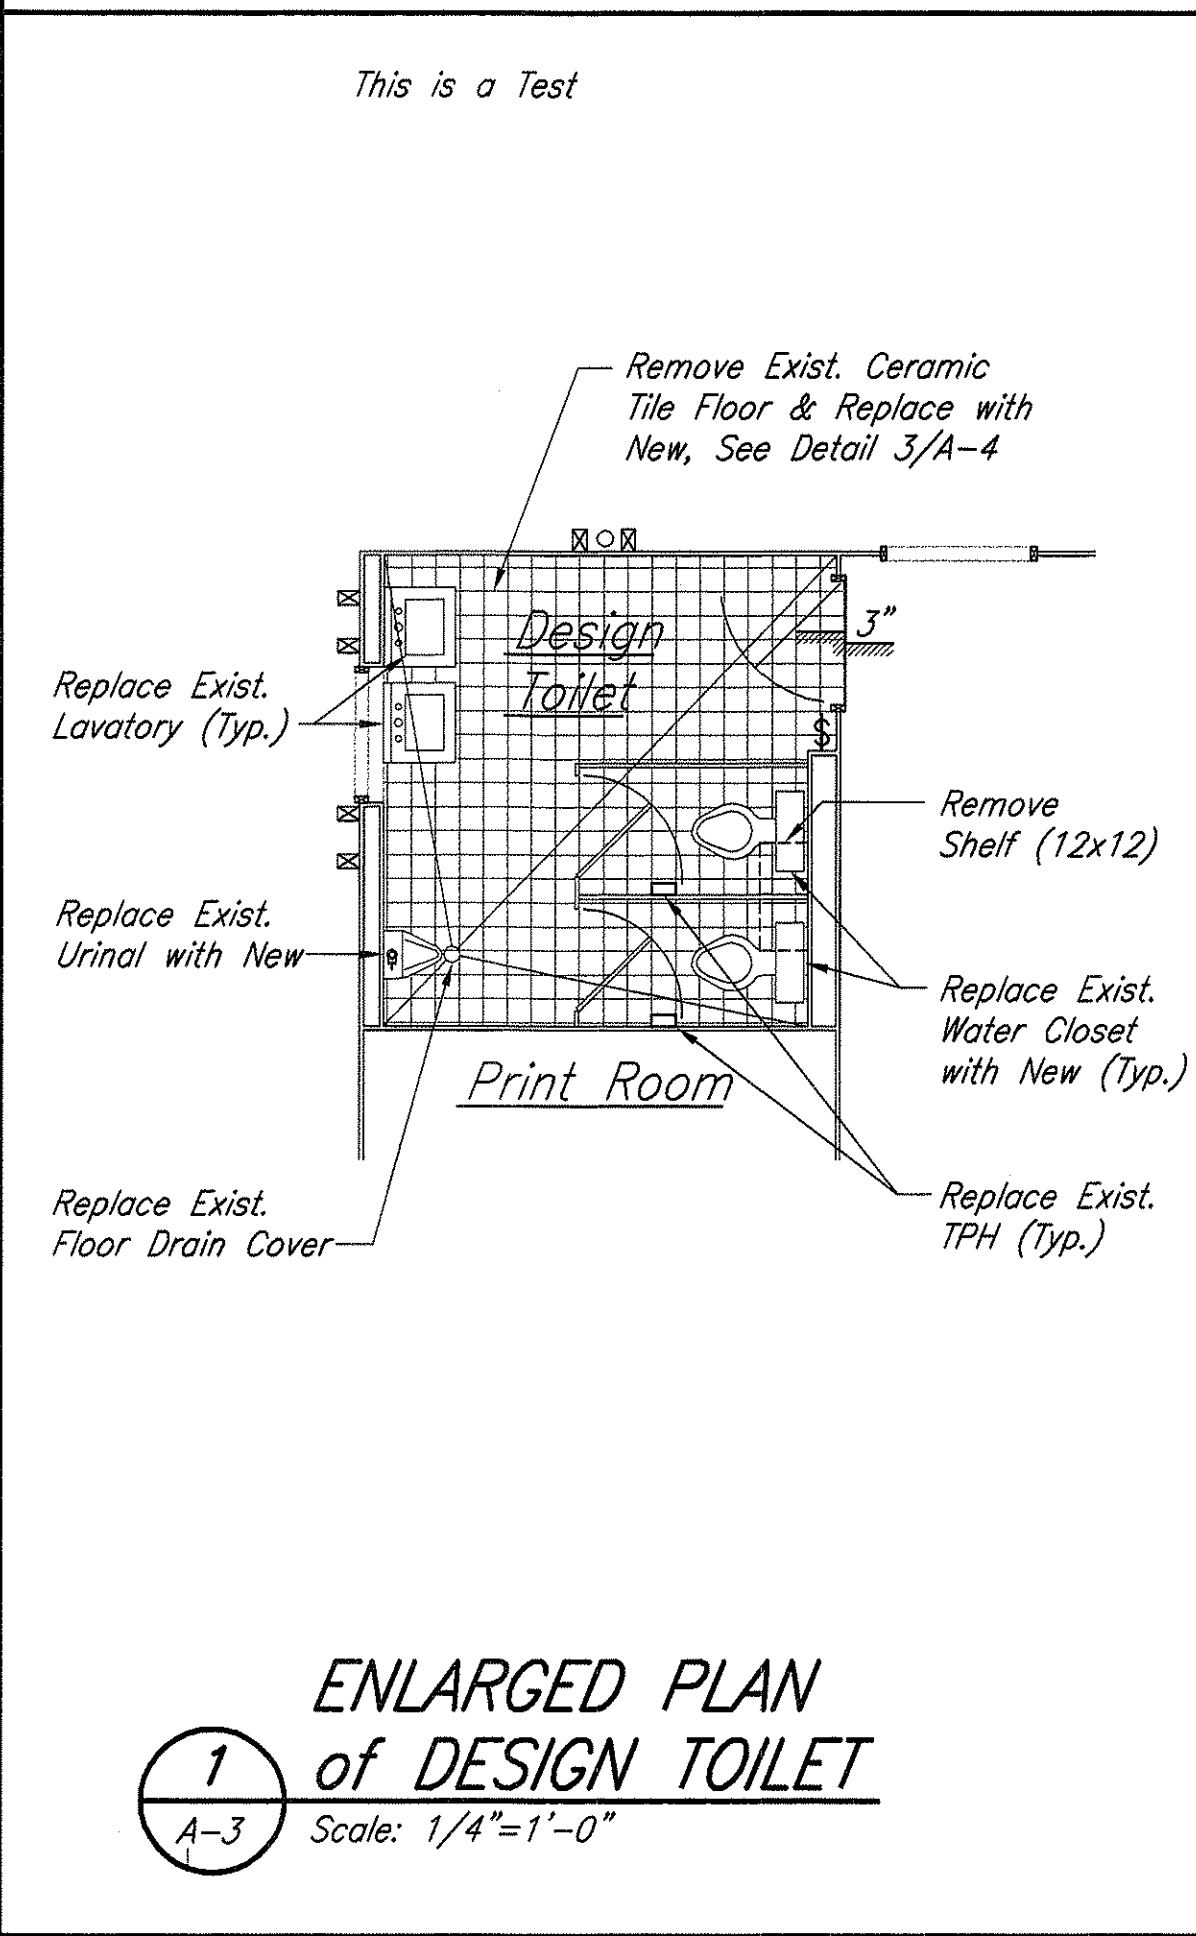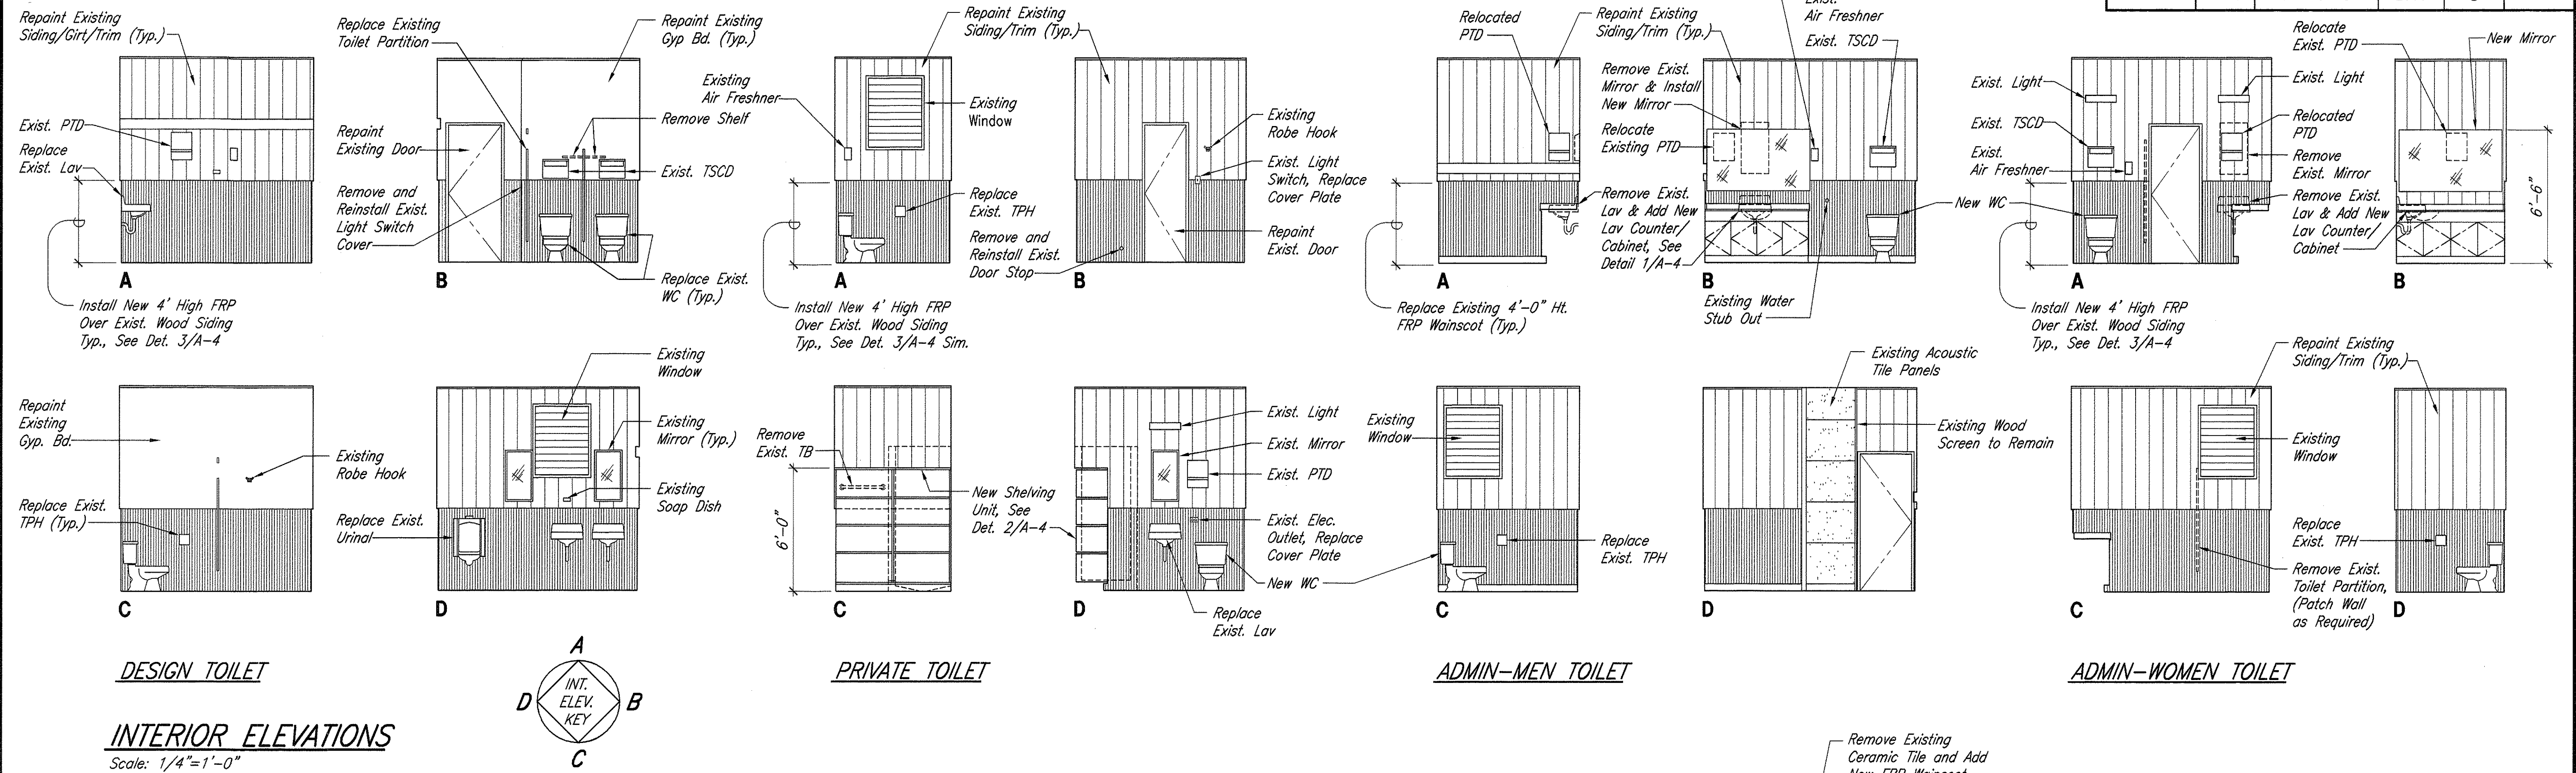

STATE OF HAWAII
DEPARTMENT OF TRANSPORTATION
HIGHWAYS DIVISION


DETAILED TOILET PLANS
INTERIOR ELEVATIONS, DETAILS
HILO BASEYARD RENOVATIONS
REPLACE EXISTING ASBESTOS
FLOOR TILES and CARPET
Project No. HWY-H-04-04M

Scale: As Noted Date: March 9, 2005


SHEET No. A-3 OF 6 SHEETS

SURVEY PLOTTED BY	DATE
DRAWN BY	
DESIGNED BY	
QUANTITIES BY	
CHECKED BY	
ORIGINAL PLAN	
NOTE BOOK	
No.	


FED. ROAD DIST. NO.	STATE	PROJ. NO.	FISCAL YEAR	SHEET NO.	TOTAL SHEETS
HAWAII	HAW.	HWY-H-04-04M	2005	6	6

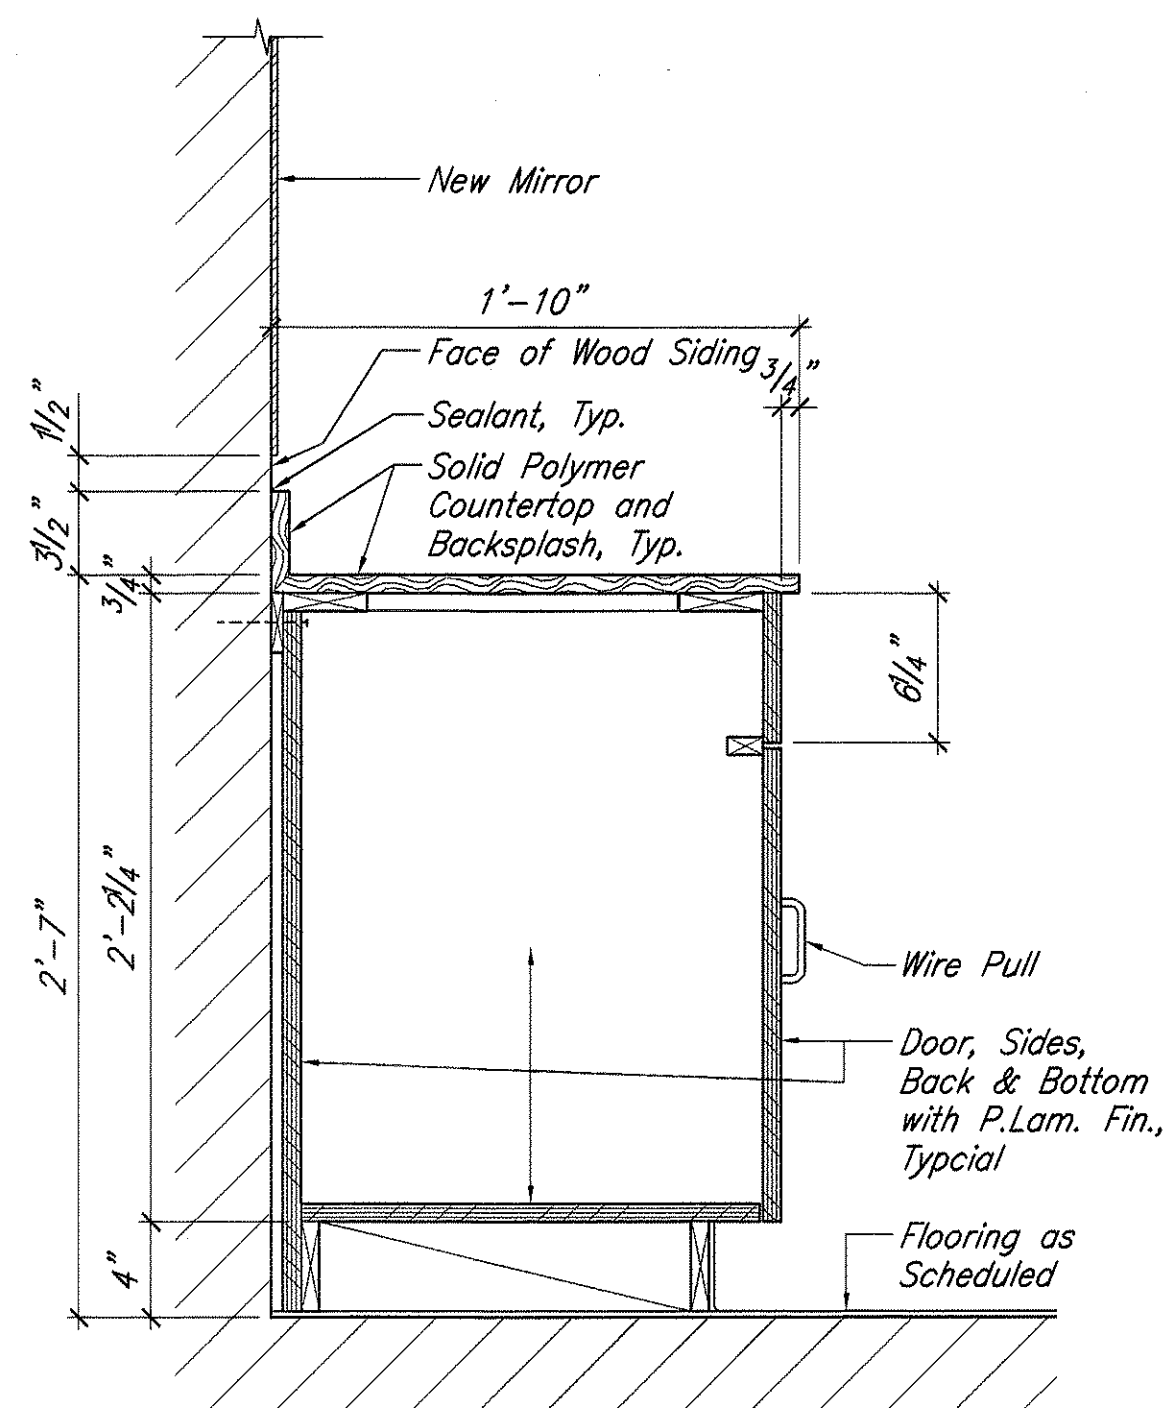


1 TYPICAL BASE CABINET
A-4 Scale: 1 1/2"=1'-0"

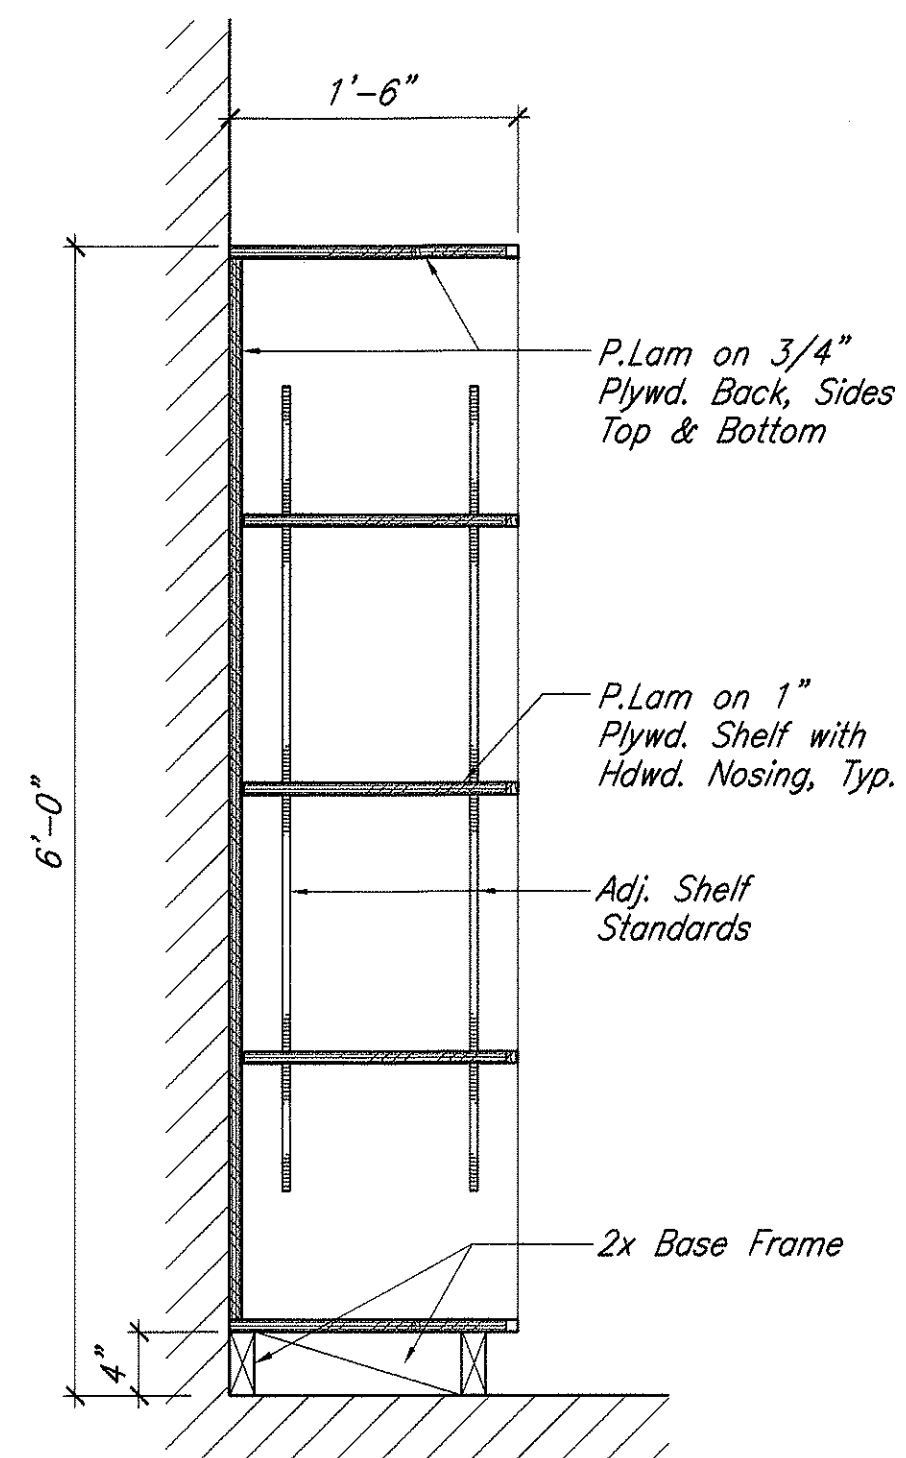

2 STORAGE SHELVING UNIT
A-4 Scale: 1"=1'-0"

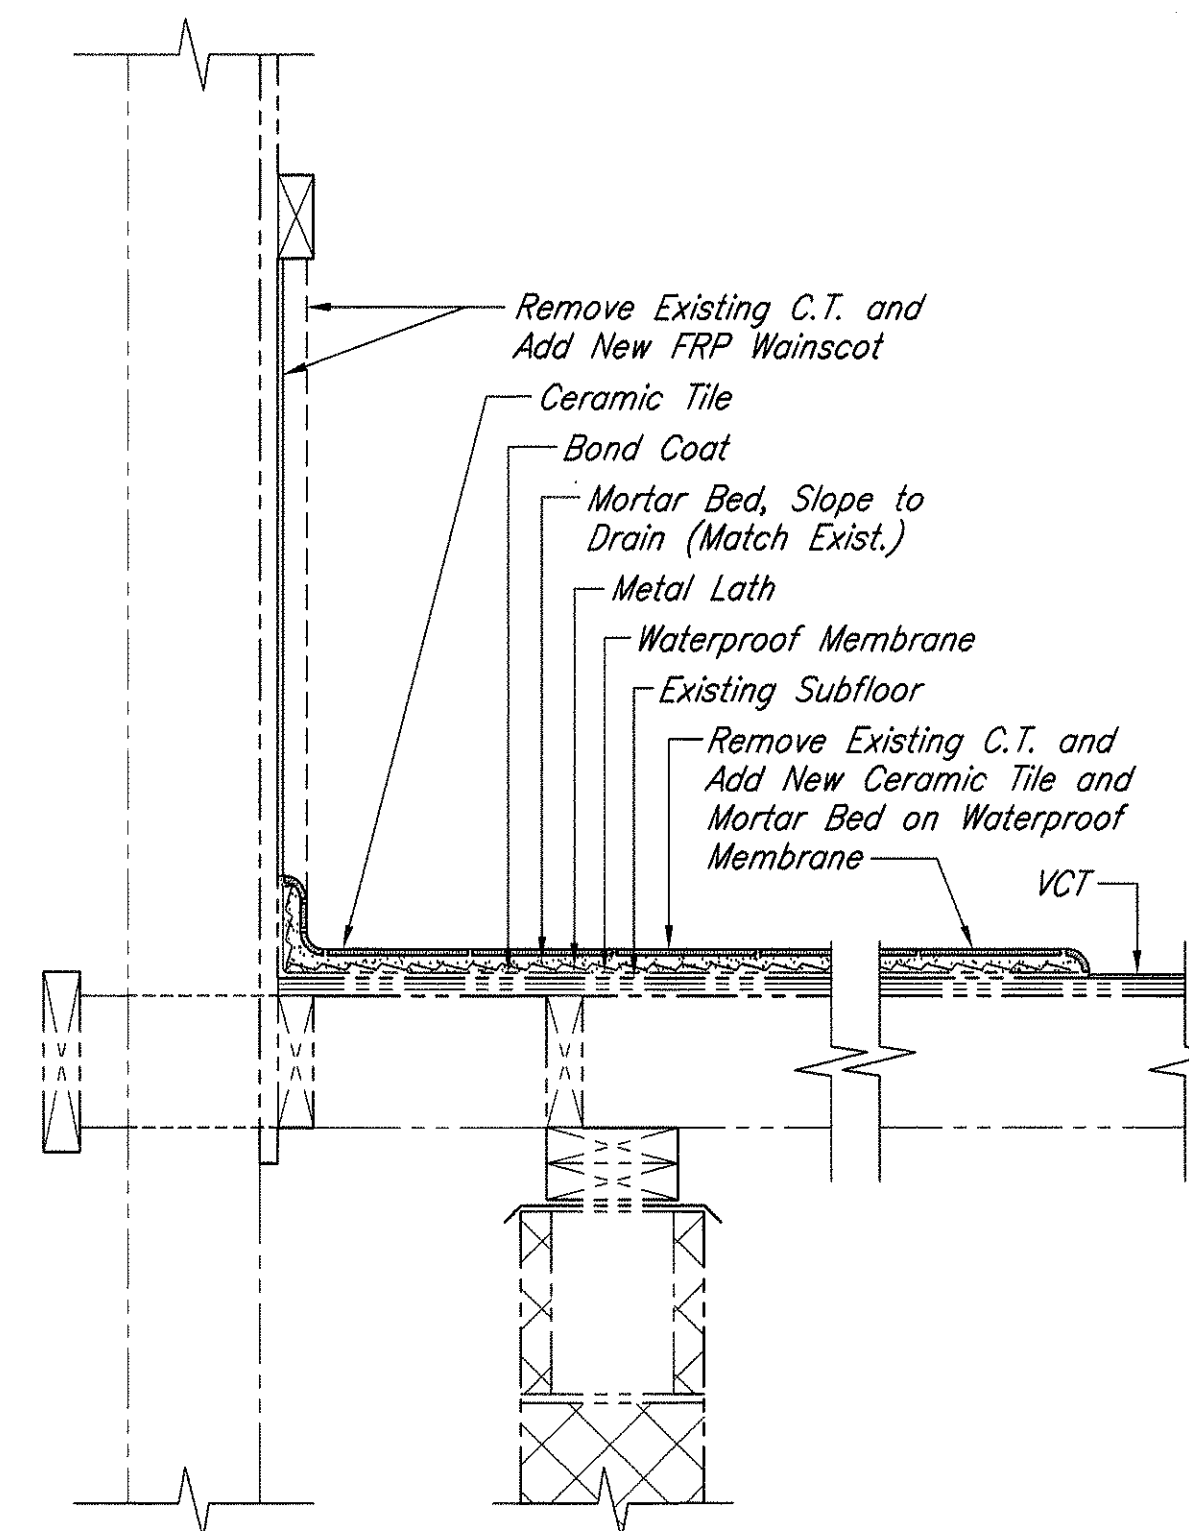

3 CERAMIC TILE FLOOR/FRP WAINSCOT
A-4 Sc: 1 1/2"=1'-0"

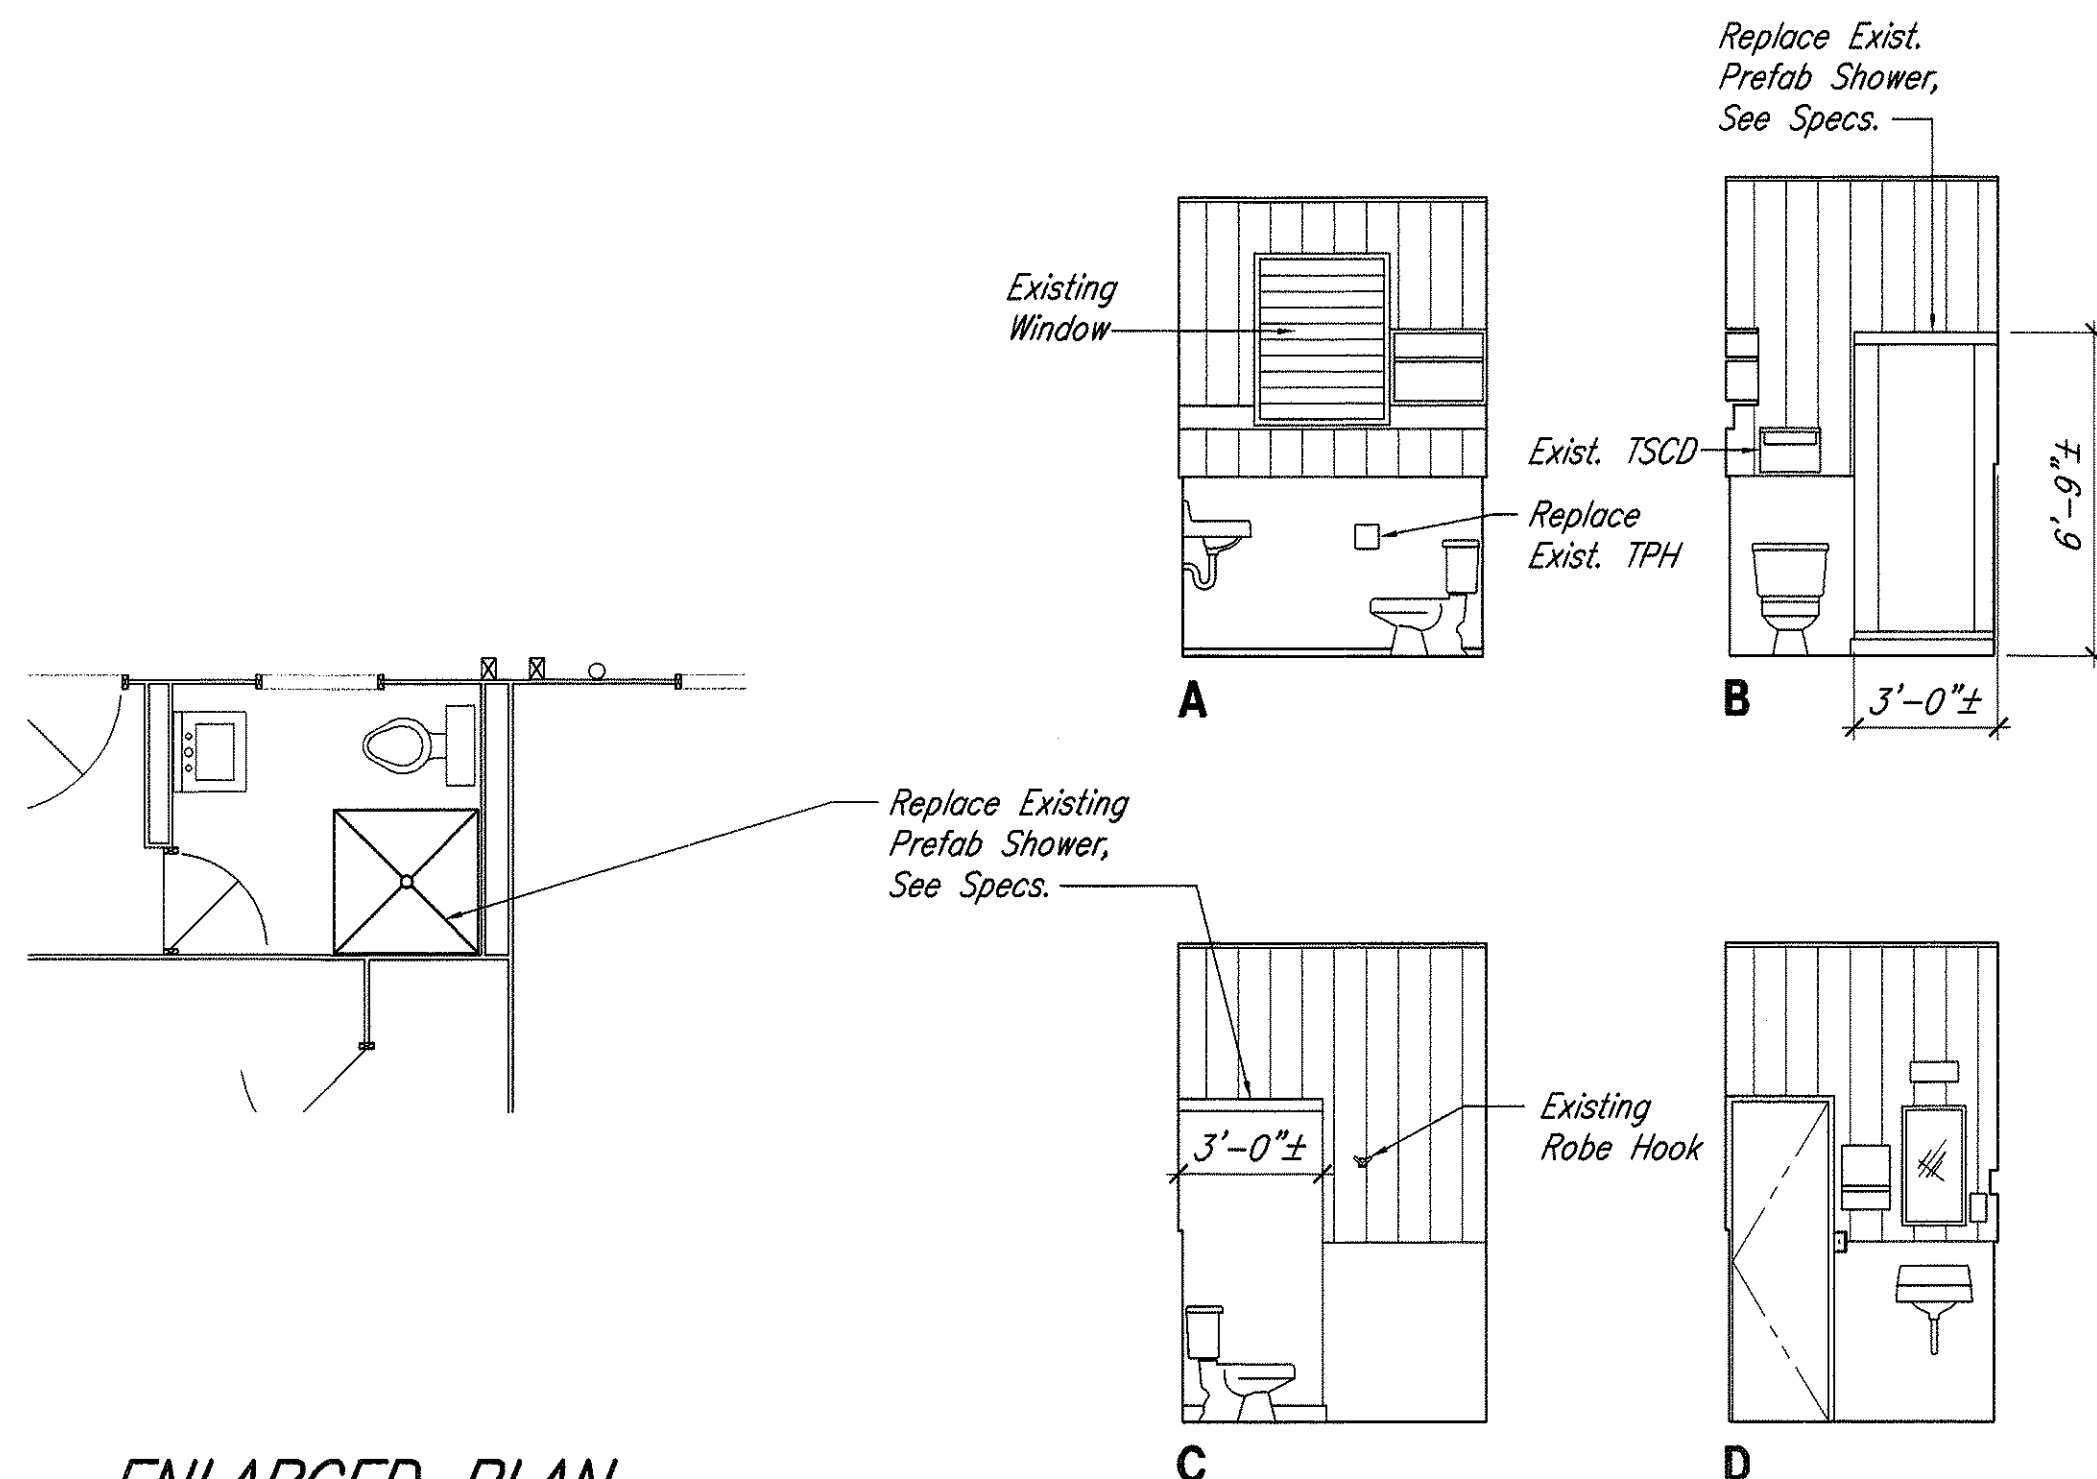

A ENLARGED PLAN of LAB TOILET
A-4 Scale: 1/4"=1'-0"

LAB-TOILET



THIS WORK WAS PREPARED BY
ME OR UNDER MY SUPERVISION
Steven D. Wong
MITSUNAGA & ASSOCIATES

STATE OF HAWAII
DEPARTMENT OF TRANSPORTATION
HIGHWAYS DIVISION
MISCELLANEOUS DETAILS
HILO BASEYARD RENOVATIONS
REPLACE EXISTING ASBESTOS
FLOOR TILES and CARPET
Project No. HWY-H-04-04M
Scale: As Noted Date: March 9, 2005
SHEET No. **A-4** OF **6** SHEETS

ORIGINAL PLAN	DATE
DESIGNED BY	
TRACED BY	
NOTE BOOK	
QUANTITIES BY	
CHECKED BY	