



| FED. ROAD DIST. NO. | STATE | PROJ. NO.    | FISCAL YEAR | SHEET NO. | TOTAL SHEETS |
|---------------------|-------|--------------|-------------|-----------|--------------|
| HAWAII              | HAW.  | HWY-H-04-04M | 2005        | 1         | 6            |

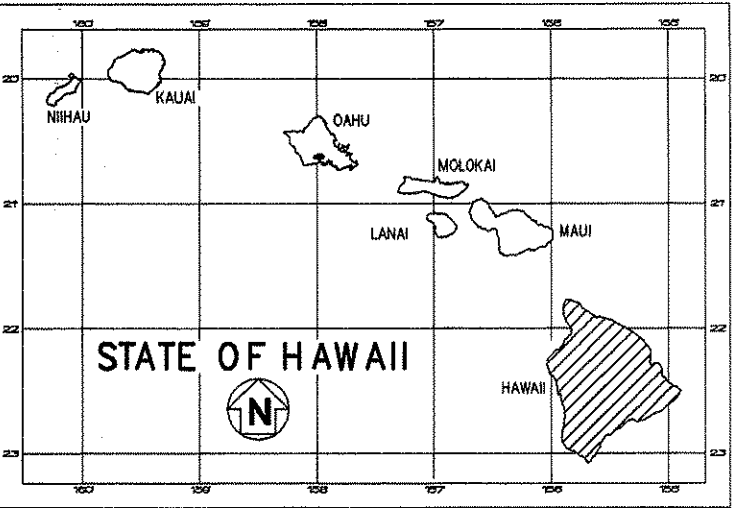


STATE OF HAWAII  
DEPARTMENT OF TRANSPORTATION  
HIGHWAYS DIVISION  
HONOLULU, HAWAII  
  
**"AS-BUILT" PLANS FOR**  
**HILO BASEYARD RENOVATIONS**  
**REPLACE EXISTING ASBESTOS**  
**FLOOR TILES and CARPET**  
**PROJECT NO. HWY-H-04-04M**  
  
DISTRICT OF SOUTH HILO  
ISLAND OF HAWAII


| OVERALL SHT NO. | SHEET NO. BY DISCIPLINE | INDEX TO DRAWINGS                        |
|-----------------|-------------------------|--|
|                 |                         | DESCRIPTION                              |
| 1               | T-1                     | TITLE SHEET                              |
| 2               | T-2                     | GENERAL NOTES, COLOR SELECTION           |
| 3               | A-1                     | SITE PLAN                                |
| 4               | A-2                     | FLOOR PLAN, SCOPE OF WORK                |
| 5               | A-3                     | DETAILED FLOOR PLAN, INTERIOR ELEVATIONS |
| 6               | A-4                     | DETAILS                                  |
|                 |                         |  |
|                 |                         |  |

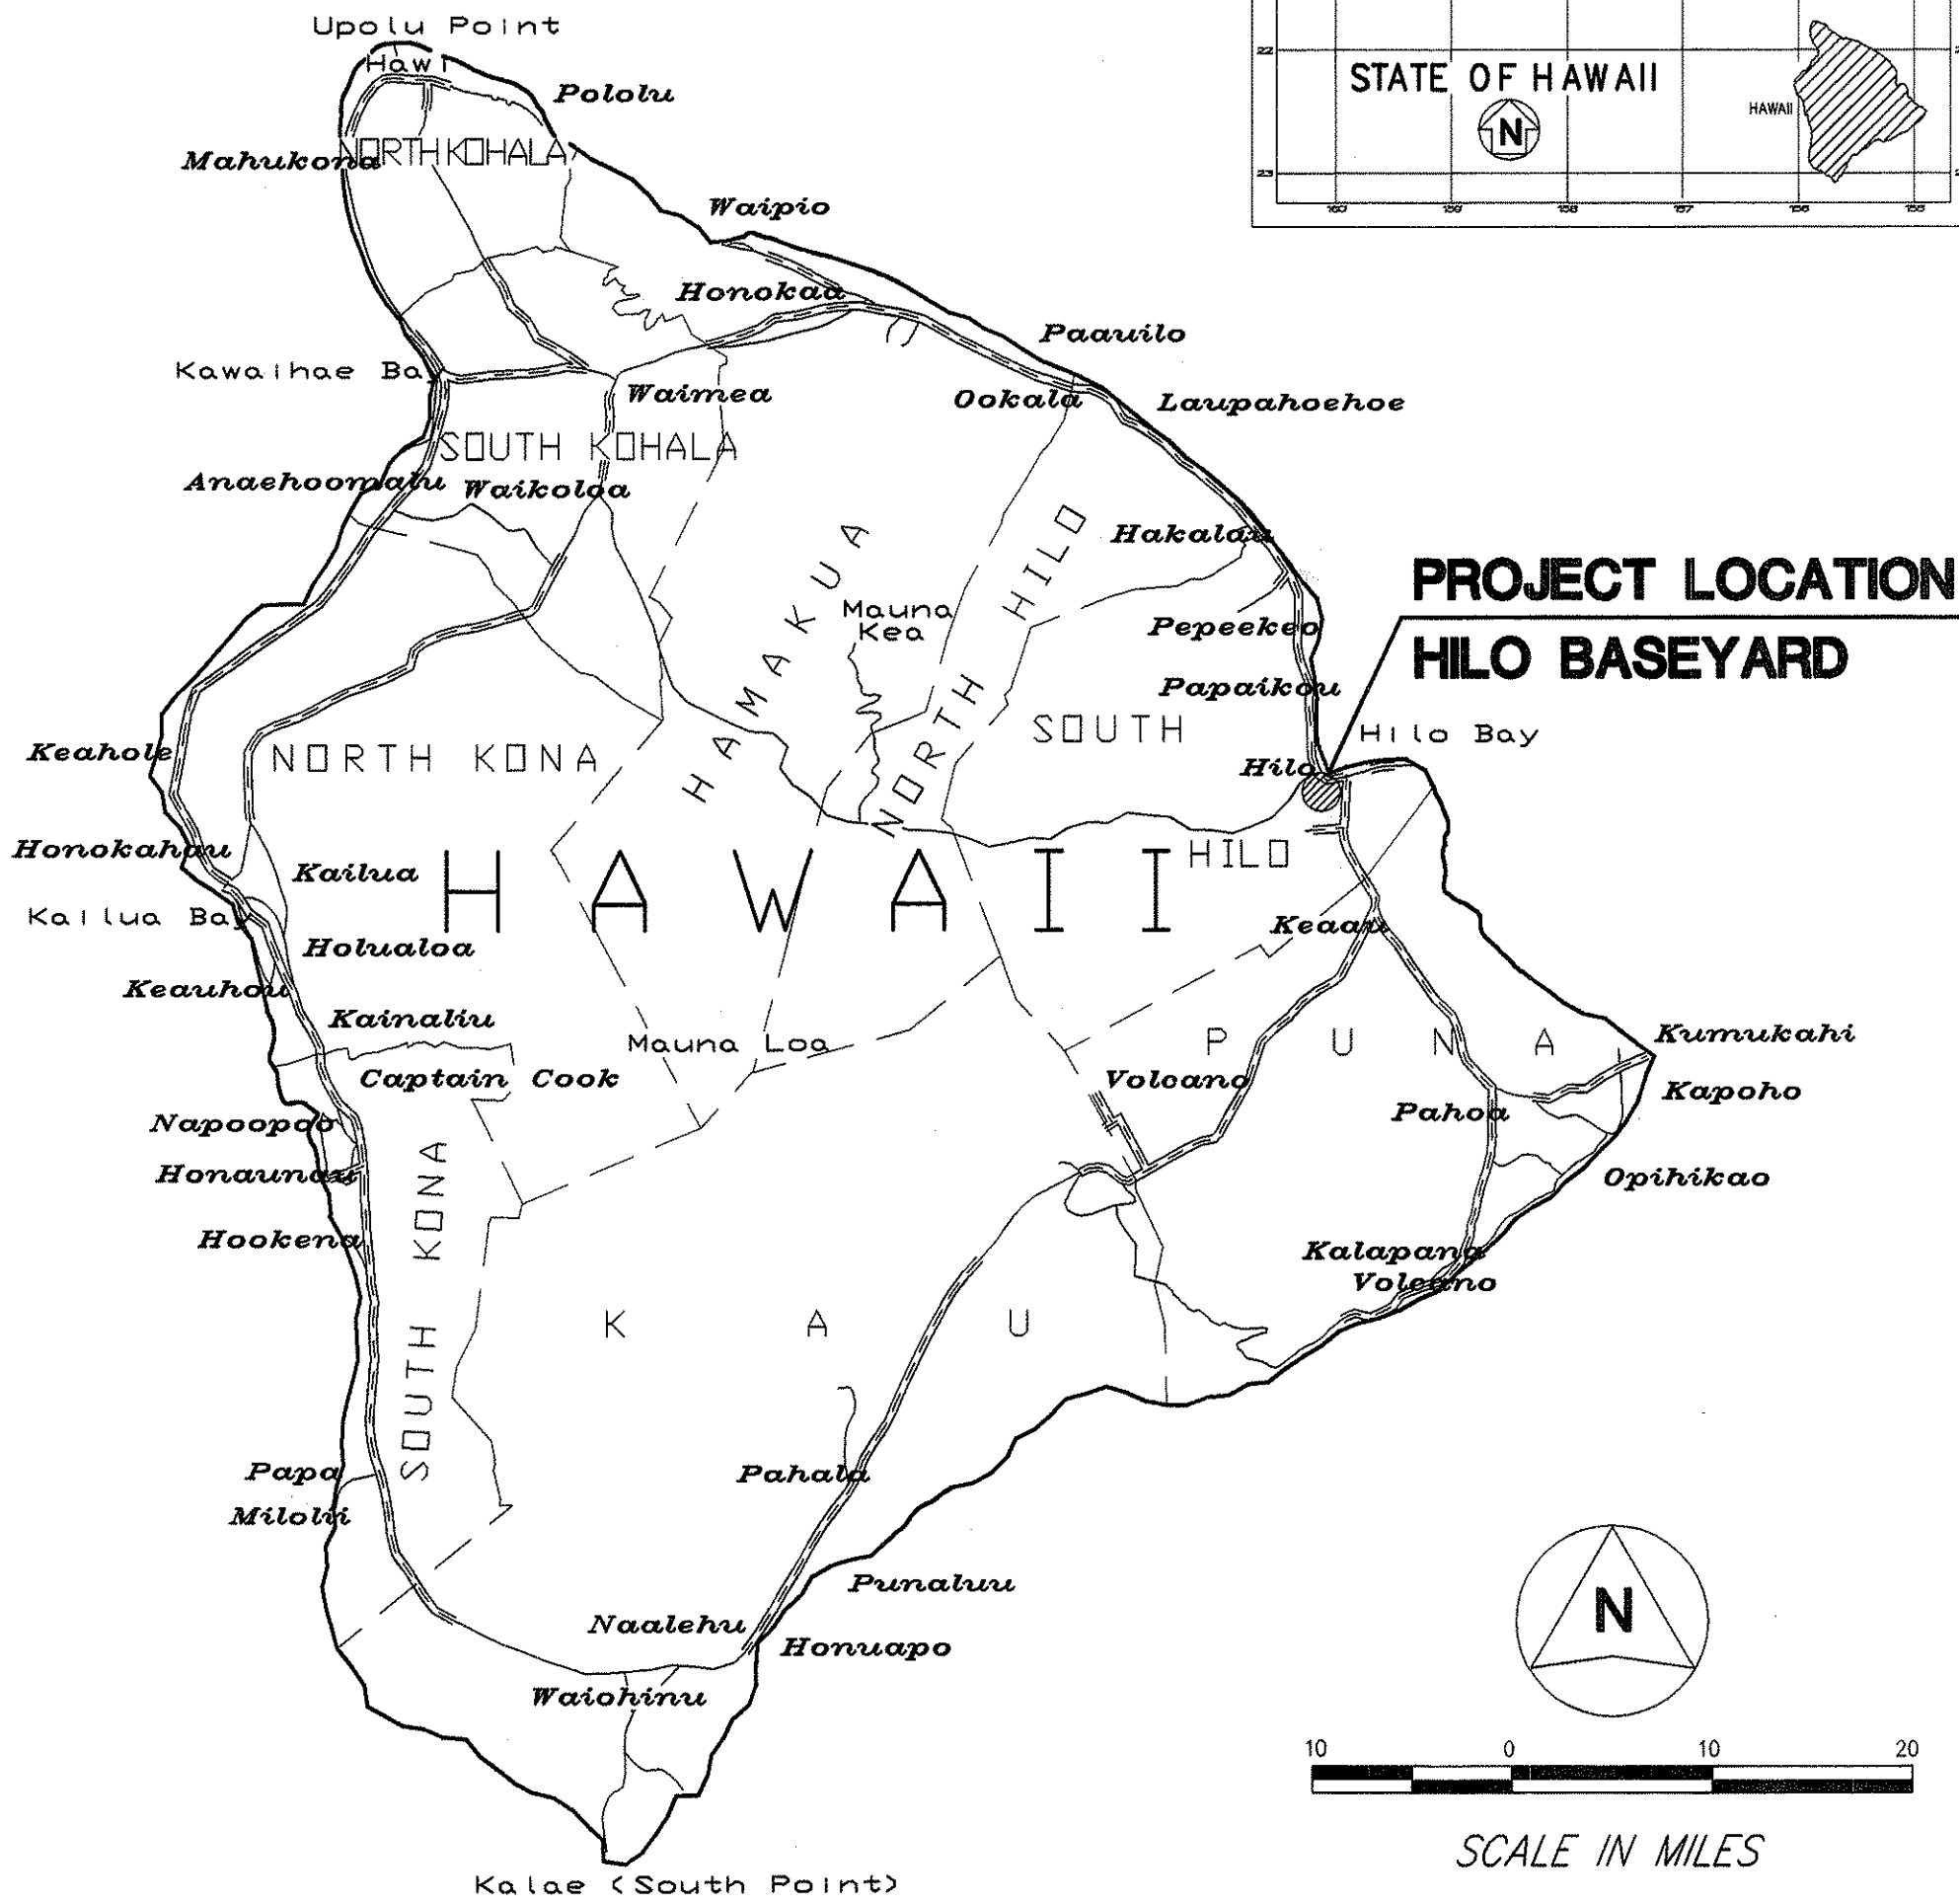

LOCATION MAP  
NOT TO SCALE

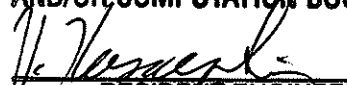


NO SIGNIFICANT CHANGES WERE MADE DURING CONSTRUCTION ON THESE PLANS EXCEPT CHANGES IN THE ORIGINAL THEORETICAL QUANTITIES. FOR ACTUAL QUANTITIES, REFER TO PROJECT LEDGER AND/OR COMPUTATION BOOK.  
  
 RESIDENT ENGINEER  
3/28/08 DATE

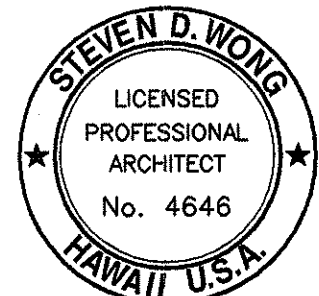

EXPIRES 04-30-06  
THIS WORK WAS PREPARED BY ME OR UNDER MY SUPERVISION AND CONSTRUCTION OF THIS PROJECT WILL BE UNDER MY OBSERVATION.

  
MITSUNAGA & ASSOCIATES

DEPARTMENT OF TRANSPORTATION  
STATE OF HAWAII  
  
APPROVED:  
 3-23-05  
DIR. OF TRANSPORTATION DATE  
SHEET No. T-1 OF 6 SHEETS

MITSUNAGA & ASSOCIATES  
DESIGNED BY  
  
HWY-H  
MANAGED BY  
  
933-8866  
PHONE  
  
JAN. 2005  
DATE