

INDEX TO DRAWINGS	
SHEET NO.	DESCRIPTION
1	TITLE SHEET
2	LOCATION PLAN

STATE OF HAWAII

DEPARTMENT OF TRANSPORTATION

HIGHWAYS DIVISION

"AS BUILT"

PLANS FOR


IMPROVEMENTS TO HILO BASEYARD

BUILDINGS

PROJ. NO. HWY-H-01-71


DISTRICT OF SOUTH HILO

FED. ROAD DIST. NO.	STATE	PROJ. NO.	FISCAL YEAR	SHEET NO.	TOTAL SHEETS
HAWAII	HAW.	HWY-H-01-71	1971	1	2

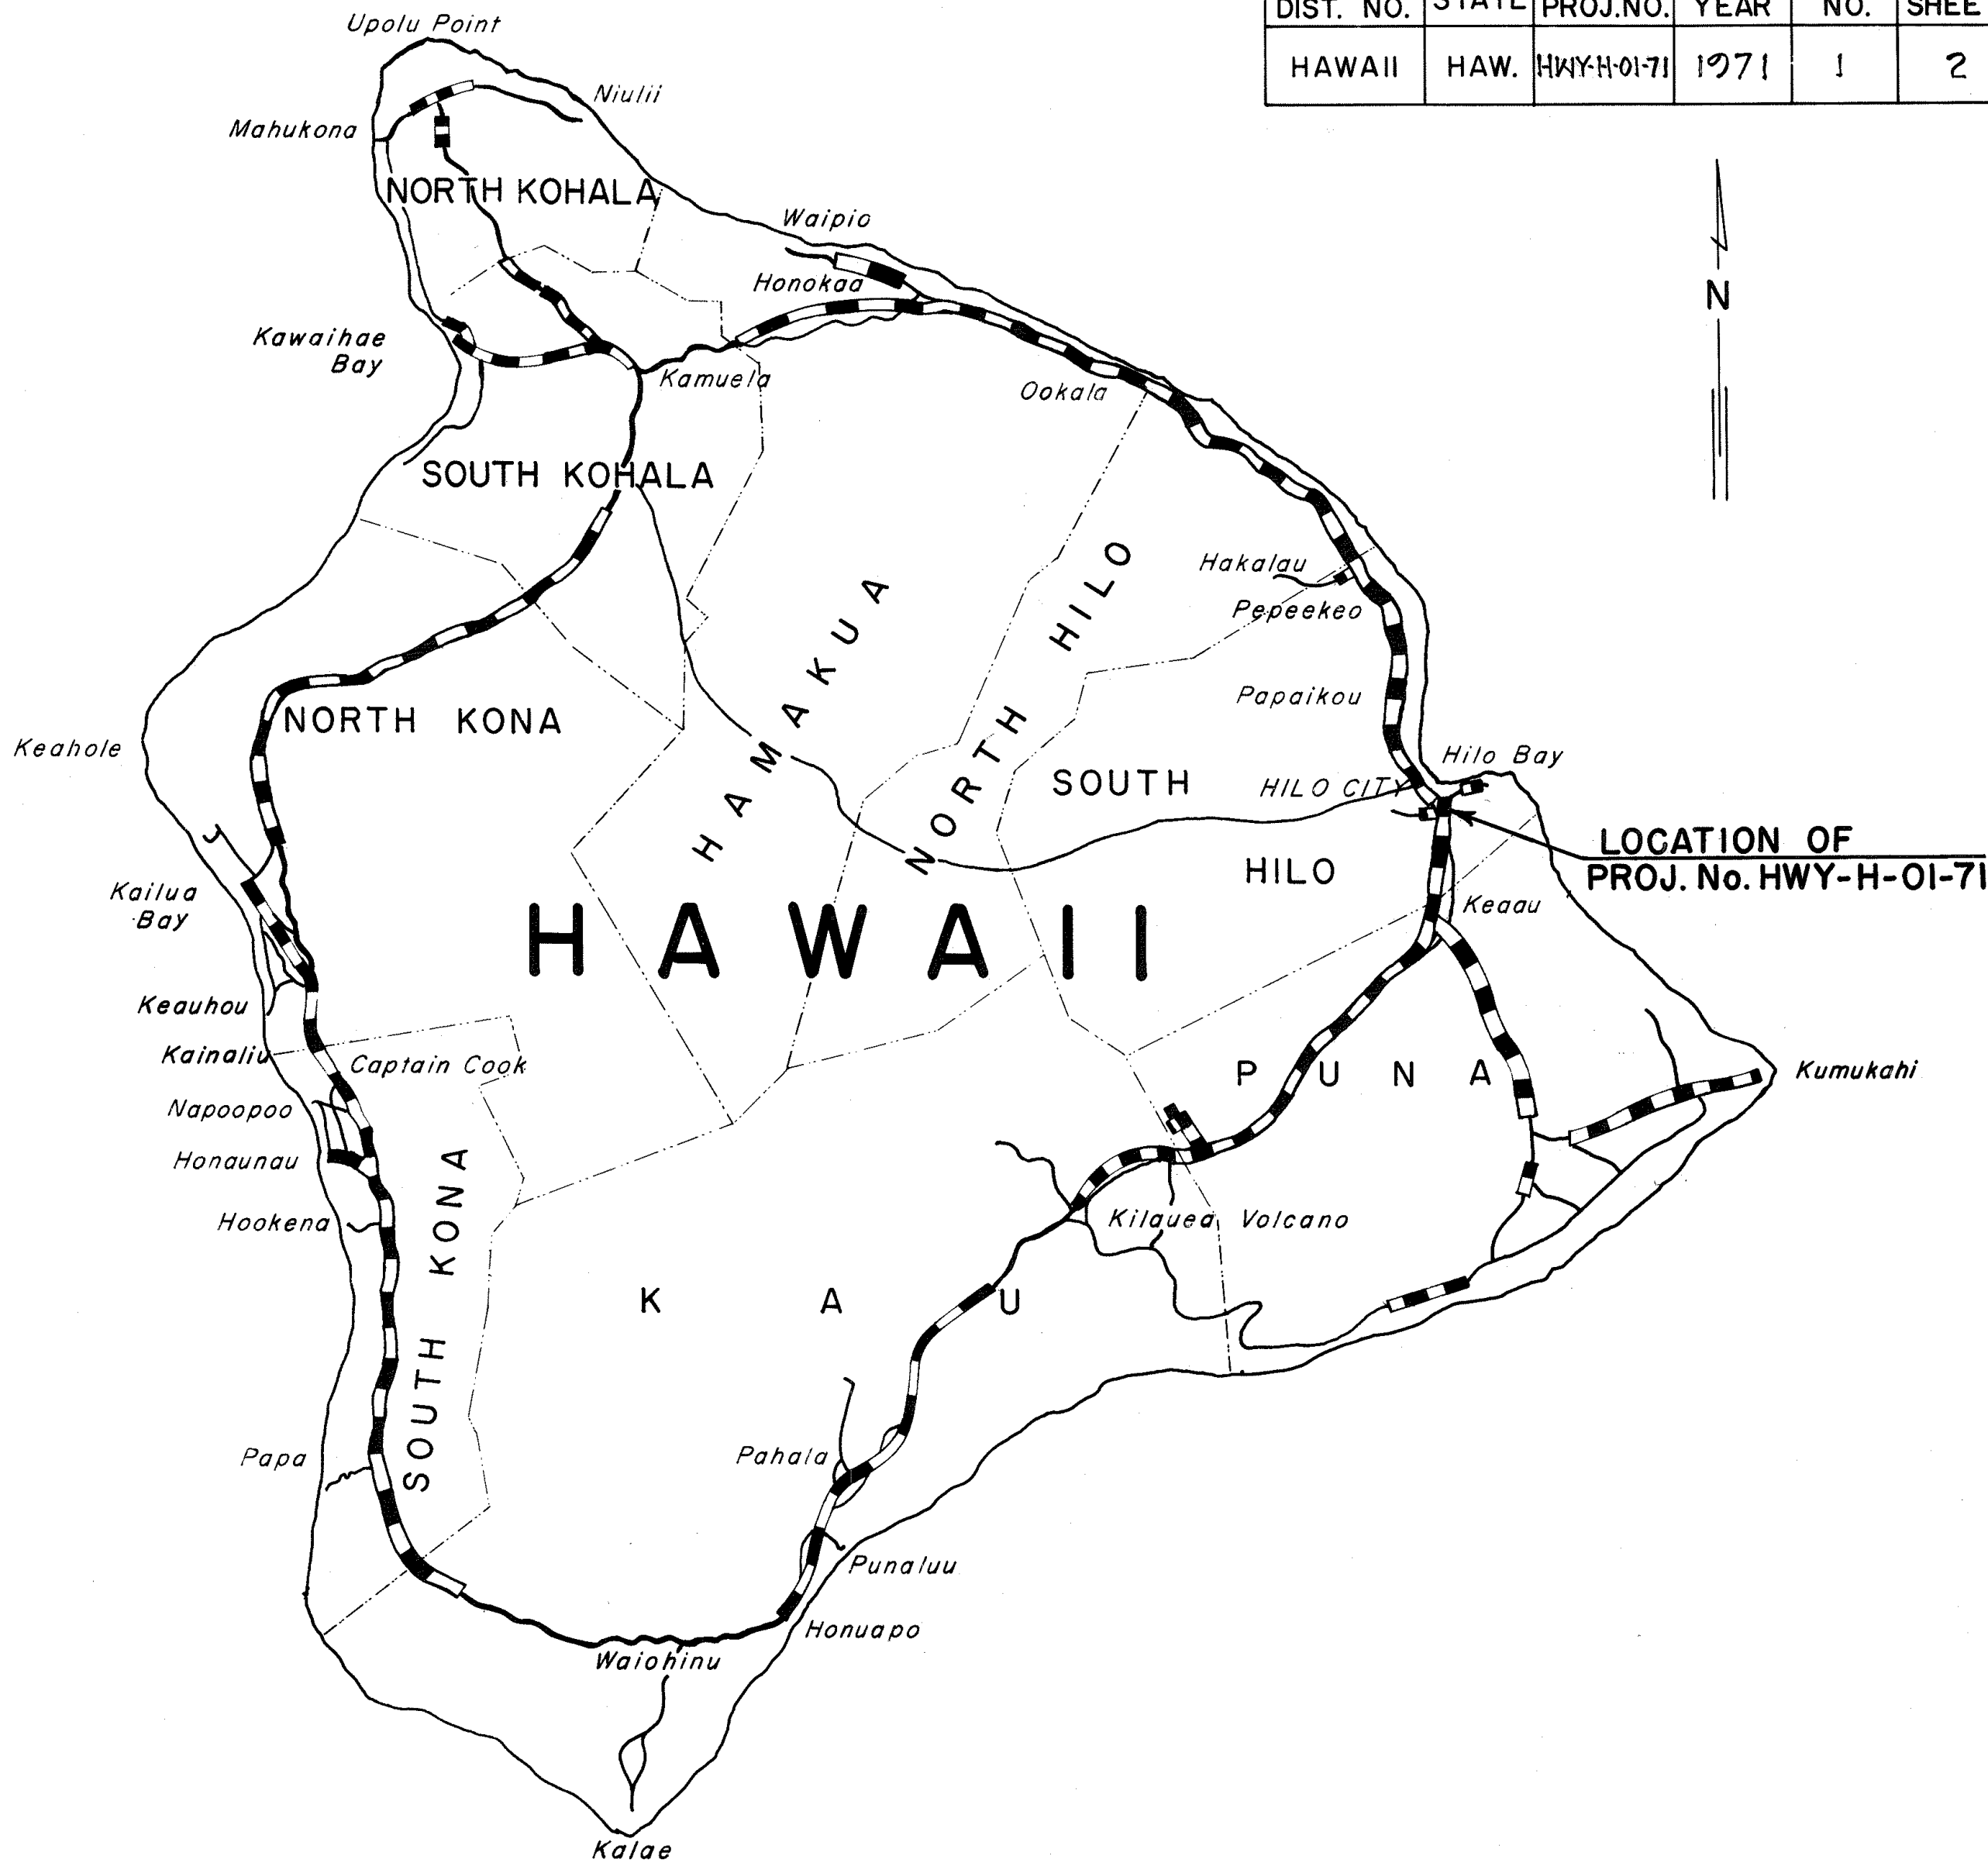

LOCATION OF

PROJ. No. HWY-H-01-71

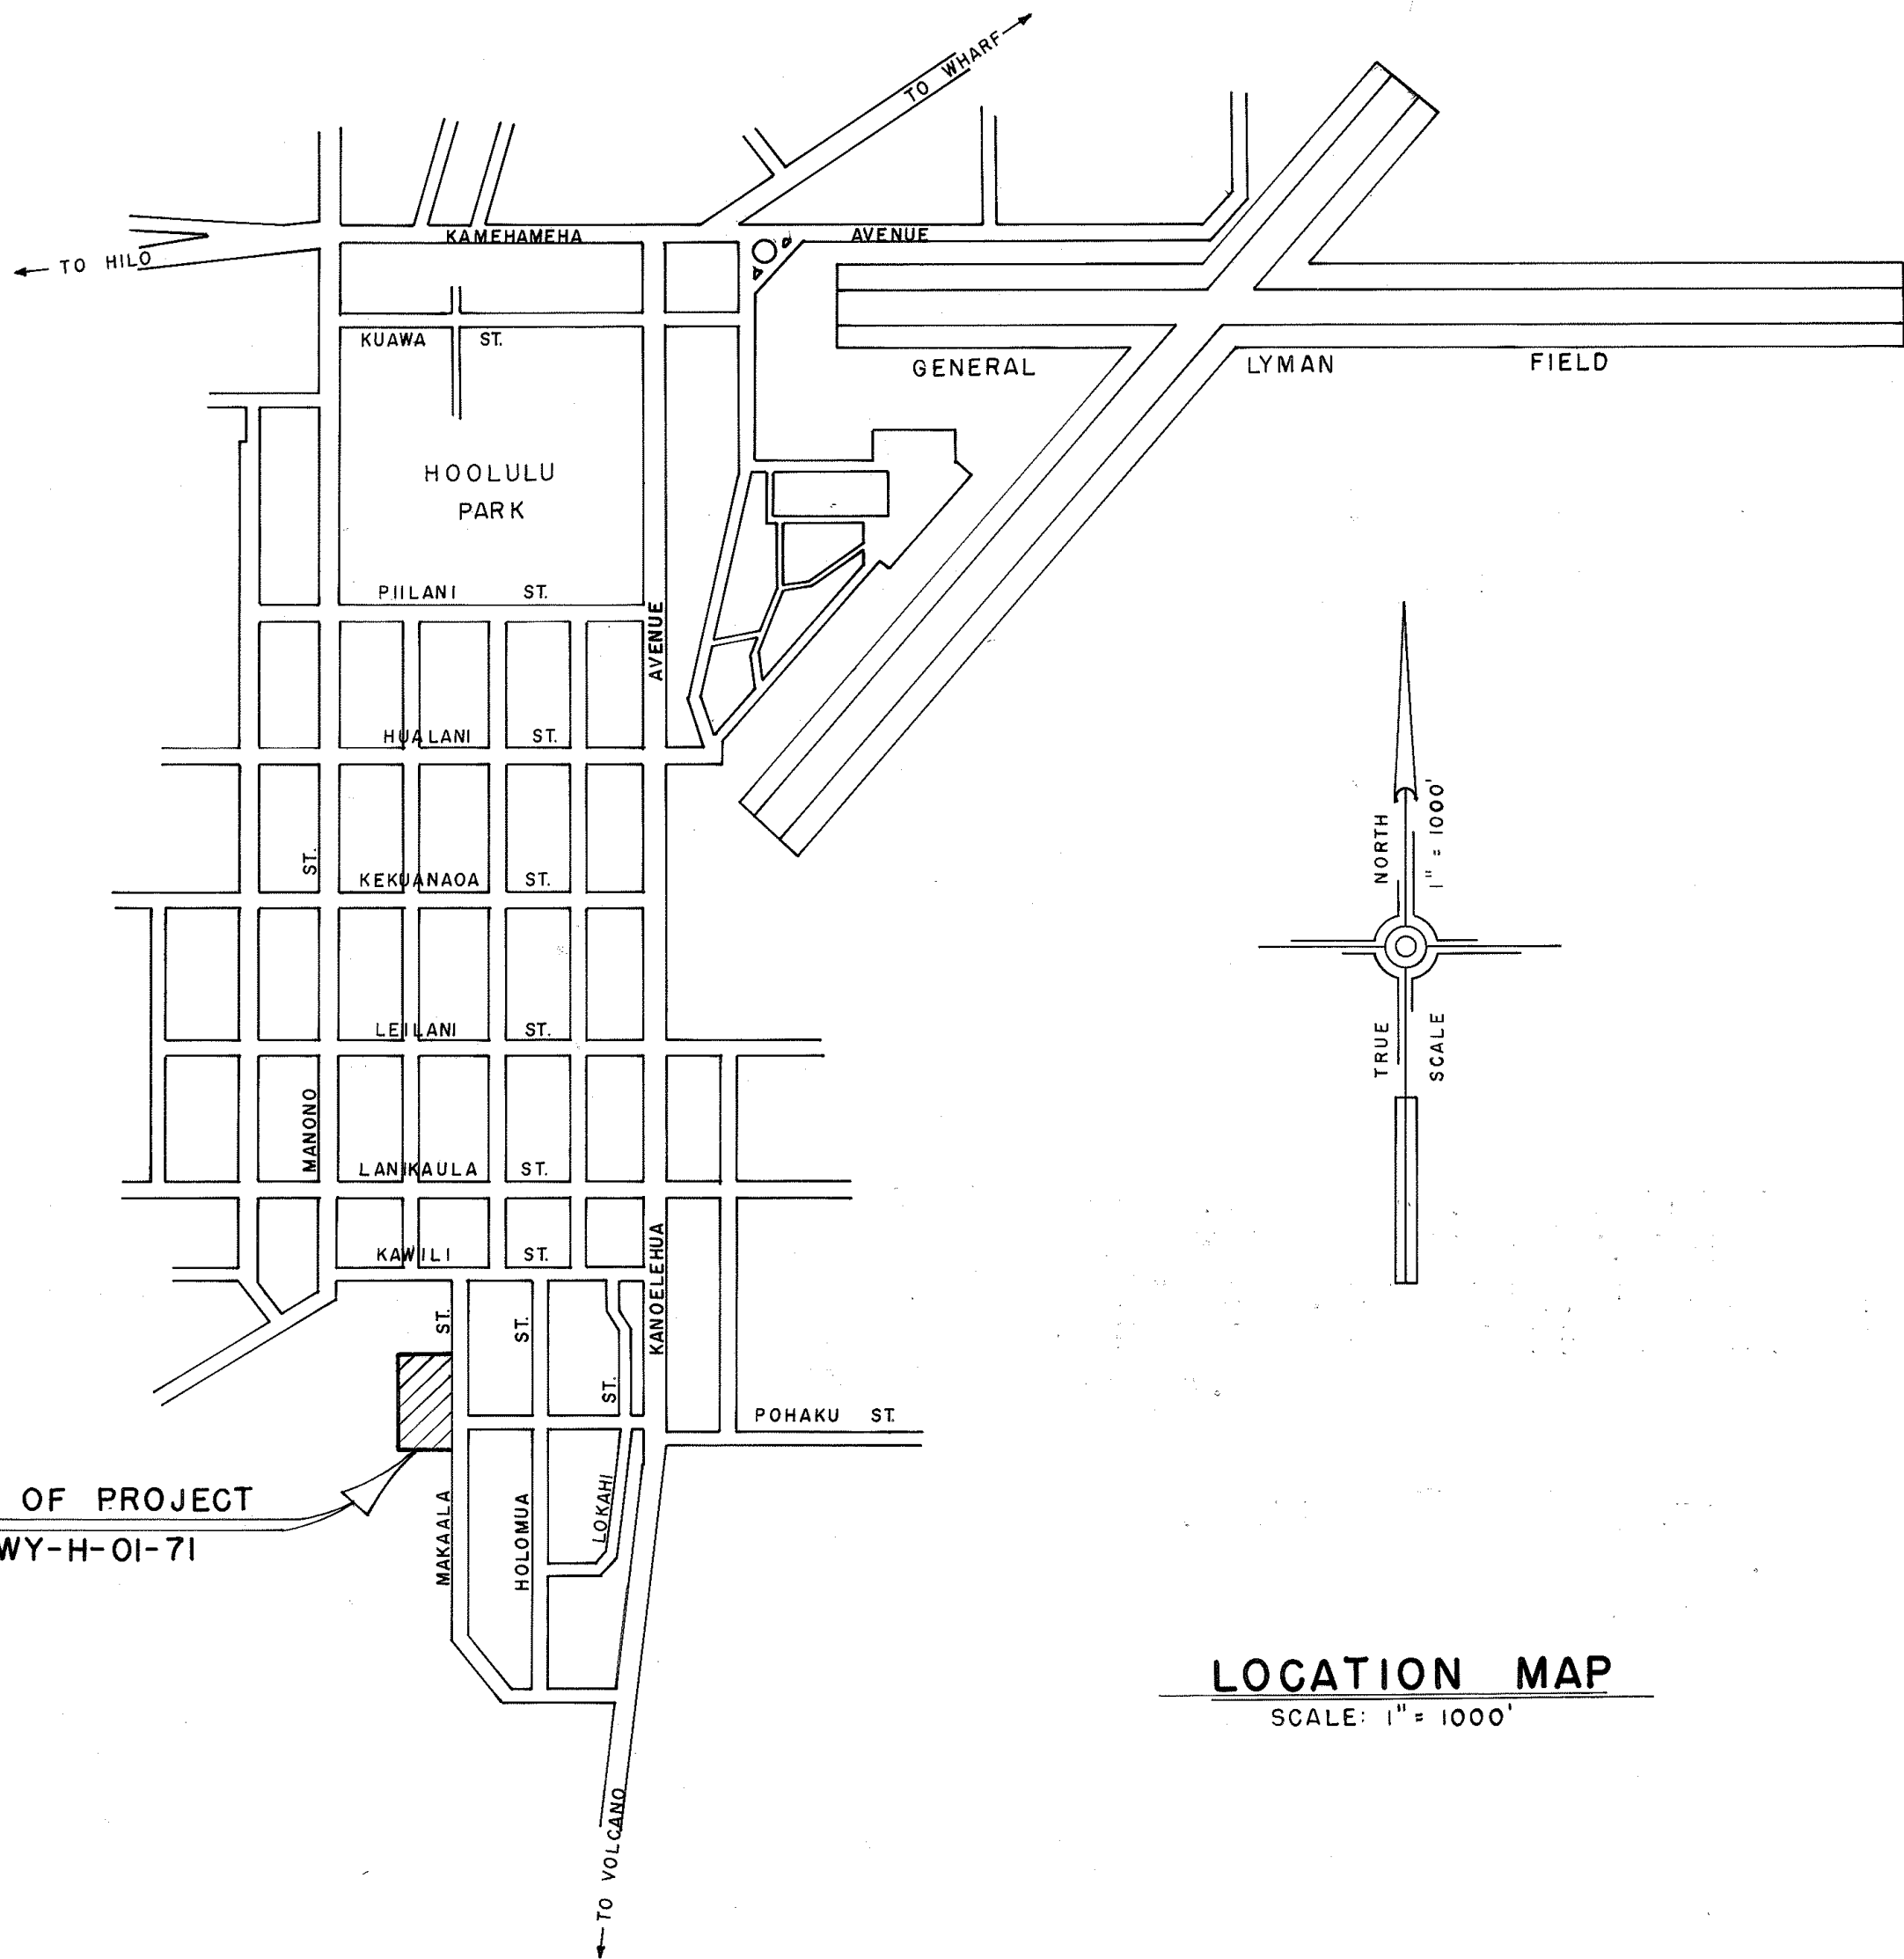

LOCATION MAP

SCALE: 1" = 1000'

Federal Aid Projects Previously Constructed Or Under Construction

NO CHANGES WERE MADE DURING CONSTRUCTION

ON THESE PLANS EXCEPT CHANGES IN THE

ORIGINAL THEORETICAL QUANTITIES. FOR ACTUAL

QUANTITIES, REFER TO PROJECT LEDGER AND/OR

COMPUTATION BOOK.

*Benny Kridani*

RESIDENT ENGINEER

4-28-82

DATE

DEPARTMENT OF TRANSPORTATION STATE OF HAWAII	
APPROVED:	
<i>G. Alvey Wright</i>	3/3/71
DIR. OF TRANSPORTATION	DATE

DESIGNED BY: HAWAII DISTRICT

DATE

PHONE

DESIGN ENGINEER

PS8E