


FINAL SURVEY	SURVEYED PLOTTED NOTE BOOK DATE AREAS CHECKED NO.	BY	DATE

ORIGINAL SURVEY	SURVEYED PLOTTED NOTE BOOK DATE AREAS CHECKED NO.	BY	DATE

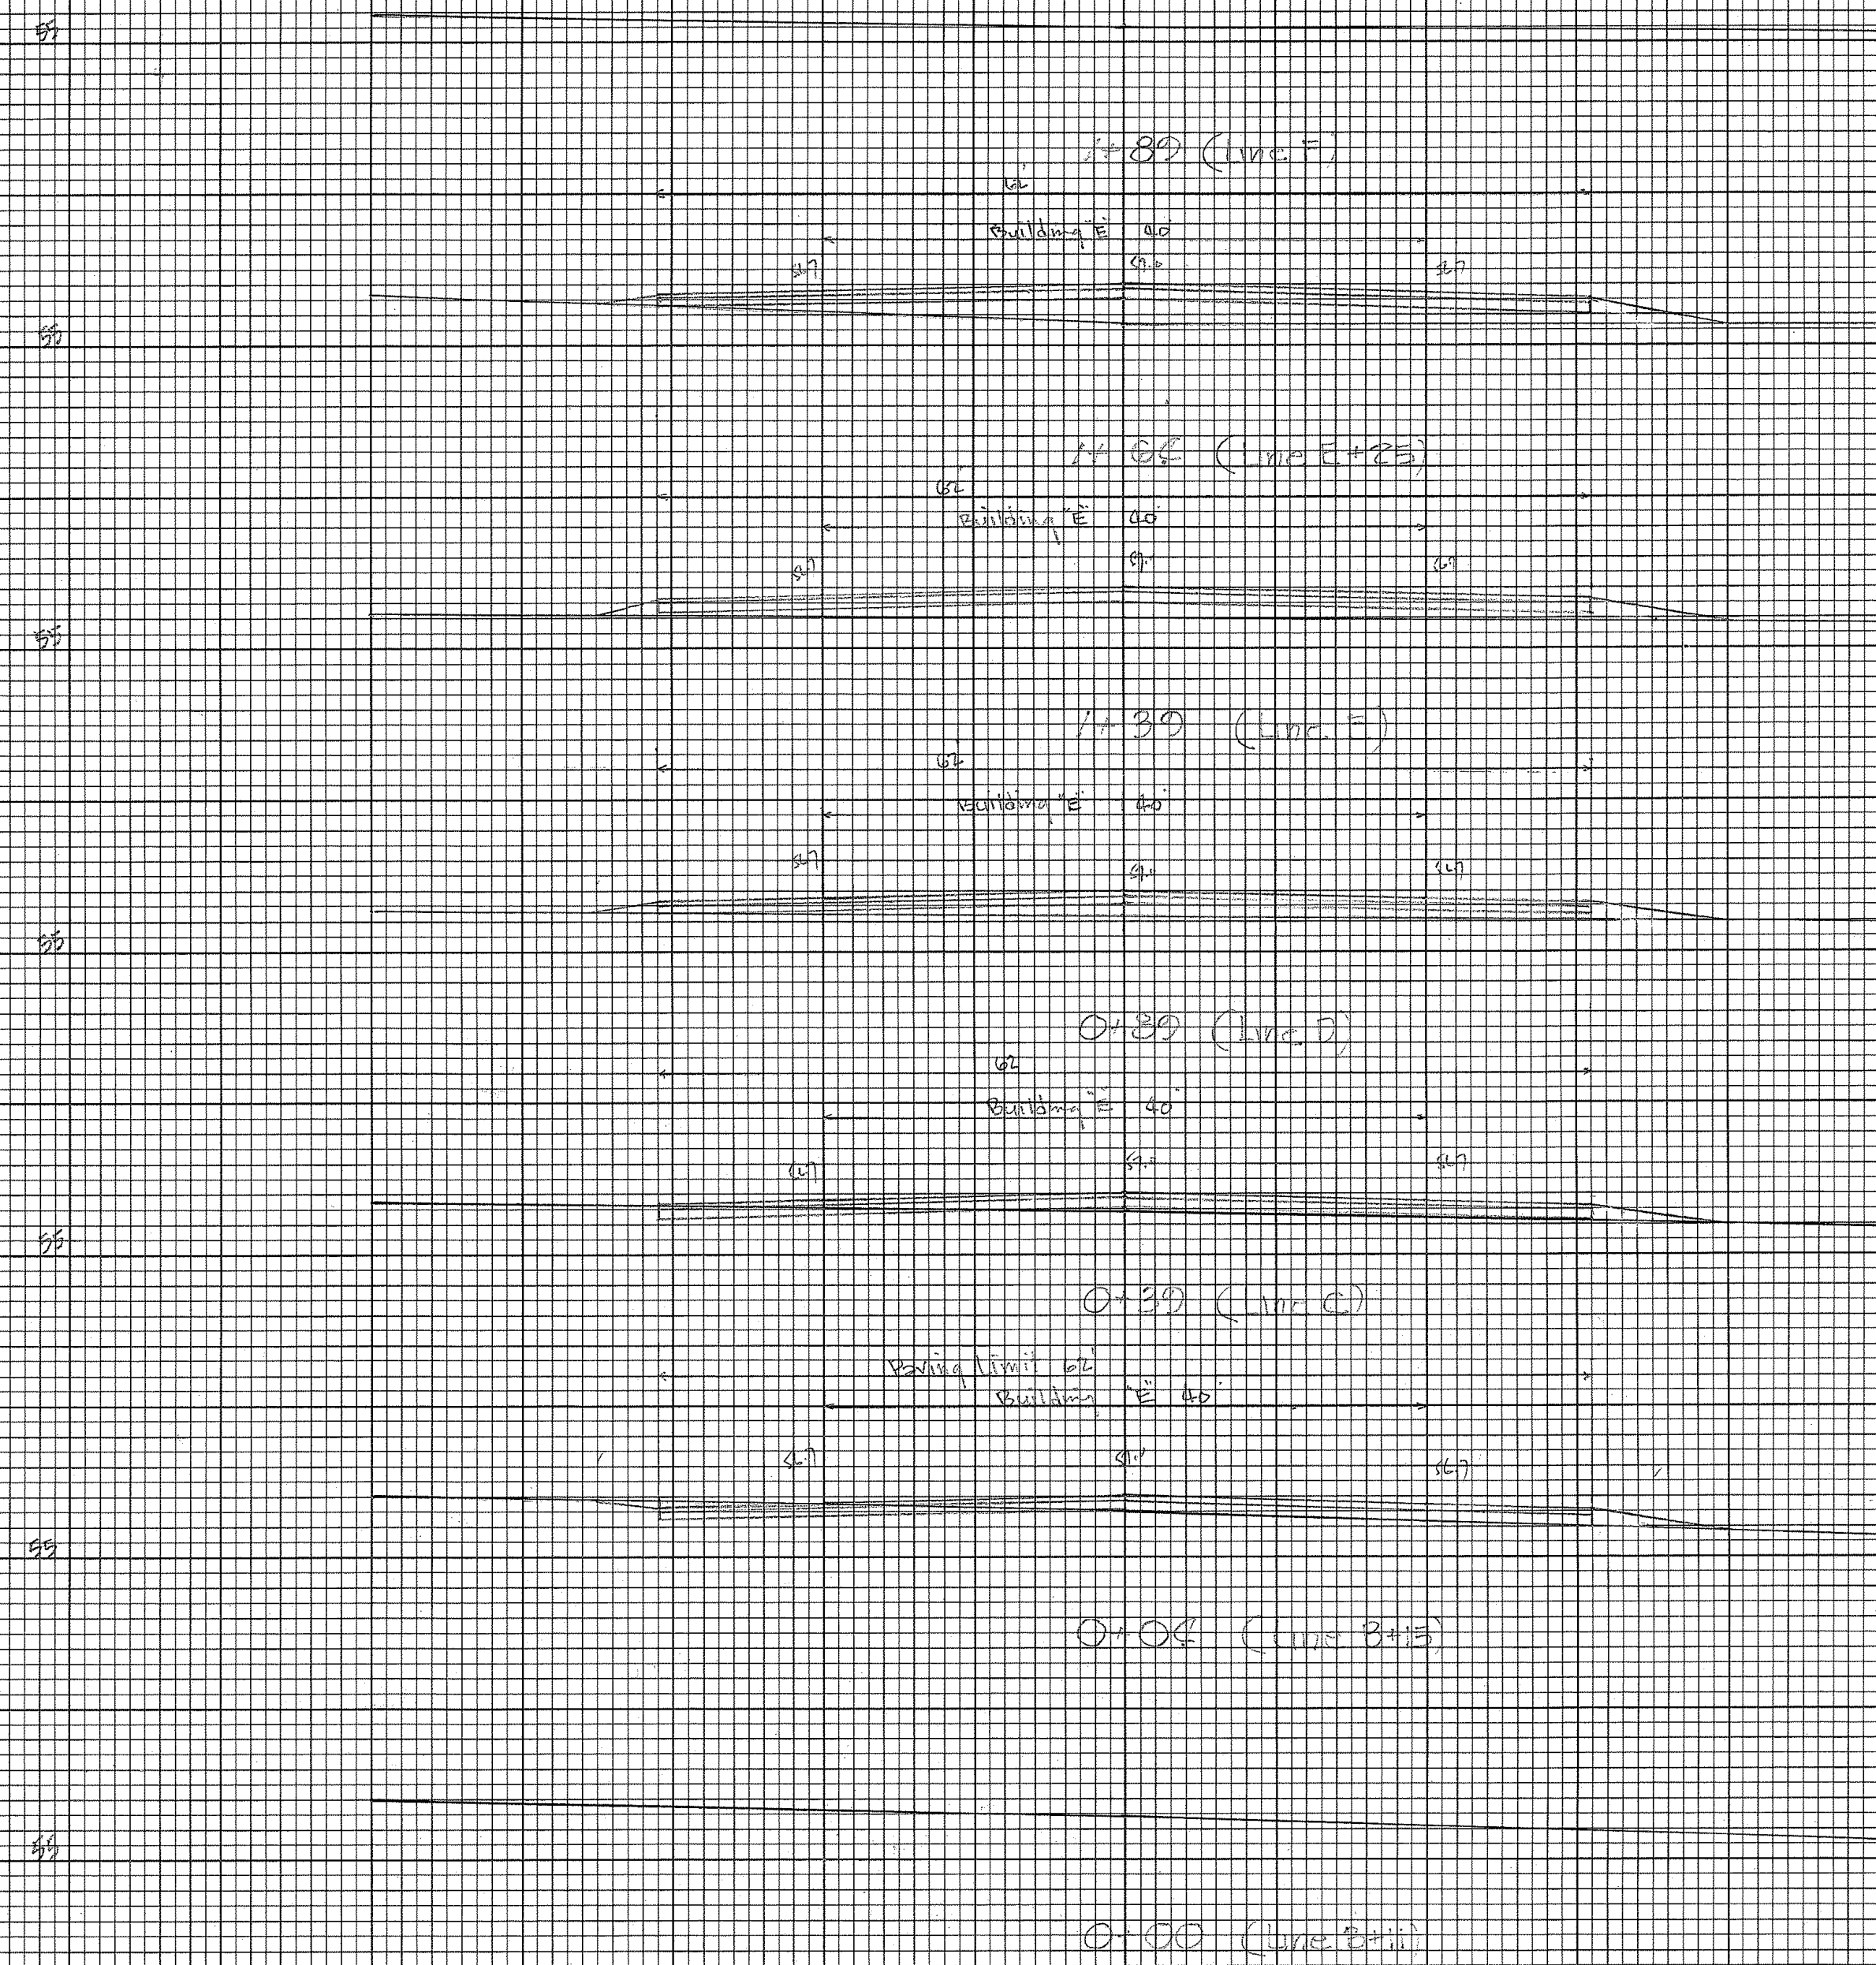

C = 0
F = 0
UB = 0

C = 0
F = 10
UB = 20


C = 0
F = 20
UB = 20

C = 0
F = 10
UB = 10

C = 0
F = 10
UB = 20

C = 0
F = 10
UB = 20

C = 0
F = 0
UB = 0

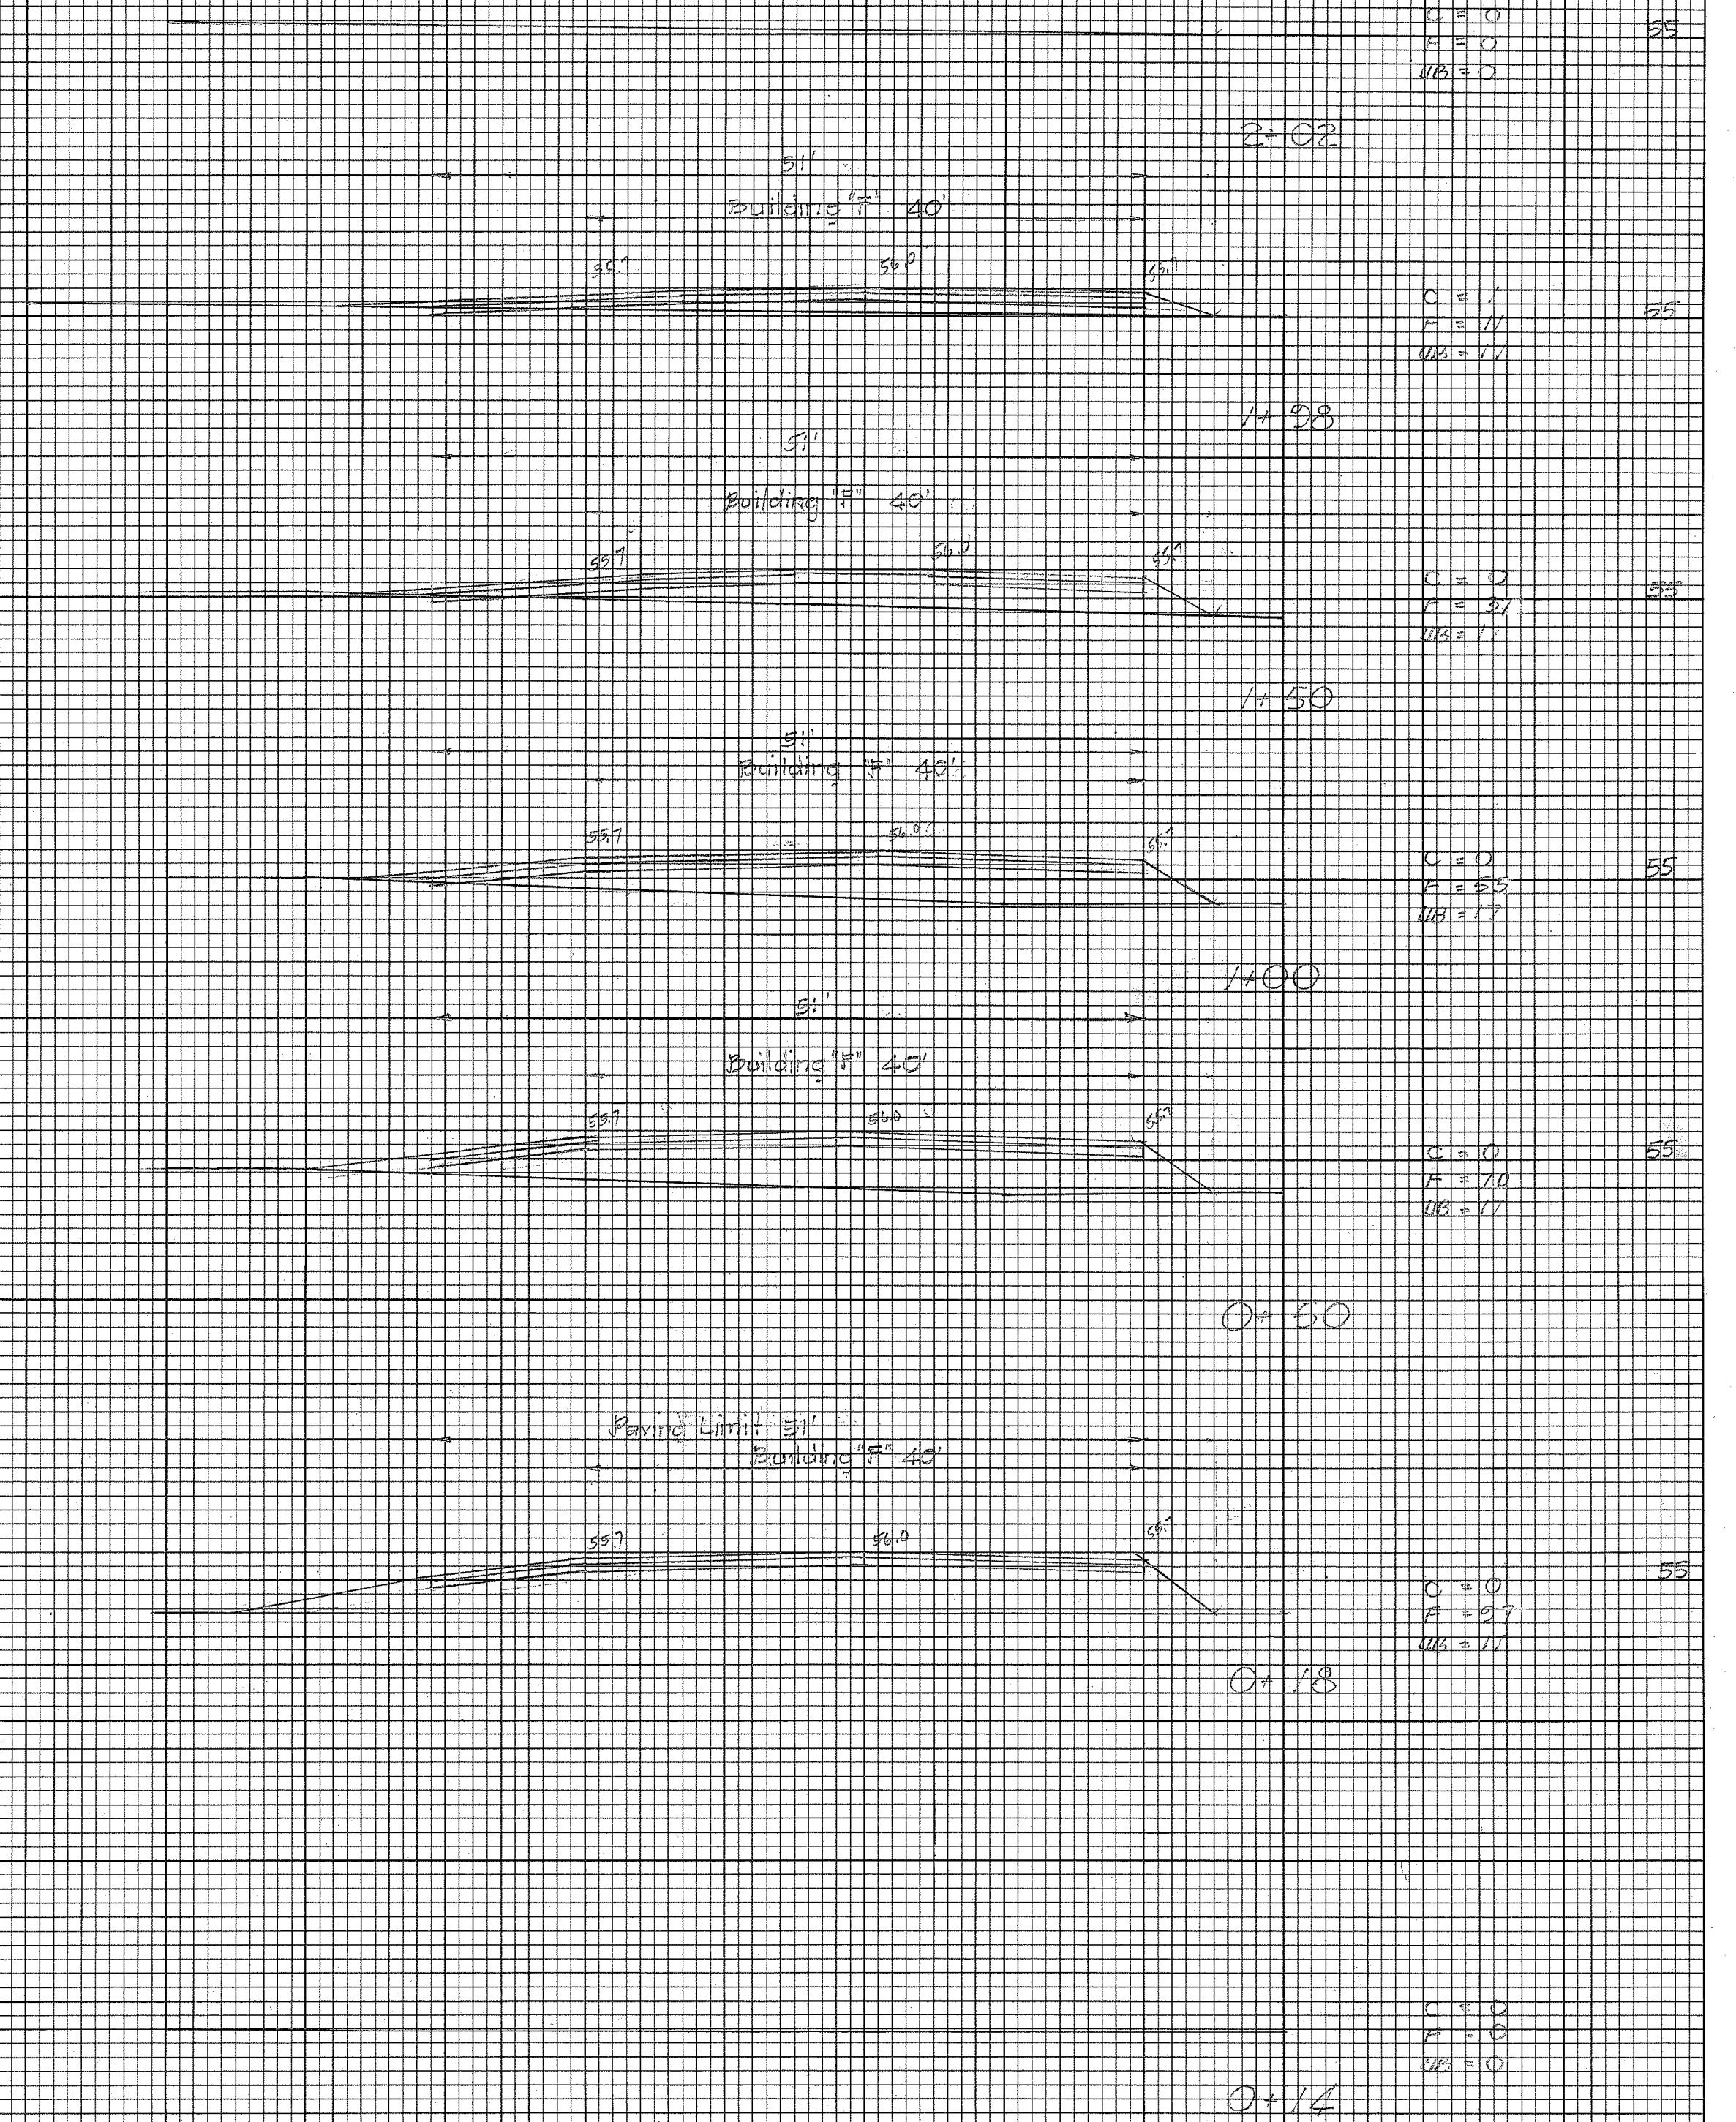

C = 0
F = 0
UB = 0

C = 1
F = 11
UB = 11

C = 1
F = 37
UB = 11

C = 0
F = 65
UB = 17

C = 0
F = 70
UB = 17

C = 0
F = 27
UB = 17

C = 0
F = 0
UB = 0