
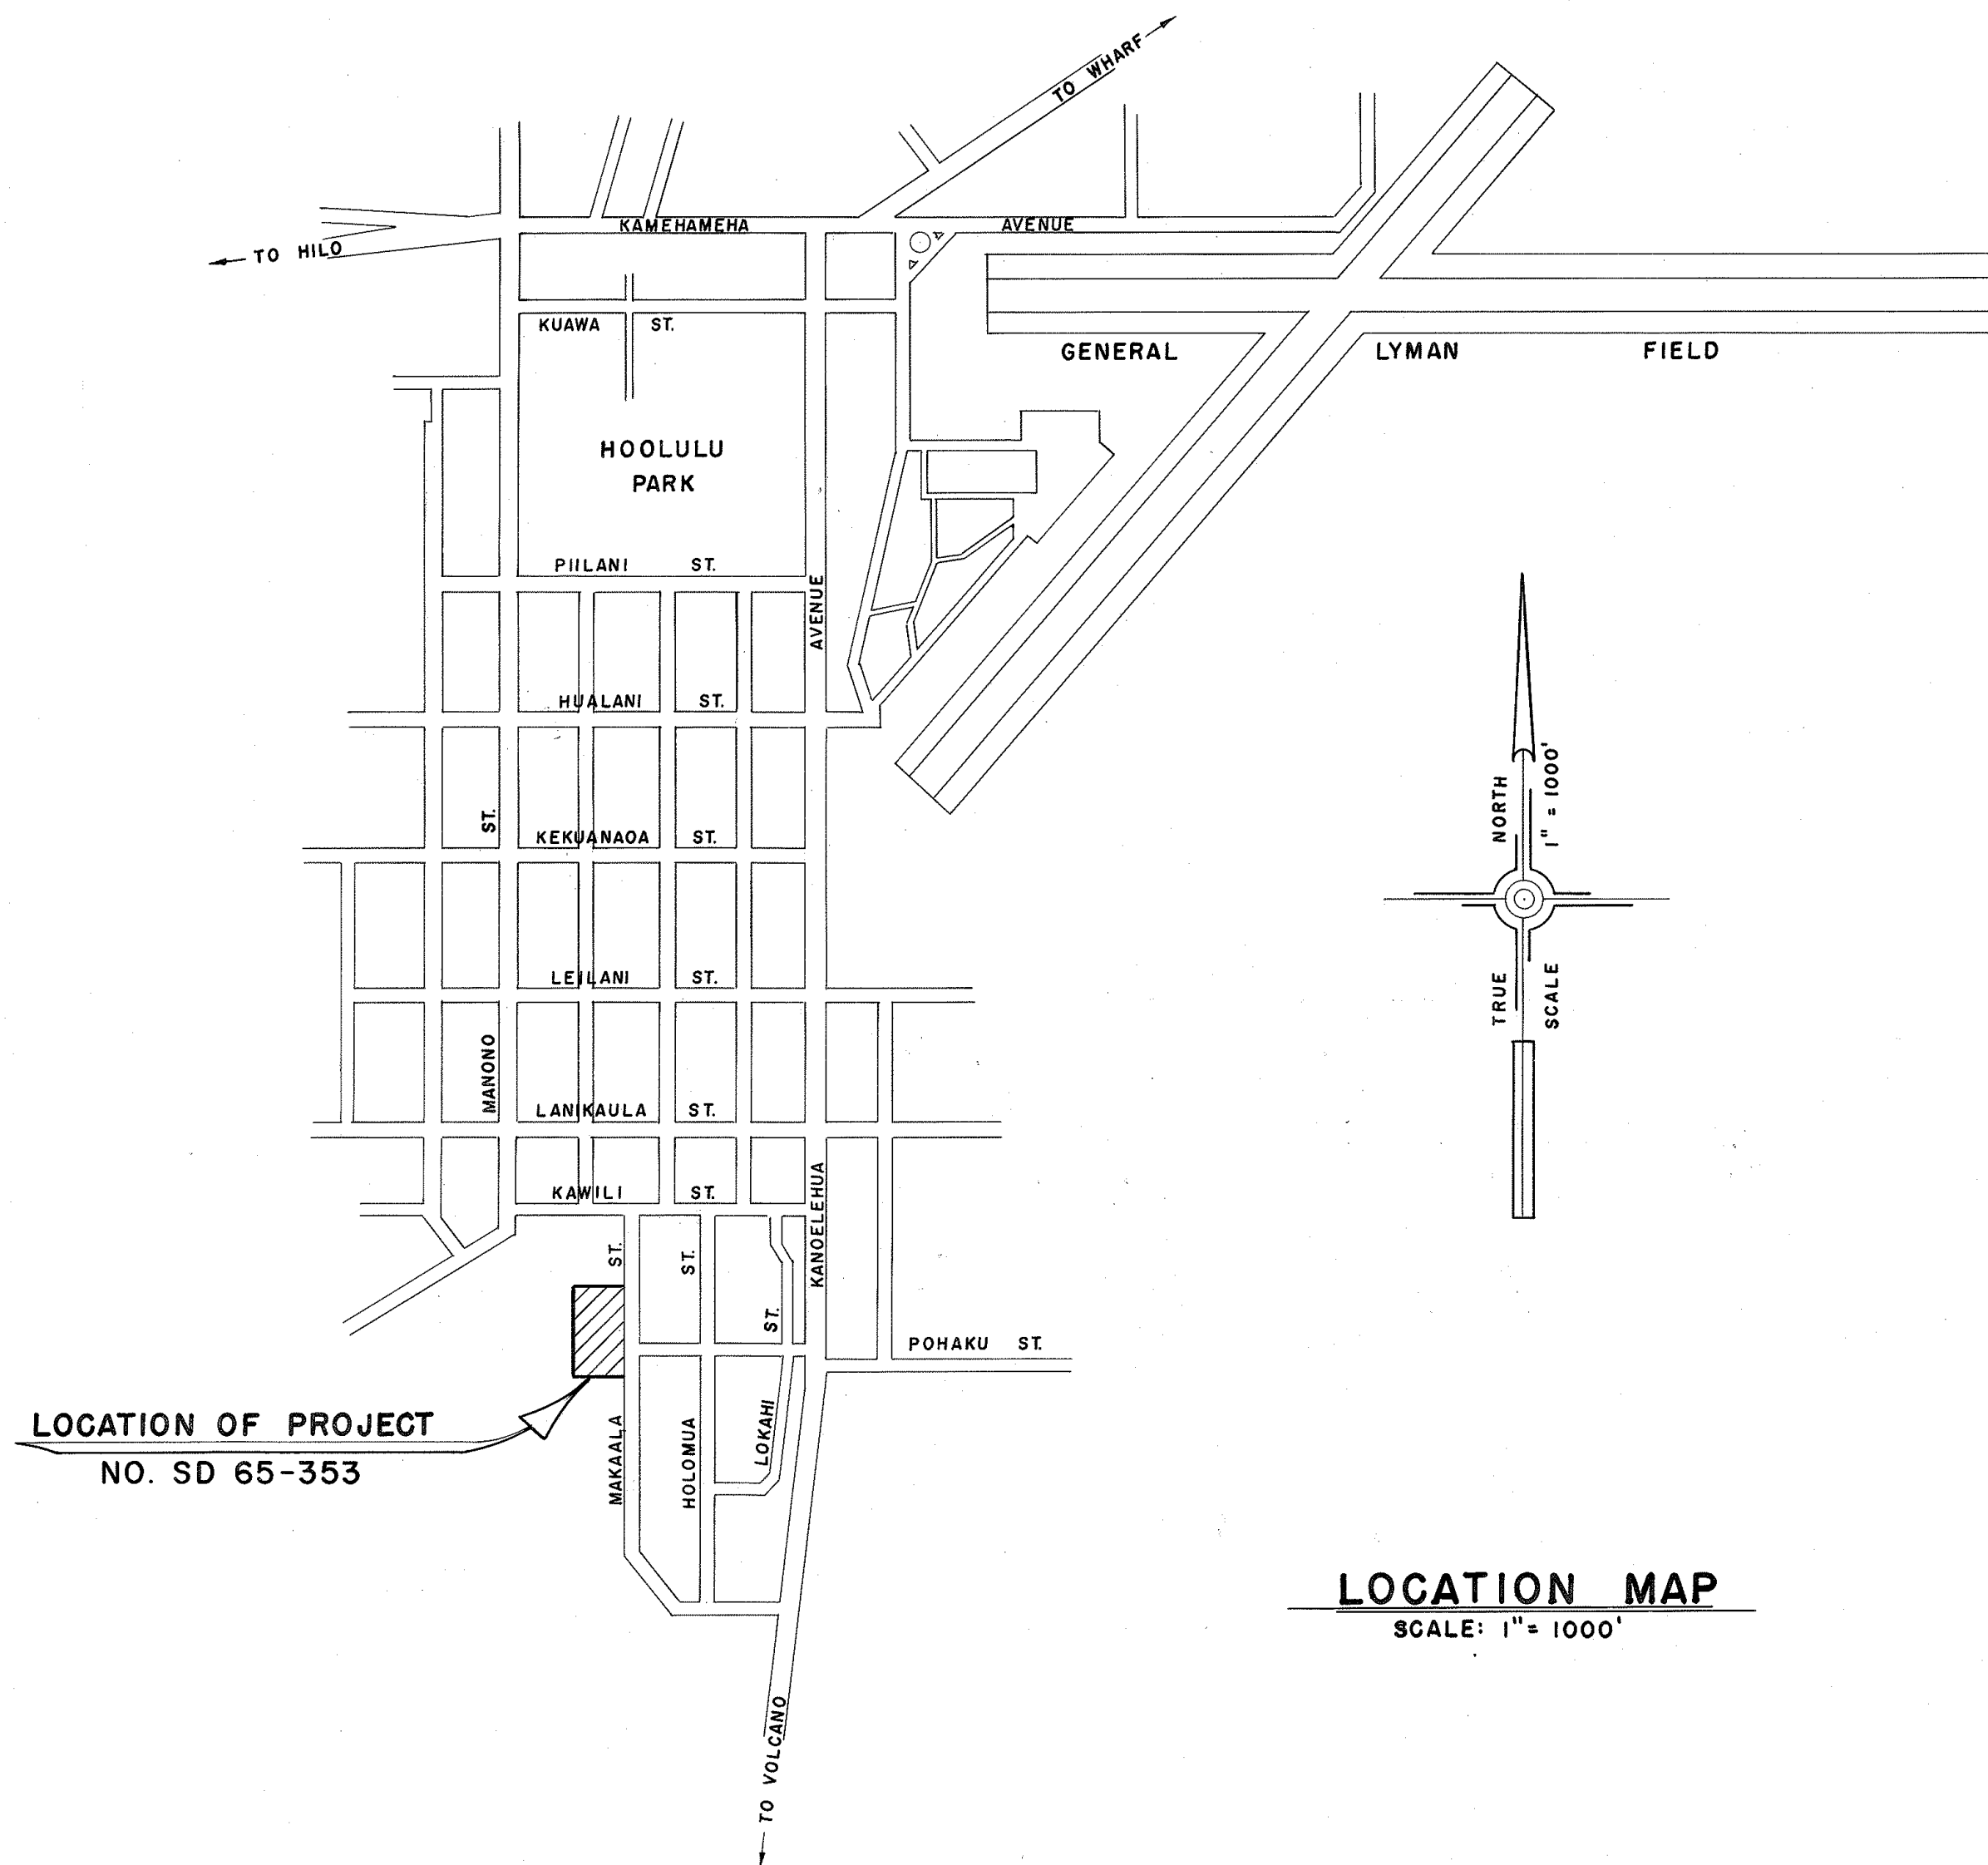


[illegible]

STATE OF HAWAII  
DEPARTMENT OF TRANSPORTATION  
HIGHWAYS DIVISION  
"AS BUILT" PLANS OF  
IMPROVEMENTS FOR HILO BASEYARD  
FOR  
THE DEPARTMENT OF TRANSPORTATION  
HIGHWAYS DIVISION  
PROJECT NO. SD 65-353  
DISTRICT OF SOUTH HILO  
ISLAND OF HAWAII

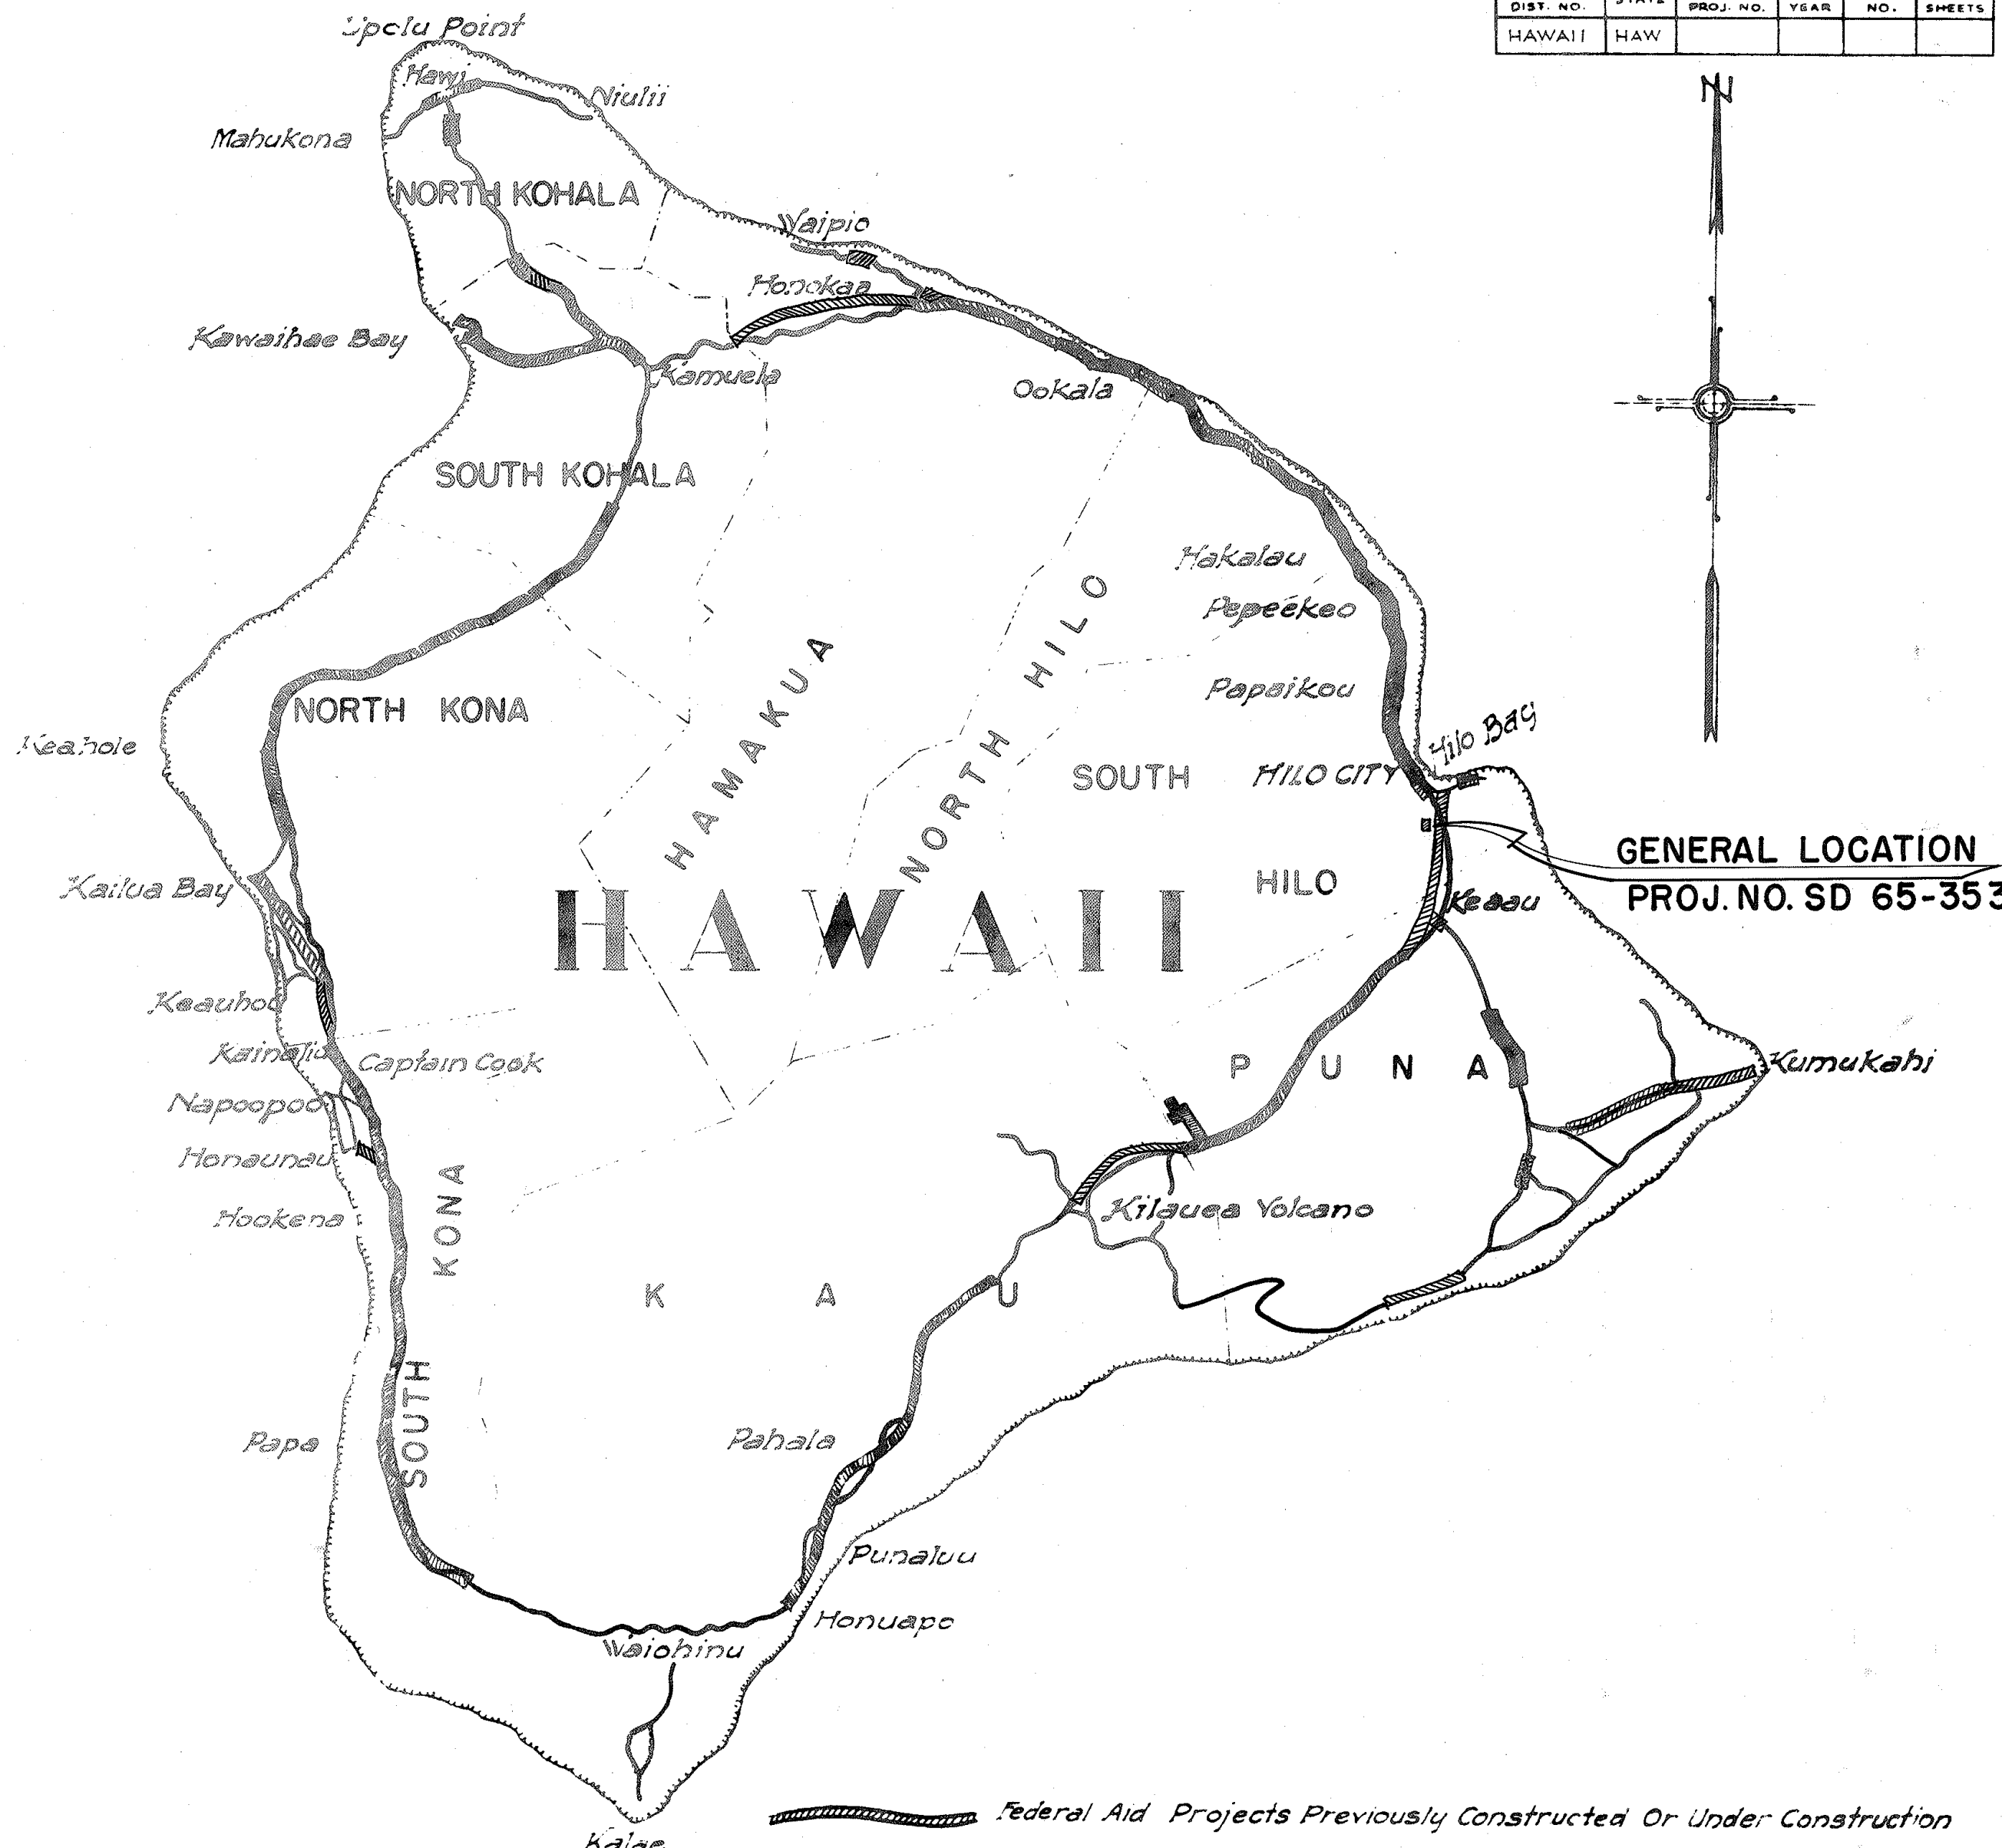

NO CHANGES WERE MADE DURING CONSTRUCTION  
ON THESE PLANS EXCEPT CHANGES IN THE  
ORIGINAL THEORETICAL QUANTITIES. FOR ACTUAL  
QUANTITIES, REFER TO PROJECT LEDGER AND/OR  
COMPUTATION BOOK.

*Berge Kodari*  
RESIDENT ENGINEER

4-28-82  
DATE

APPROVED: *for John Hall Sr.* DATE *11-23-66*  
DIRECTOR OF TRANSPORTATION