



FED. ROAD DIST. NO.	STATE	FED. AID PROJ. NO.	FISCAL YEAR	SHEET NO.	TOTAL SHEETS
HAWAII	HAW.	HWT-H-10-00M	2000	ADD.4	5

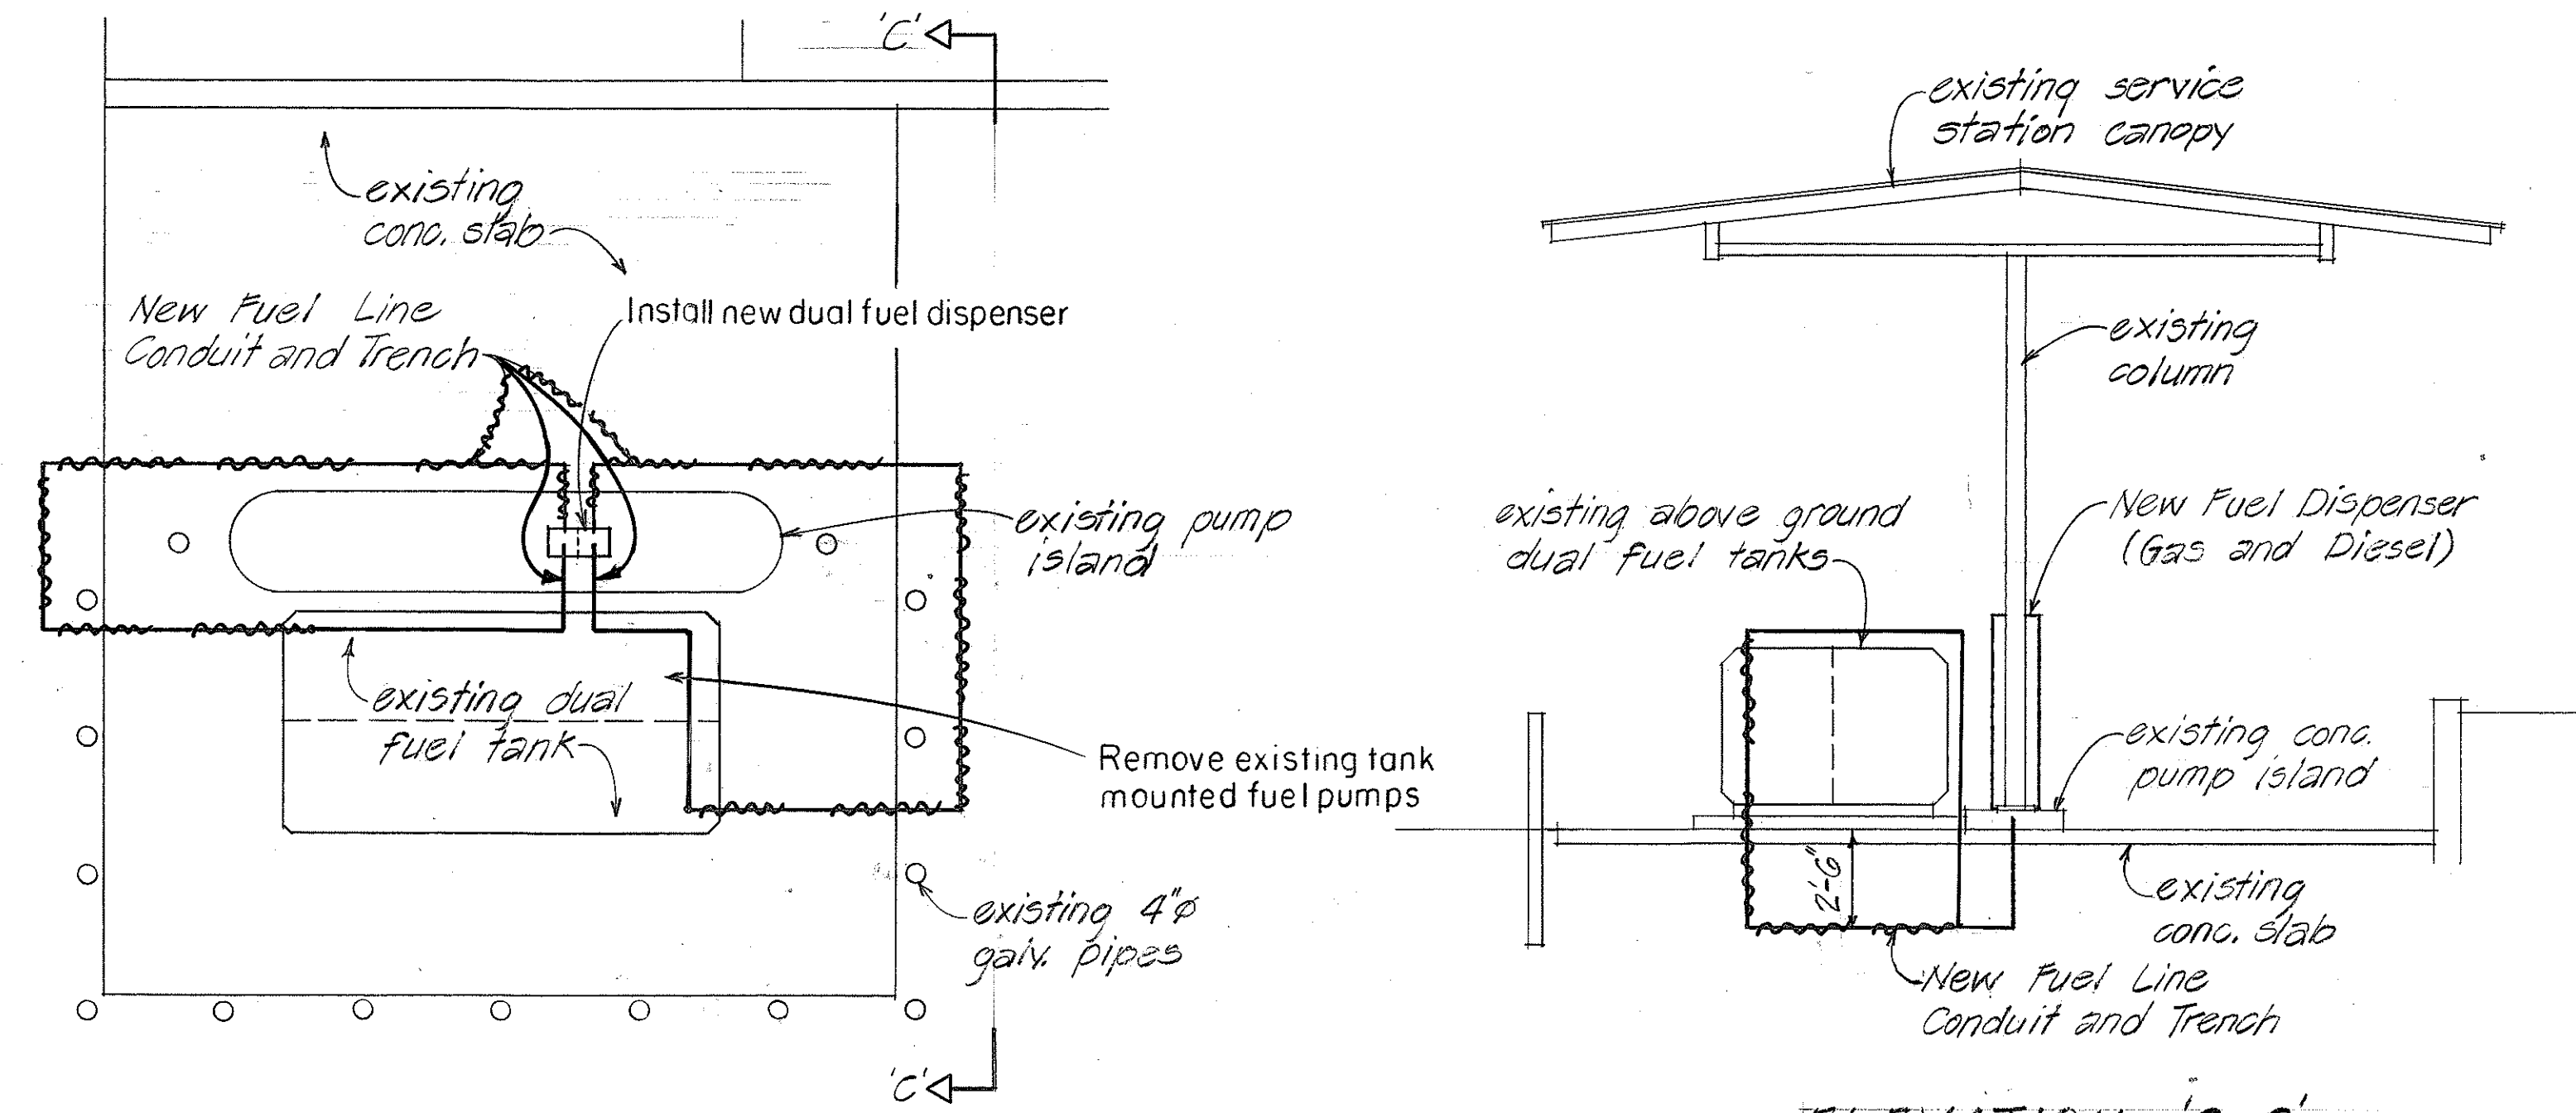

LAYOUT PLAN
Scale: 1/4" = 1'-0"

ELEVATION 'C-C'
Scale: 1/4" = 1'-0"

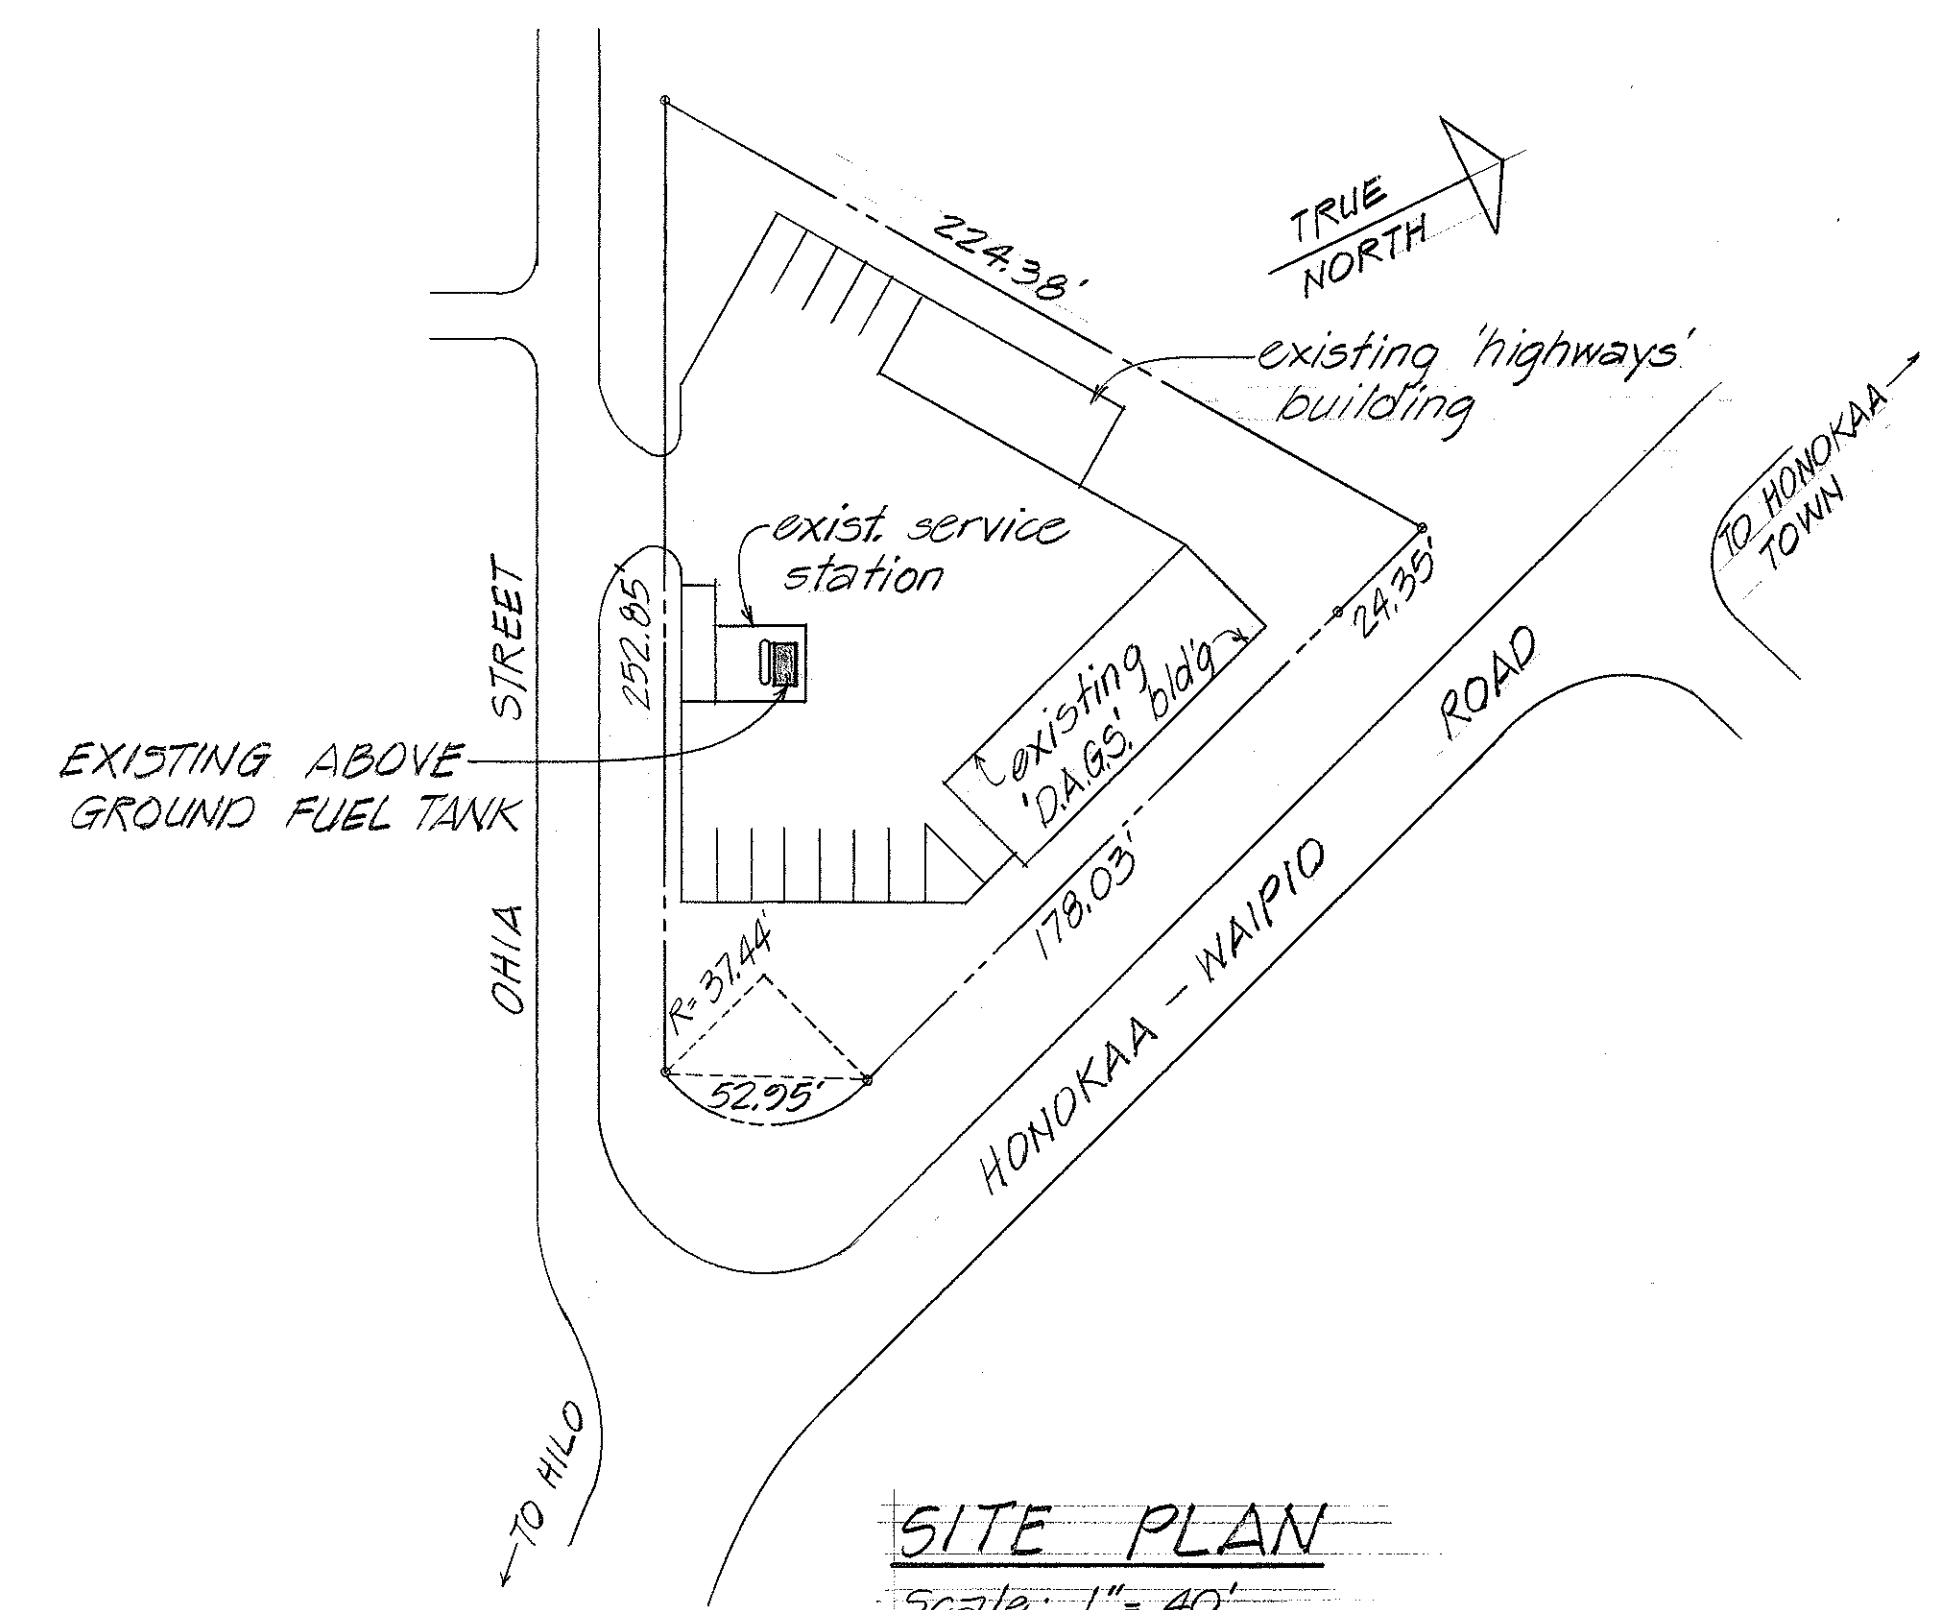

SITE PLAN
Scale: 1" = 40'
TMK: 4-5-01:15
Area:
45-3/80 Ohia Street

ORIGINAL PLAN	DATE
DESIGNED BY	
TRACED BY	
NOTE BOOK	
QUANTITIES BY	
CHECKED BY	
No.	

5-31-00	REVISED, ADDED NOTE TO REMOVE EXISTING TANK MOUNTED FUEL PUMPS.
DATE	REVISION

STATE OF HAWAII
DEPARTMENT OF TRANSPORTATION
HIGHWAYS DIVISION

**HONOKAA BASEYARD
PLANS AND DETAILS**

**KAU AND HONOKAA BASEYARDS
REPLACE FUEL PUMPS**
PROJECT NO. HWT-H-10-00M

Scale: As Noted Date: April 2000

SHEET No. 1 OF 1 SHEETS