

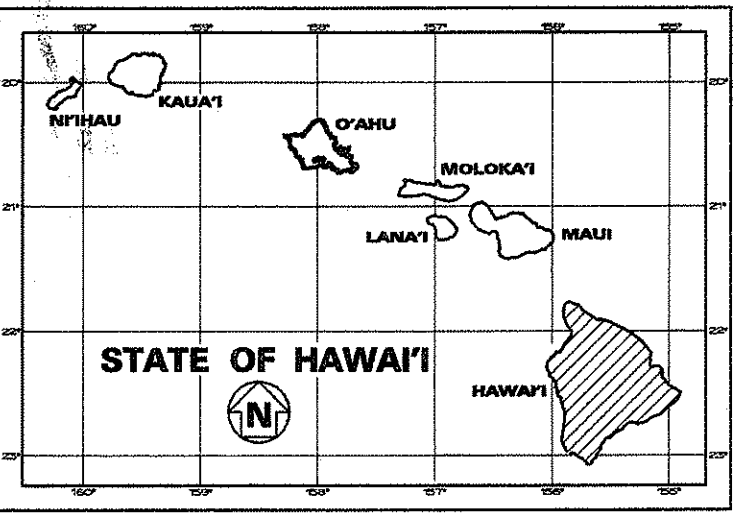


INDEX TO DRAWINGS	
SHEET NO.	DESCRIPTION
1	TITLE SHEET
2	GENERAL NOTES
3	KA'Ū BASEYARD-PLANS AND DETAILS
4	HONOKA'A BASEYARD-PLANS AND DETAILS
5	DETAILS AND NOTES

FED. ROAD DIST. NO.	STATE	PROJ. NO.	FISCAL YEAR	SHEET NO.	TOTAL SHEETS
HAWAII	HAW.	HWY-H-10-00M	2000	1	5

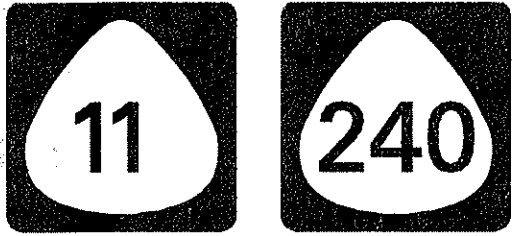

STATE OF HAWAII
DEPARTMENT OF TRANSPORTATION
HIGHWAYS DIVISION
HONOLULU, HAWAII
"AS-BUILT"
PLANS FOR
**KA'Ū AND HONOKA'A BASEYARDS
REPLACE FUEL PUMPS**
PROJECT NO. HWY-H-10-00M
DISTRICT OF KA'Ū AND HĀMĀKUA
ISLAND OF HAWAII

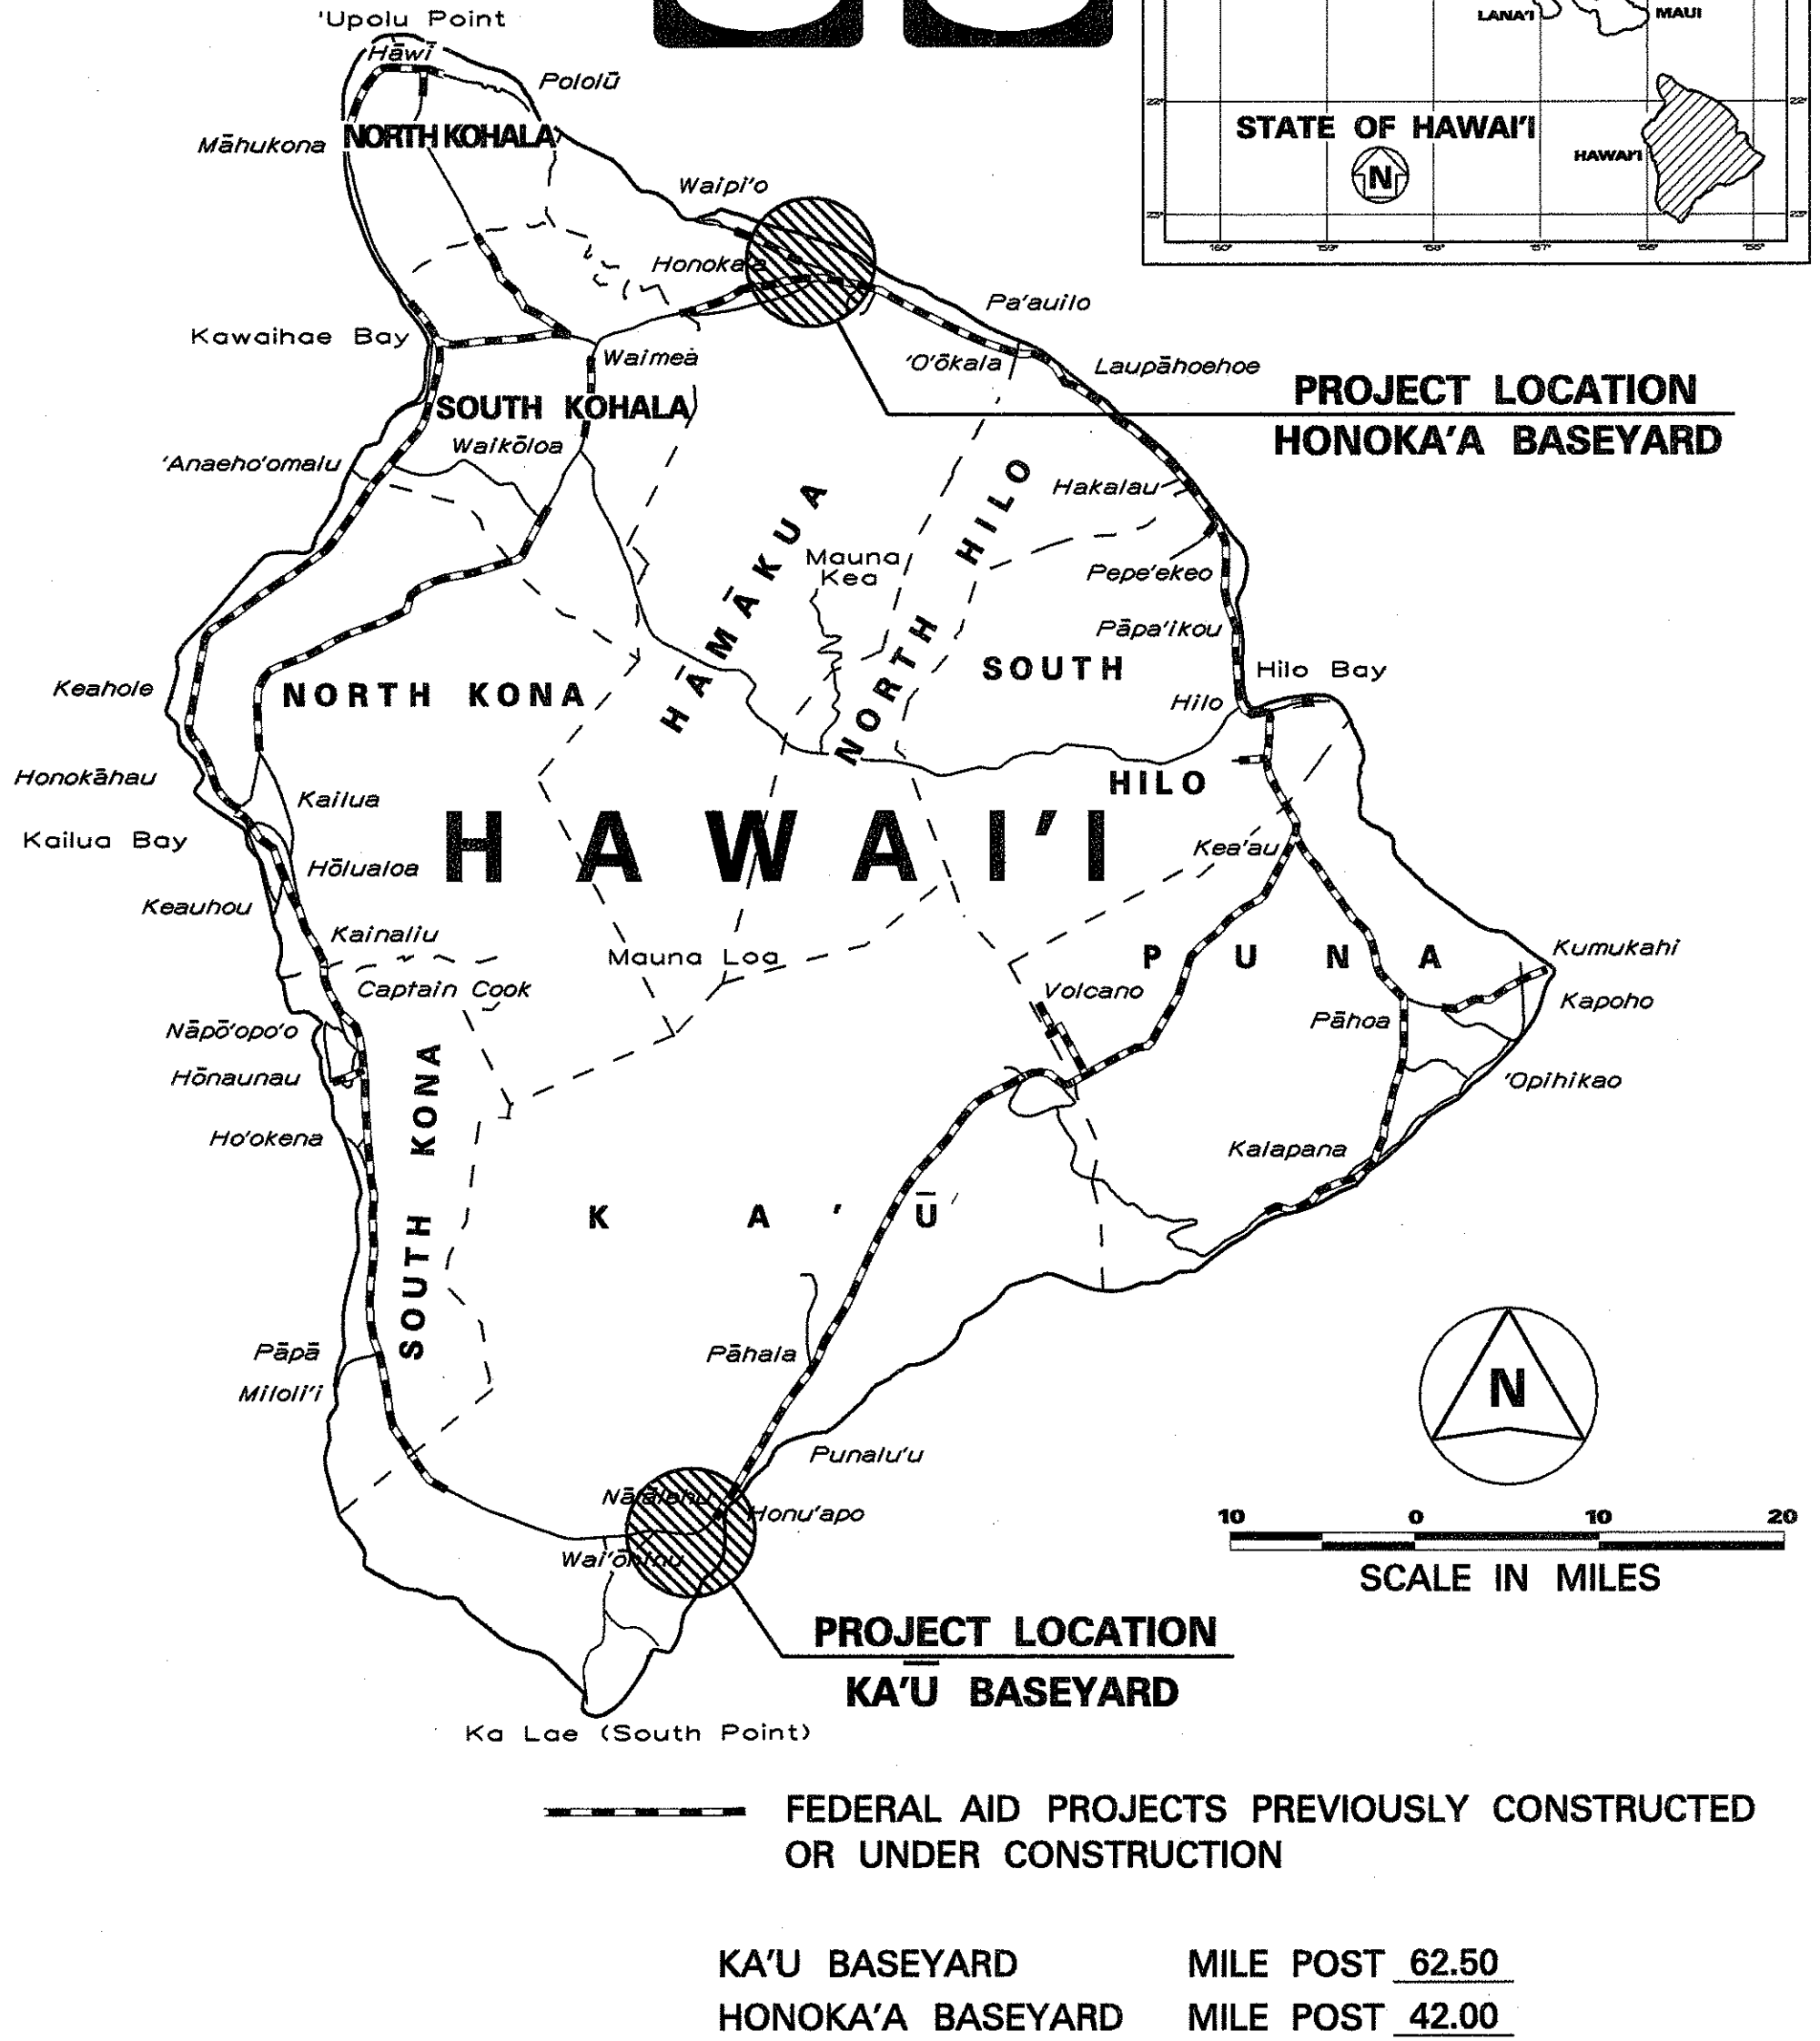

CHANGES MADE DURING CONSTRUCTION HAVE BEEN INCORPORATED ON THESE PLANS EXCEPT CHANGES IN THE ORIGINAL THEORETICAL QUANTITIES. FOR ACTUAL QUANTITIES, REFER TO PROJECT LEDGER AND/OR COMPUTATION BOOK.

RESIDENT ENGINEER *[Signature]* 4-15-02 DATE

DEPARTMENT OF TRANSPORTATION
STATE OF HAWAII
APPROVED: *[Signature]* 4/15/02
DIR. OF TRANSPORTATION DATE

HAWAII DISTRICT DESIGNED BY ROBERT TAIRA P. S. & E. BY 933-8866 APRIL, 2000 PHONE DATE