


FED. ROAD DIST. NO.	STATE	FED. AID PROJ. NO.	FISCAL YEAR	SHEET NO.	TOTAL SHEETS
HAWAII	HAW.	HWY-H-04-99M	2000	28	73

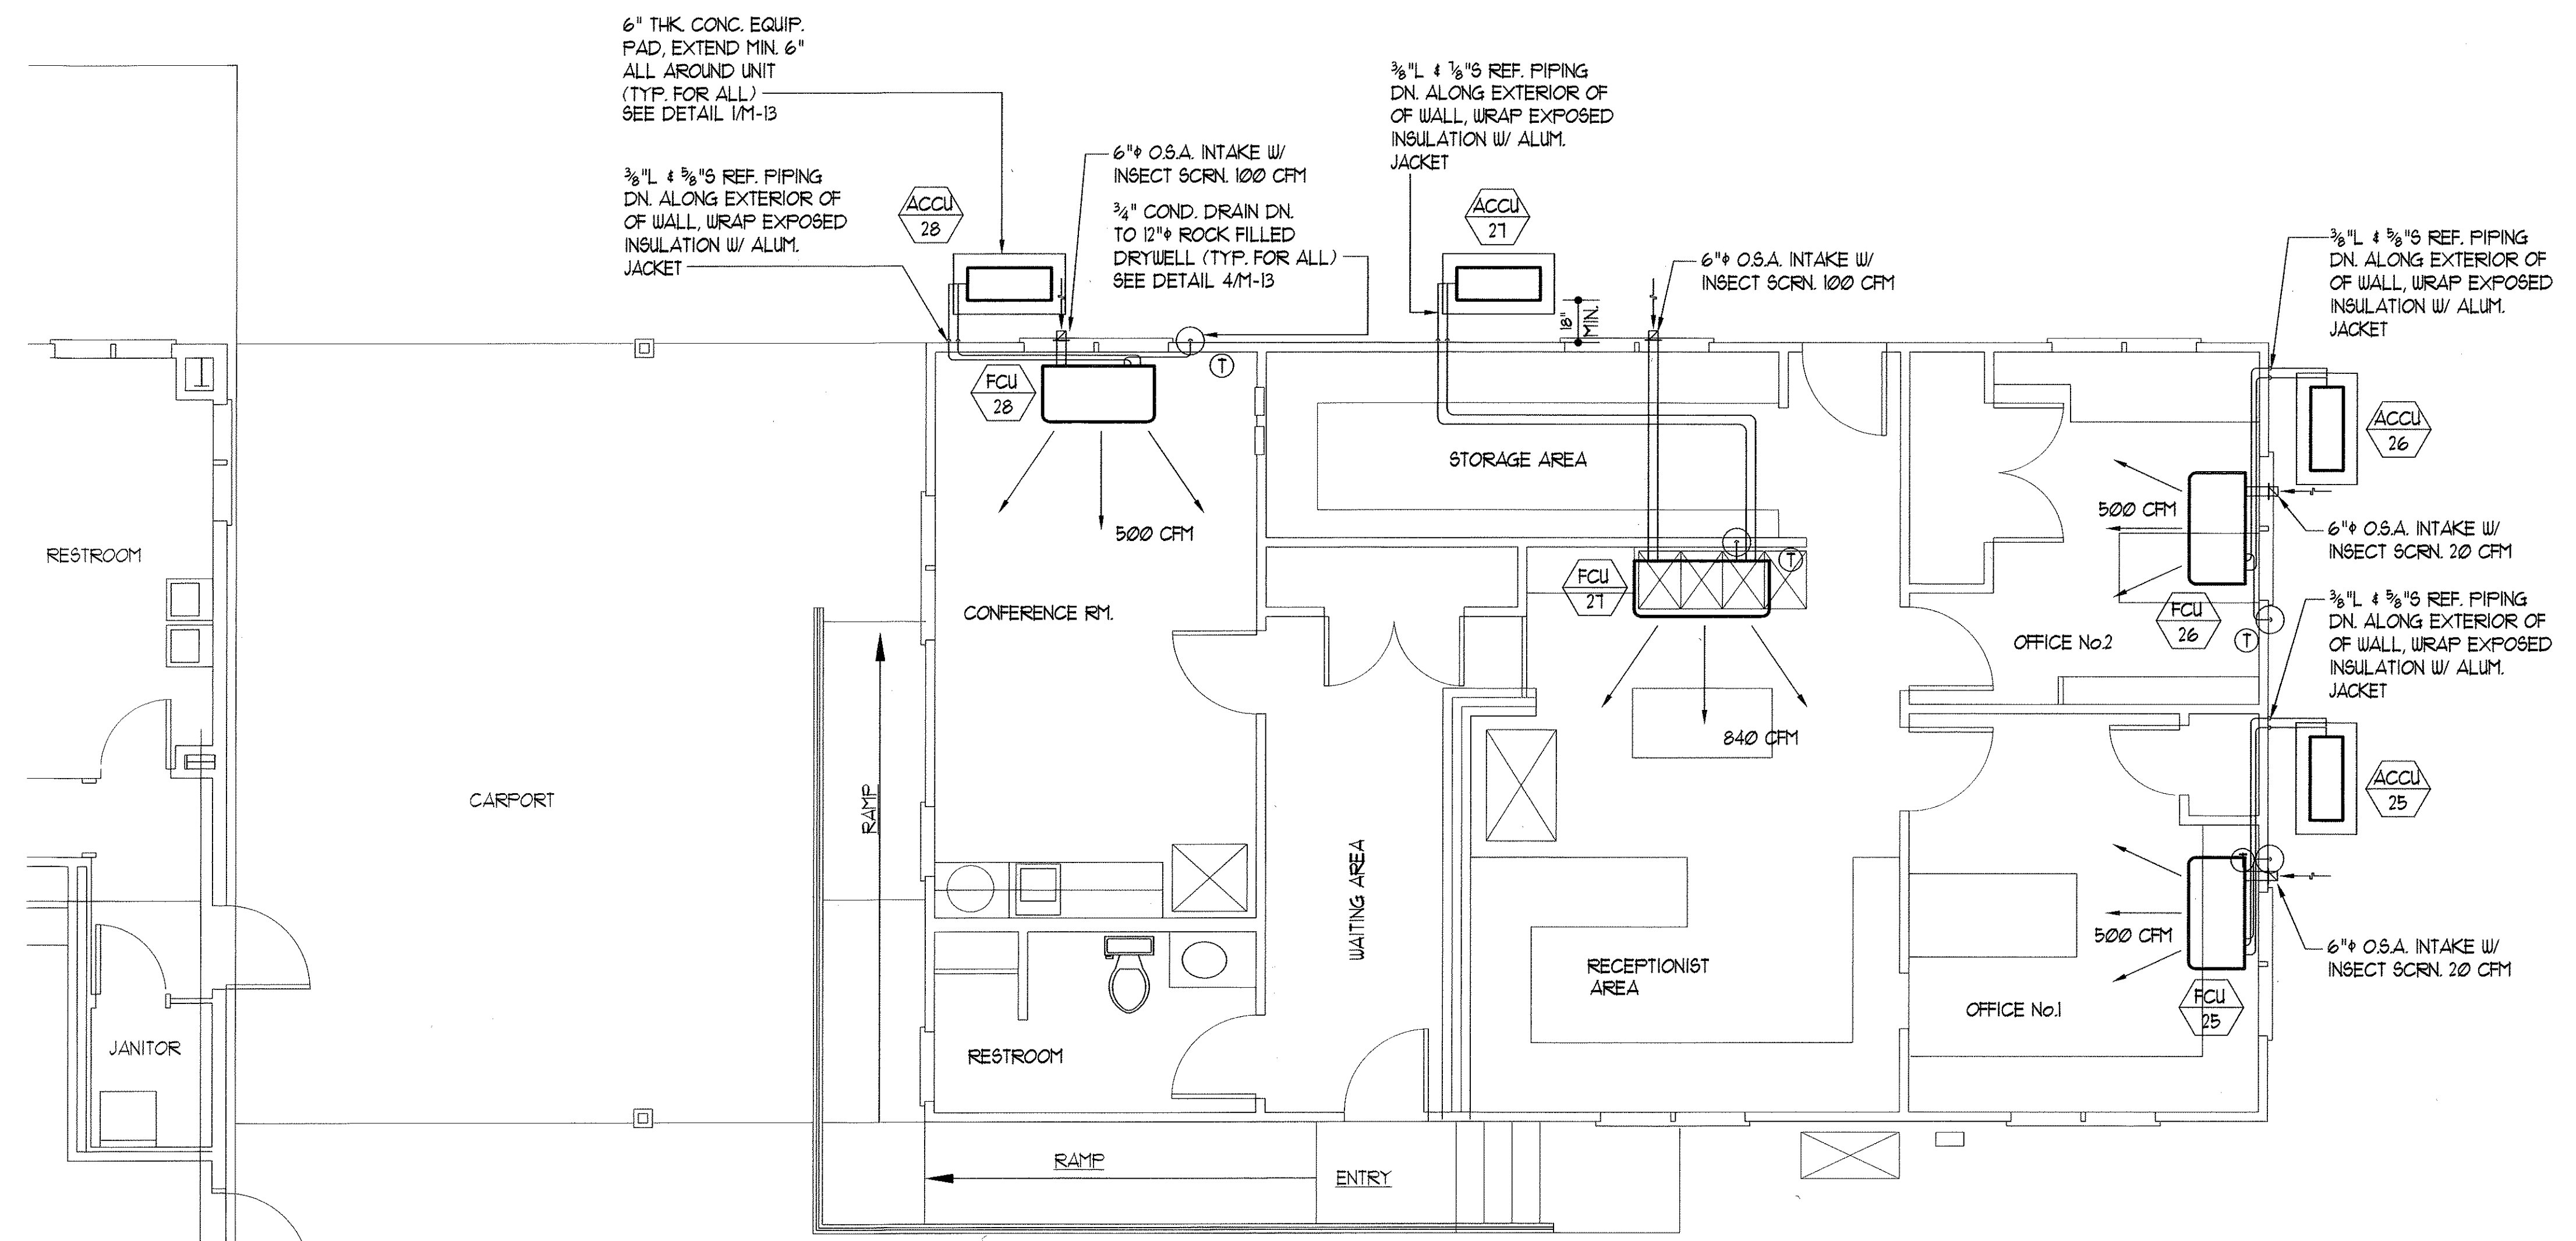

# AIR CONDITIONING PLAN - BUILDING D EXTENSION

SC: 1/4"=1'

ORIGINAL PLAN	DATE
DRAWN BY	
CHECKED BY	
NOTED BY	
NO.	

STATE OF HAWAII  
DEPARTMENT OF TRANSPORTATION  
HIGHWAYS DIVISION

**AIR CONDITIONING PLAN - BUILDING D EXTENSION**

HILO BASEYARD IMPROVEMENTS

PROJECT NO. HWY-H-04-99M

Scale: Noted Date: May 2000

DWG. No. M-9 SHEET No. 1 OF 1 SHEETS