


FED. ROAD DIST. NO.	STATE	FED. AID PROJ. NO.	FISCAL YEAR	SHEET NO.	TOTAL SHEETS
HAWAII	HAW.	HWY-H-04-99M	2000	23	73

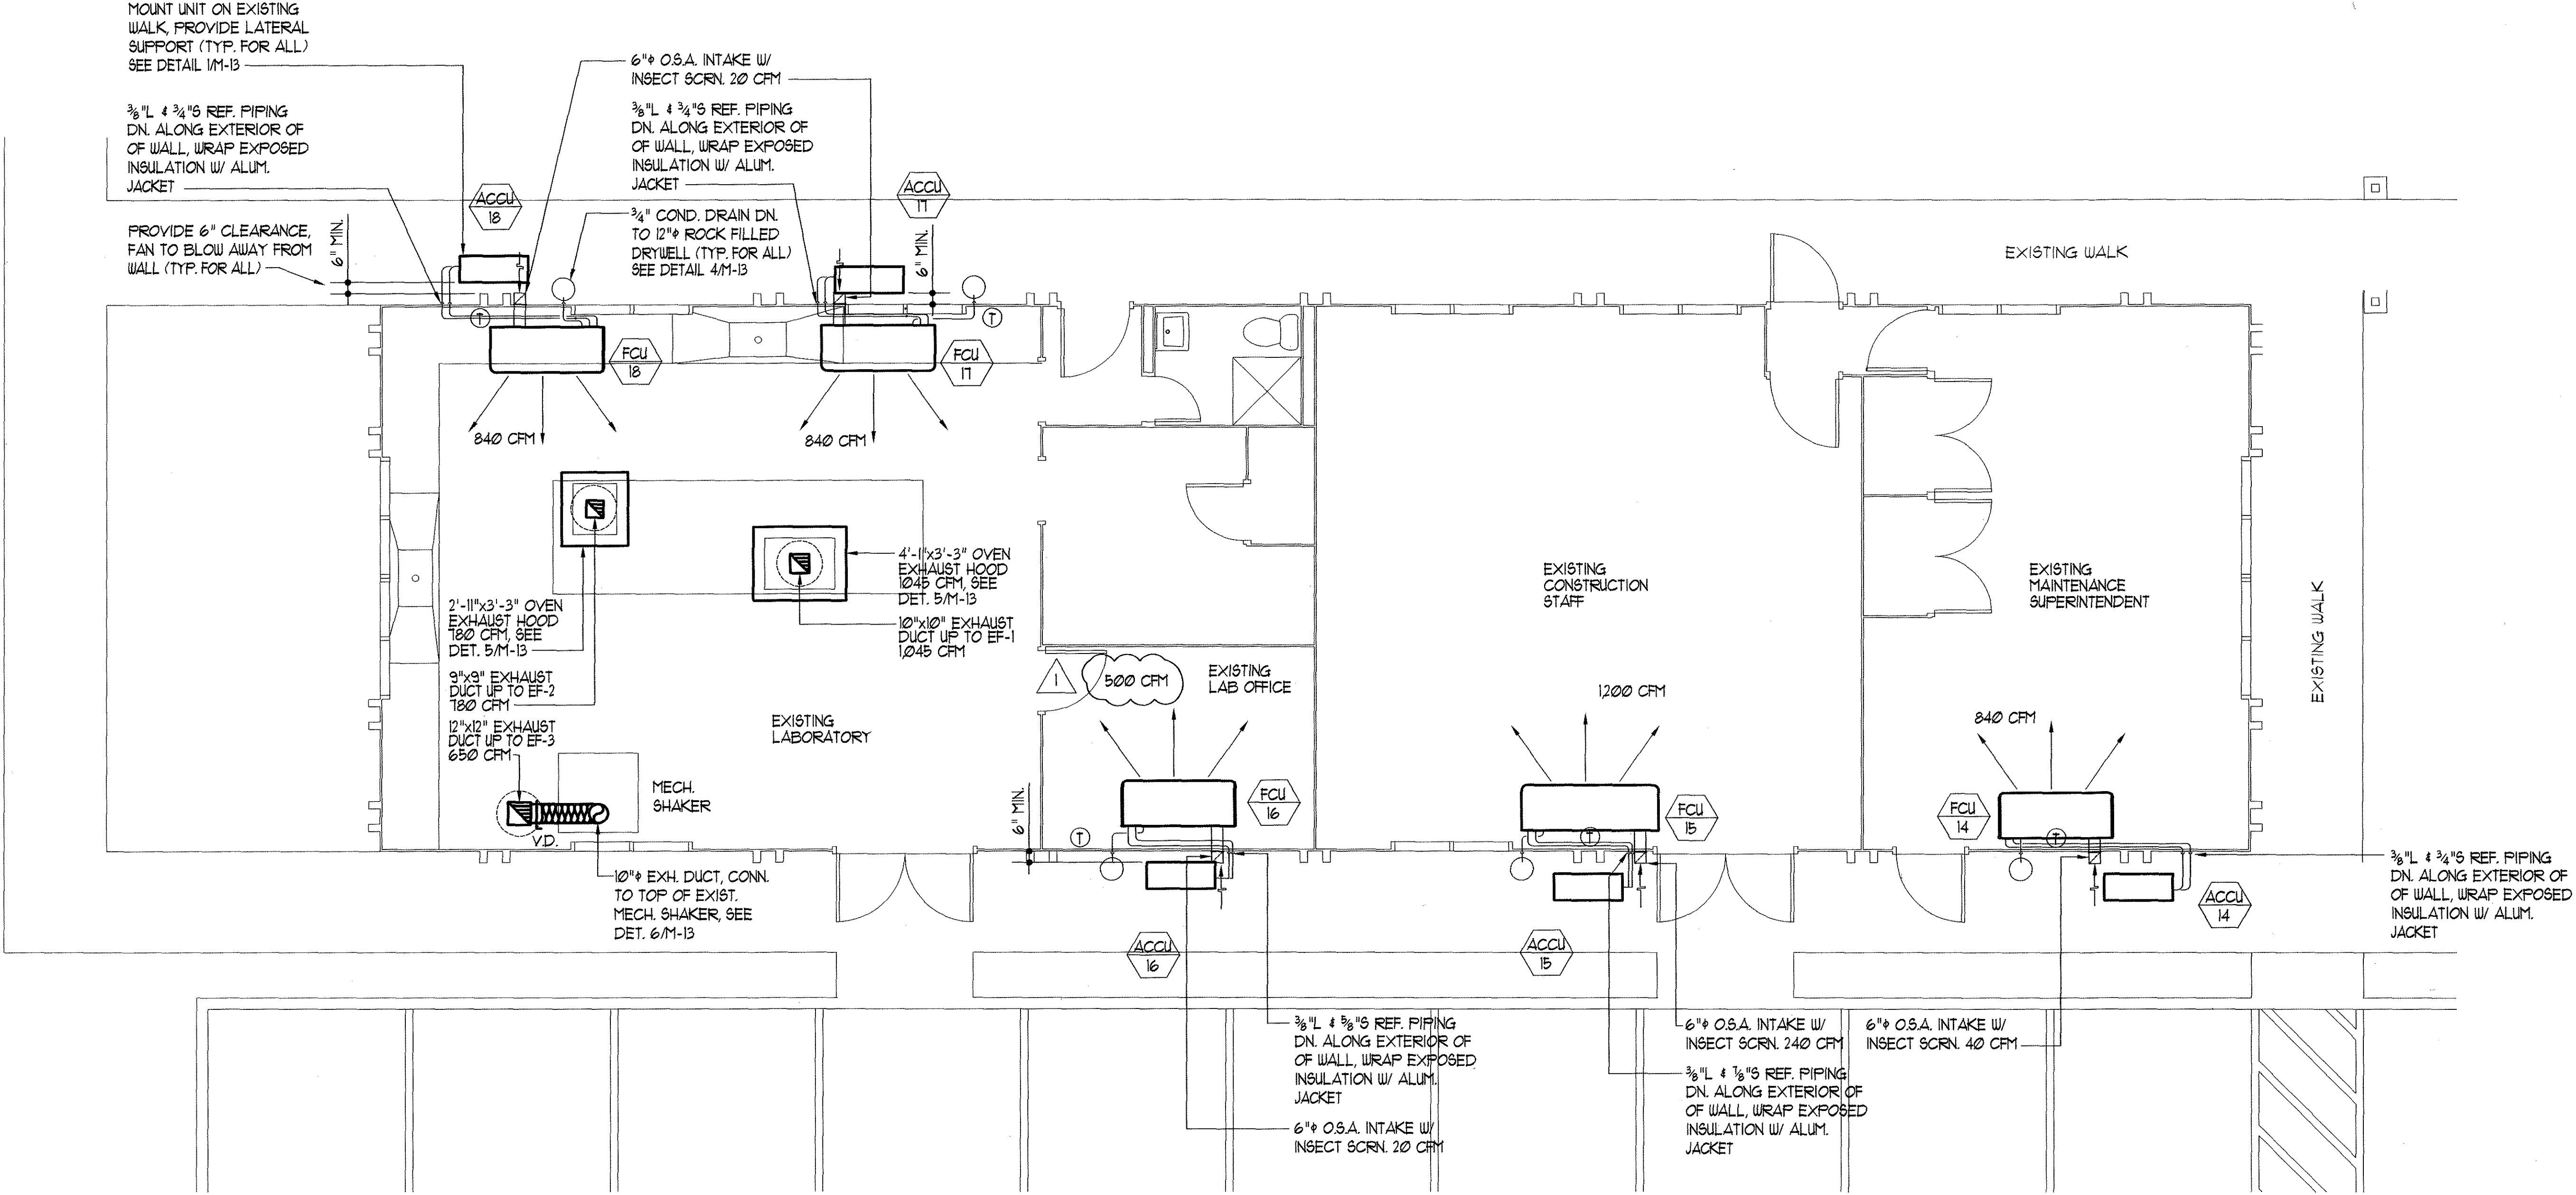


SURVEY PLOTTED BY	DATE
DRAWN BY	
TRACED BY	
QUANTITIES BY	
CHECKED BY	
ORIGINAL PLAN	
NOTE BOOK	
No.	

AIR CONDITIONING PLAN - LAB

SC: 1/4"=1'

6/12/00 Revised Cfm

Date Revision

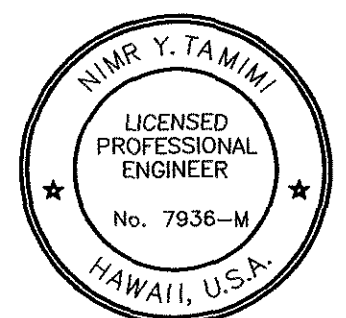

THIS WORK WAS PREPARED BY ME OR UNDER MY SUPERVISION

STATE OF HAWAII
DEPARTMENT OF TRANSPORTATION
HIGHWAYS DIVISION
AIR CONDITIONING PLAN - LAB
HILO BASEYARD IMPROVEMENTS
PROJECT NO. HWY-H-04-99M
Scale: Noted Date: May 2000
SHEET No. 1 OF 1 SHEETS

DWG. No. M-4