


FED. ROAD DIST. NO.	STATE	FED. AID PROJ. NO.	FISCAL YEAR	SHEET NO.	TOTAL SHEETS
HAWAII	HAW.	HWY-H-04-99M	2000	25	73

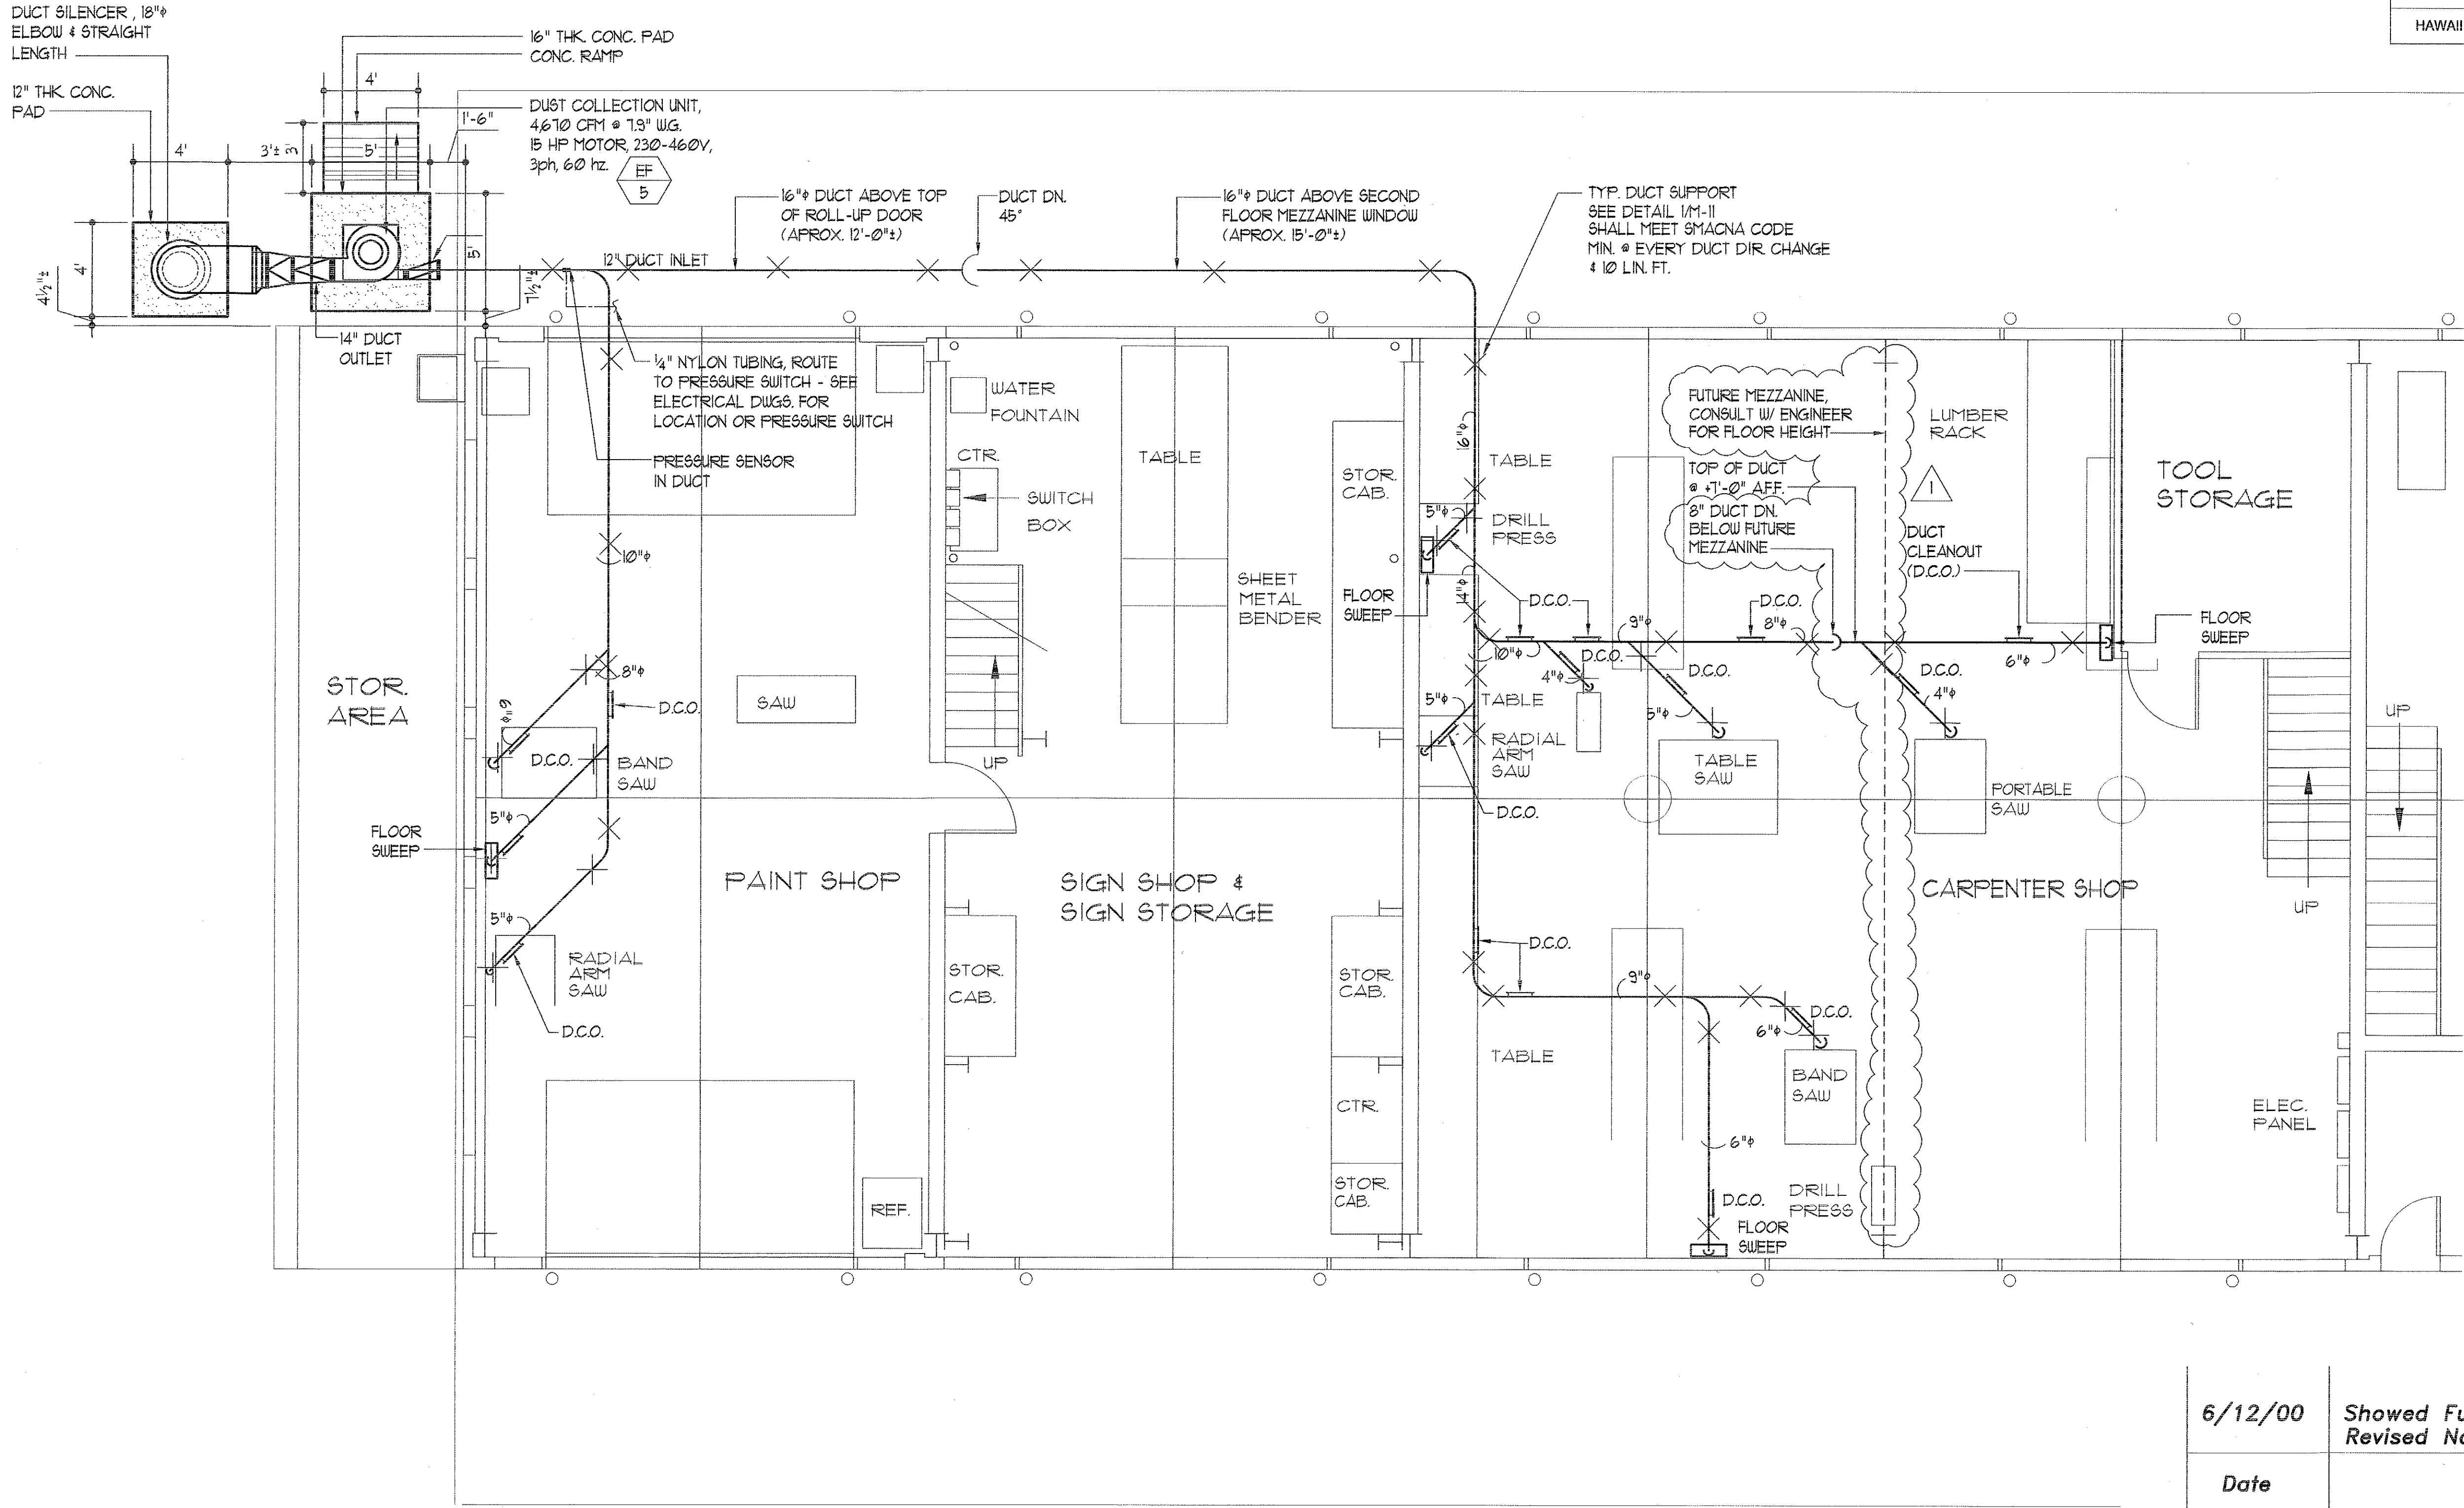

DESIGNED BY	DATE
NOTED BY	
CHECKED BY	
ORIGINAL PLAN	
NOTE BOOK	
No.	

DUST COLLECTION SYSTEM PLAN - BUILDING C
 SC: 1/4"=1'

6/12/00	Showned Future Mezzanine Floor Line and Revised Notes
Date	Revision

THIS WORK WAS PREPARED BY ME OR UNDER MY SUPERVISION

[Signature]

STATE OF HAWAII
 DEPARTMENT OF TRANSPORTATION
 HIGHWAYS DIVISION

DUST COLLECTION SYSTEM PLAN - BUILDING C

HILO BASEYARD
 IMPROVEMENTS

PROJECT NO. HWY-H-04-99M

Scale: Noted Date: May 2000

SHEET No. 1 OF 1 SHEETS

DWG. No. M-6