

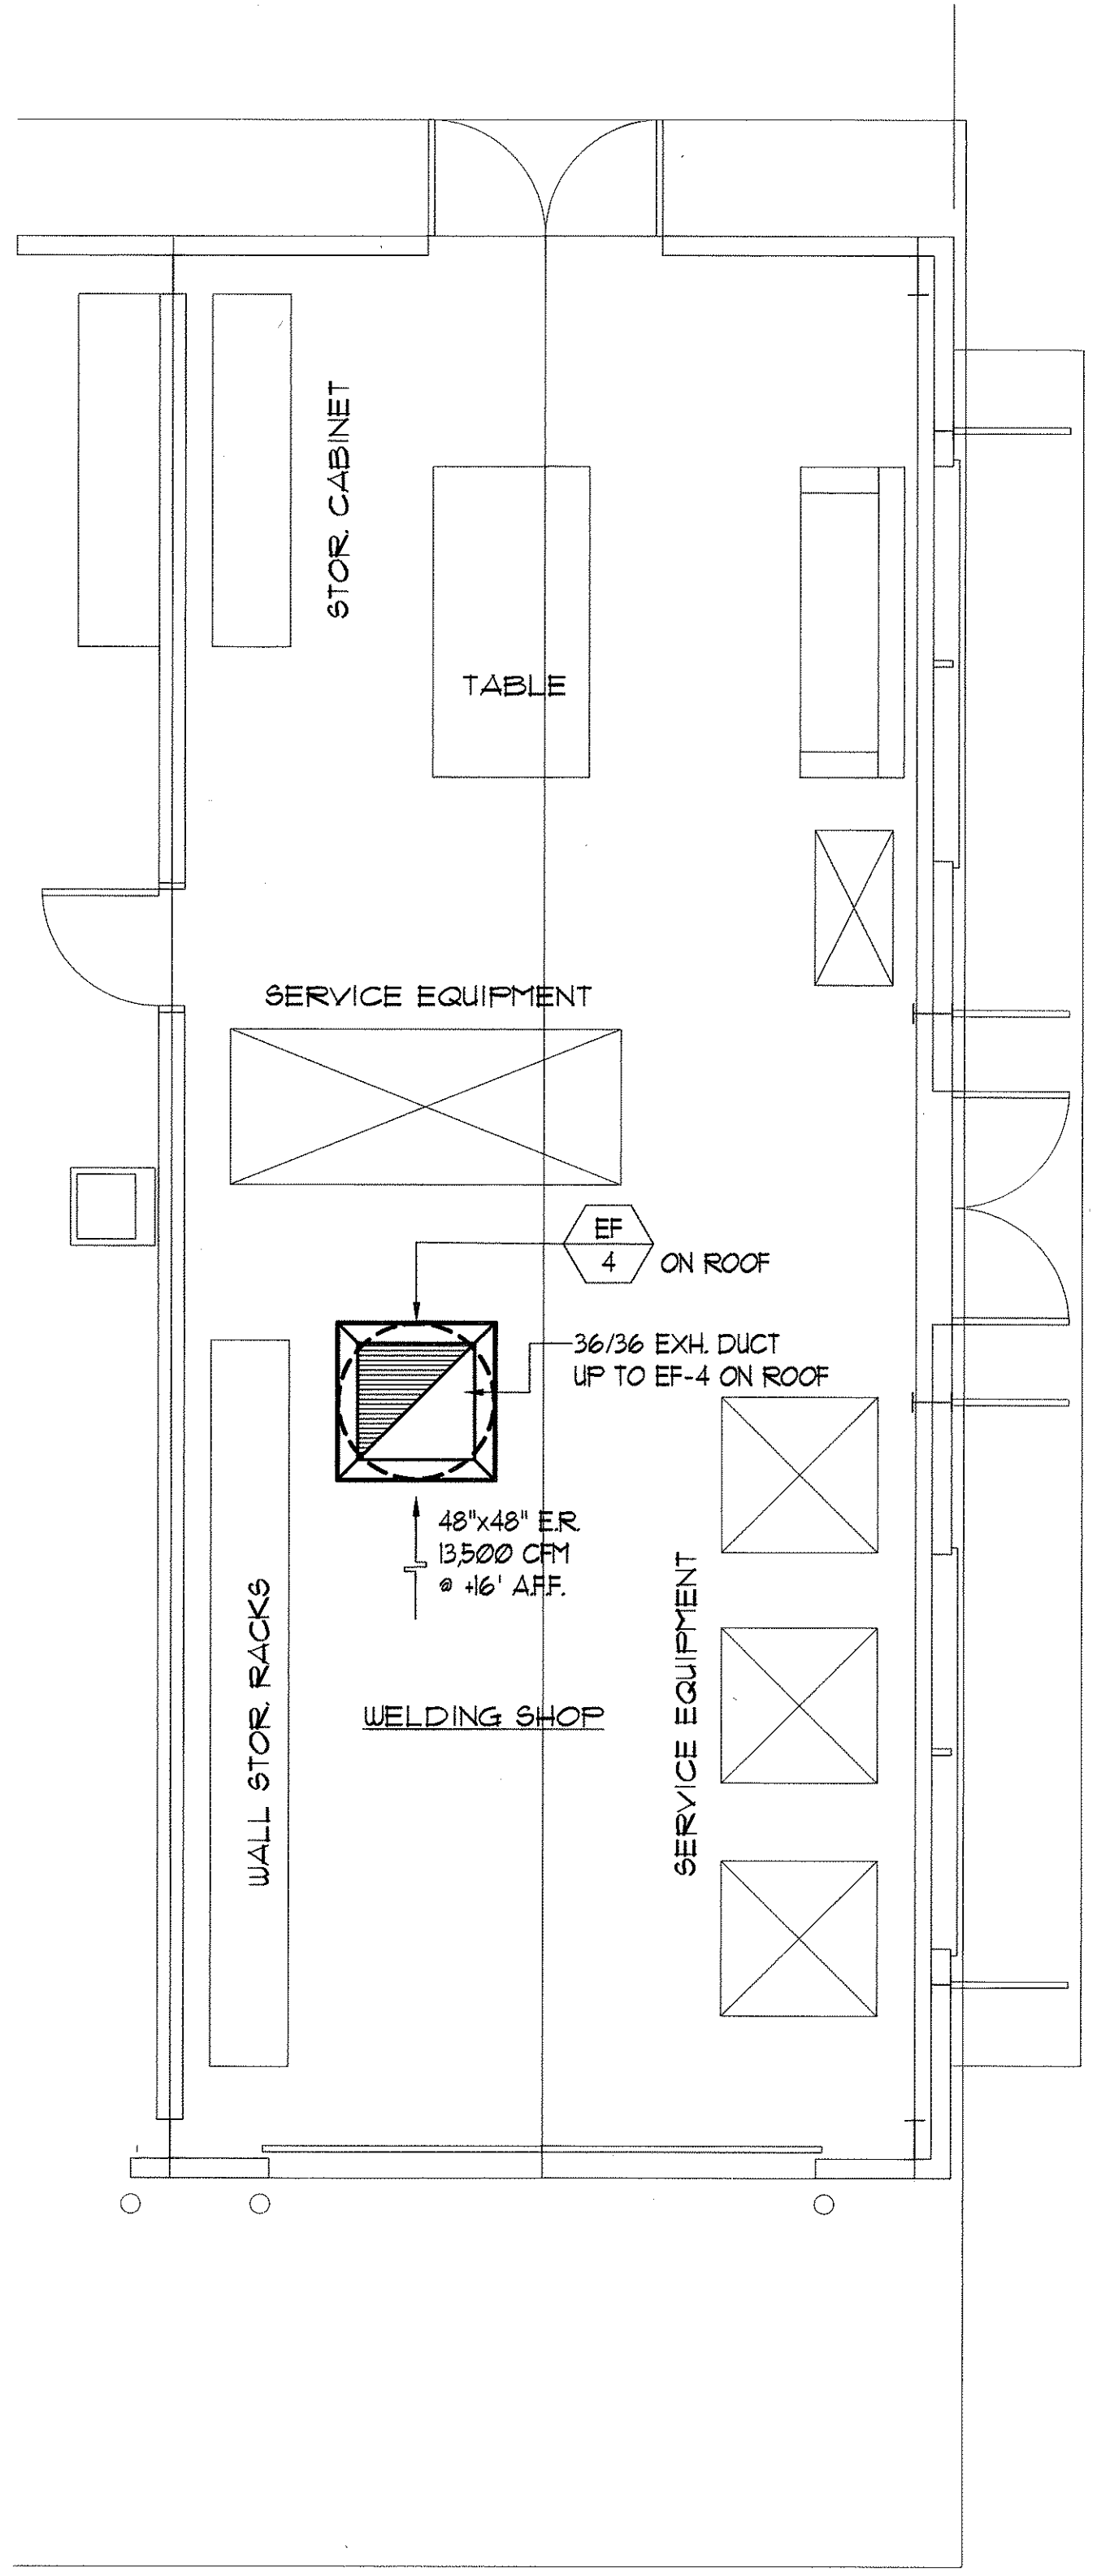


FED. ROAD DIST. NO.	STATE	FED. AID PROJ. NO.	FISCAL YEAR	SHEET NO.	TOTAL SHEETS
HAWAII	HAW.	HWY-H-04-99M	2000	24	73

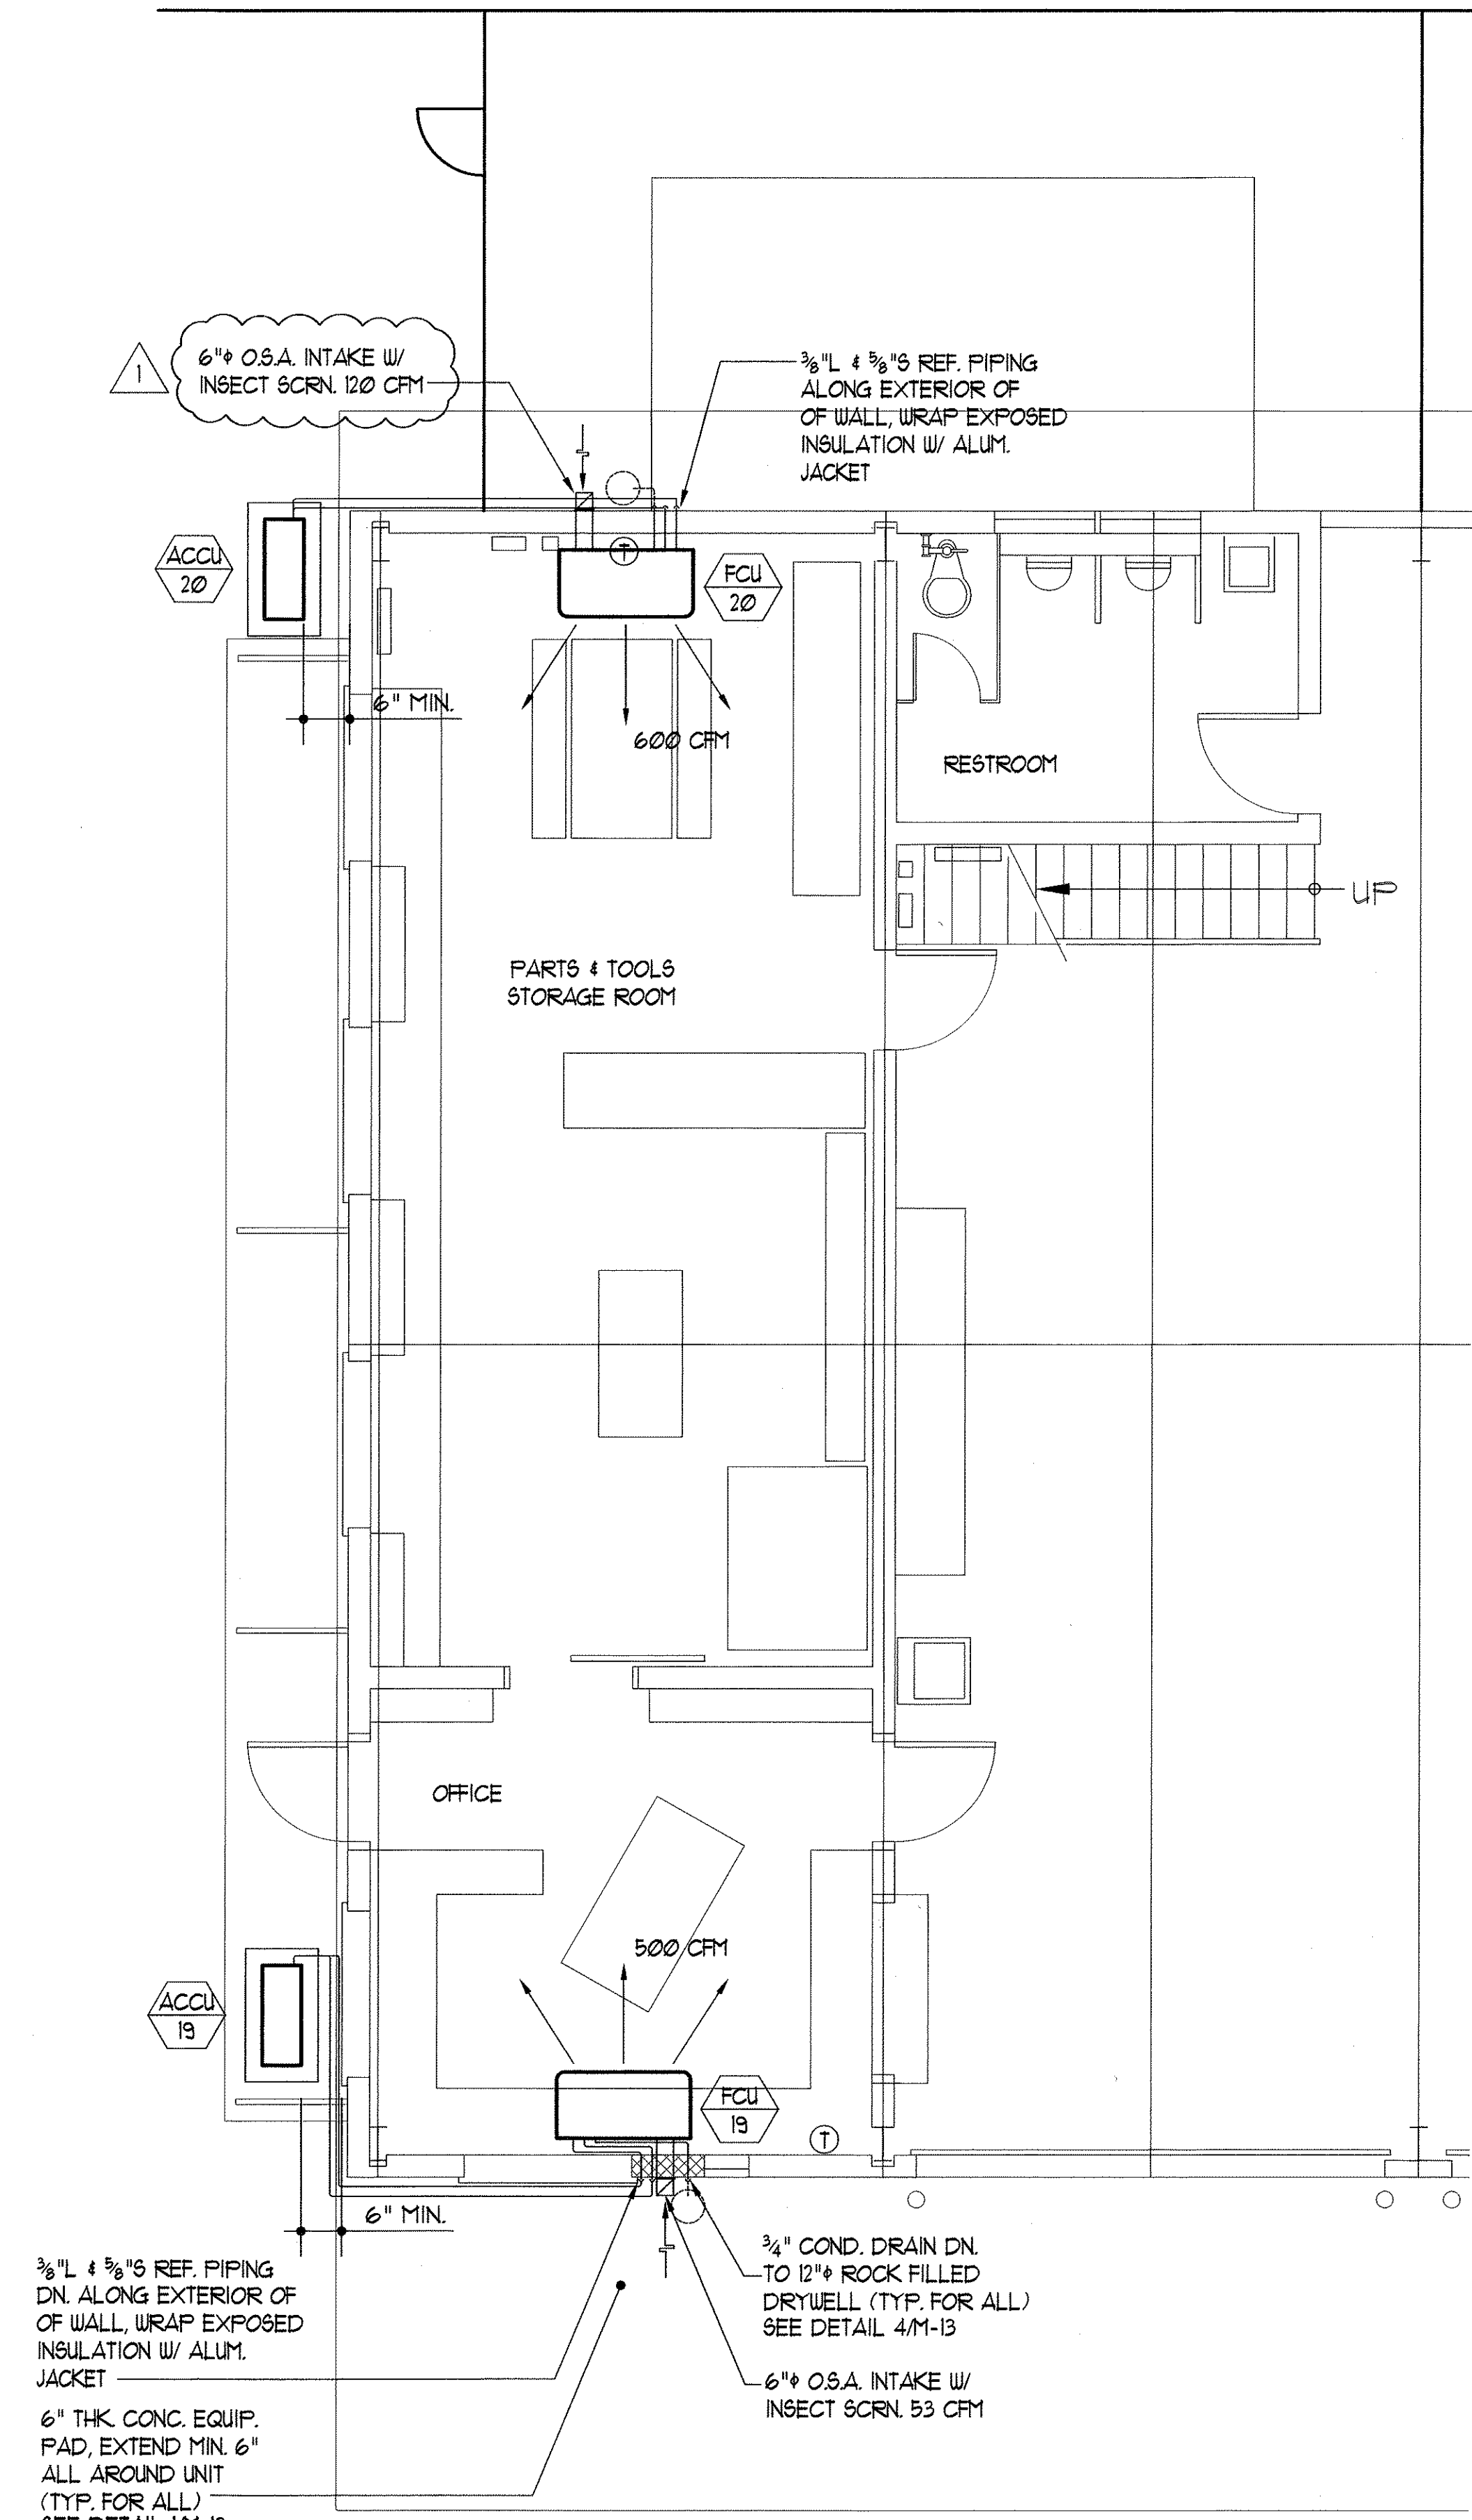

PARTIAL AIR CONDITIONING PLAN - STREET LEVEL - BUILDING B
 SCALE: 1/4"=1'-0"

6/12/00	Revised Cfm
Date	Revision

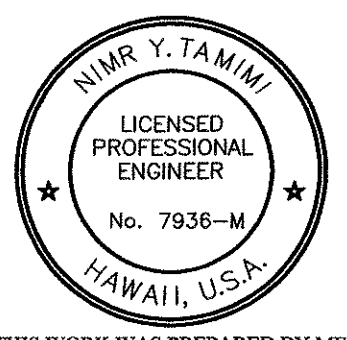

THIS WORK WAS PREPARED BY ME OR UNDER MY SUPERVISION

[Signature]

STATE OF HAWAII
 DEPARTMENT OF TRANSPORTATION
 HIGHWAYS DIVISION
PARTIAL AIR CONDITIONING PLAN - STREET LEVEL - BUILDING B
 HILO BASEYARD IMPROVEMENTS
 PROJECT NO. HWY-H-04-99M
 Scale: Noted Date: May 2000
 SHEET No. 1 OF 1 SHEETS

DWG. No. **M-5**