




PARTIAL AIR CONDITIONING PLAN - UPPER LEVEL - BUILDING C

ALL STANDS & SUPPORTS SHALL BE HOT 2000 26 HWY-H-04-99M DIPPED GALY, AFTER FABRICATION, DUST COLLECTOR STAND SHALL BE PAINTED AT THE FACTORY W/ PAINT SYSTEM TO MEET 500 HR. SALT SPRAY SIMILAR TO DUST COLLECTION UNIT PAINT SYSTEM. -FLEX CONN. ---16" PEXH. DUCT 18" PELBOW DUCT SILENCER W/2" THK, INSULATION DUST COLLECTION UNIT 18" DUCT SILENCER W/6" THK INSULATION DUST COLLECTION UNIT STAND 55 GAL. DRUM --BASE PLATE & ANCHOR BOLTS 1/2" PRE-MOLDED BY DUST COLLECTION SYSTEM JOINT FILLER W/ SEALANT -SUPPORT FRAME, SEE — ¾" THK NON-SHRINK, NON-METALLIC DETAIL THIS SHEET LEVELING GROUT ---FINISH GRADE 3" CLEAR -- UNDISTURBED FIRM MATERIAL #4 @ 12" O.C. MAX. - COMPACT STRUCT, FILL E.W. TOP & BOTTOM -

DUST COLLECTION UNIT ELEVATION

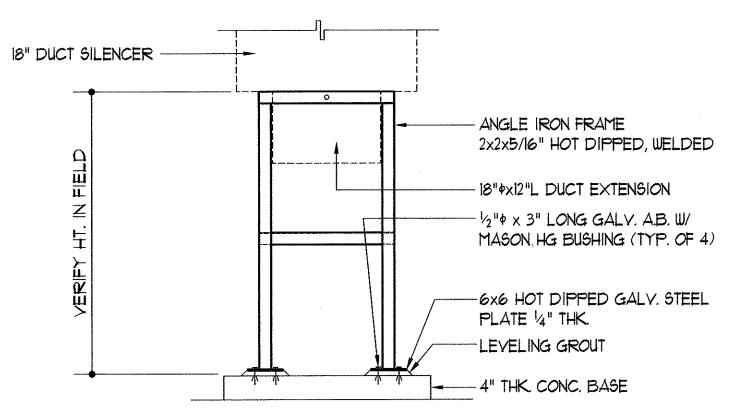

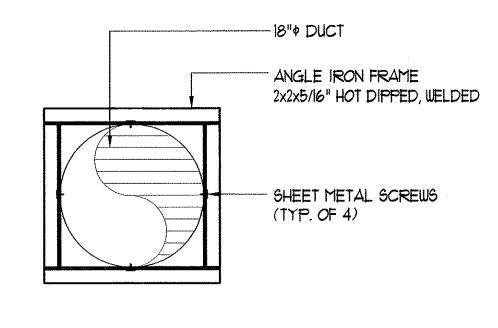

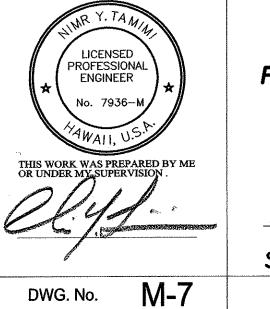

STATE OF HAWAI'I DEPARTMENT OF TRANSPORTATION

PARTIAL AIR CONDITIONING PLAN - UPPER LEVEL - BUILDING C

HILO BASEYARD <u>IMPROVEMENTS</u> PROJECT NO. HWY-H-04-99M

Scale: Noted

Date: May 2000 SHEET No. 1 OF 1 SHEETS

FISCAL YEAR

SHEET

NO.

FED. AID PROJ. NO.

FED. ROAD

DIST. NO.

STATE

SUPPORT FRAME DETAIL NOT TO SCALE

1/8"="-0"

26