

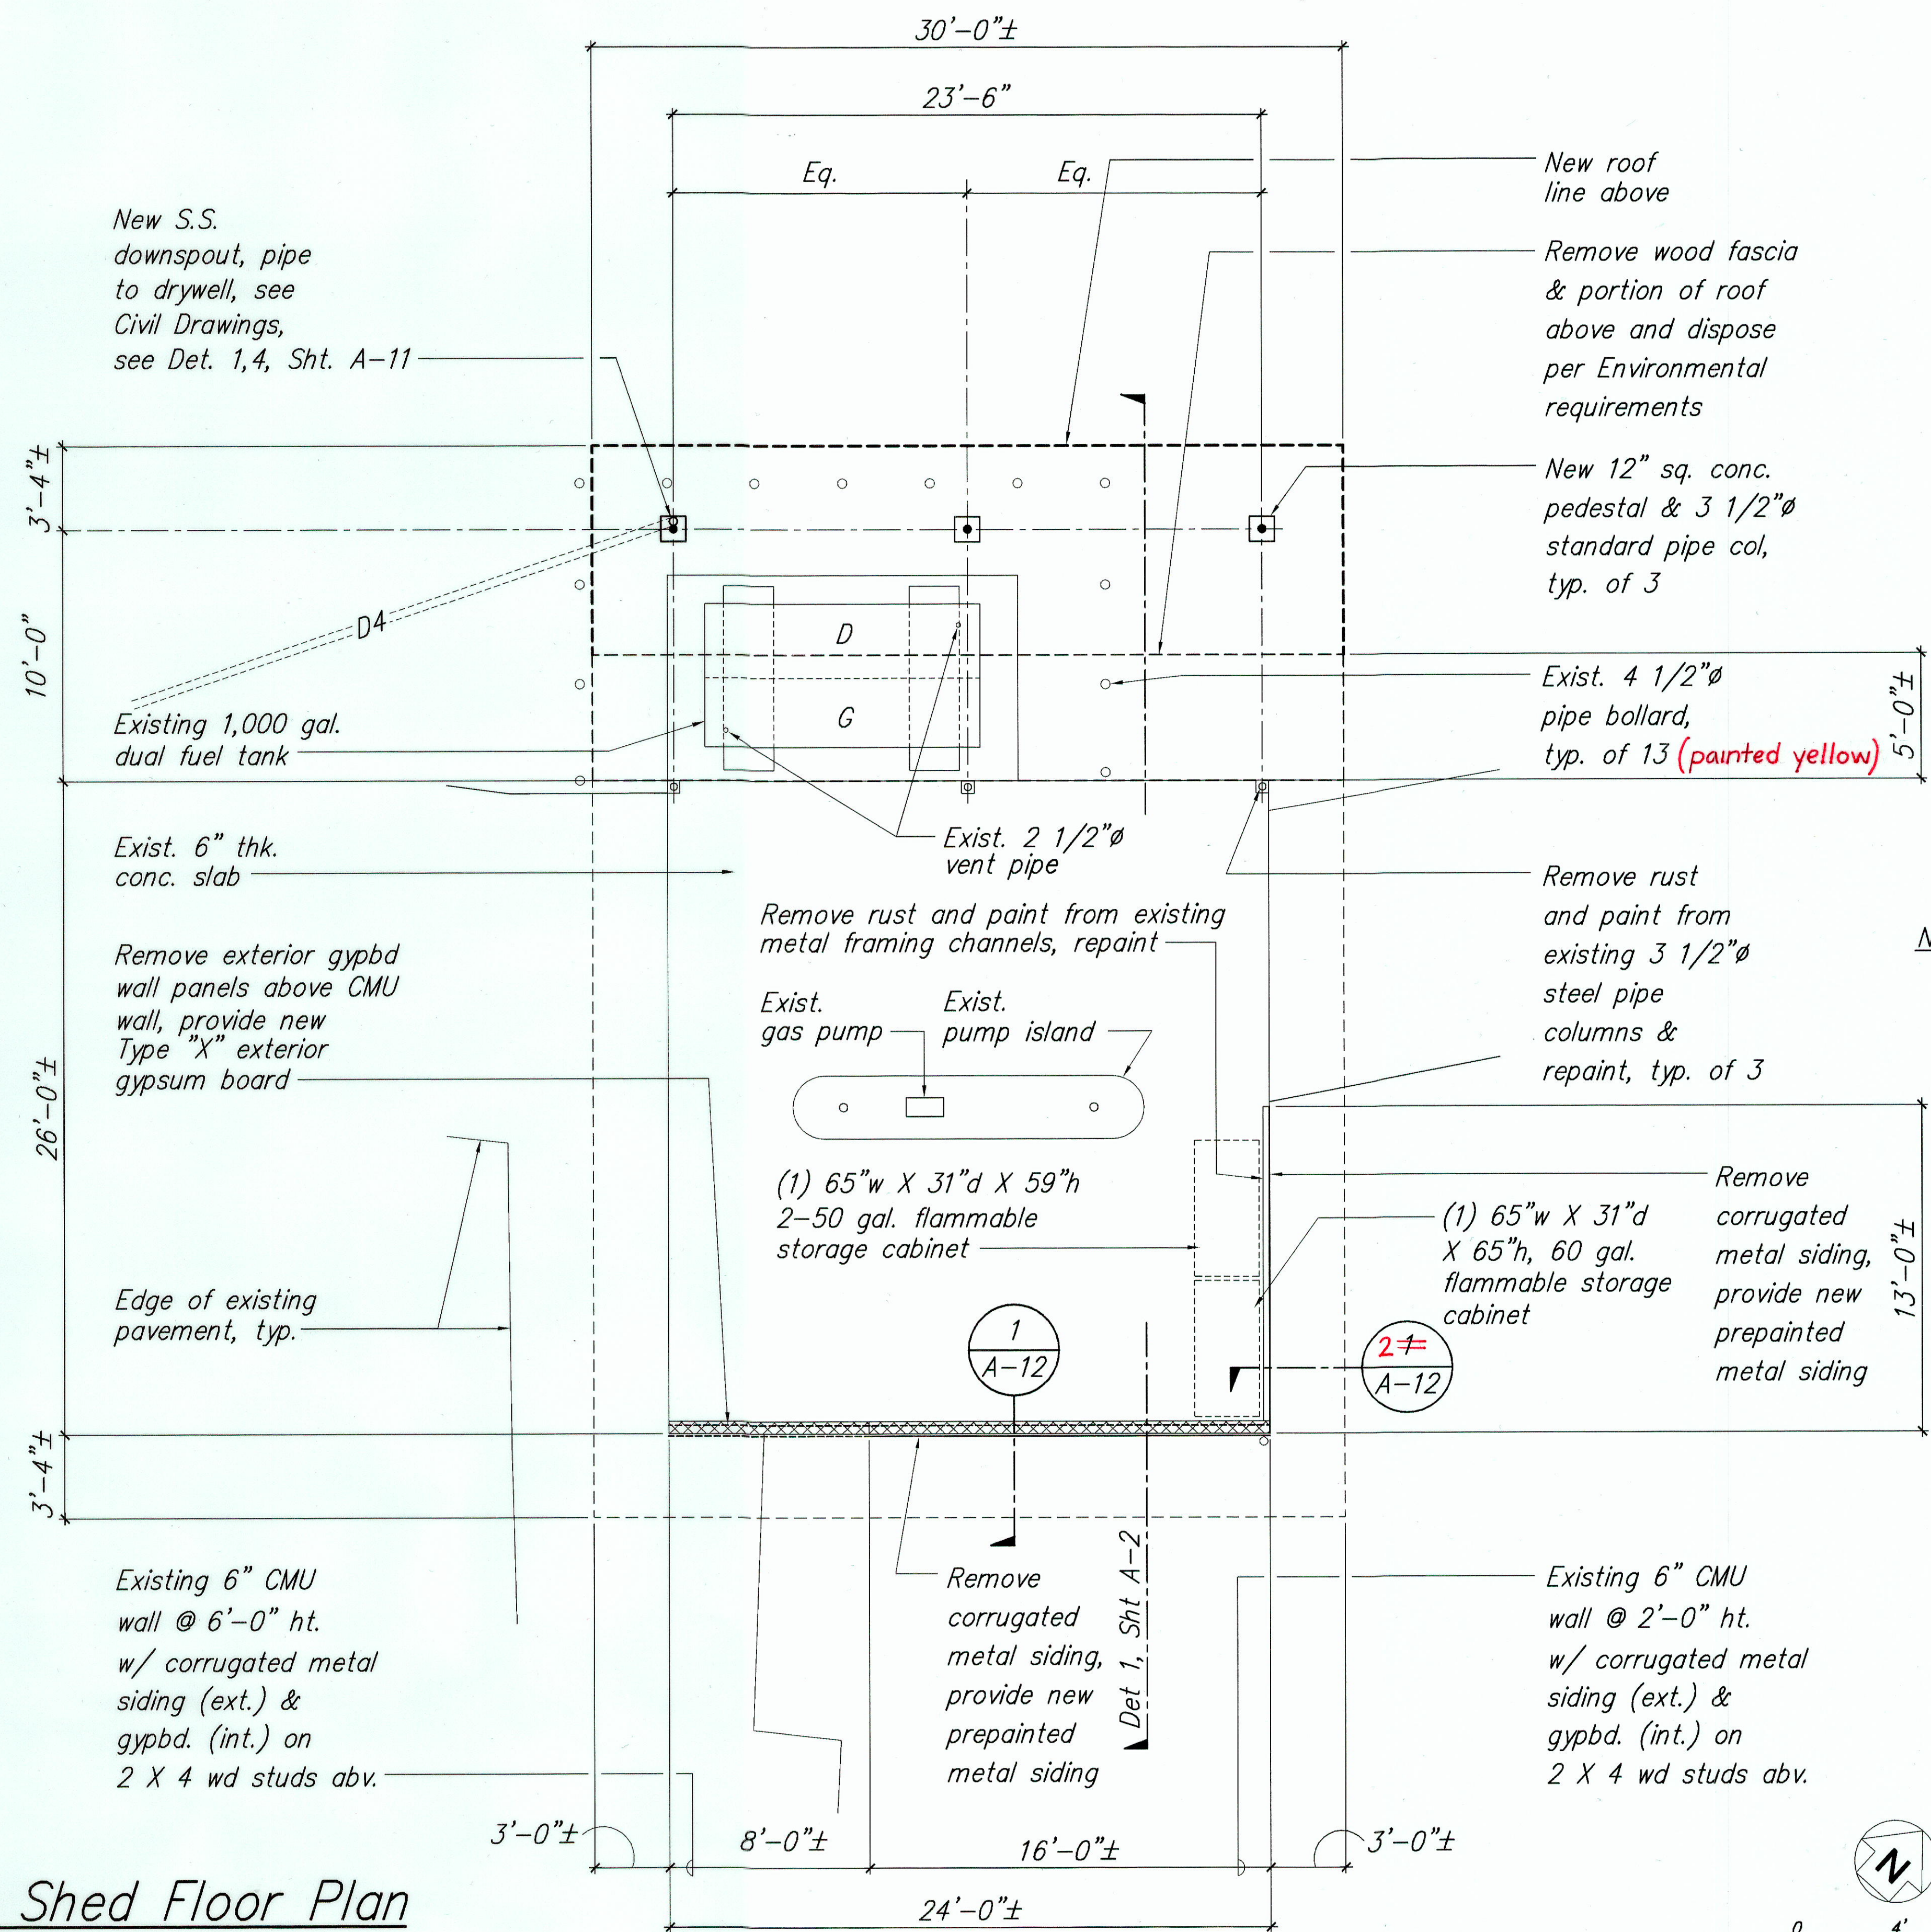


FED. ROAD DIST. NO.	STATE	PROJ. NO.	FISCAL YEAR	SHEET NO.	TOTAL SHEETS
HAWAII	HAW.	HWY-H-03-02M	2003	12	53

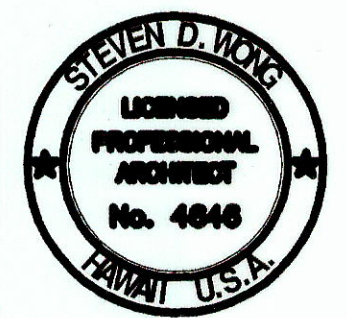

- Note:**
1. All Removal of paint and building material shall be performed in accordance with Environmental requirements.
 2. All structural wood members required for the extension of the roof shall be of noncombustible fire-retardant-treated wood.
 3. Refer to Civil Site Plan for location of building on site.
 4. All existing exposed building materials to remain (including walls, columns, beams, roofing components, etc.) shall be painted as indicated in the Specifications. All new building materials and also existing materials to be removed and replaced with new shall be painted in accordance with the Specifications.

Gas Pump Shed Floor Plan
 Scale: 1/4" = 1'-0"

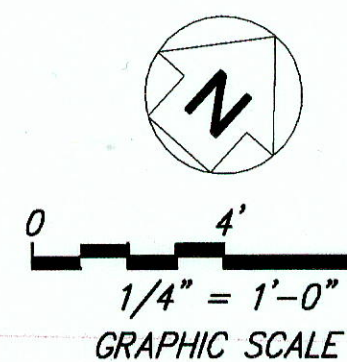

THIS WORK WAS PREPARED BY ME OR UNDER MY SUPERVISION
 Steven D. Wong
 MITSUNAGA & ASSOCIATES

STATE OF HAWAII
 DEPARTMENT OF TRANSPORTATION
 HIGHWAYS DIVISION

GAS PUMP SHED FLOOR PLAN

NAALEHU BASEYARD RENOVATIONS
 Project No. HWY-H-03-02M


Scale: As Noted Date: April 2003

SHEET No. **A-1** OF **A-12** SHEETS

"AS-BUILT"

FINAL SUBMITTAL

FED. ROAD DIST. NO.	STATE	PROJ. NO.	FISCAL YEAR	SHEET NO.	TOTAL SHEETS
HAWAII	HAW.	HWY-H-03-02M	2003	14	53

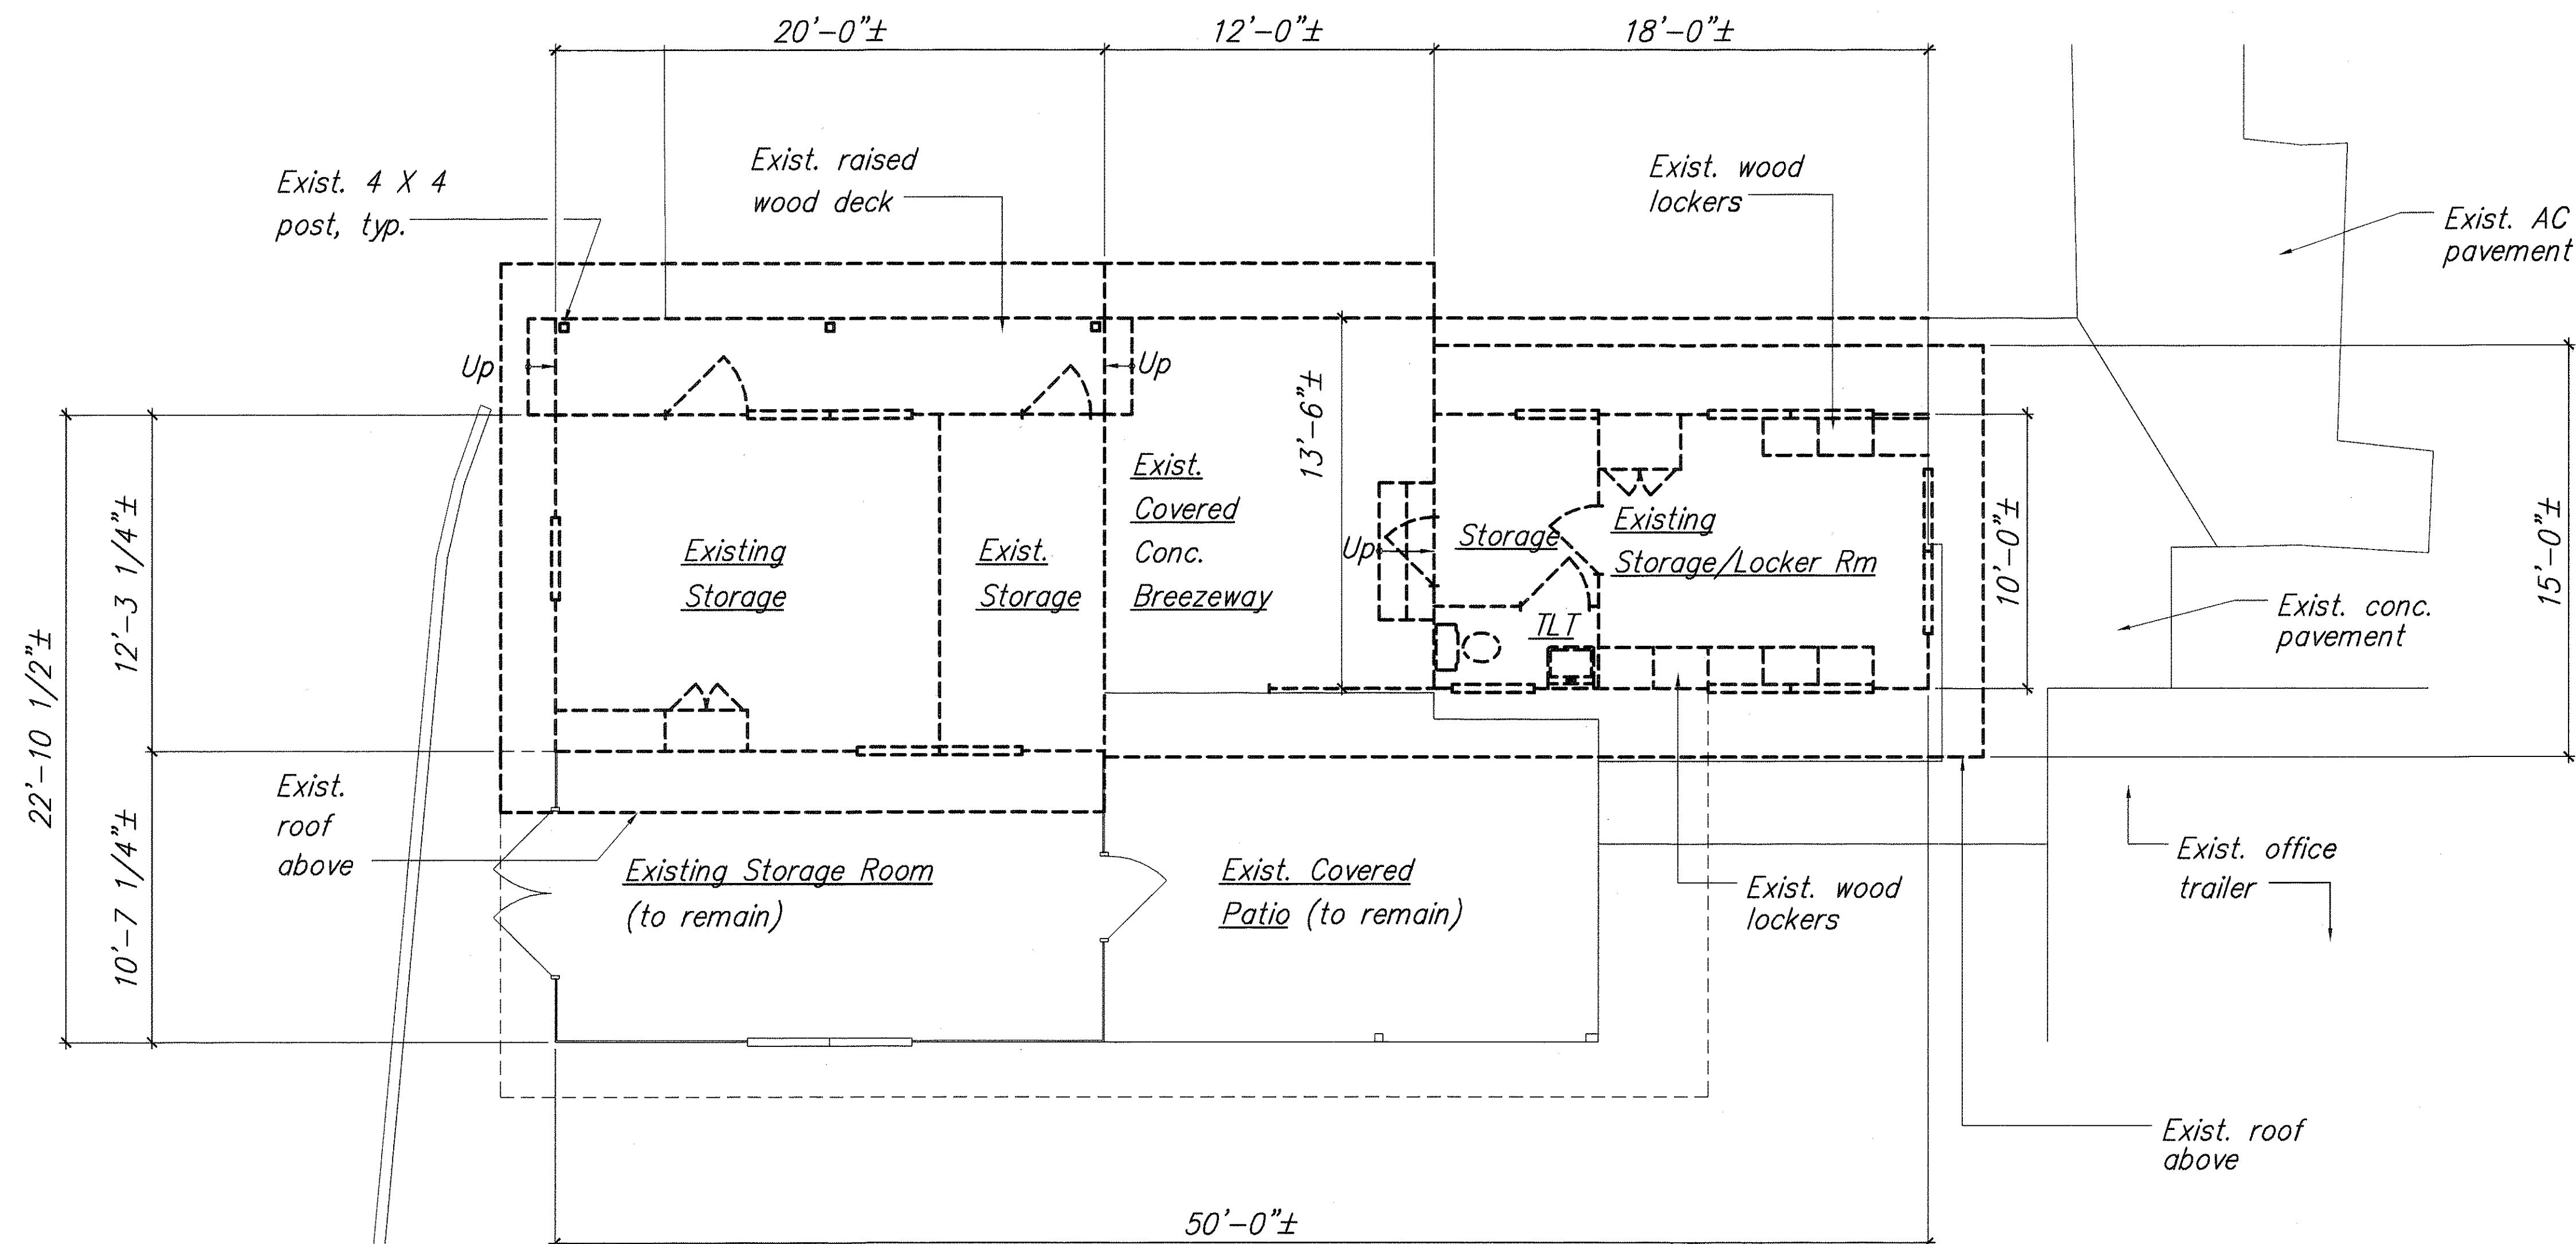

- Note:
1. Demolish partial building in its entirety.
 2. Items to be demolished indicated as bold dashed lines, including concrete slabs within the designated areas. Building materials shall be removed and properly disposed of in accordance with environmental requirements.
 3. Refer to Civil Site Plan for location of building on site.

Field Office/Storage Shed/Breezeway Floor and Demolition Plan

Scale: 1/4" = 1'-0"

ORIGINAL PLAN	SURVEY PLOTTED BY	DATE
NOTE BOOK	DESIGNED BY	
	QUANTITIES BY	
	CHECKED BY	



0 4' 8'
1/4" = 1'-0"
GRAPHIC SCALE




THIS WORK WAS PREPARED BY ME OR
UNDER MY SUPERVISION
Steven D. King
MITSUNAGA & ASSOCIATES


STATE OF HAWAII
DEPARTMENT OF TRANSPORTATION
HIGHWAYS DIVISION
**FIELD OFFICE/STORAGE
SHED/BREEZEWAY
FLOOR & DEMOLITION PLAN**
NAALEHU BASEYARD RENOVATIONS
Project No. HWY-H-03-02M

Scale: As Noted Date: April 2003
SHEET No. **A-3** OF **A-12** SHEETS

FED. ROAD DIST. NO.	STATE	PROJ. NO.	FISCAL YEAR	SHEET NO.	TOTAL SHEETS
HAWAII	HAW.	HWY-H-03-02M	2003	17	53

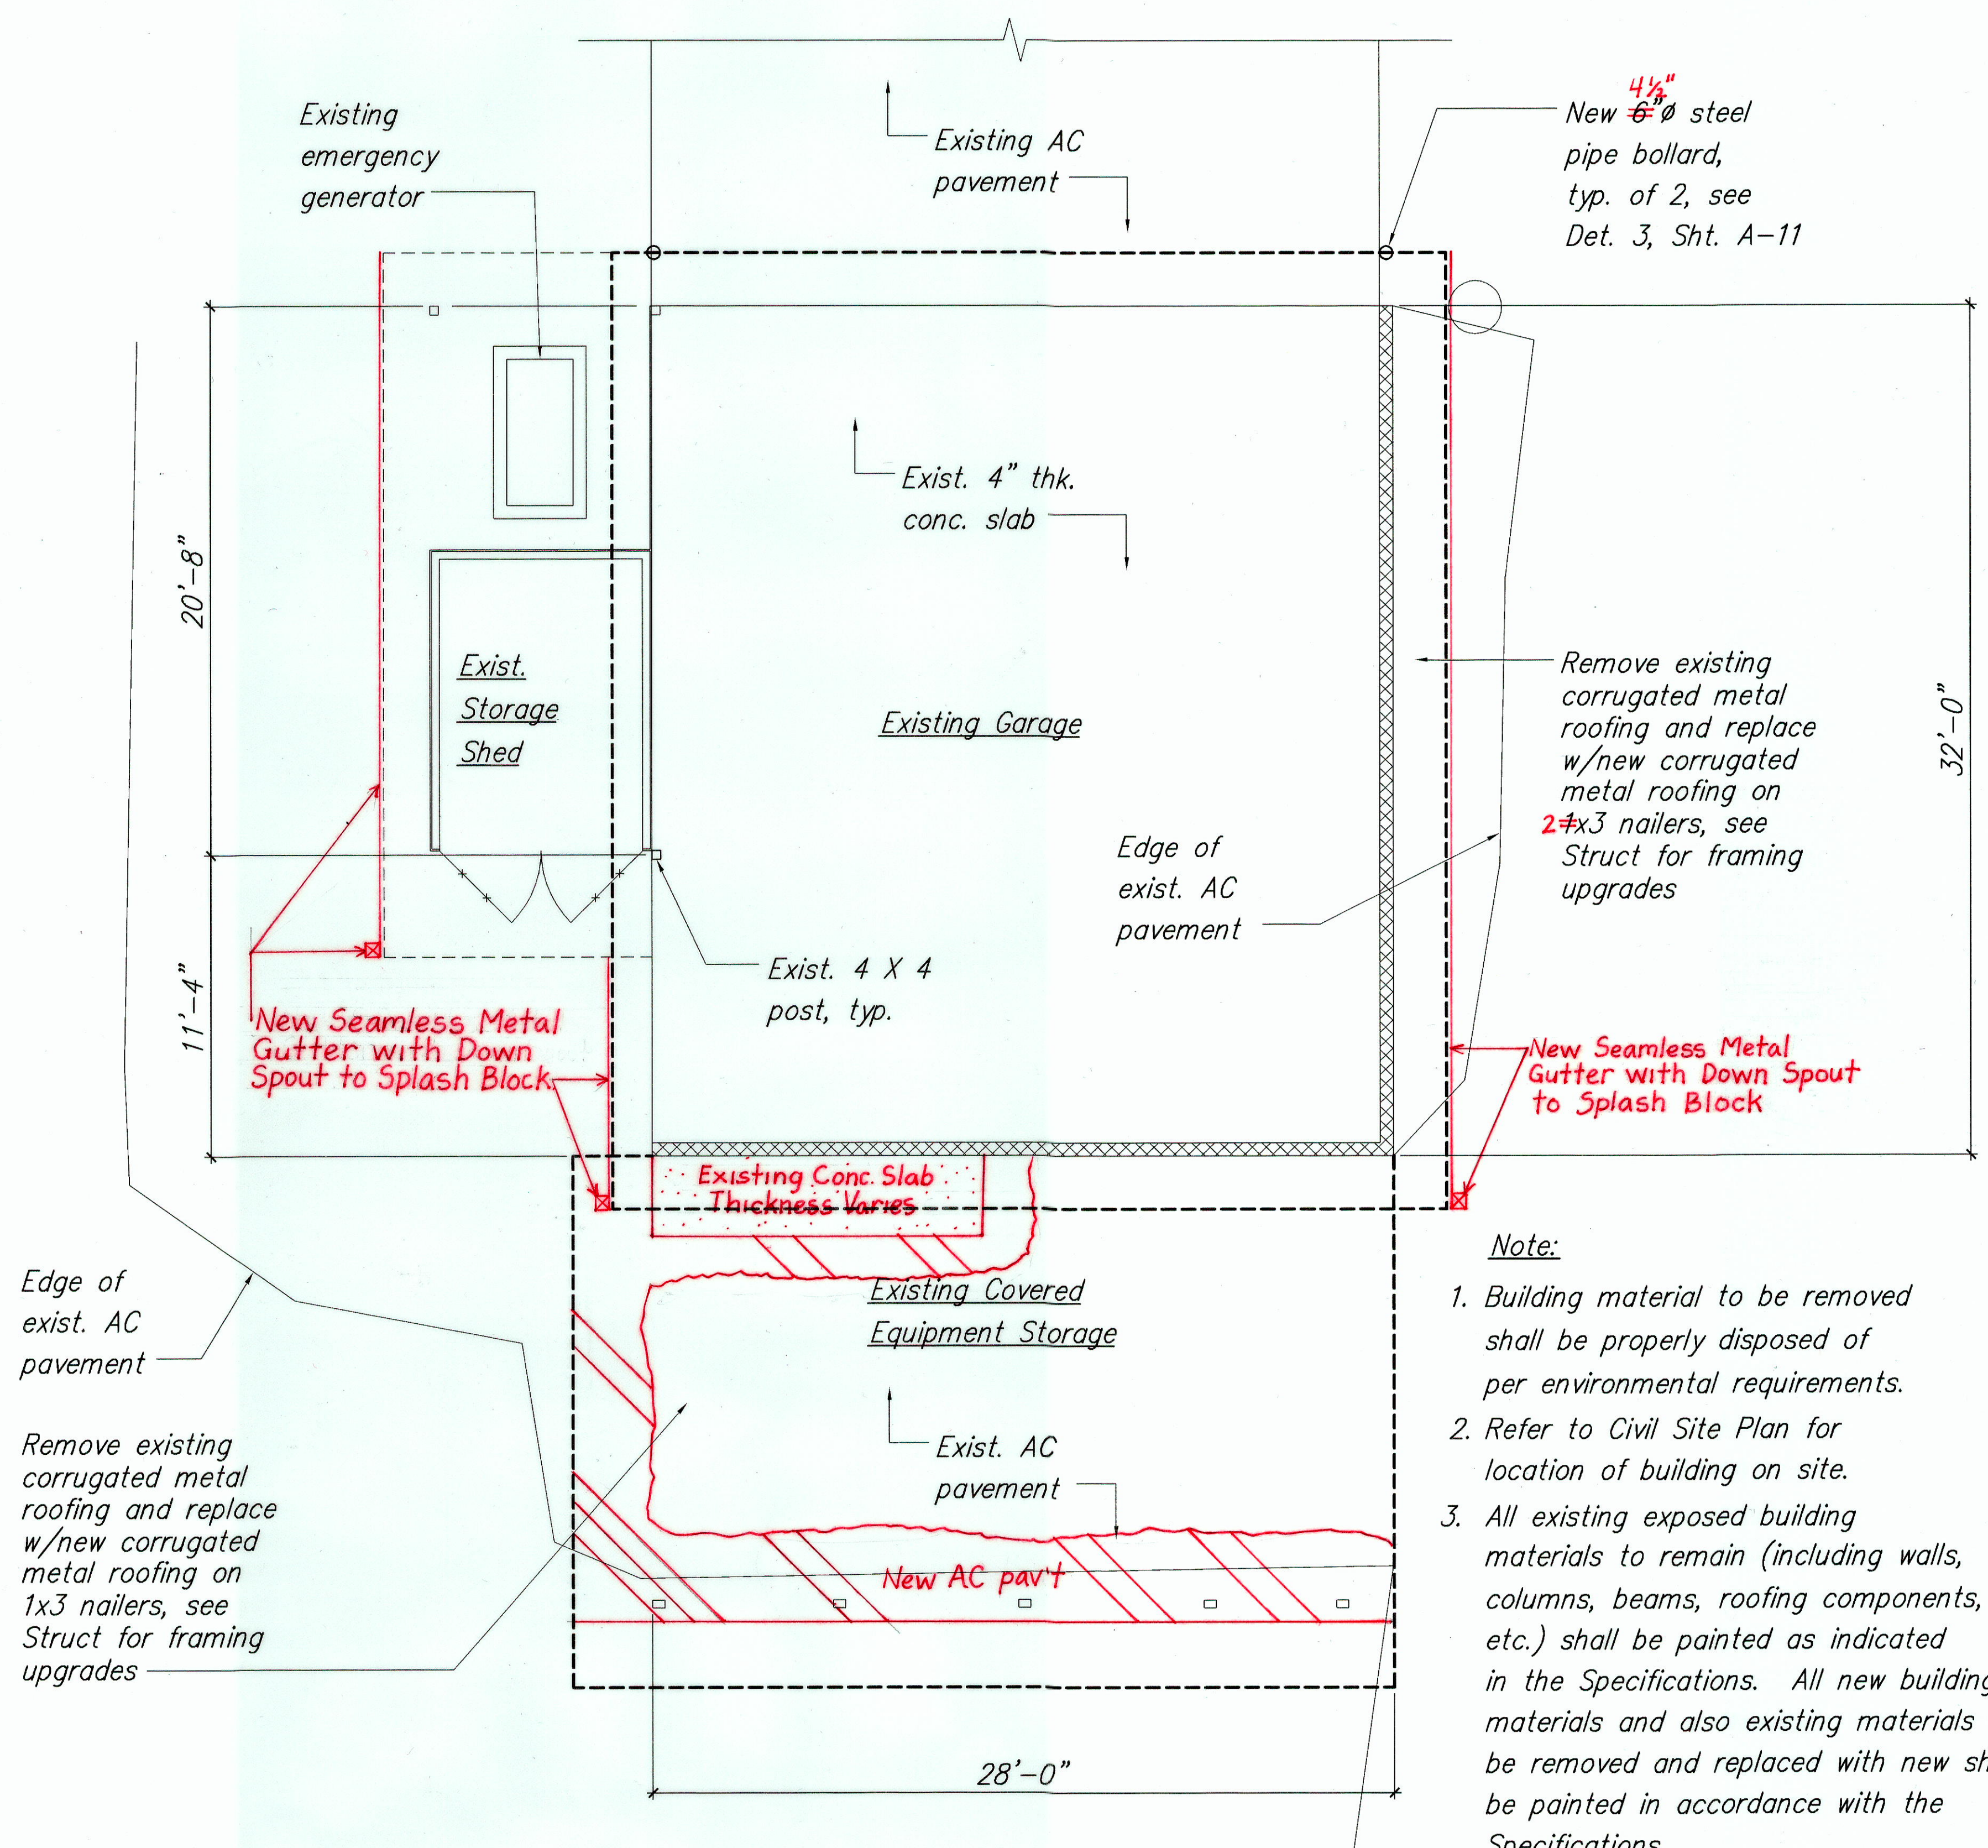


Garage & Equipment Storage Floor Plan
 Scale: 1/4" = 1'-0"

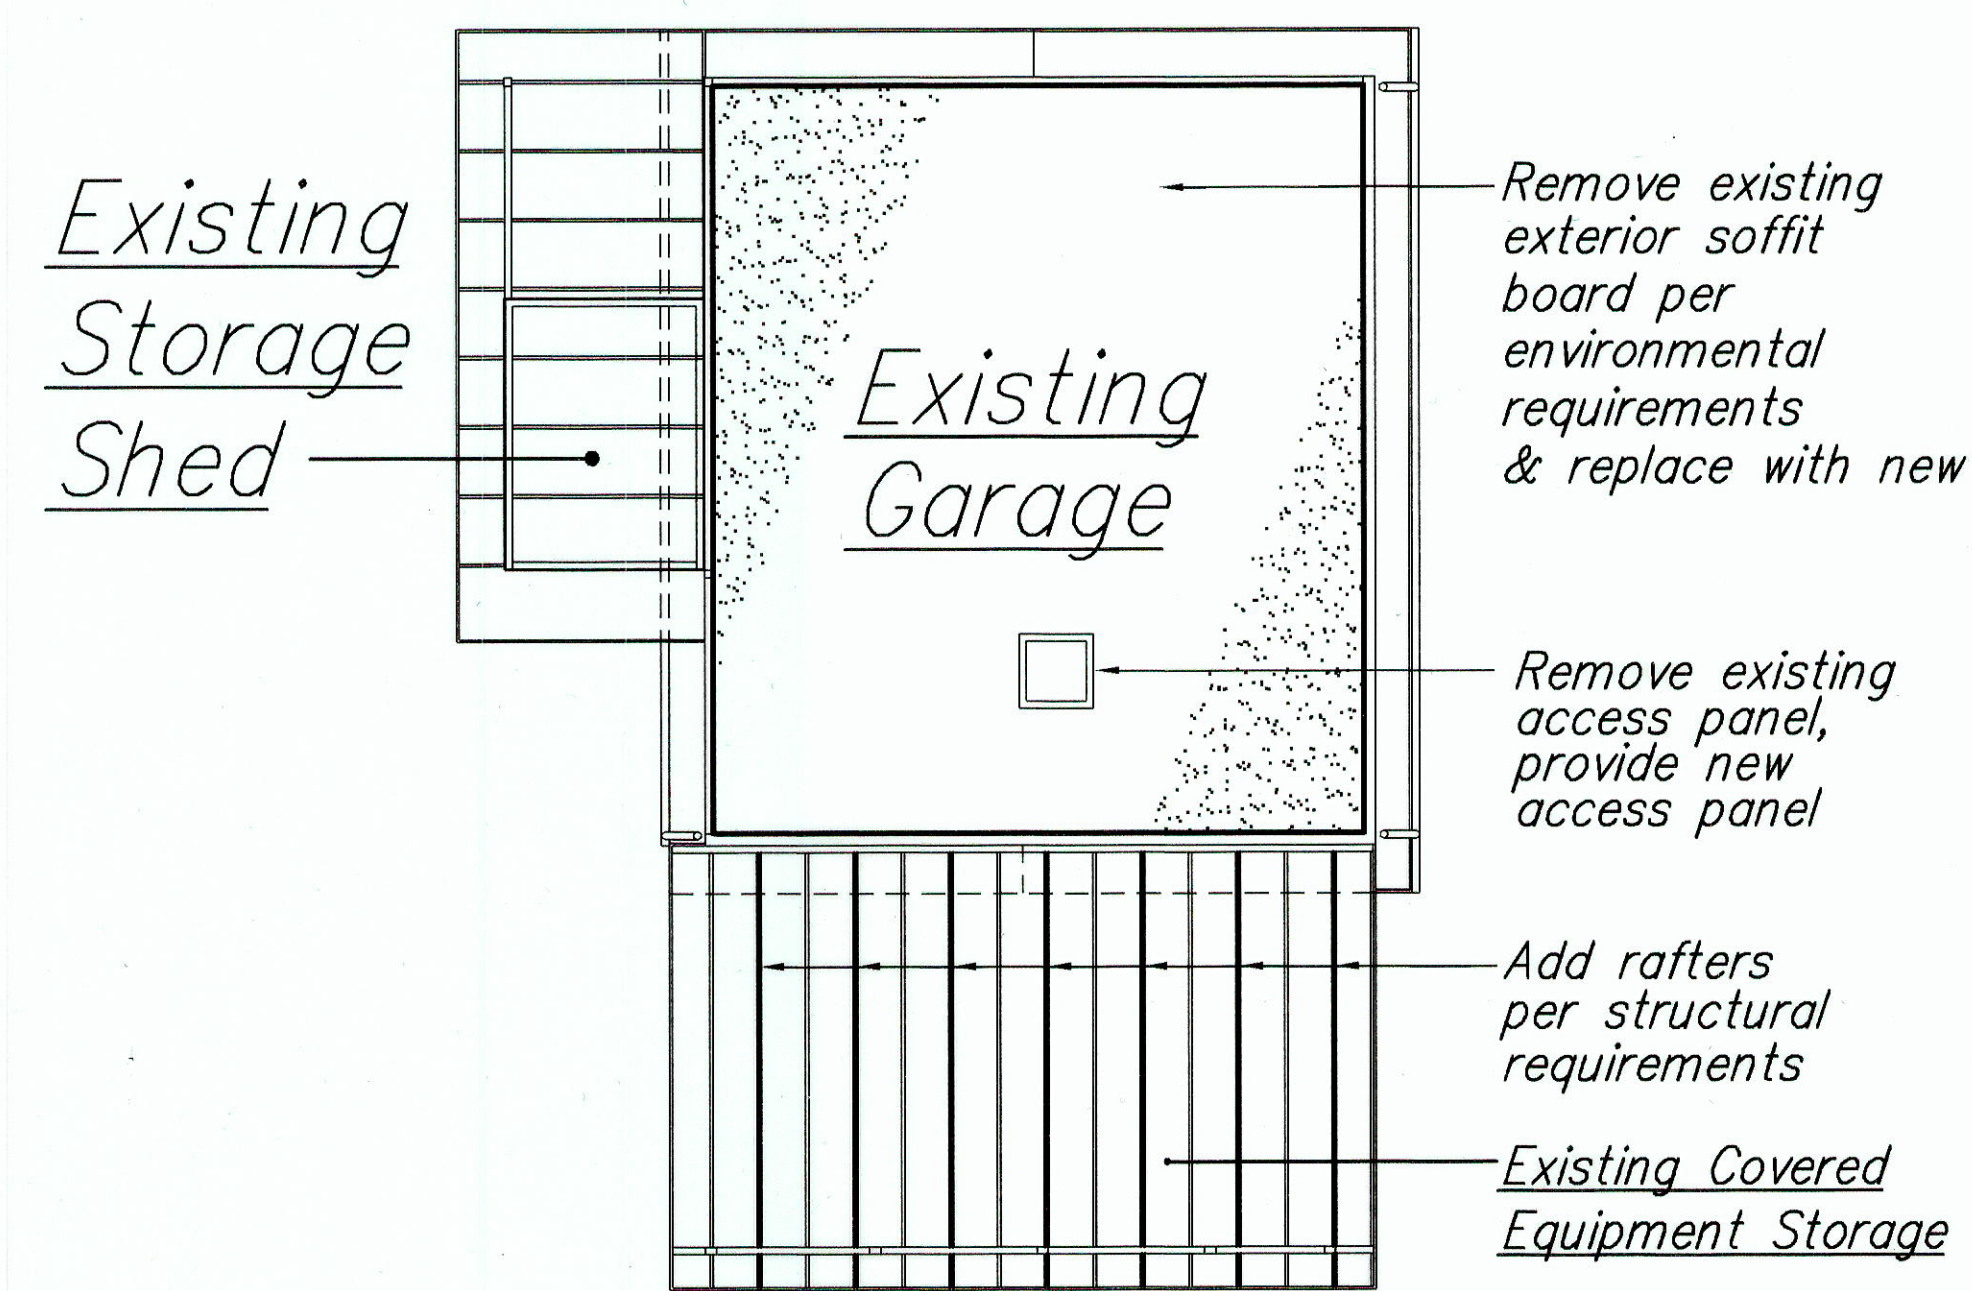

Existing Garage & Equipment Storage Reflected Ceiling Plan
 Scale: 1/8" = 1'-0"

- Note:**
1. Building material to be removed shall be properly disposed of per environmental requirements.
 2. Refer to Civil Site Plan for location of building on site.
 3. All existing exposed building materials to remain (including walls, columns, beams, roofing components, etc.) shall be painted as indicated in the Specifications. All new building materials and also existing materials to be removed and replaced with new shall be painted in accordance with the Specifications.

ORIGINAL PLAN	SURVEY PLOTTED BY	DATE
	DRAWN BY	
	TRACED BY	
	NOTED BY	
NOTE BOOK	QUANTITIES BY	
	CHECKED BY	

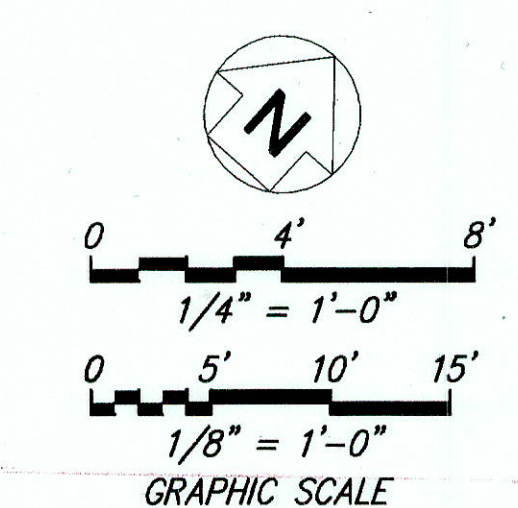


THIS WORK WAS PREPARED BY ME OR UNDER MY SUPERVISION
Steven D. King
 MITSUNAGA & ASSOCIATES

STATE OF HAWAII
 DEPARTMENT OF TRANSPORTATION
 HIGHWAYS DIVISION
GARAGE & EQUIPMENT STORAGE FLOOR PLAN & REFLECTED CEILING PLAN
 NAALEHU BASEYARD RENOVATIONS
 Project No. HWY-H-03-02M
 Scale: As Noted Date: April 2003
 SHEET No. **A-6** OF **A-12** SHEETS

"AS-BUILT"

FINAL SUBMITTAL


FED. ROAD DIST. NO.	STATE	PROJ. NO.	FISCAL YEAR	SHEET NO.	TOTAL SHEETS
HAWAII	HAW.	HWY-H-03-02M	2003	18	53

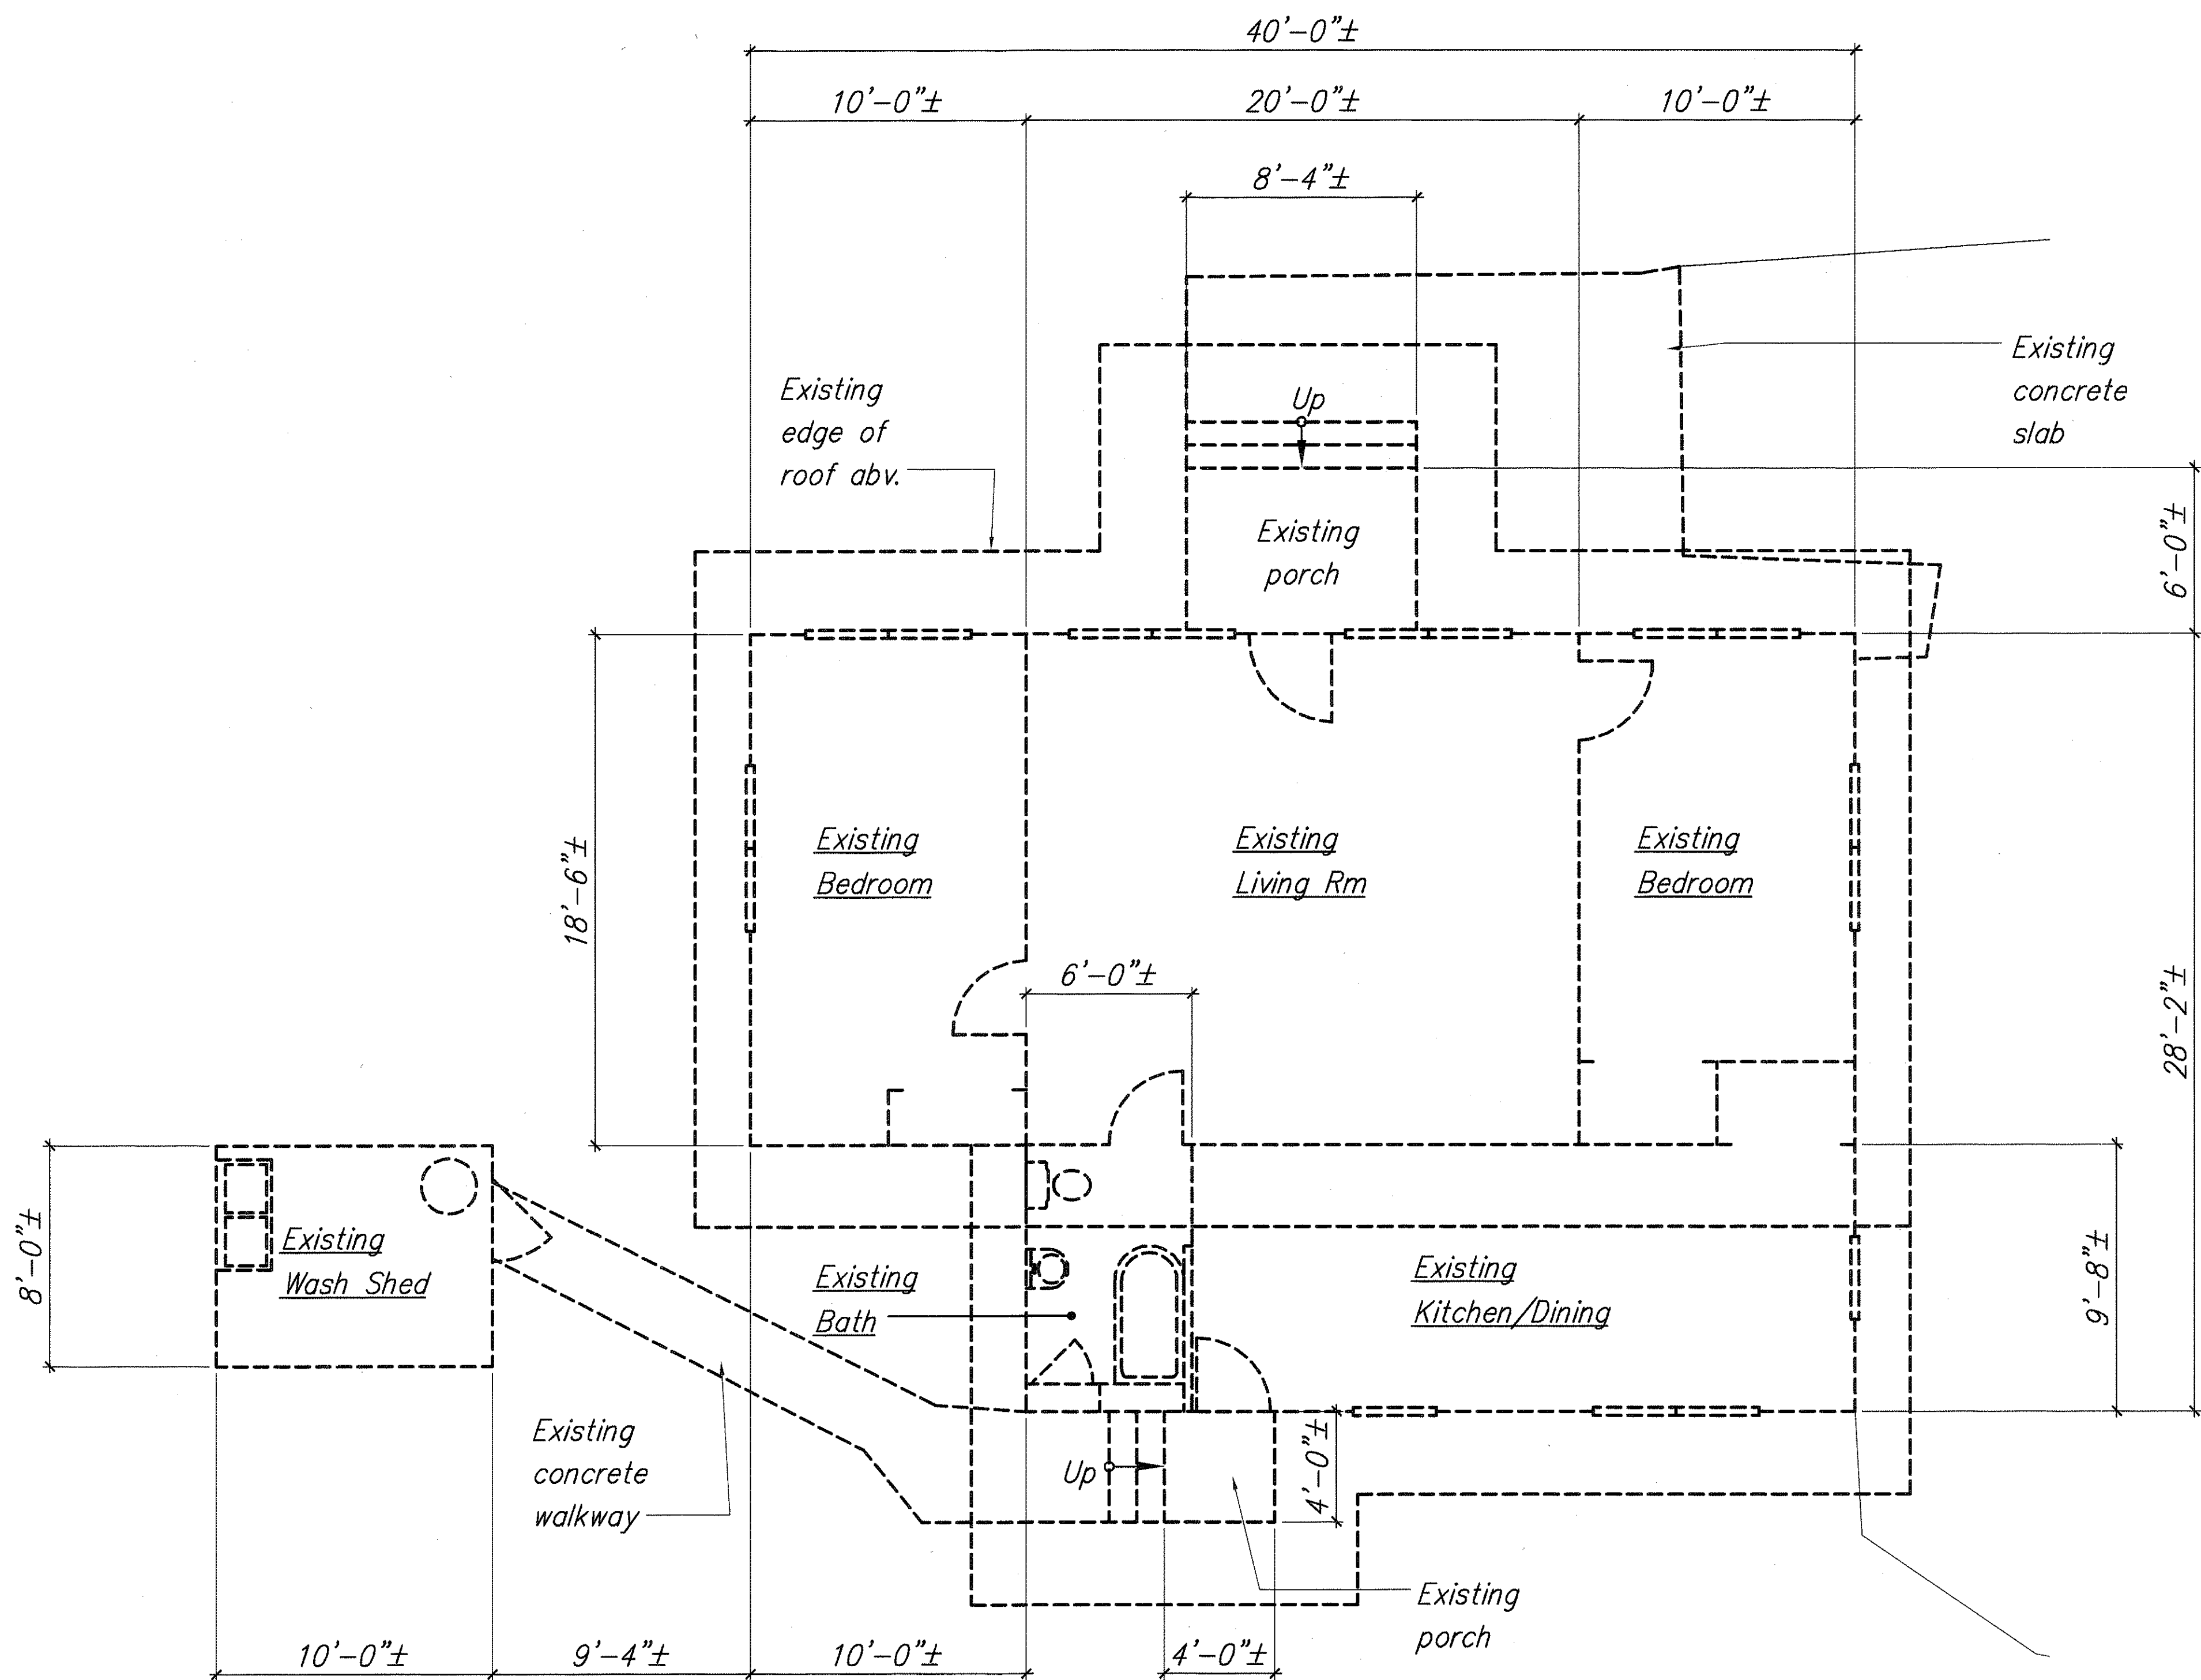


- Note: 1. Demolish residence building and wash shed in its entirety, including concrete slab, concrete sidewalks, etc. Items to be demolished indicated as bold dashed lines. Building materials shall be removed and properly disposed of in accordance with Environmental Requirements.
2. Refer to Civil Site Plan for location of building on site.

Residence Demolition Plan
Scale: 1/4" = 1'-0"

ORIGINAL PLAN	SURVEY PLOTTED BY	DATE
	DRAWN BY	
	DESIGNED BY	
	QUANTITIES BY	
NOTE BOOK	CHECKED BY	
	SW	

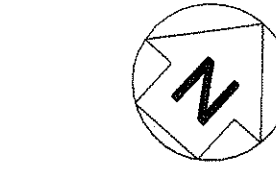

0 4' 8'
1/4" = 1'-0"
GRAPHIC SCALE

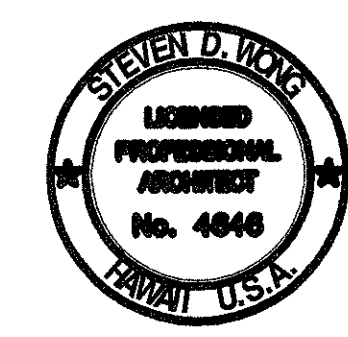


THIS WORK WAS PREPARED BY ME OR UNDER MY SUPERVISION
Steven D. Wong
MITSUNAGA & ASSOCIATES

STATE OF HAWAII
DEPARTMENT OF TRANSPORTATION
HIGHWAYS DIVISION
**RESIDENCE
DEMOLITION PLAN**
NAALEHU BASEYARD RENOVATIONS
Project No. HWY-H-03-02M
Scale: As Noted Date: April 2003
SHEET No. **A-7** OF **A-12** SHEETS


FED. ROAD DIST. NO.	STATE	PROJ. NO.	FISCAL YEAR	SHEET NO.	TOTAL SHEETS
HAWAII	HAW.	HWY-H-03-02M	2003	19	53

- Note:
- All work for the New Office Trailer shall be Deductive Bid Alternate.
 - Provide new ADA compliant locksets:
 - (2) Exterior doors at the New Office Trailer
 - (2) Interior doors at the New Office Trailer
 - (2) Exterior doors at the Existing Office Trailer
 - (2) Interior doors at the Existing Office Trailer (Existing Office Trailer not shown but similar to New Trailer. See Civil Site Plan for building location.)
 - Door Hardware shall comply with ADA Accessibility Guidelines Section 4.13.9. (Schlage D91PD or equal) Sargent
 - See Sheet A-5 for Roof Plan, Reflected Ceiling Plan, Exterior Elevations & Building Section (Conditions similar excluding Storage Room and Covered Patio).
 - Refer to Civil Site Plan for location of building on site.
 - All existing exposed building materials to remain (including walls, columns, beams, roofing components, etc.) shall be painted as indicated in the Specifications. All new building materials and also existing materials to be removed and replaced with new shall be painted in accordance with the Specifications.

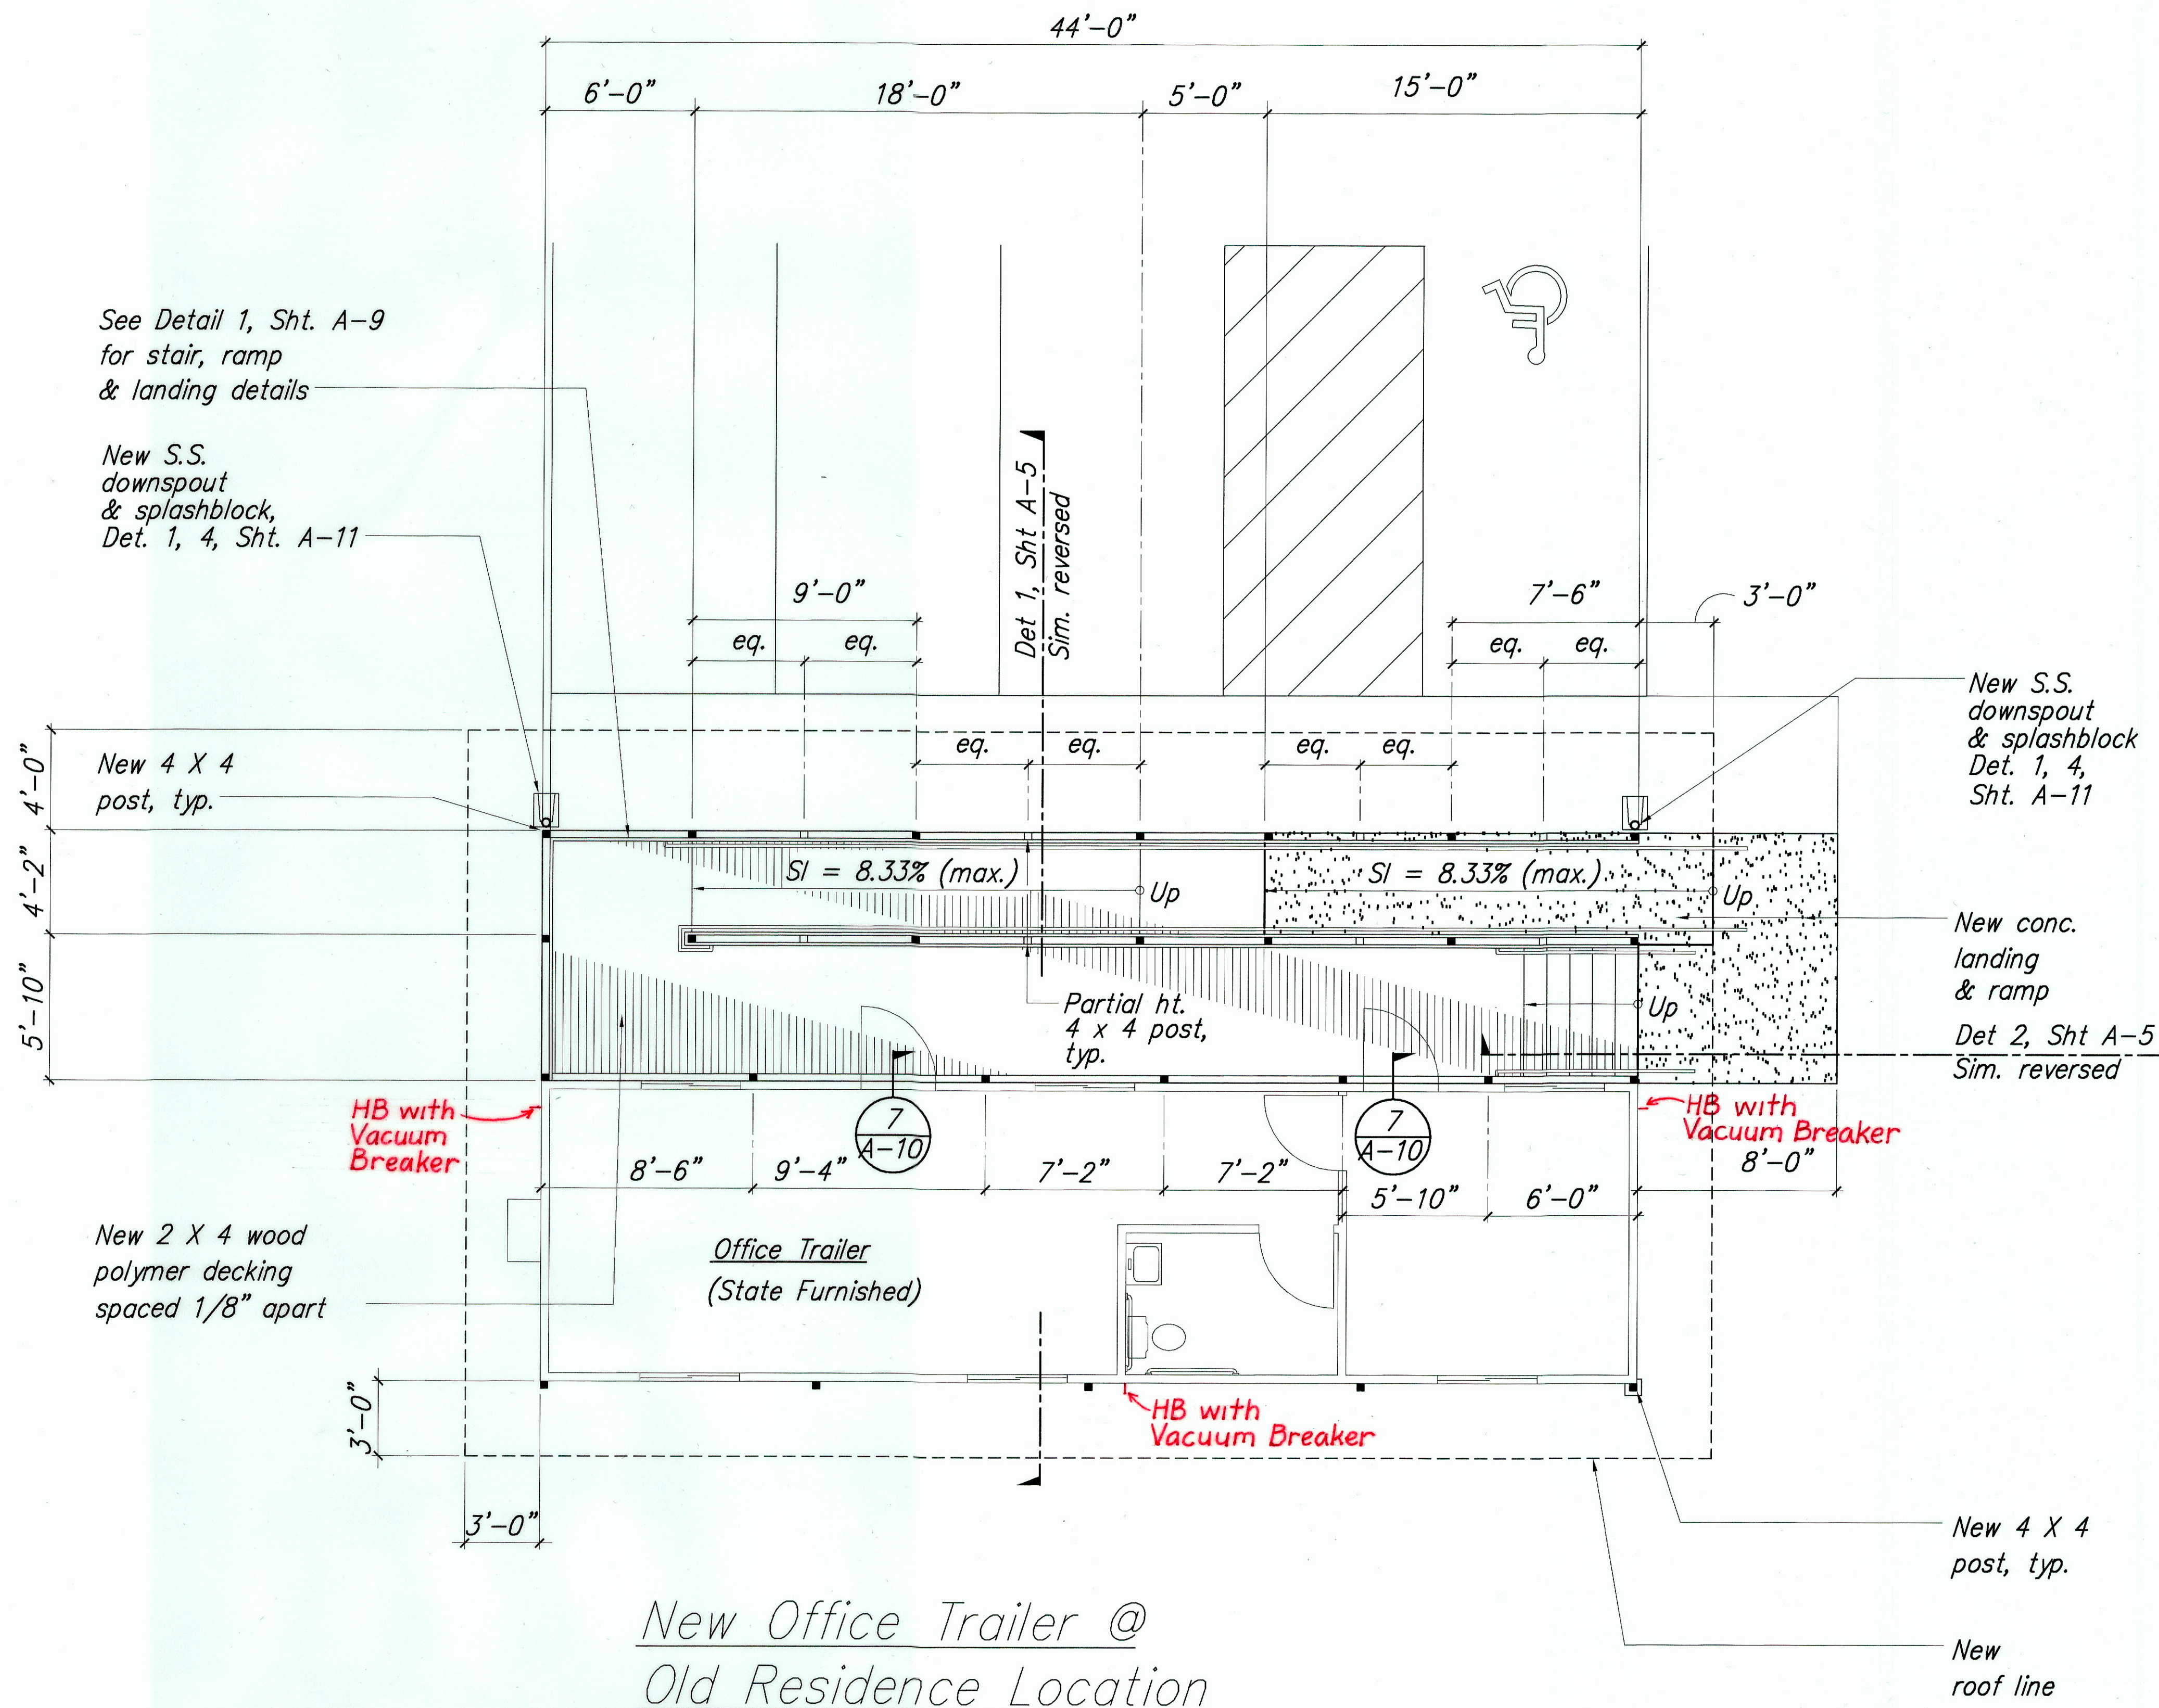

*New Office Trailer @
Old Residence Location
Floor Plan (Deductive Bid Alternate)
Scale: 1/4" = 1'-0"*

SURVEY PLOTTED BY	DATE
DESIGNED BY	
NOTED BY	
CHECKED BY	


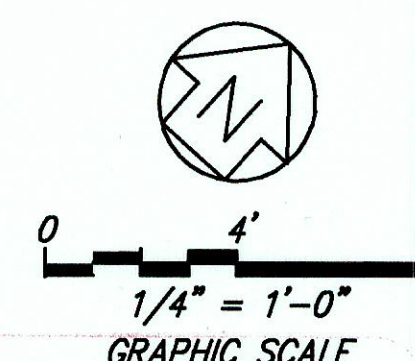


THIS WORK WAS PREPARED BY ME OR UNDER MY SUPERVISION
Steven D. Wong
MITSUNAGA & ASSOCIATES

5/27/2003	1	NOTE REVISED FOR DOOR HARDWARE.
DATE	REVISION	
STATE OF HAWAII DEPARTMENT OF TRANSPORTATION HIGHWAYS DIVISION <u>NEW OFFICE TRAILER @</u> <u>OLD RESIDENCE LOCATION</u> <u>FLOOR PLAN</u> <u>NAALEHU BASEYARD RENOVATIONS</u> <u>Project No. HWY-H-03-02M</u> Scale: As Noted Date: April 2003		
SHEET No. A-8 OF A-12 SHEETS		


"AS-BUILT"

FED. ROAD DIST. NO.	STATE	PROJ. NO.	FISCAL YEAR	SHEET NO.	TOTAL SHEETS
HAWAII	HAW.	HWY-H-03-02M	2003	20	53

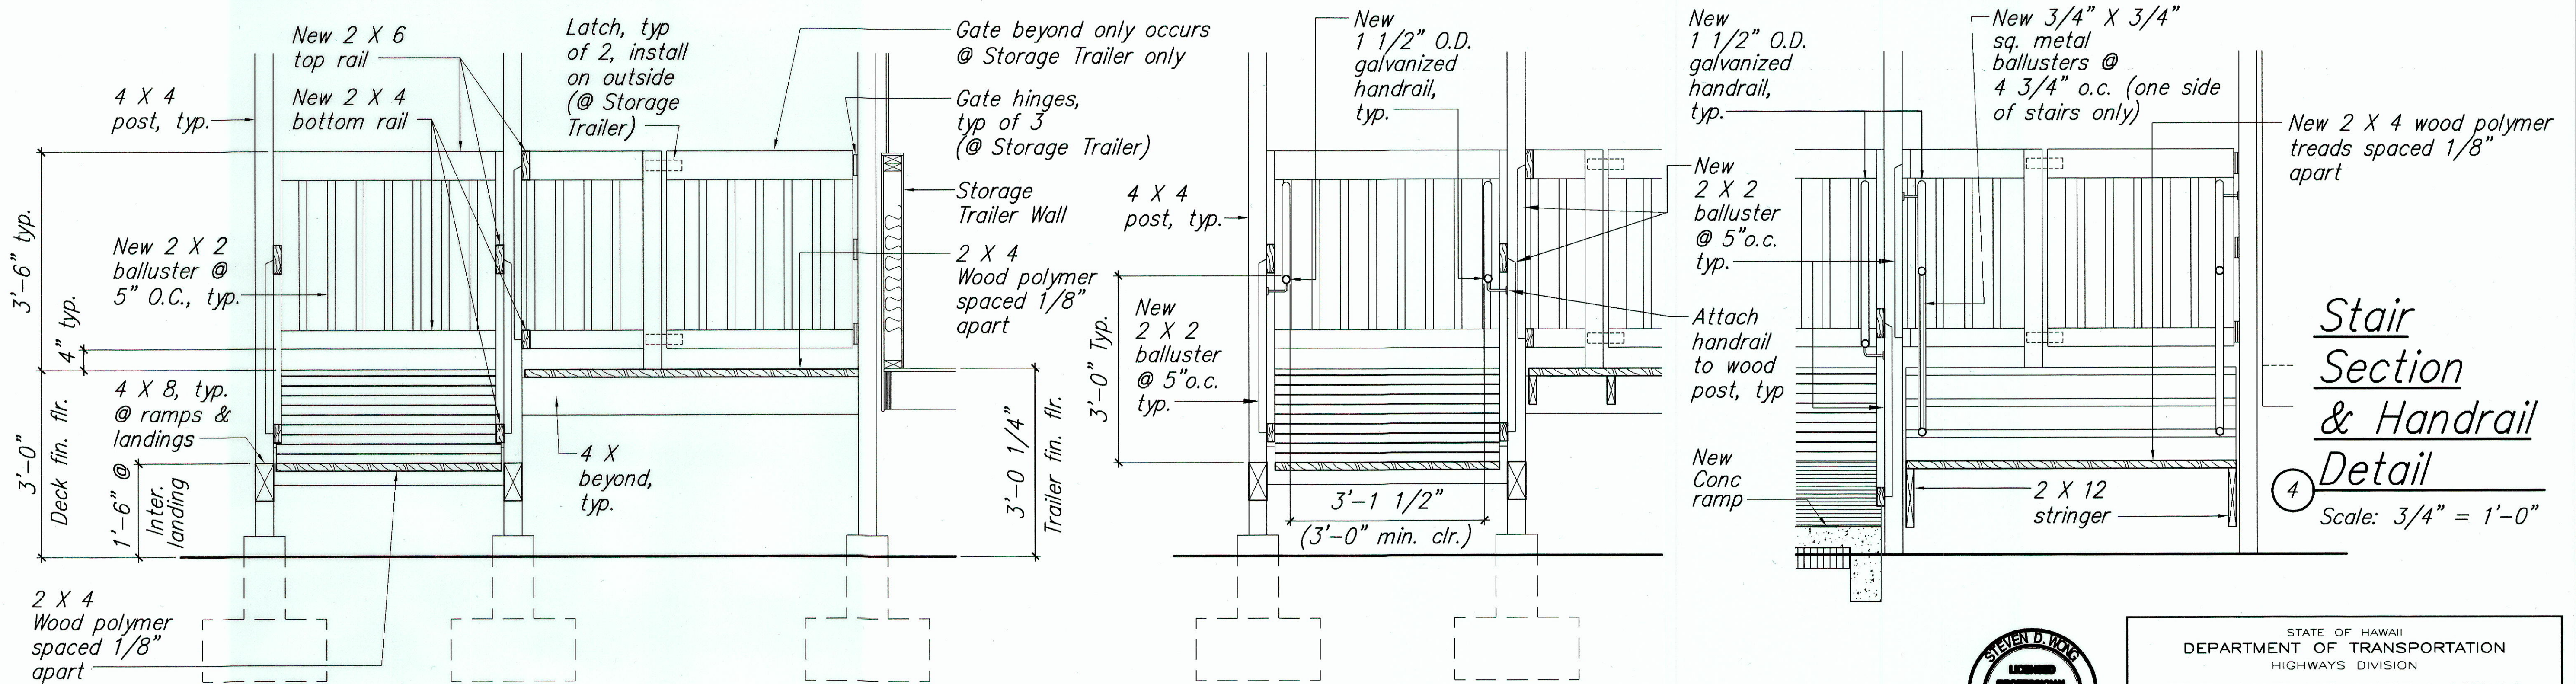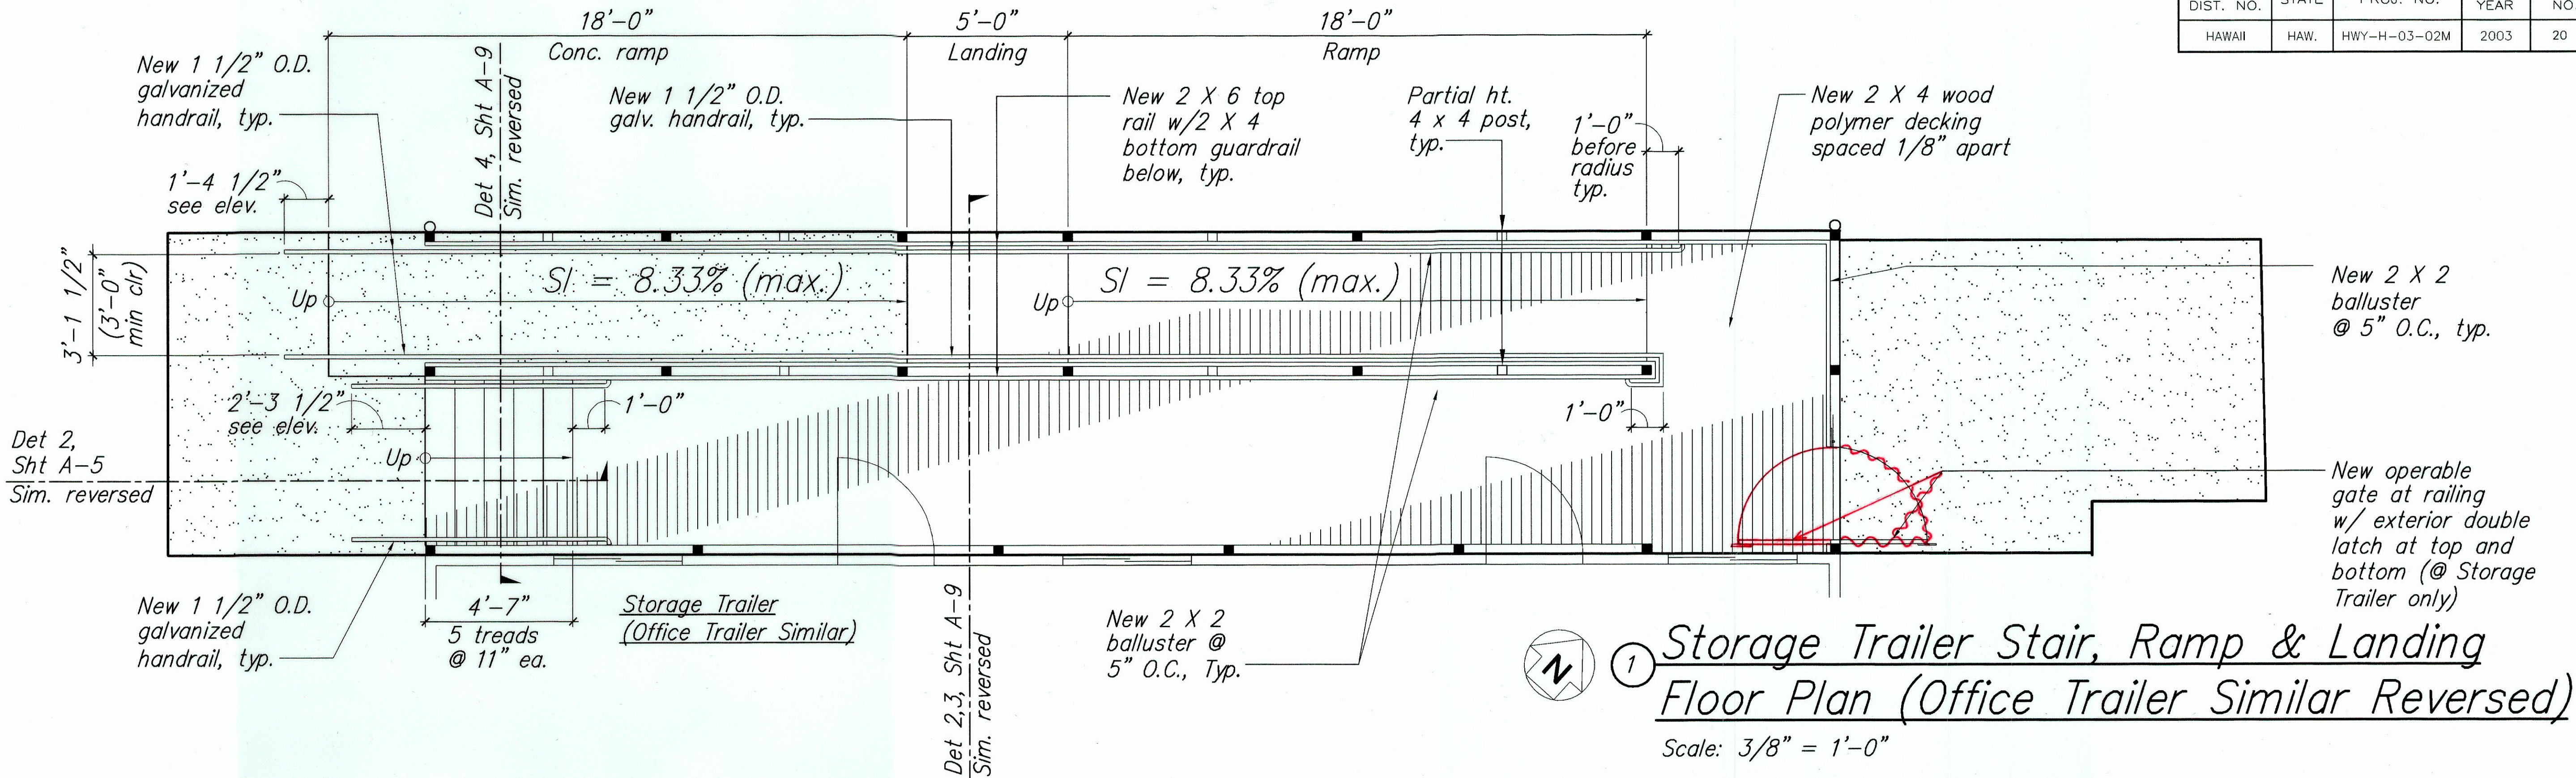

2 Section @ Polymer Ramp & Deck
Scale: 3/4" = 1'-0"

3 Ramp Section & Handrail Detail
Scale: 3/4" = 1'-0"

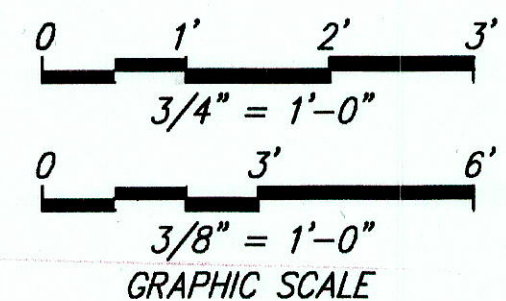


THIS WORK WAS PREPARED BY ME OR UNDER MY SUPERVISION
Steven D. Wong
MITSUNAGA & ASSOCIATES

STATE OF HAWAII
DEPARTMENT OF TRANSPORTATION
HIGHWAYS DIVISION
STAIR, RAMP AND LANDING DETAILS


NAAALEHU BASEYARD RENOVATIONS
Project No. HWY-H-03-02M

Scale: As Noted Date: April 2003
SHEET No. **A-9** OF **A-12** SHEETS


FED. ROAD DIST. NO.	STATE	PROJ. NO.	FISCAL YEAR	SHEET NO.	TOTAL SHEETS
HAWAII	HAW.	HWY-H-03-02M	2003	21	53

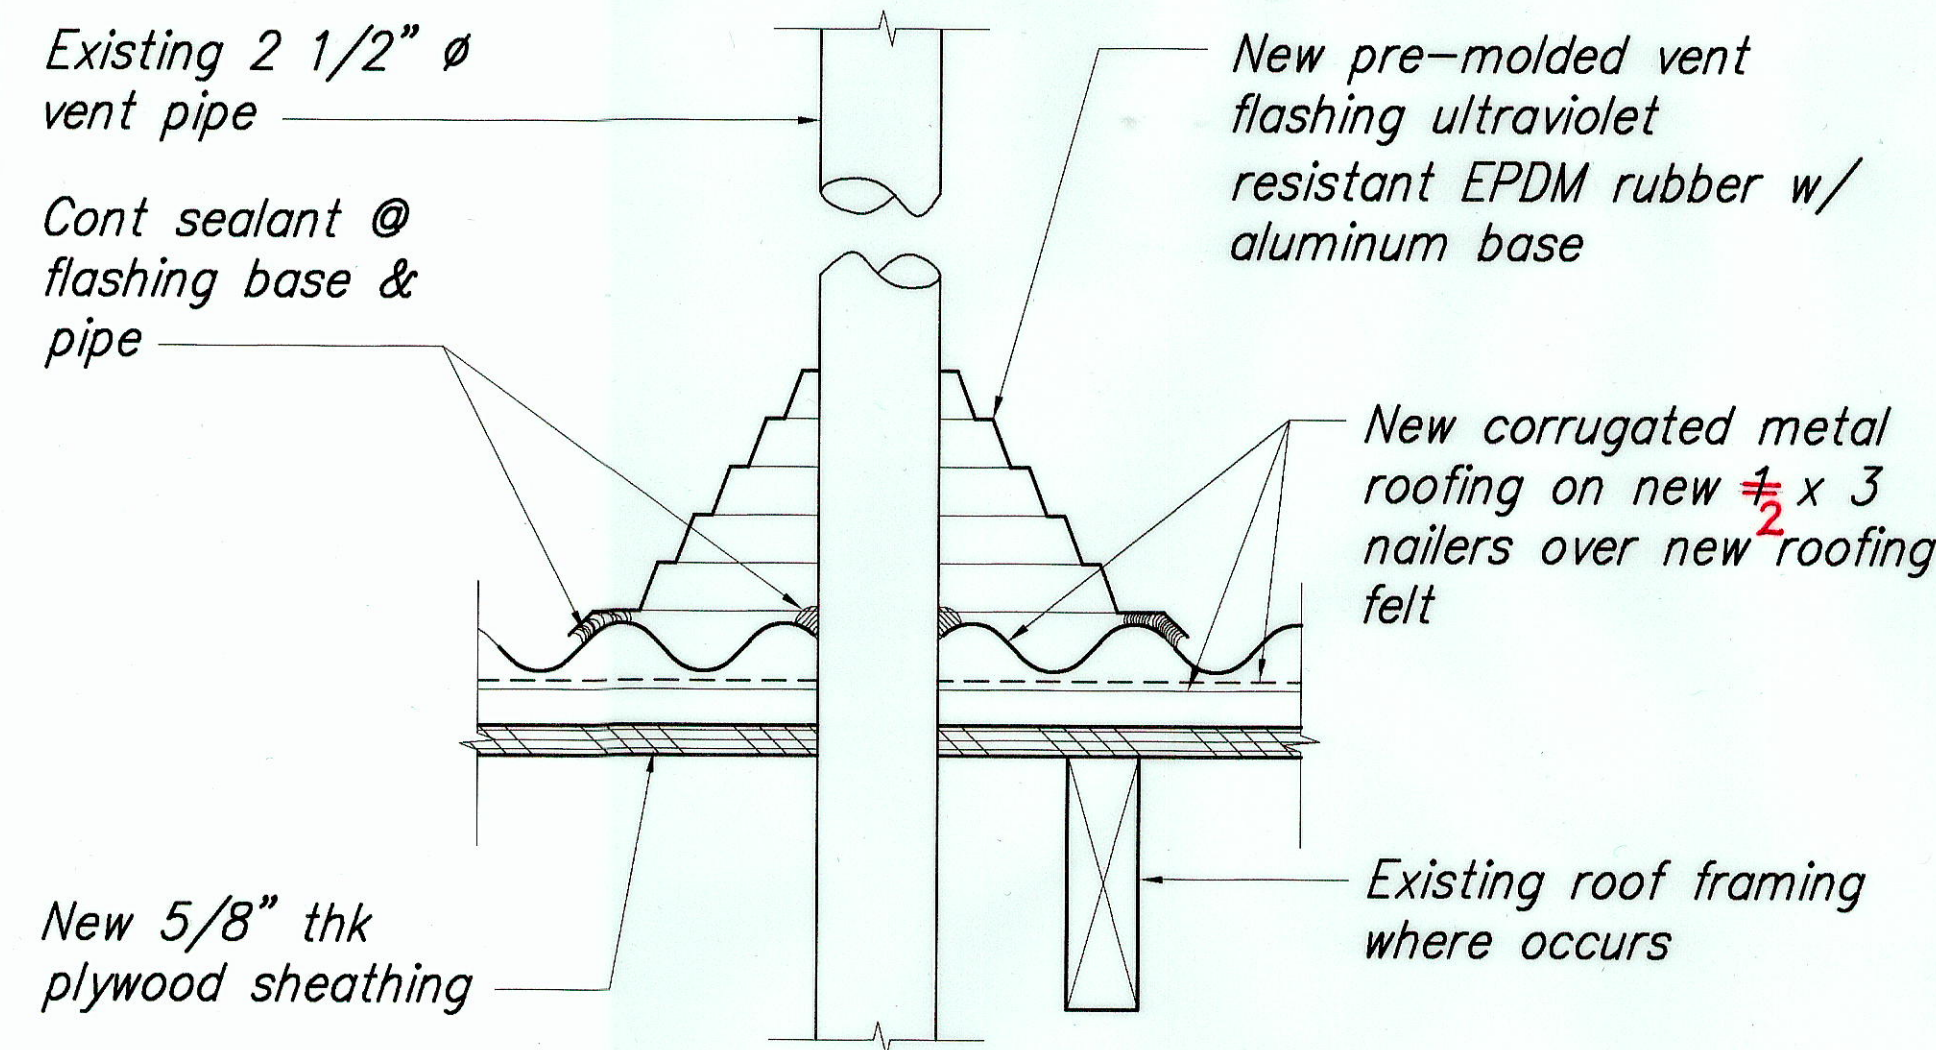


① VTR Flashing
Scale: 3" = 1'-0"

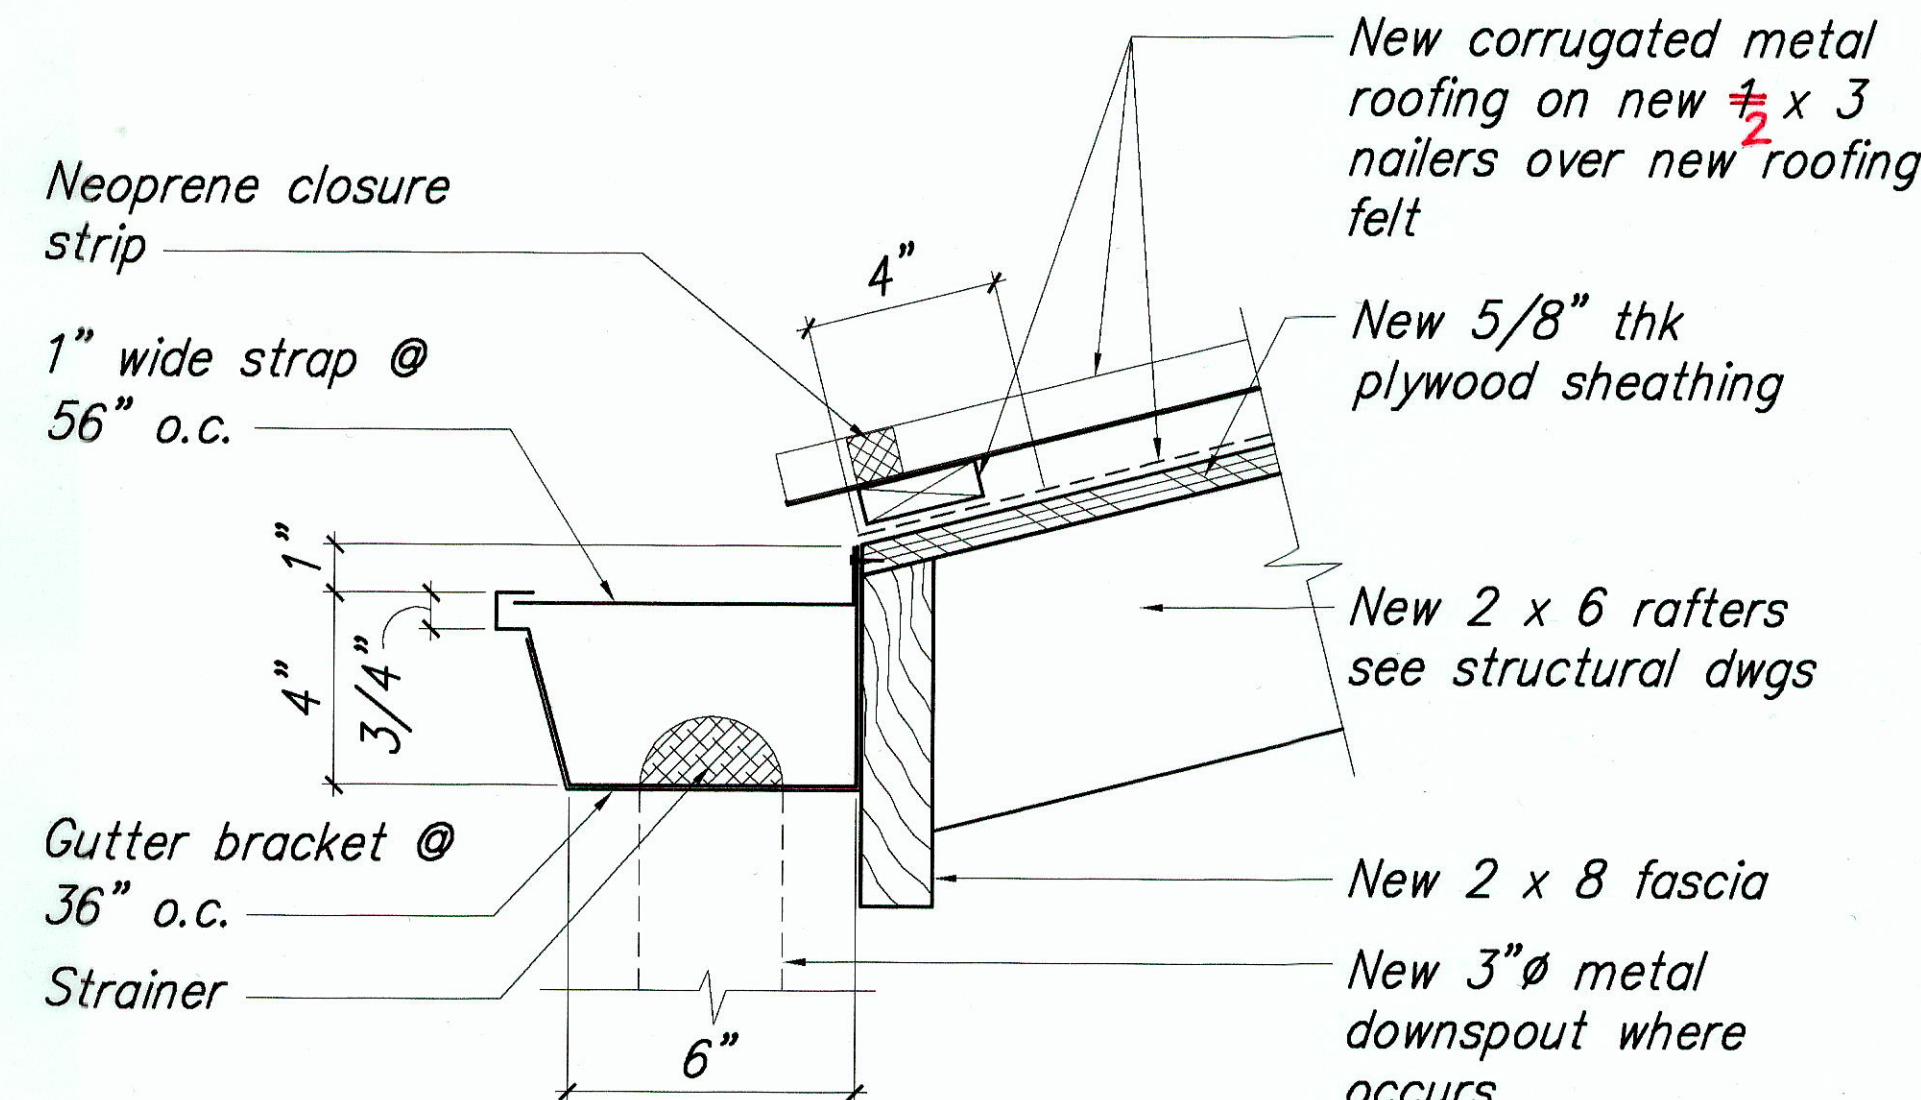


② Gutter / Eave Detail
Scale: 3" = 1'-0"

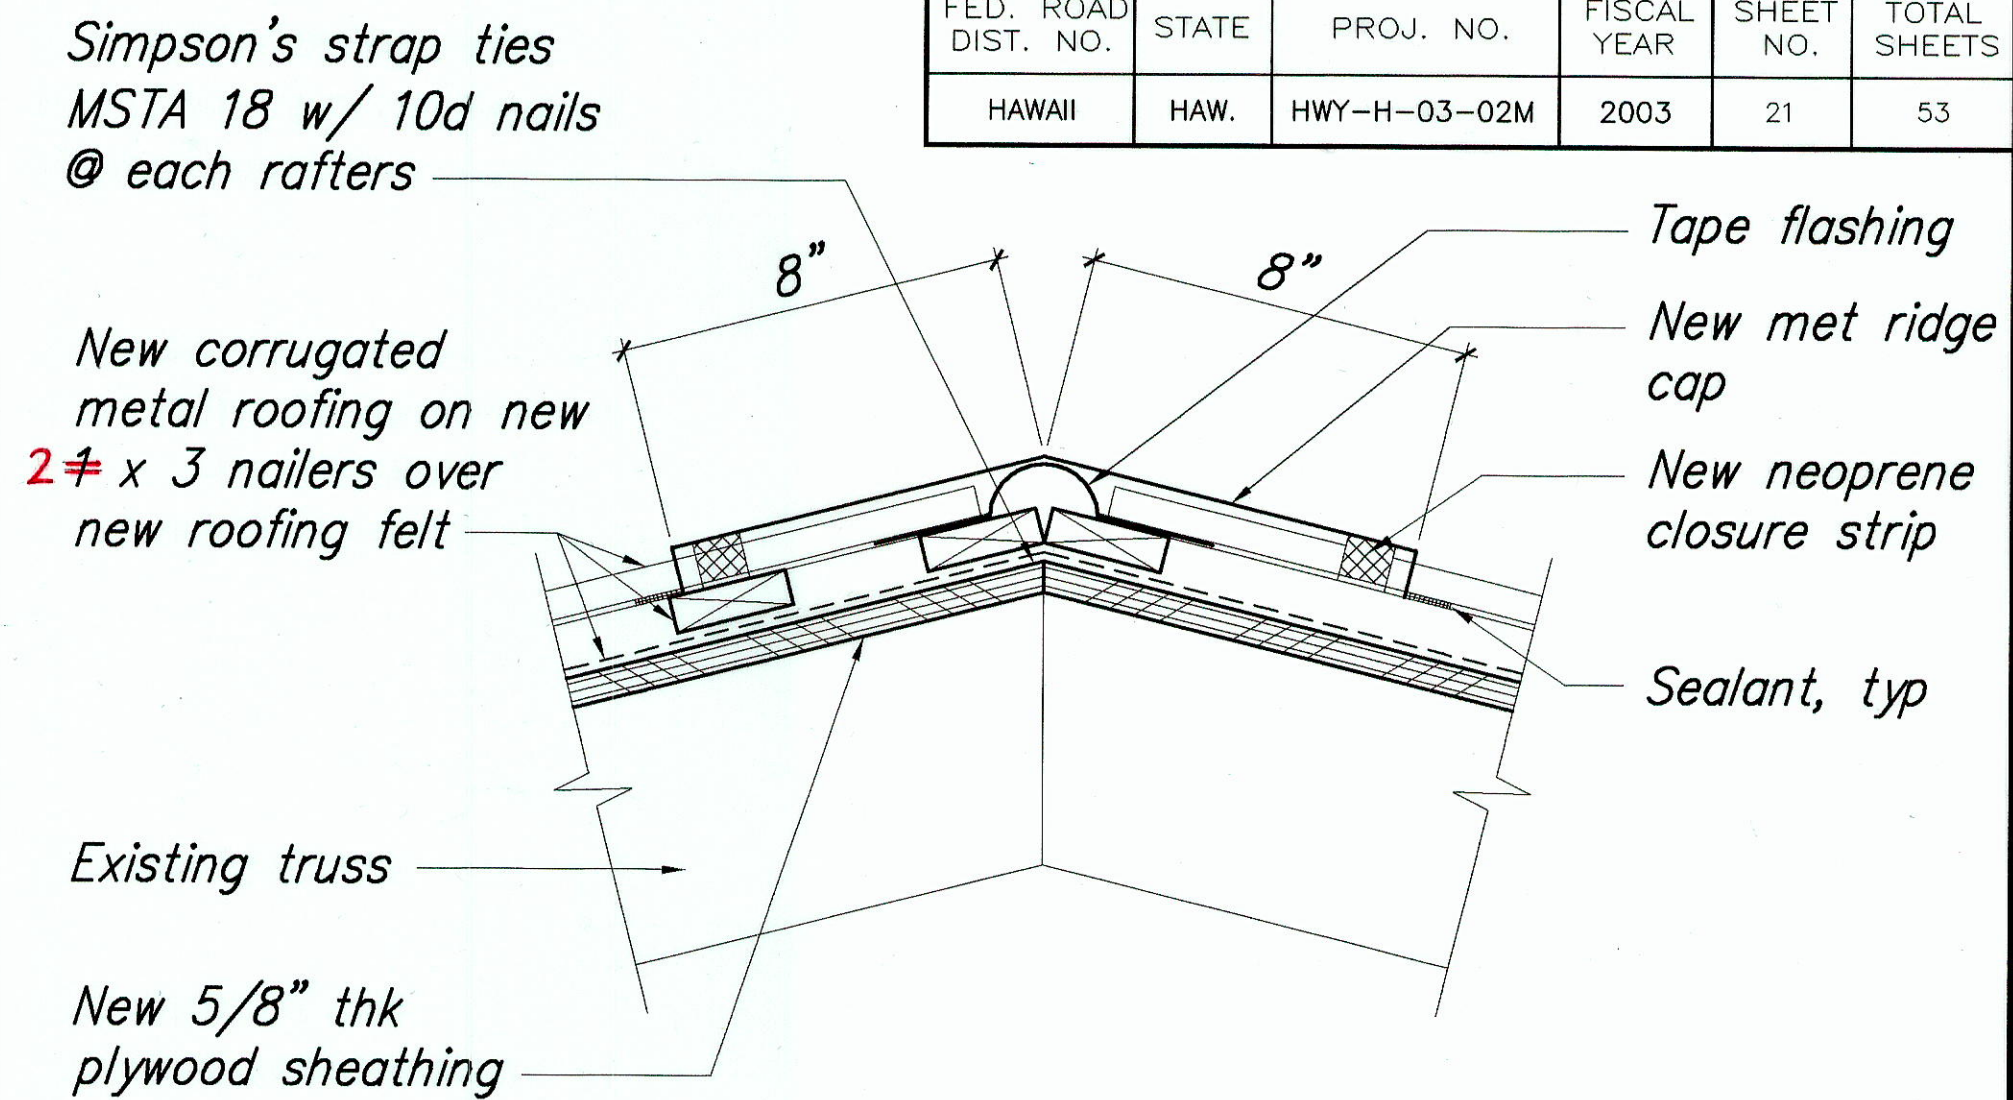


③ Ridge Detail
Scale: 3" = 1'-0"

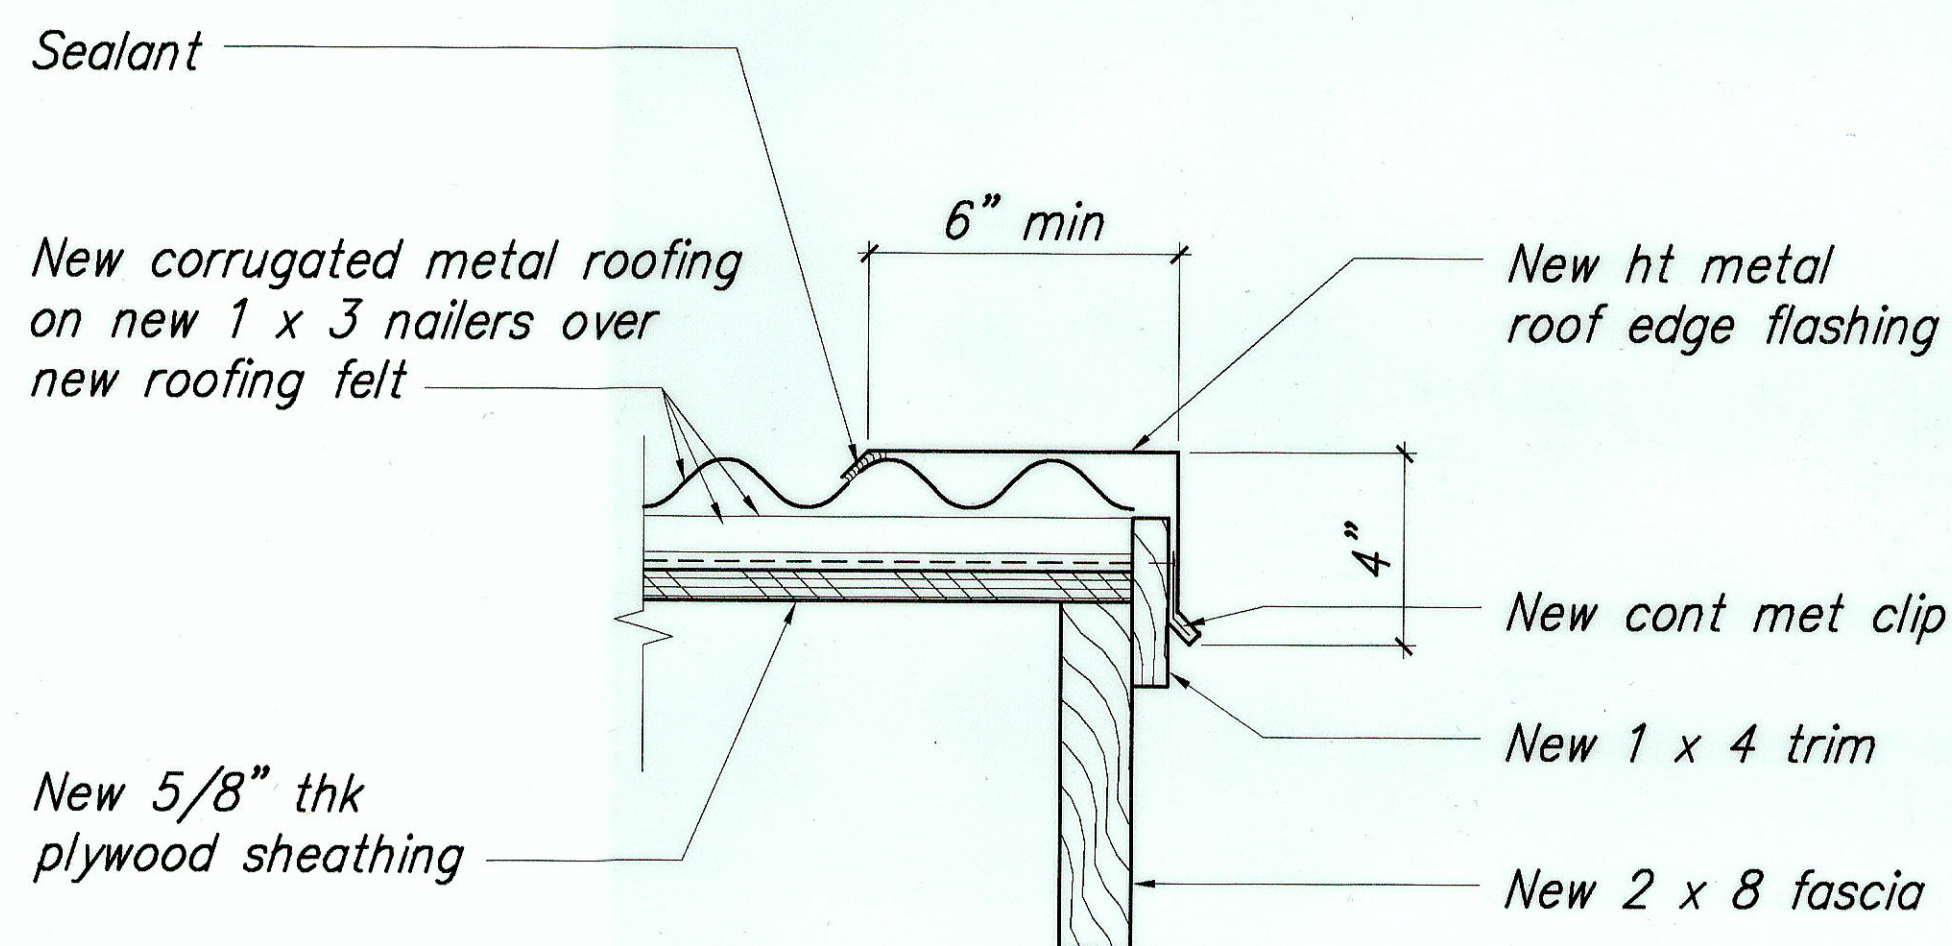


④ Roof Edge
Scale: 3" = 1'-0"

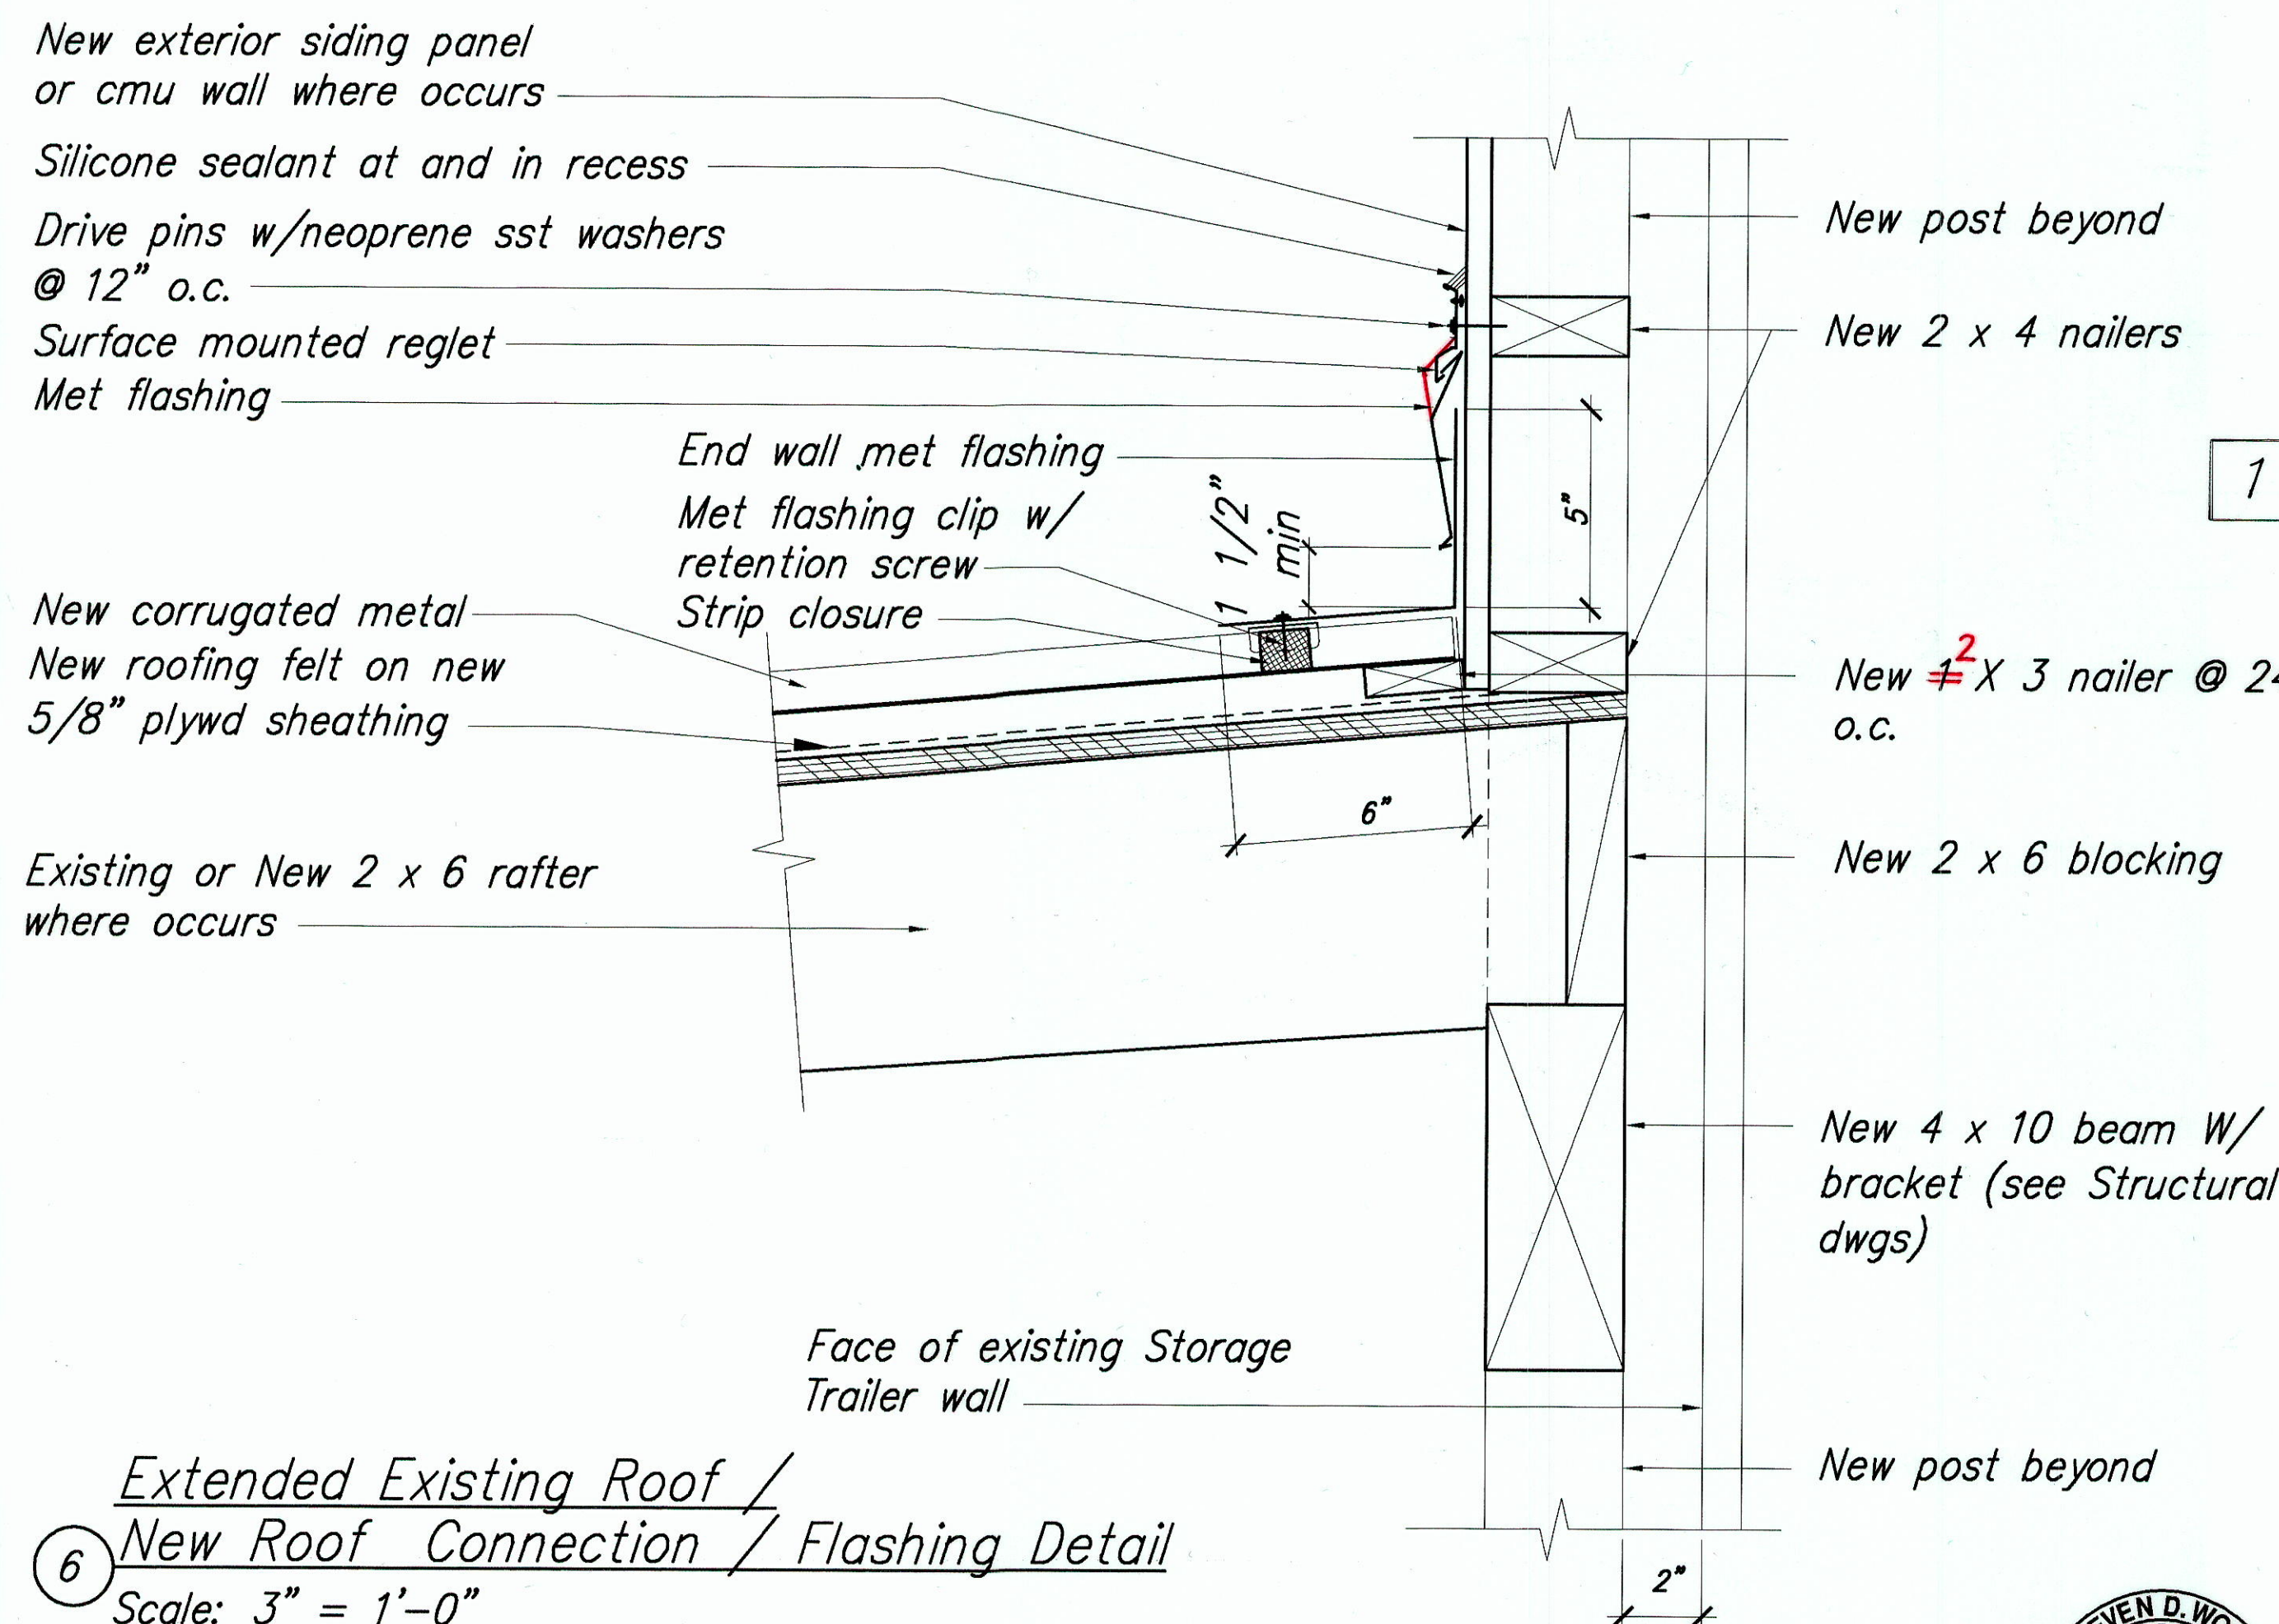

⑥ Extended Existing Roof / New Roof Connection / Flashing Detail
Scale: 3" = 1'-0"

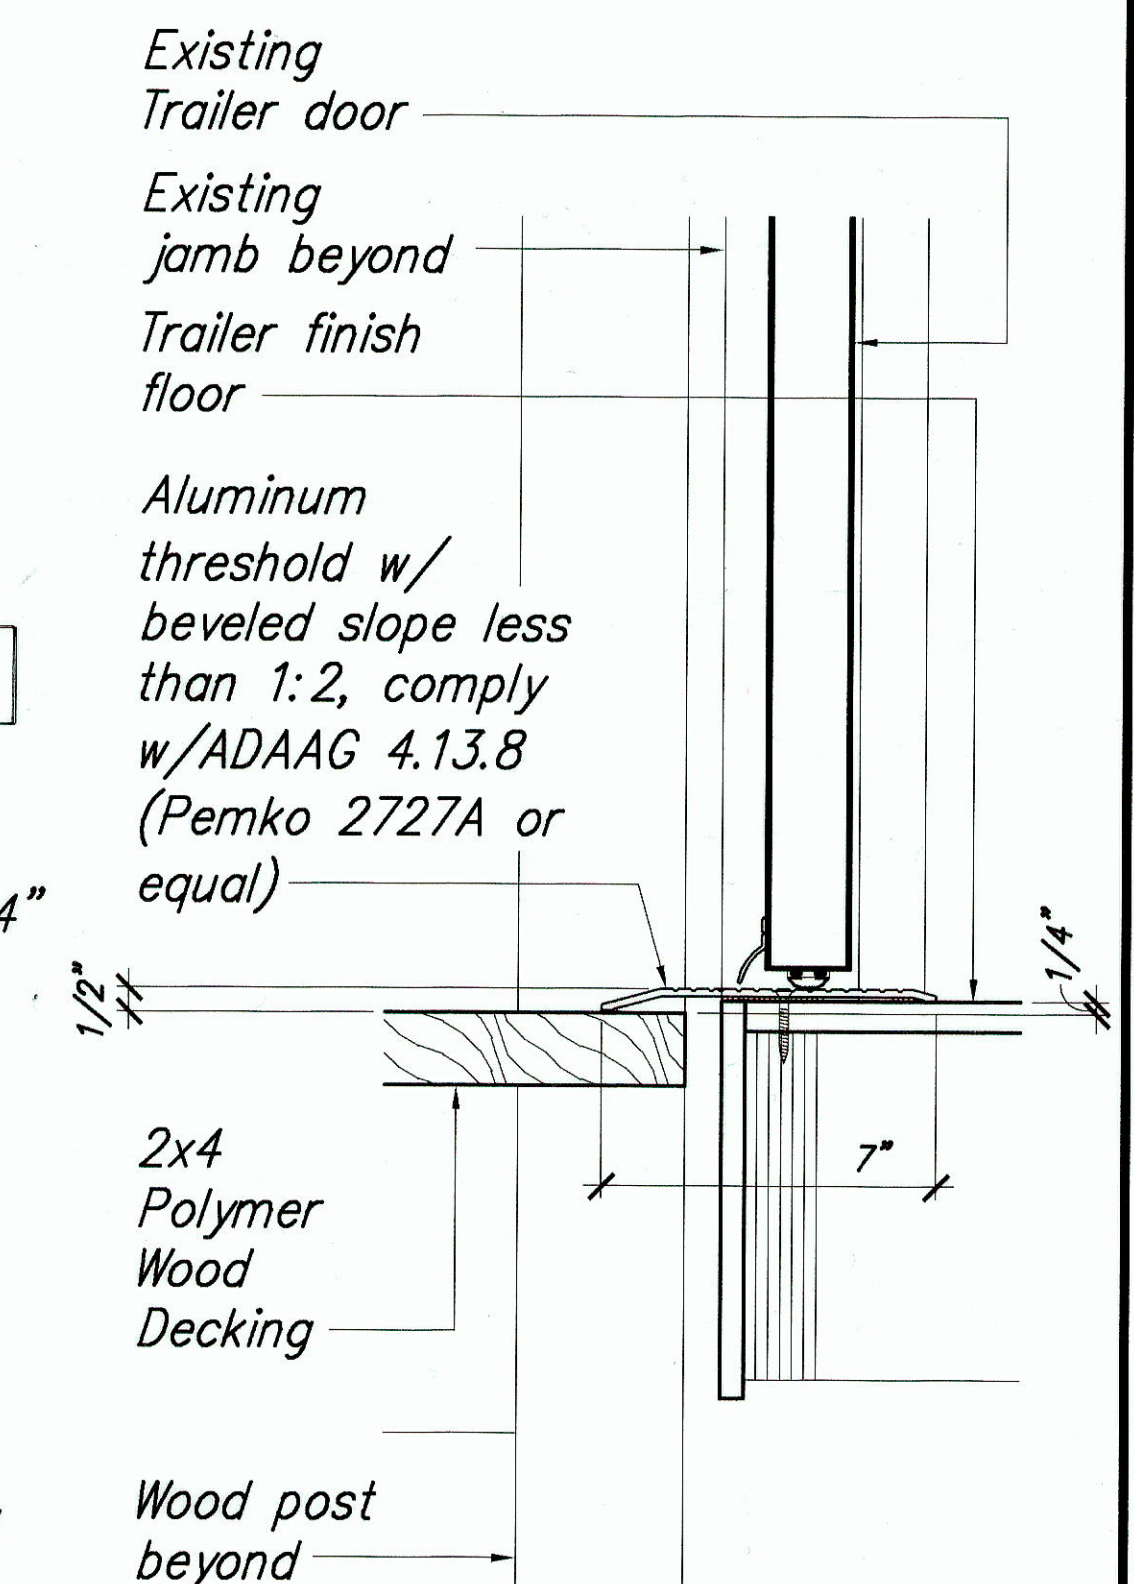

⑦ Door Threshold Detail
Scale: 3" = 1'-0"

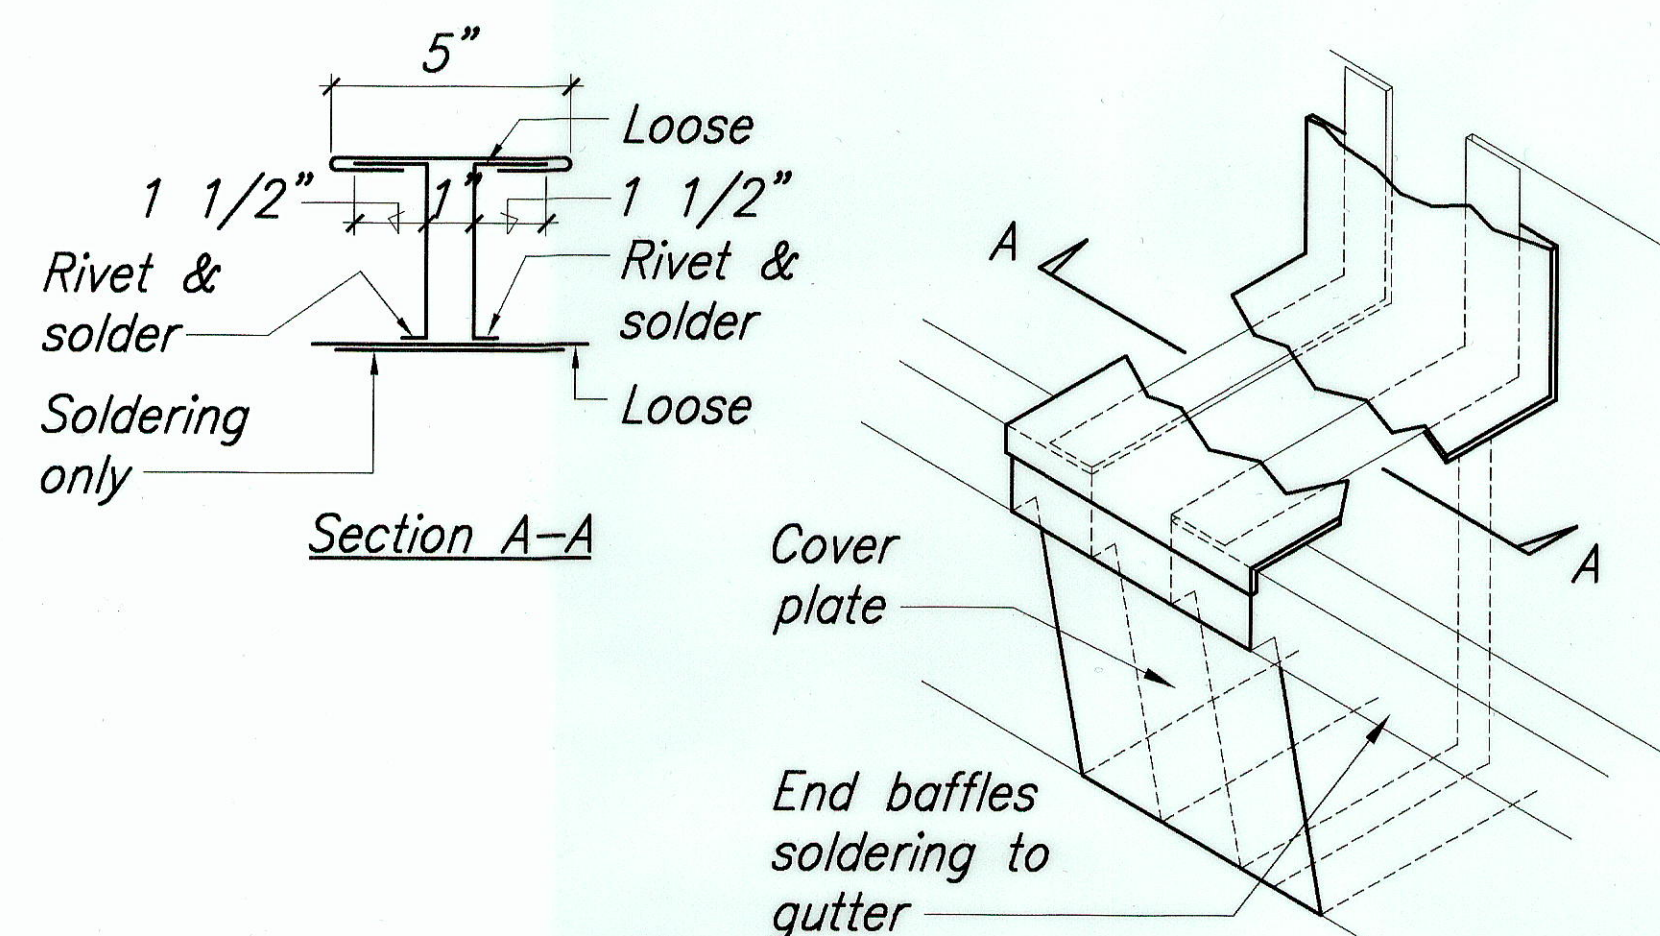

⑤ Gutter Expansion Joint Detail
Scale: 3" = 1'-0"

SURVEY PLOTTED BY	DATE
DRAWN BY	DATE
TRACED BY	DATE
CHECKED BY	DATE
NOTED BY	DATE
QUANTITIES BY	DATE
CHECKED BY	DATE
ORIGINAL PLAN	DATE
NOTE BOOK	DATE
No.	DATE




0 3" 6"
3" = 1'-0"
GRAPHIC SCALE

THIS WORK WAS PREPARED BY ME OR UNDER MY SUPERVISION
Steven D. Wong
MITSUNAGA & ASSOCIATES


5/27/2003	7	NOTE REVISED FOR DOOR THRESHOLD.
DATE	REVISION	
		STATE OF HAWAII DEPARTMENT OF TRANSPORTATION HIGHWAYS DIVISION MISCELLANEOUS DETAILS NAALEHU BASEYARD RENOVATIONS Project No. HWY-H-03-02M Scale: As Noted Date: April 2003 SHEET No. A-100F A-12SHEETS

"AS-BUILT"


FED. ROAD DIST. NO.	STATE	PROJ. NO.	FISCAL YEAR	SHEET NO.	TOTAL SHEETS
HAWAII	HAW.	HWY-H-03-02M	2003	23	53

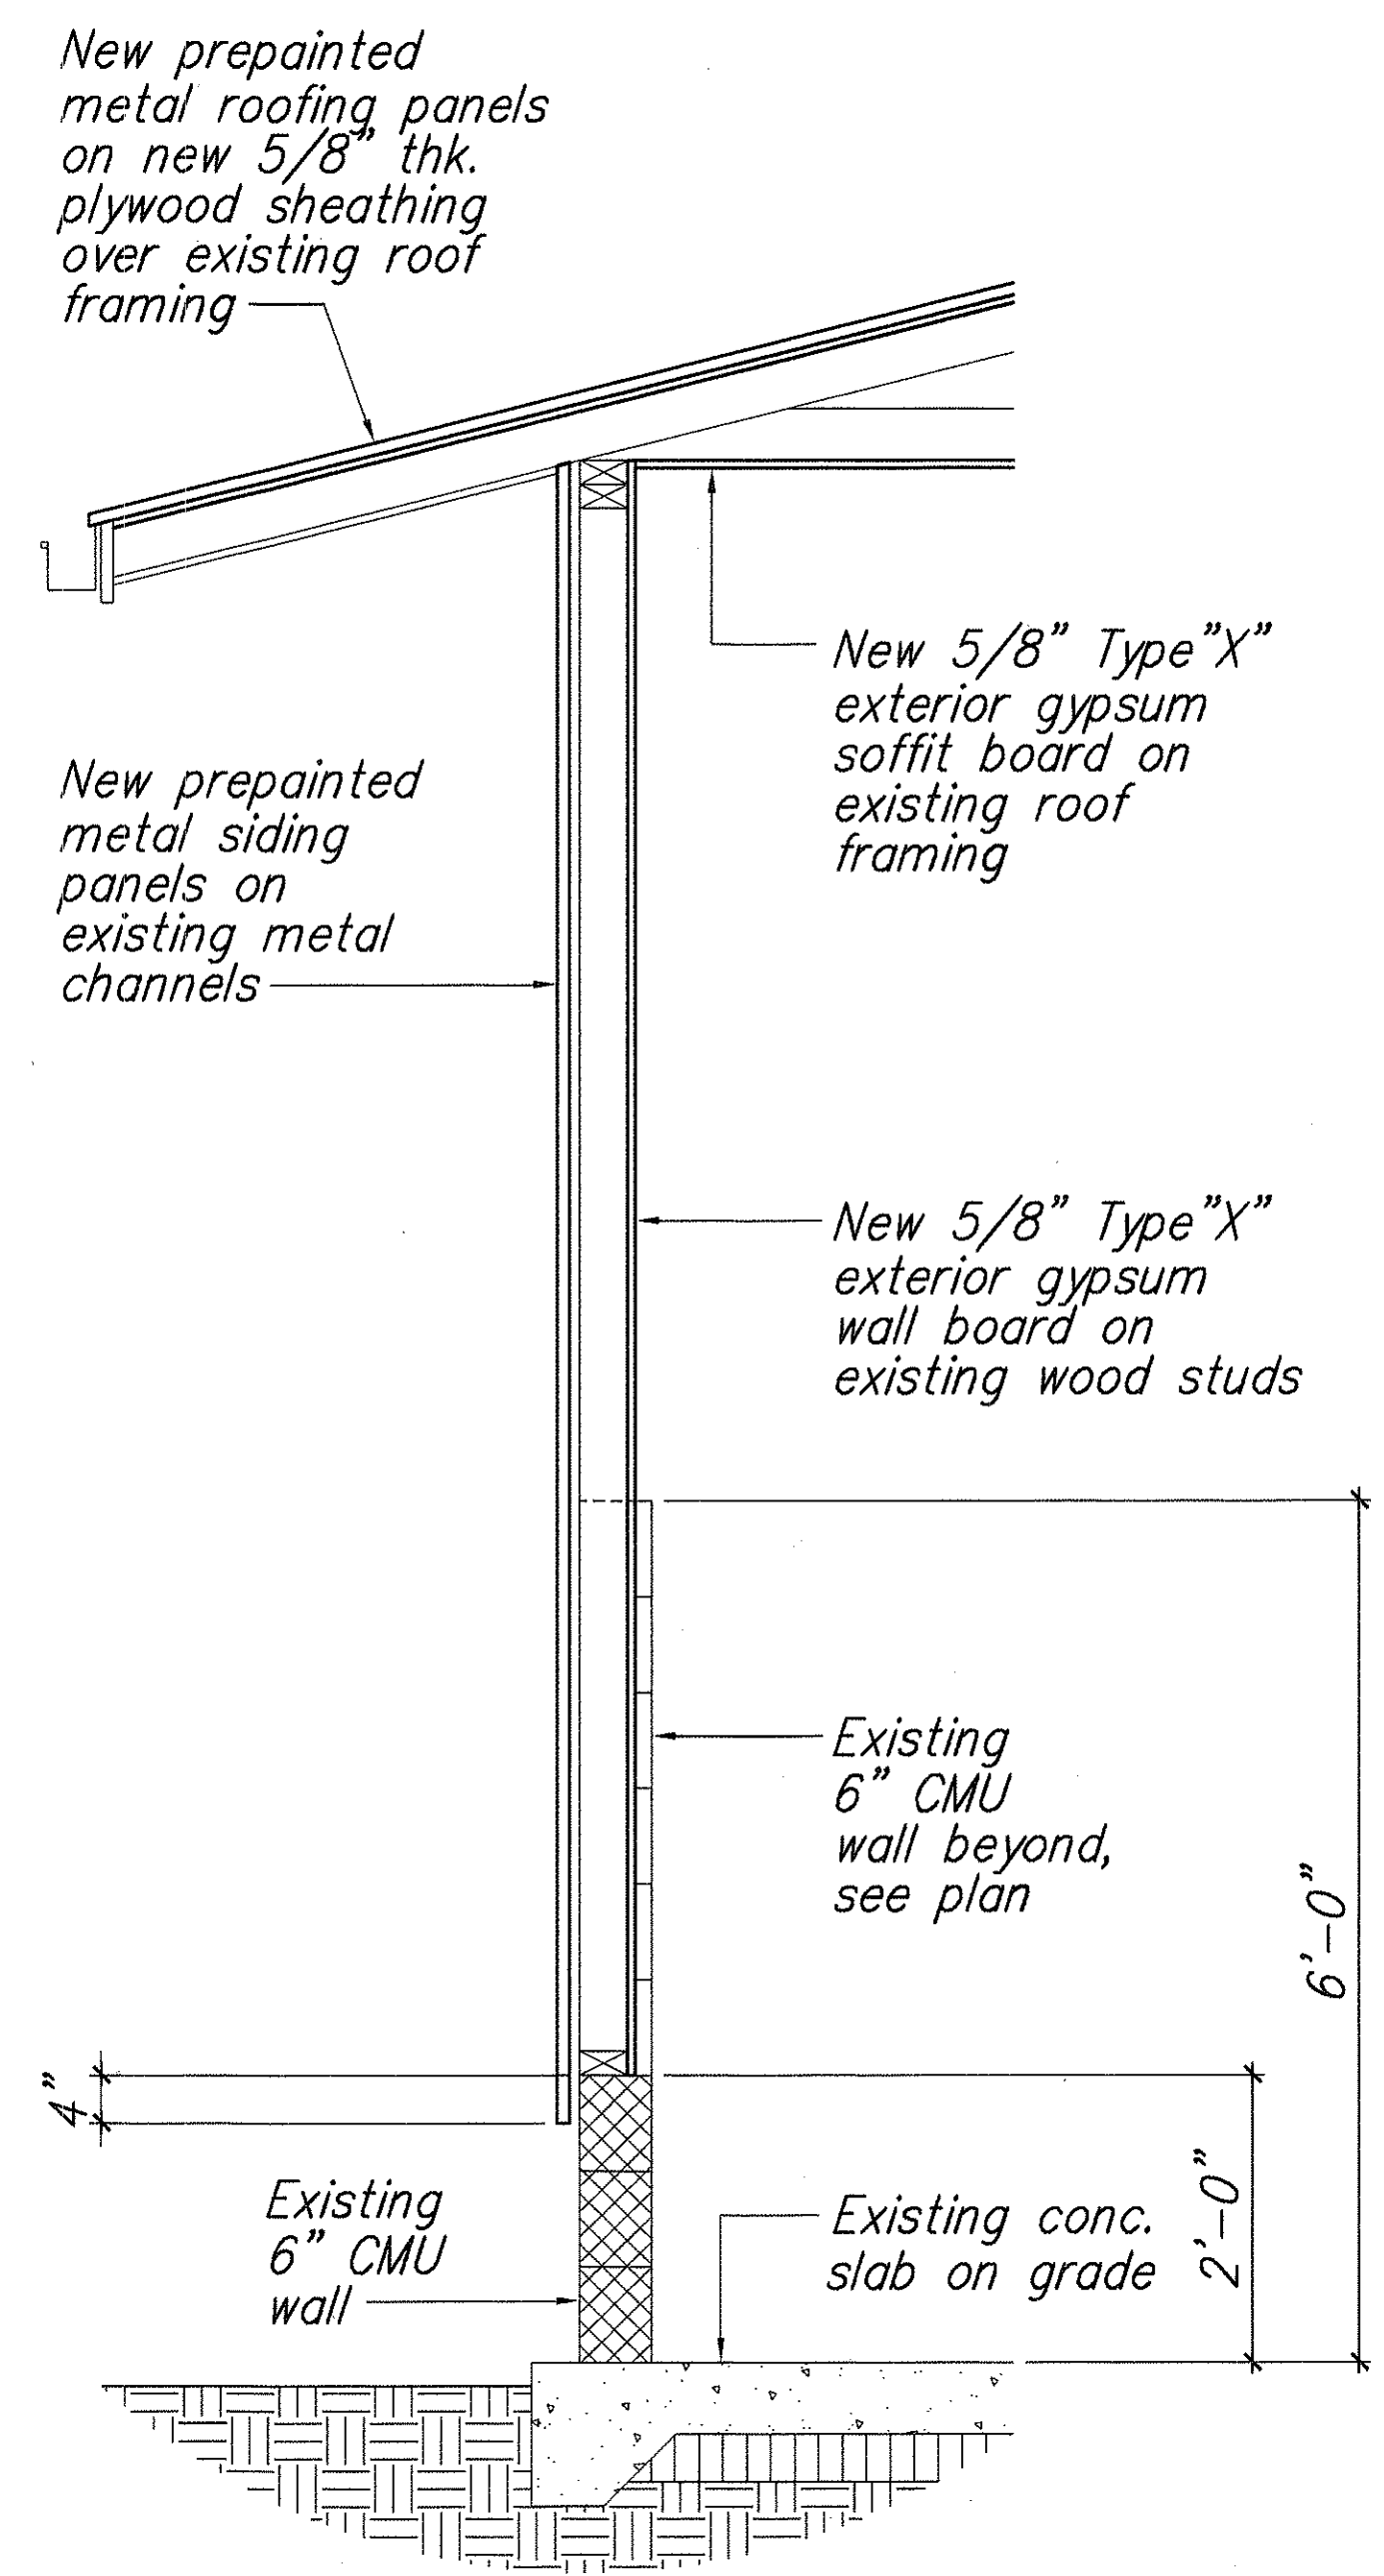

1 Wall Section
Scale: 3/4" = 1'-0"

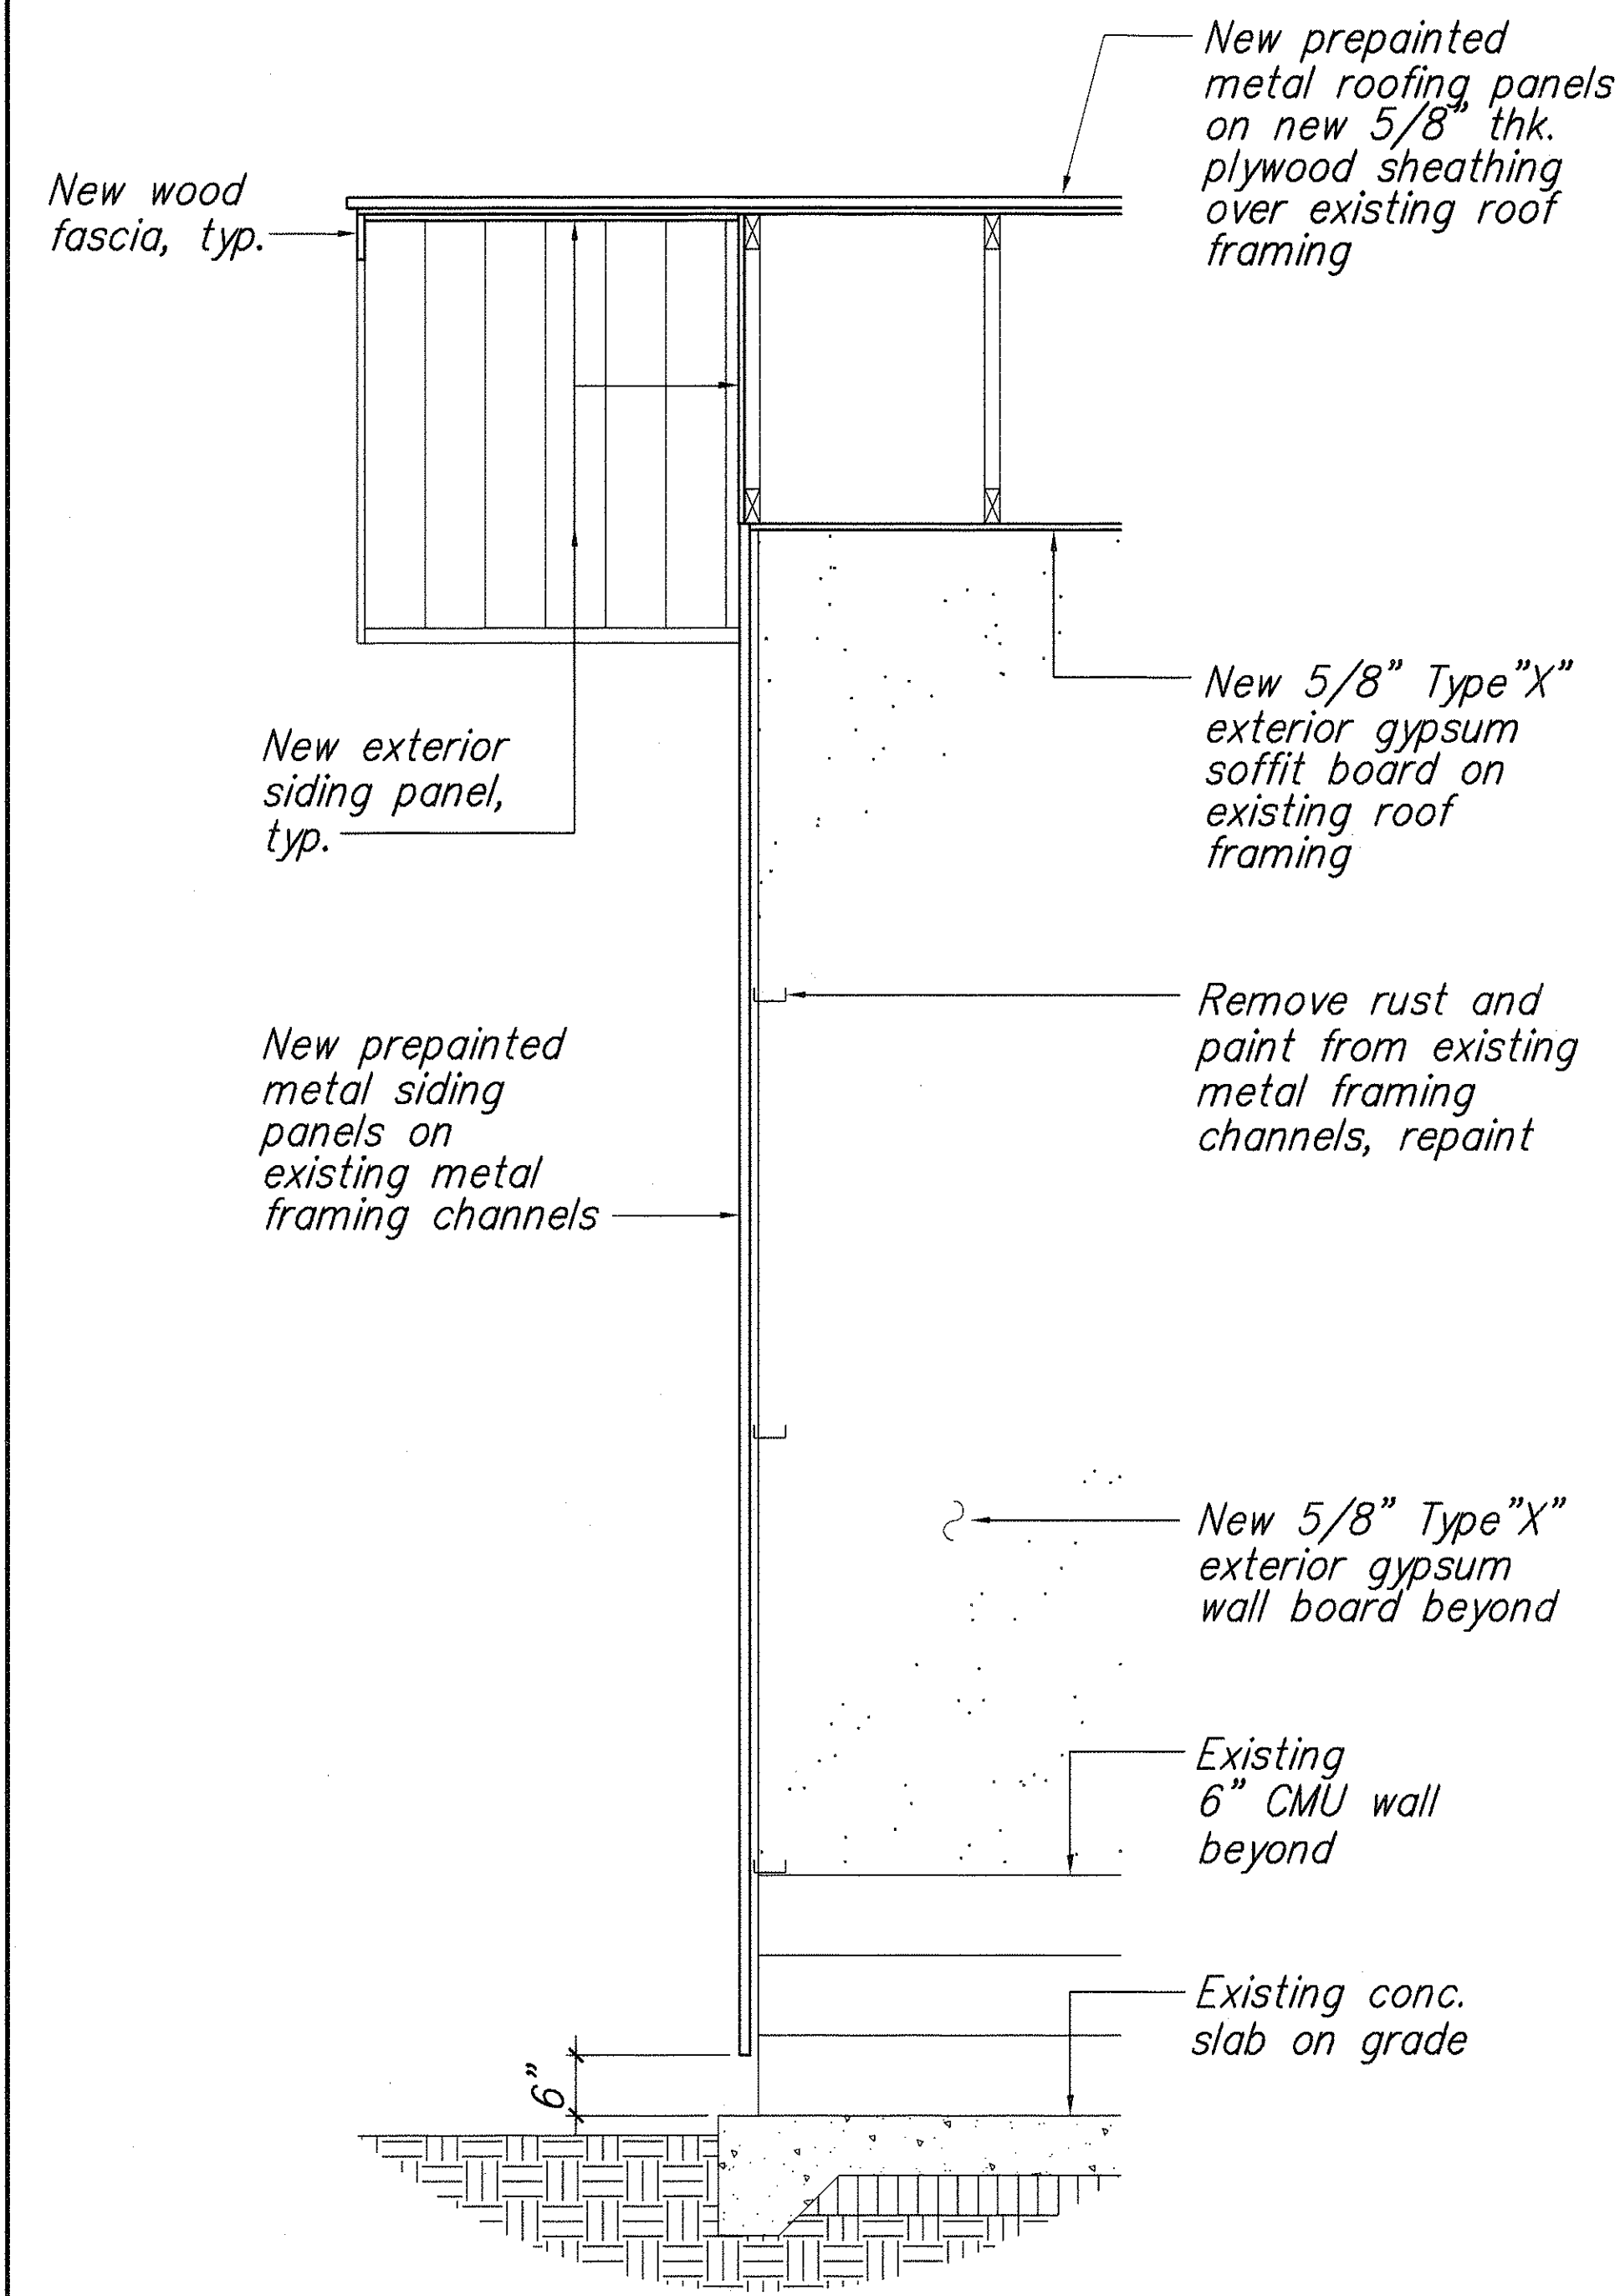


2 Wall Section
Scale: 3/4" = 1'-0"

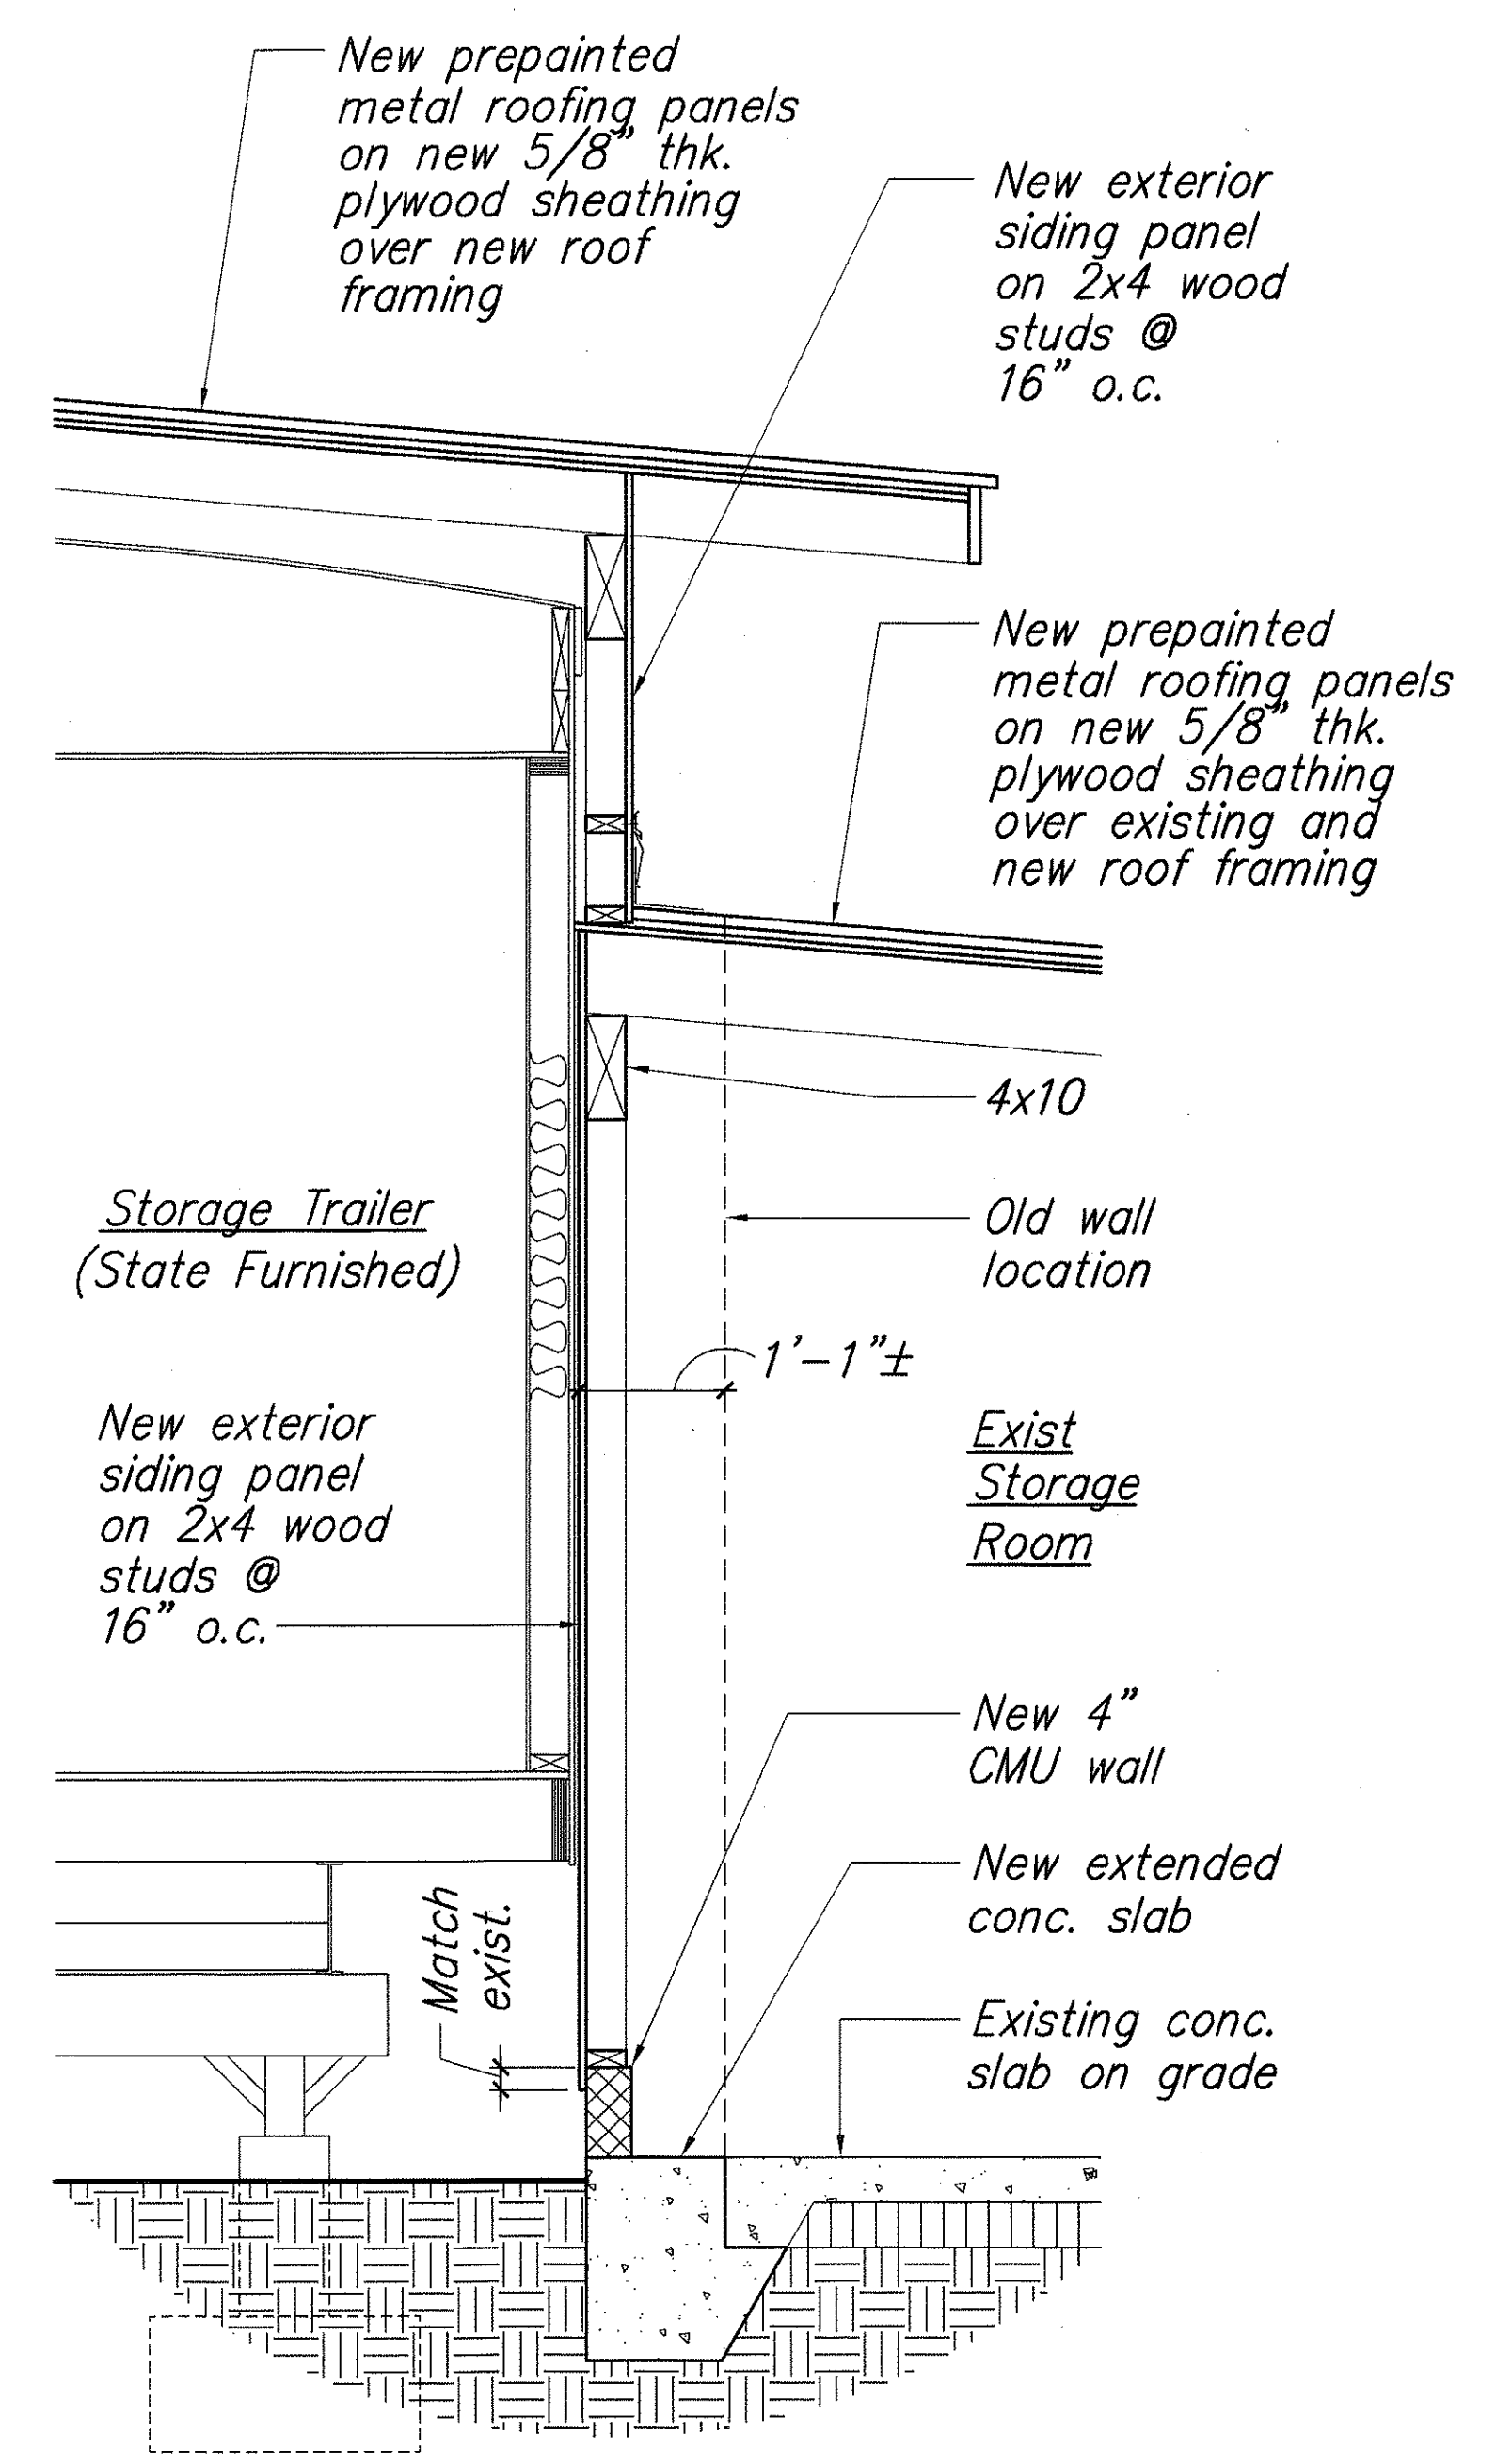

3 Wall Section
Scale: 3/4" = 1'-0"

ORIGINAL PLAN	DATE
DESIGNED BY	ER
TRACED BY	RT
QUANTITIES BY	SW
CHECKED BY	

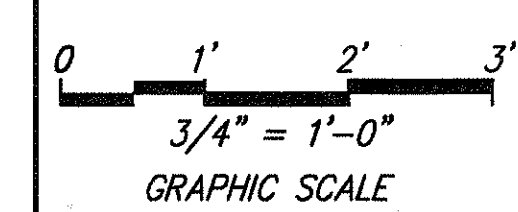

THIS WORK WAS PREPARED BY ME OR UNDER MY SUPERVISION
Steven D. King
MITSUNAGA & ASSOCIATES

STATE OF HAWAII

DEPARTMENT OF TRANSPORTATION

HIGHWAYS DIVISION

MISCELLANEOUS DETAILS

NAALEHU BASEYARD RENOVATIONS

Project No. HWY-H-03-02M

Scale: As Noted Date: April 2003

SHEET No. A-12 OF A-12 SHEETS