


| FED. ROAD DIST. NO. | STATE | PROJ. NO. | FISCAL YEAR | SHEET NO. | TOTAL SHEETS |
|---------------------|-------|--------------|-------------|-----------|--------------|
| HAWAII | HAW. | HWY-H-03-02M | 2003 | 1 | 53 |

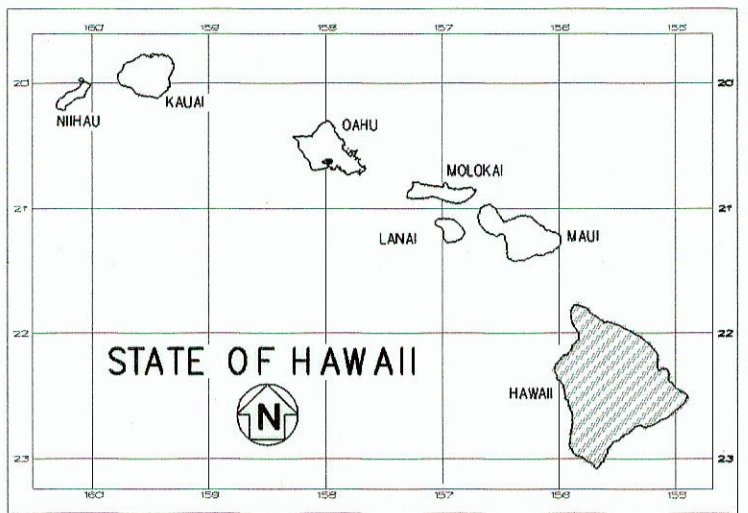


STATE OF HAWAII
DEPARTMENT OF TRANSPORTATION
HIGHWAYS DIVISION
HONOLULU, HAWAII
"AS-BUILT"
PLANS FOR
NAALEHU BASEYARD RENOVATIONS
PROJECT NO. HWY-H-03-02M
DISTRICT OF KAU
ISLAND OF HAWAII

| OVERALL SHT NO. | SHEET NO. BY DISCIPLINE | INDEX TO DRAWINGS |
|-----------------|-------------------------|---------------------------------------------------------------------------------------------------|
| | | DESCRIPTION |
| 1 | T-1 | TITLE SHEET |
| 2 | T-2 | GENERAL NOTES AND LEGEND |
| 3 | C-1 | WATER POLLUTION & EROSION CONTROL NOTES - 1 |
| 4 | C-2 | WATER POLLUTION & EROSION CONTROL NOTES - 2 |
| 5 | C-3 | SITE PLAN |
| 6 | C-4 | GRADING PLAN |
| 7 | C-5 | PROFILES |
| 8 | C-6 | MISCELLANEOUS DETAILS - 1 |
| 9 | C-7 | MISCELLANEOUS DETAILS - 2 |
| 10 | C-8 | MISCELLANEOUS DETAILS - 3 |
| 11 | C-9 | MISCELLANEOUS DETAILS - 4 |
| 12 | A-1 | GAS PUMP SHED FLOOR PLAN |
| 13 | A-2 | GAS PUMP SHED ROOF PLAN, REFLECTED CEILING PLAN, EXTERIOR ELEVATIONS & BUILDING SECTION |
| 14 | A-3 | FIELD OFFICE/STORAGE SHED/BREEZEWAY FLOOR & DEMOLITION PLAN |
| 15 | A-4 | RELOCATED STORAGE TRAILER @ STORAGE ROOM & COVERED PATIO FLOOR PLAN |
| 16 | A-5 | STORAGE TRAILER & LEAN-TO ROOF PLAN, REFL CLG PLAN, EXT ELEV & BUILDING SECTION |
| 17 | A-6 | GARAGE & EQUIPMENT STORAGE FLOOR PLAN & REFLECTED CEILING PLAN |
| 18 | A-7 | RESIDENCE DEMOLITION PLAN |
| 19 | A-8 | NEW OFFICE TRAILER @ OLD RESIDENCE LOCATION FLOOR PLAN |
| 20 | A-9 | STAIR RAMP AND LANDING DETAILS |
| 21 | A-10 | MISCELLANEOUS DETAILS |
| 22 | A-11 | MISCELLANEOUS DETAILS |
| 23 | A-12 | MISCELLANEOUS DETAILS |
| 24 | S-1 | GENERAL NOTES |
| 25 | S-2 | GENERAL NOTES |
| 26 | S-3 | GAS PUMP SHED PLANS |
| 27 | S-4 | STORAGE TRAILER, STORAGE ROOM AND COVERED PATIO - GROUND FLOOR AND FOUNDATION PLAN |
| 28 | S-5 | STORAGE TRAILER, STORAGE ROOM AND COVERED PATIO - COVERED PATIO FLOOR FRAMING PLAN |
| 29 | S-6 | STORAGE TRAILER, STORAGE ROOM AND COVERED PATIO - ROOF FRAMING PLAN |
| 30 | S-7 | GARAGE AND EQUIPMENT STORAGE PLANS |
| 31 | S-8 | SLAB-ON-GRADE AND FOUNDATION DETAILS |
| 32 | S-9 | ROOF FRAMING DETAILS |
| 33 | S-10 | ROOF AND FLOOR FRAMING DETAILS |
| 34 | S-11 | NEW OFFICE TRAILER AND COVERED PATIO (DEDUCTIVE BID ALTERNATE) - FOUNDATION PLAN |
| 35 | S-12 | NEW OFFICE TRAILER AND COVERED PATIO (DEDUCTIVE BID ALTERNATE) - COVERED PATIO FLOOR FRAMING PLAN |
| 36 | S-13 | NEW OFFICE TRAILER AND COVERED PATIO (DEDUCTIVE BID ALTERNATE) - ROOF FRAMING PLAN |

| OVERALL SHT NO. | SHEET NO. BY DISCIPLINE | INDEX TO DRAWINGS CONT |
|-----------------|-------------------------|----------------------------------------------------------------------------|
| | | DESCRIPTION |
| 37 | M-1 | MECH SITE PLAN, GENERAL NOTES, LEGEND & ABBREVIATIONS |
| 38 | M-2 | NEW OFFICE TRAILER, SANITARY & WATER PIPING DIAGRAM |
| 39 | M-3 | EXST GARAGE & EQUIP STOR FLR PLAN & COMPRESSED AIR PIPING DIAGRAM |
| 40 | M-4 | NEW STOR TRAILER, STOR RM & COVERED PATIO & WATER PIPING DIAGRAM |
| 41 | M-5 | GAS PUMP SHED FLOOR PLAN, COMPRESSED AIR PIPING DIAGRAM & DETAIL |
| 42 | M-6 | WASH PAD FLR PLAN, WATER PIPING DIAGRAM & DETAIL |
| 43 | M-7 | ABOVE GROUND DIESEL/GASOLINE TANK PLAN, SCHEMATIC & PIPING DIAGRAMS |
| 44 | M-8 | DETAILS |
| 45 | E-1 | ELECTRICAL SYMBOL LIST, ELECTRICAL DEMOLITION PLAN, & LUMINAIRE SCHEDULE |
| 46 | E-2 | ELECTRICAL SITE PLAN |
| 47 | E-3 | PULLBOX DETAILS |
| 48 | E-4 | GARAGE & EQUIPMENT STORAGE ELECTRICAL PLANS |
| 49 | E-5 | GAS PUMP SHED ELECTRICAL PLANS |
| 50 | E-6 | STORAGE TRAILER @ STORAGE ROOM & COVERED PATIO ELECTRICAL & LIGHTING PLANS |
| 51 | E-7 | TRAILER ELECTRICAL PLANS |
| 52 | E-8 | ONE-LINE DIAGRAM & METER ELEVATION |
| 53 | EN-1 | REMOVAL & DEMOLITION OF LEAD CONTAINING ITEMS |

PROJECT LOCATION
NAALEHU BASEYARD

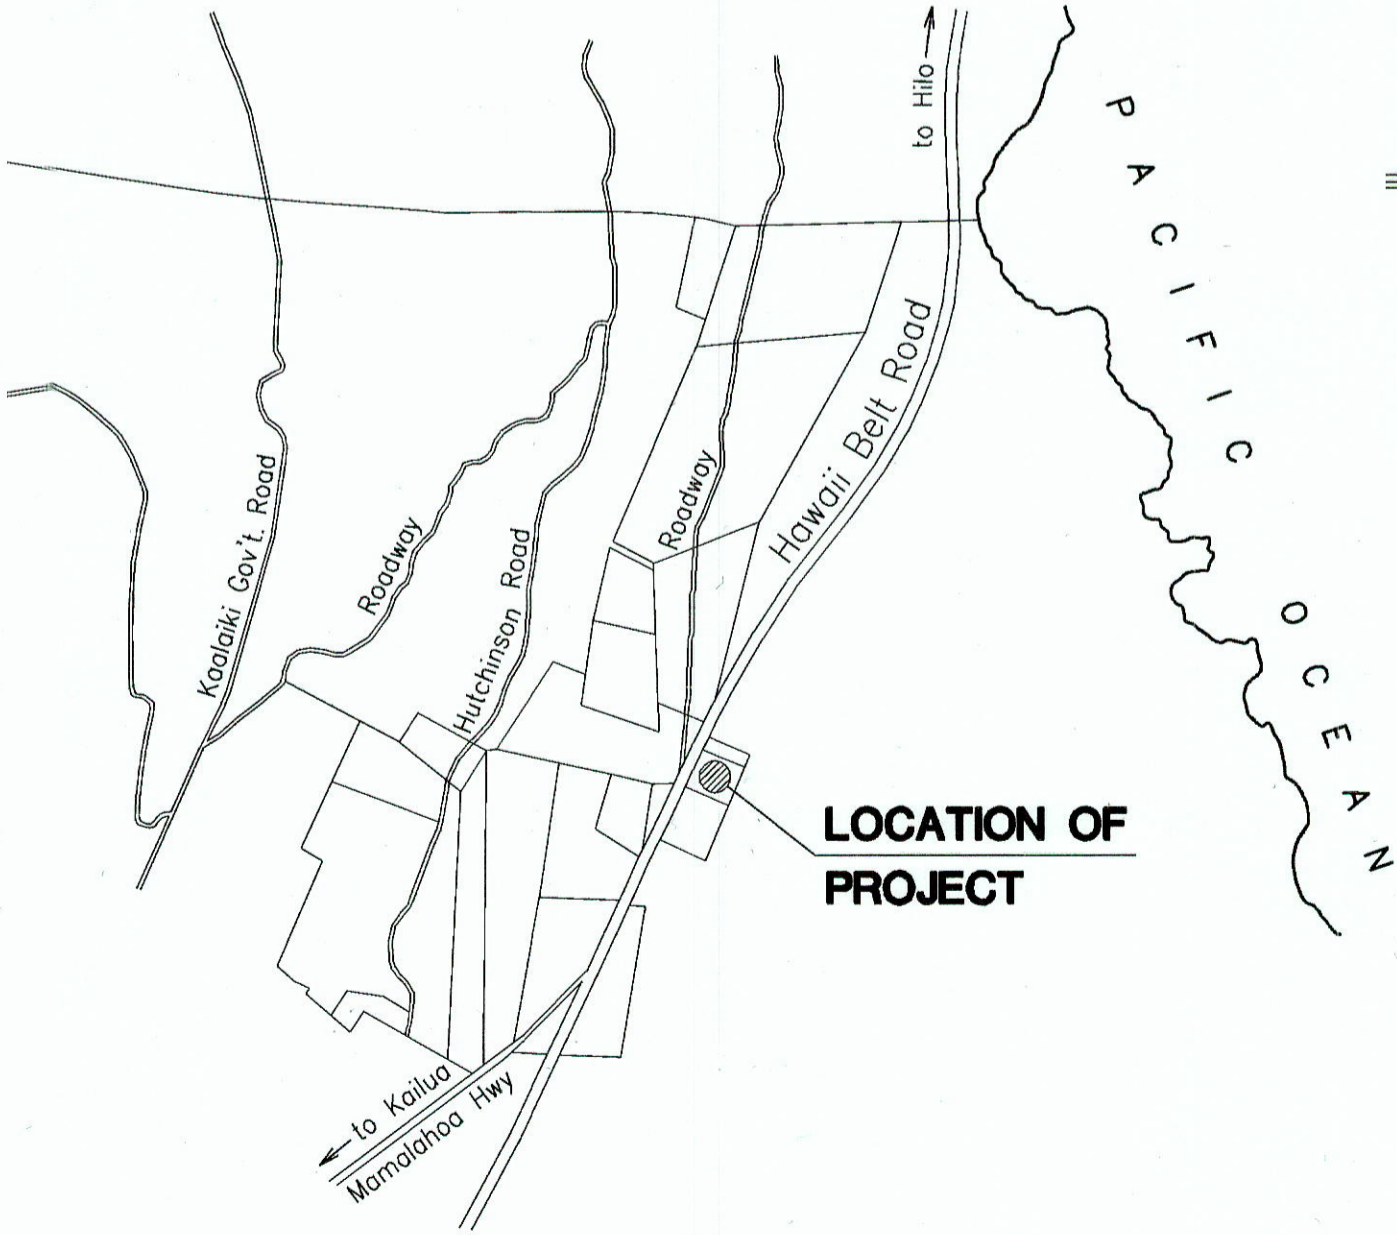

LOCATION MAP
NOT TO SCALE

FEDERAL AID PROJECTS PREVIOUSLY CONSTRUCTED OR UNDER CONSTRUCTION

NAALEHU BASEYARD MILE POST 62.50

CHANGES MADE DURING CONSTRUCTION HAVE BEEN INCORPORATED ON THESE PLANS EXCEPT CHANGES IN THE ORIGINAL THEORETICAL QUANTITIES. FOR ACTUAL QUANTITIES, REFER TO PROJECT LEDGER AND/OR COMPUTATION BOOK.
R. S. & E. BY
RESIDENT ENGINEER
10/17/03
DATE

DEPARTMENT OF TRANSPORTATION
STATE OF HAWAII
APPROVED: _____
DIR. OF TRANSPORTATION
SHEET No. T-1 OF T-2 SHEETS
DATE 4-10-03

MITSUNAGA & ASSOCIATES
DESIGNED BY R. SHIOJI
P. S. & E. BY P. S. & E. BY
933-8866
FEB. 2003
PHONE
DATE

Plan Sheet No. 115-1 is a Supplementary Sheet to this Project.
Total Sheet Count After "AS-BUILT" posting 54 sheets.