


FED. ROAD DIST. NO.	STATE	PROJ. NO.	FISCAL YEAR	SHEET NO.	TOTAL SHEETS
HAWAII	HAW.	HWY-H-02-06M	2006	9	12

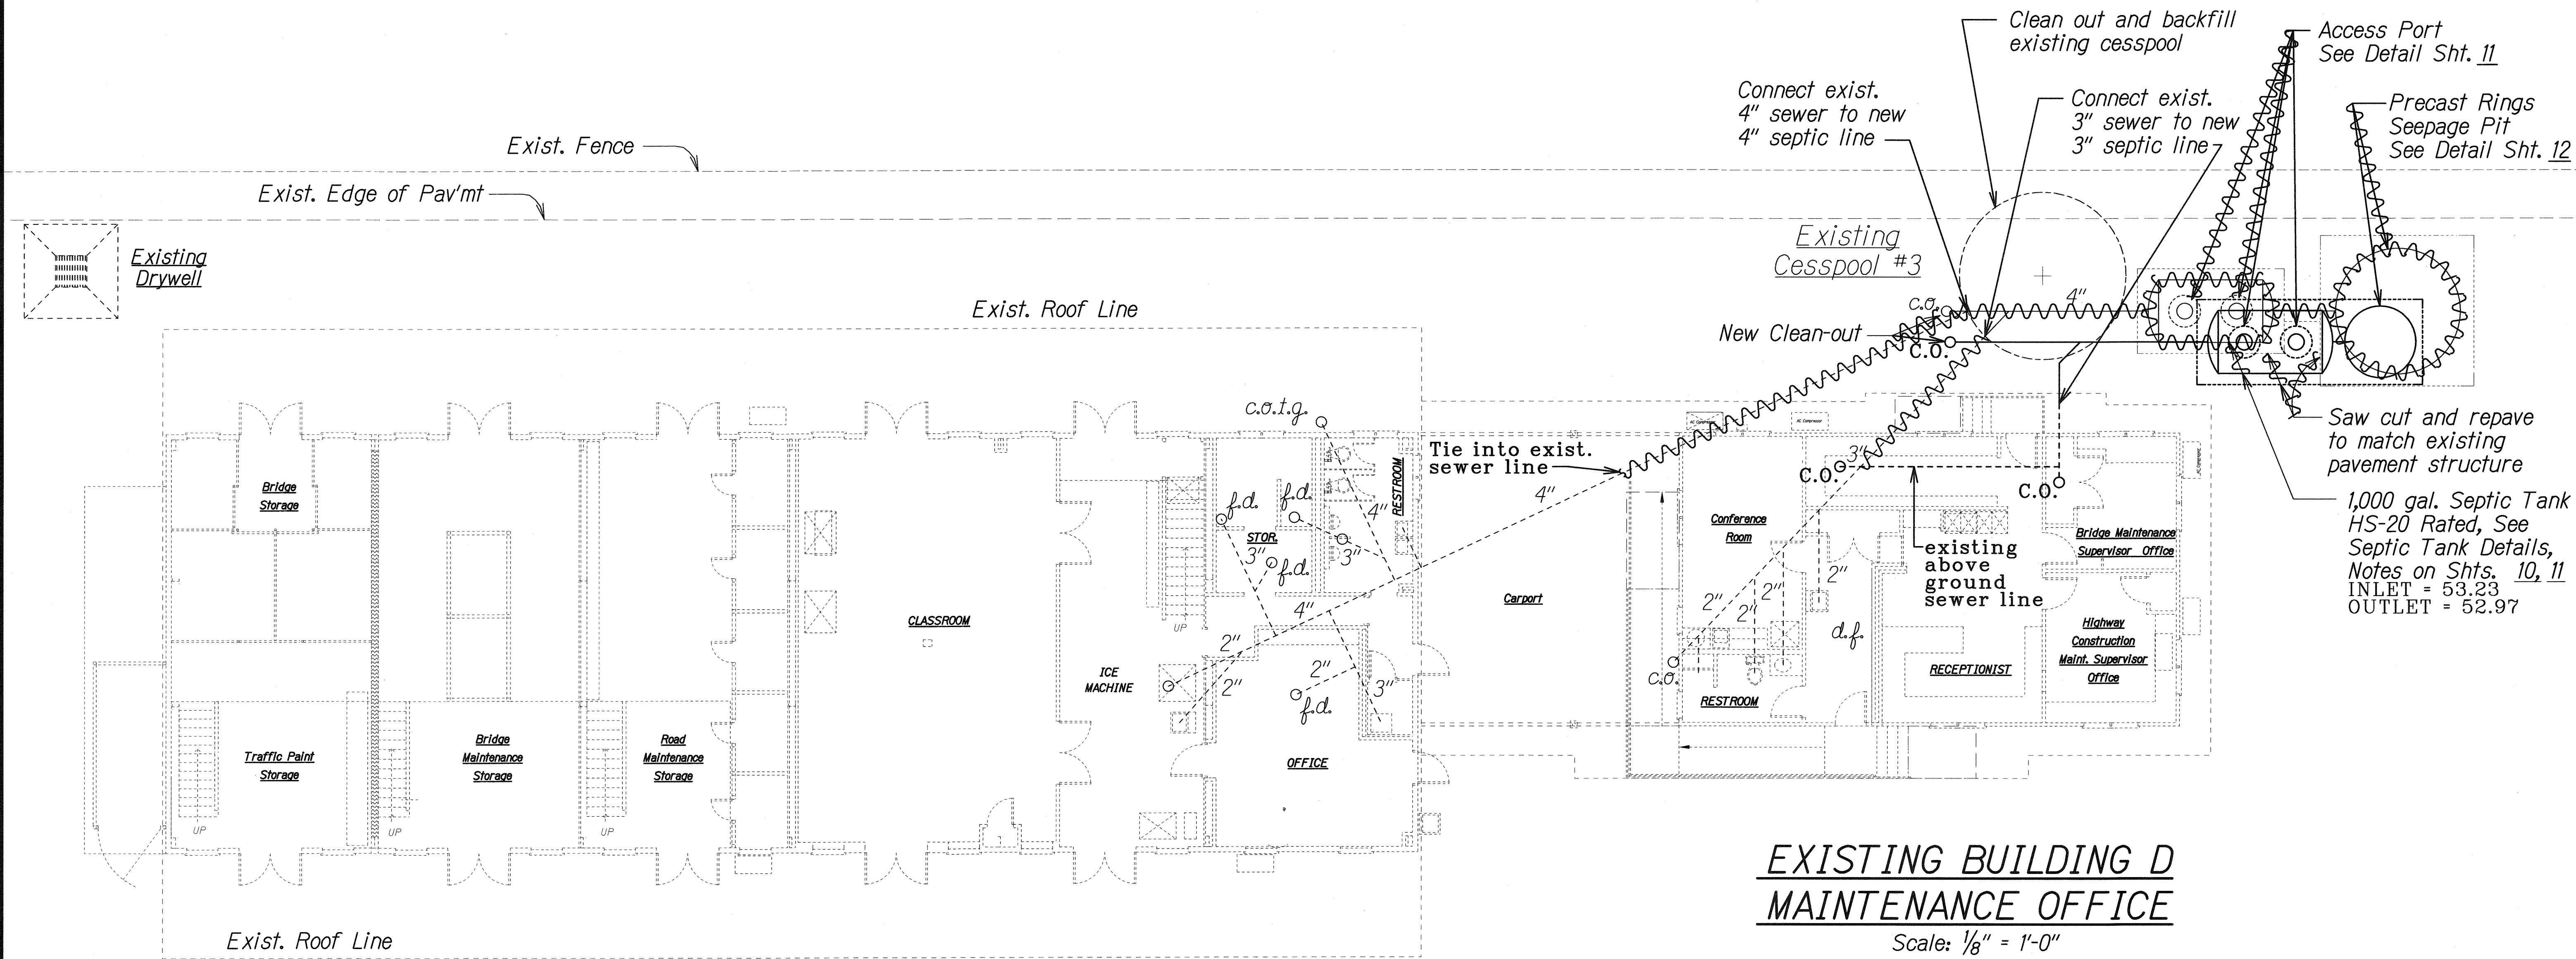

EXISTING BUILDING D
Scale: 1/8" = 1'-0"

**EXISTING BUILDING D
MAINTENANCE OFFICE**
Scale: 1/8" = 1'-0"

**LEGEND FOR
AS-BUILT POSTINGS**

Squiggly line for as-built deletion

Double line for as-built deletion

Roadway Text for as-built posting

----- Existing Sewer Line
 _____ new 4" pipe

STATE OF HAWAII
 DEPARTMENT OF TRANSPORTATION
 HIGHWAYS DIVISION

BUILDING - D

HILO BASEYARD
INSTALLATION OF SEPTIC SYSTEMS
PROJECT NO. HWY-H-02-06M

Scale: As Shown Date: April, 2006

SHEET No. 3 OF 3 SHEETS

ORIGINAL PLAN	SURVEY PLOTTED BY	DATE
NOTE BOOK	DRAWN BY	
DESIGNED BY		
CHECKED BY		
NOTED/leave		