

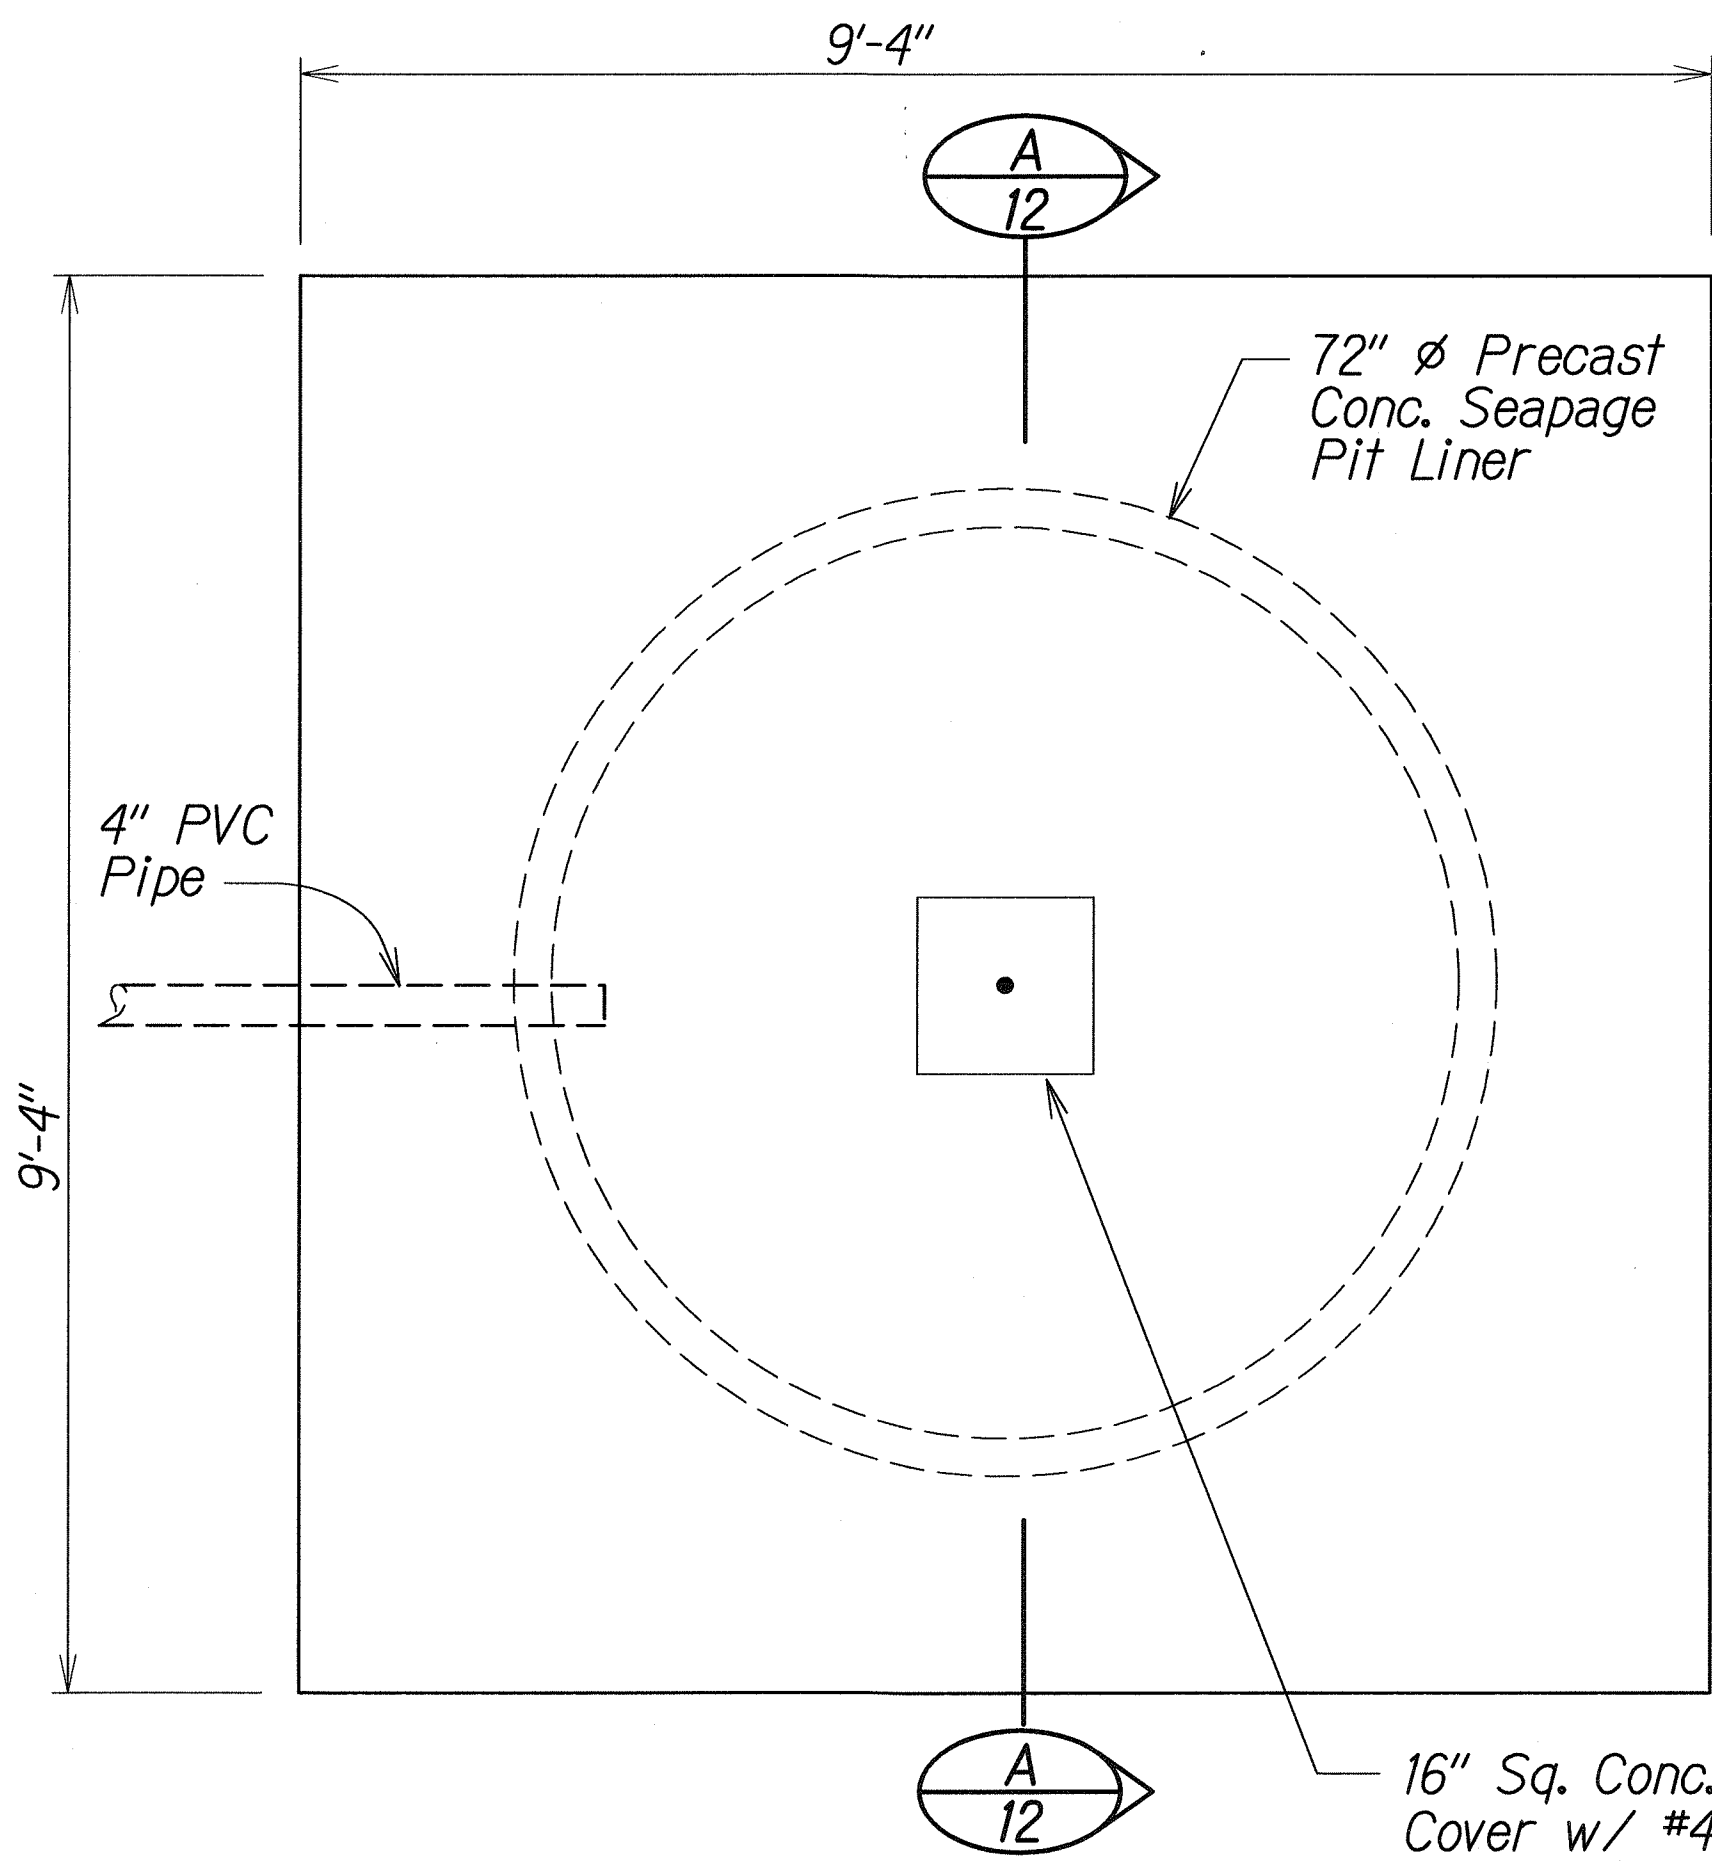



FED. ROAD DIST. NO.	STATE	PROJ. NO.	FISCAL YEAR	SHEET NO.	TOTAL SHEETS
HAWAII	HAW.	HWY-H-02-06M	2006	12	12

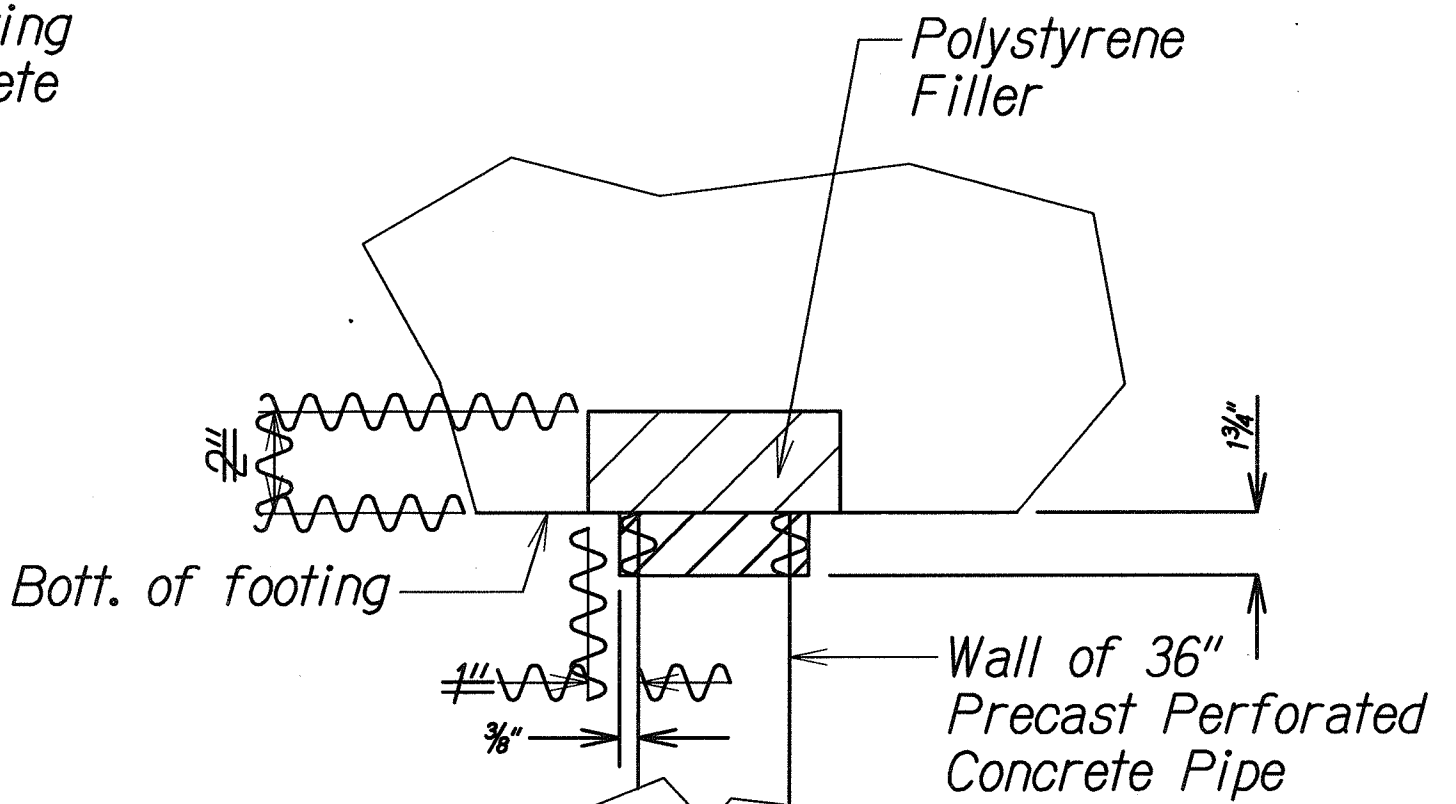


PLAN
Scale: 3/4"=1'-0"

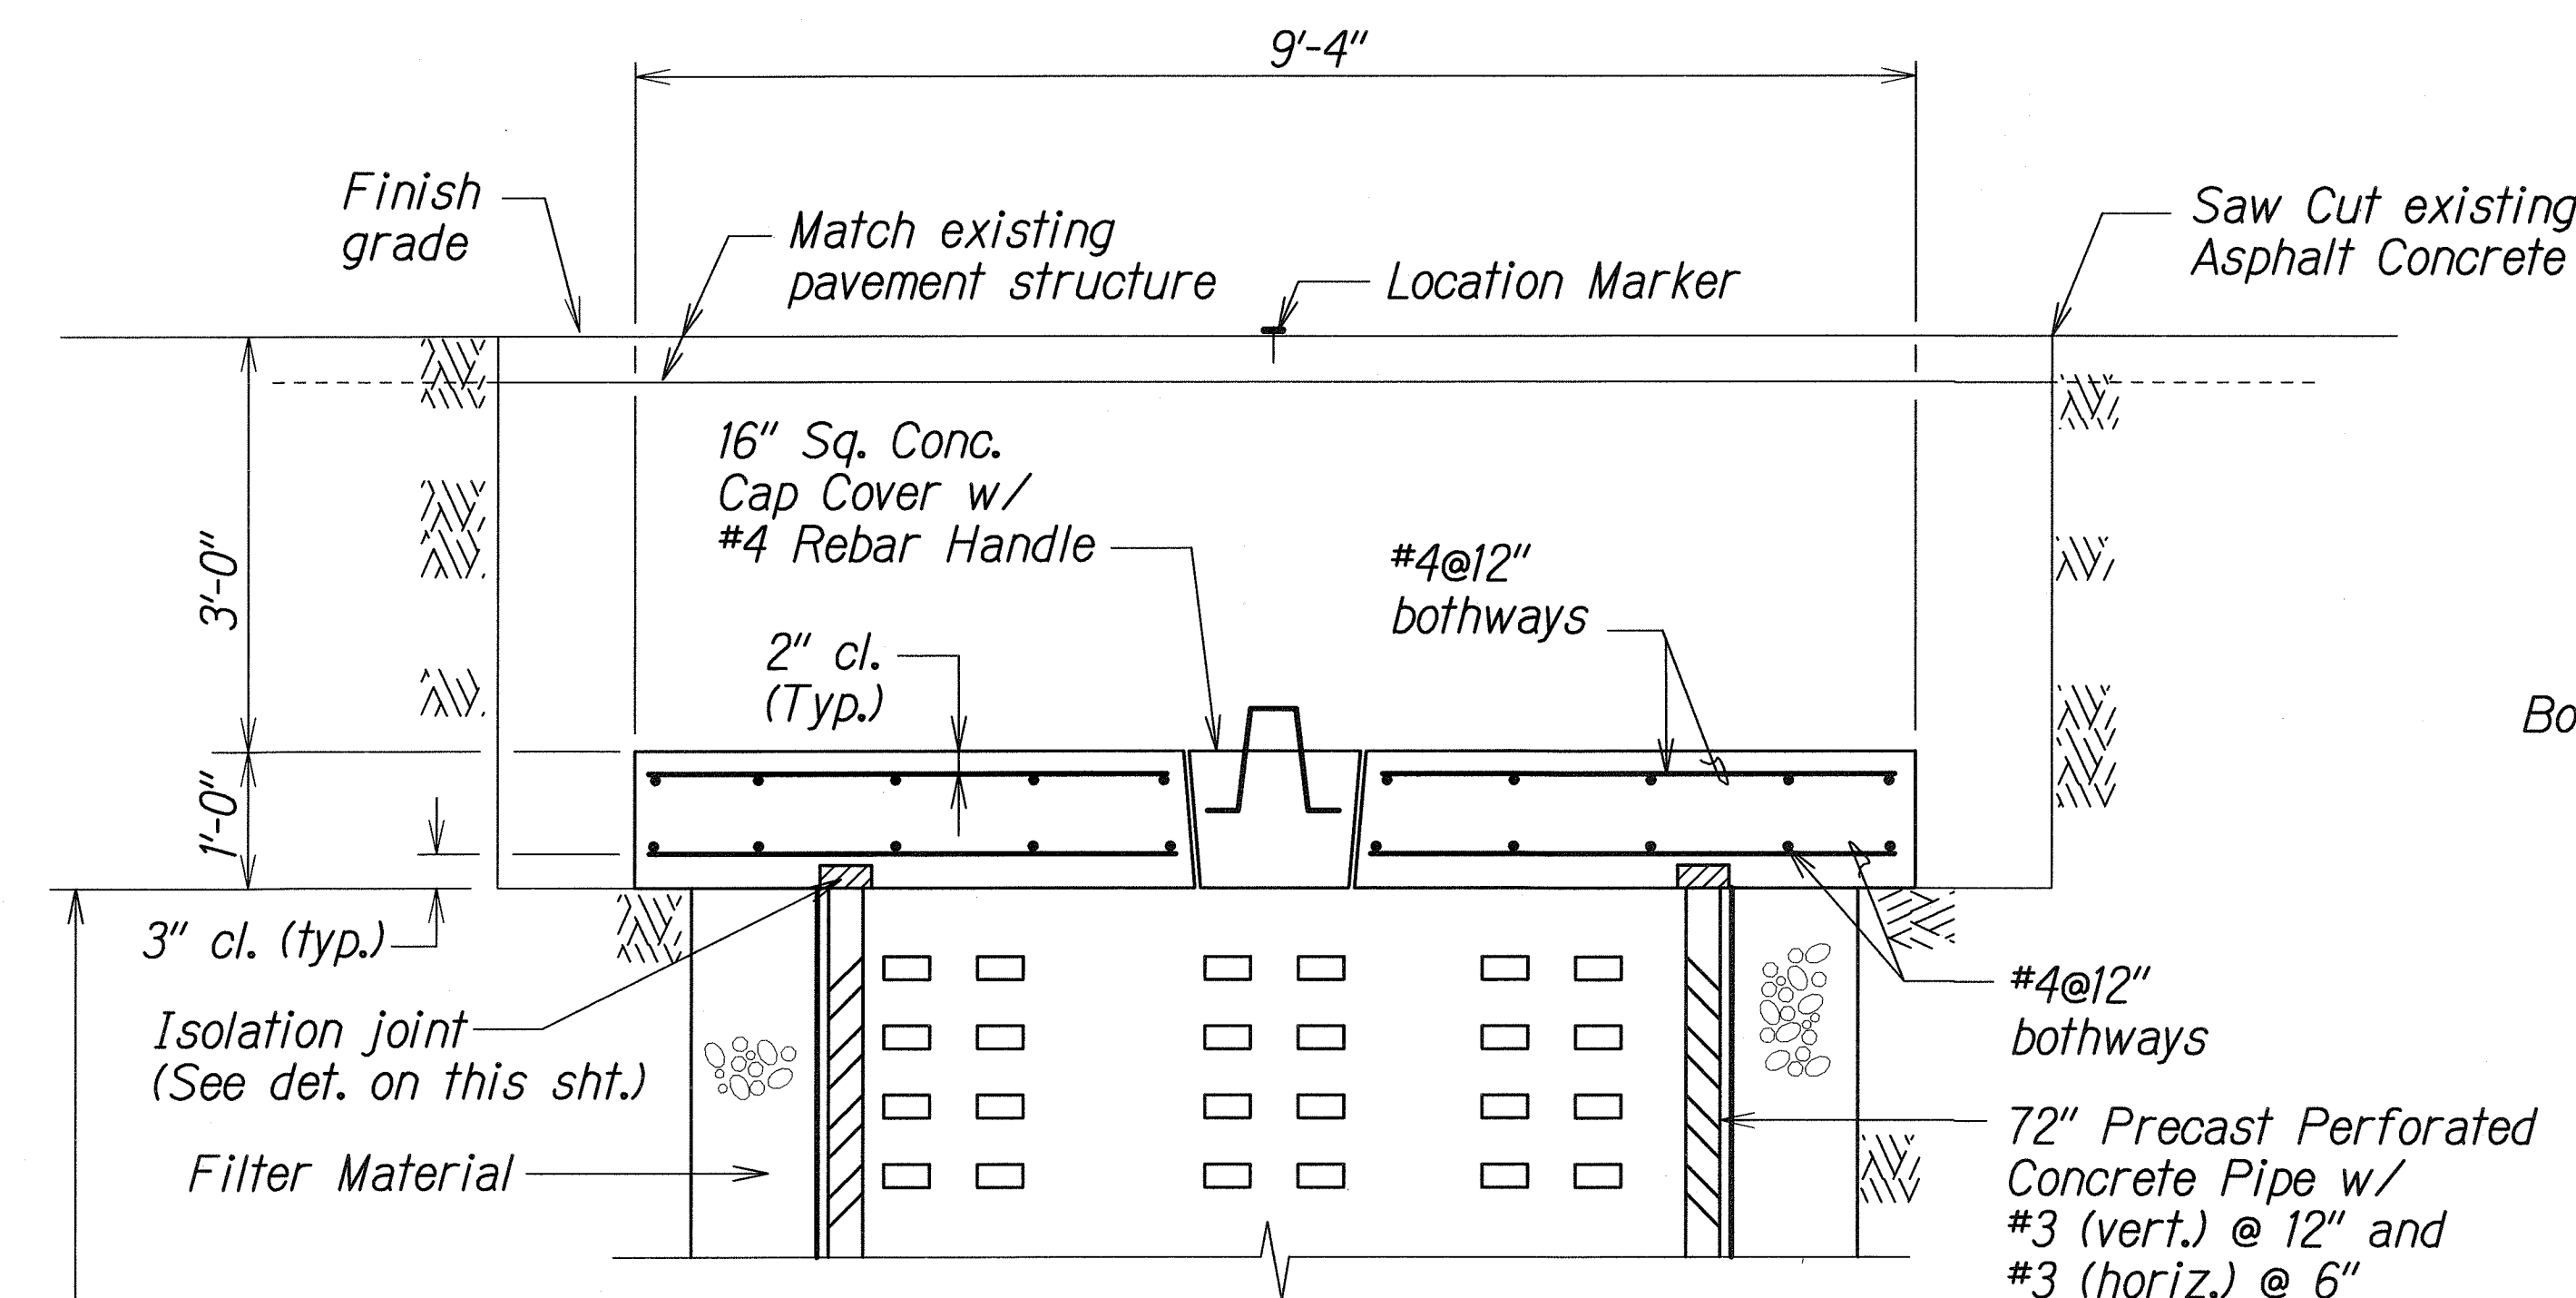


ISOLATION JOINT DETAIL
Scale: 3"=1'-0"

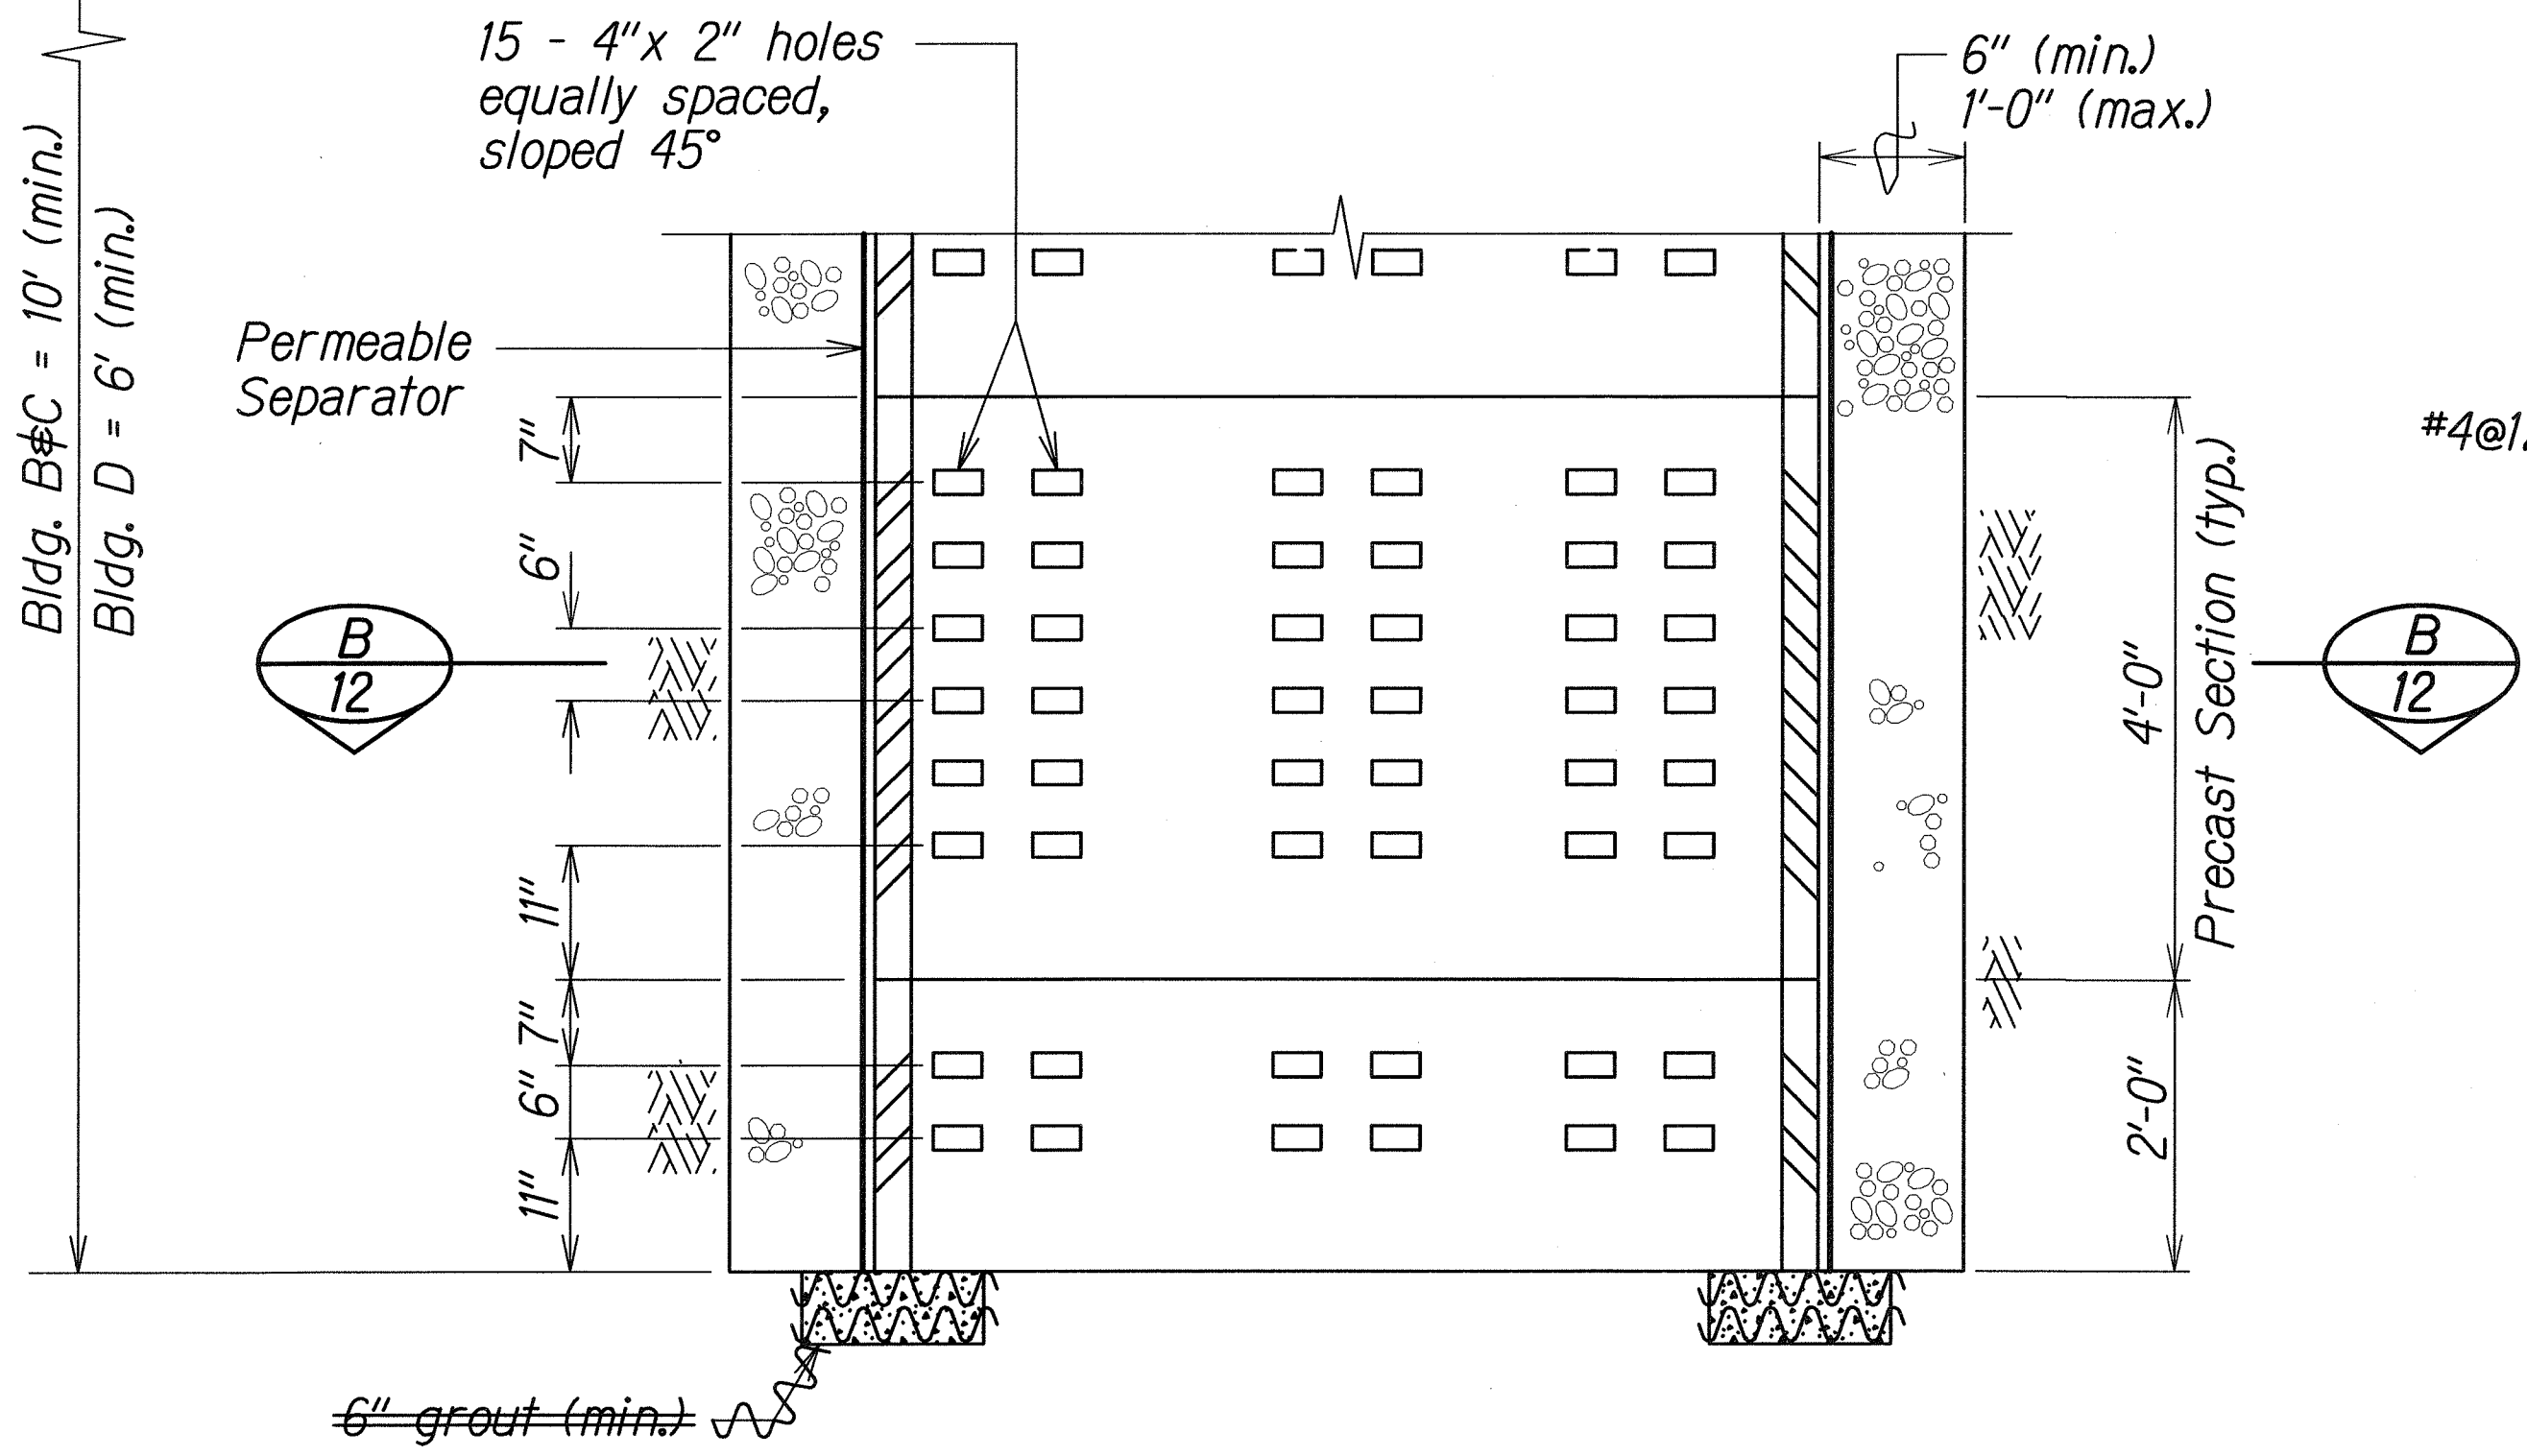

SECTION A
Scale: 3/4"=1'-0"

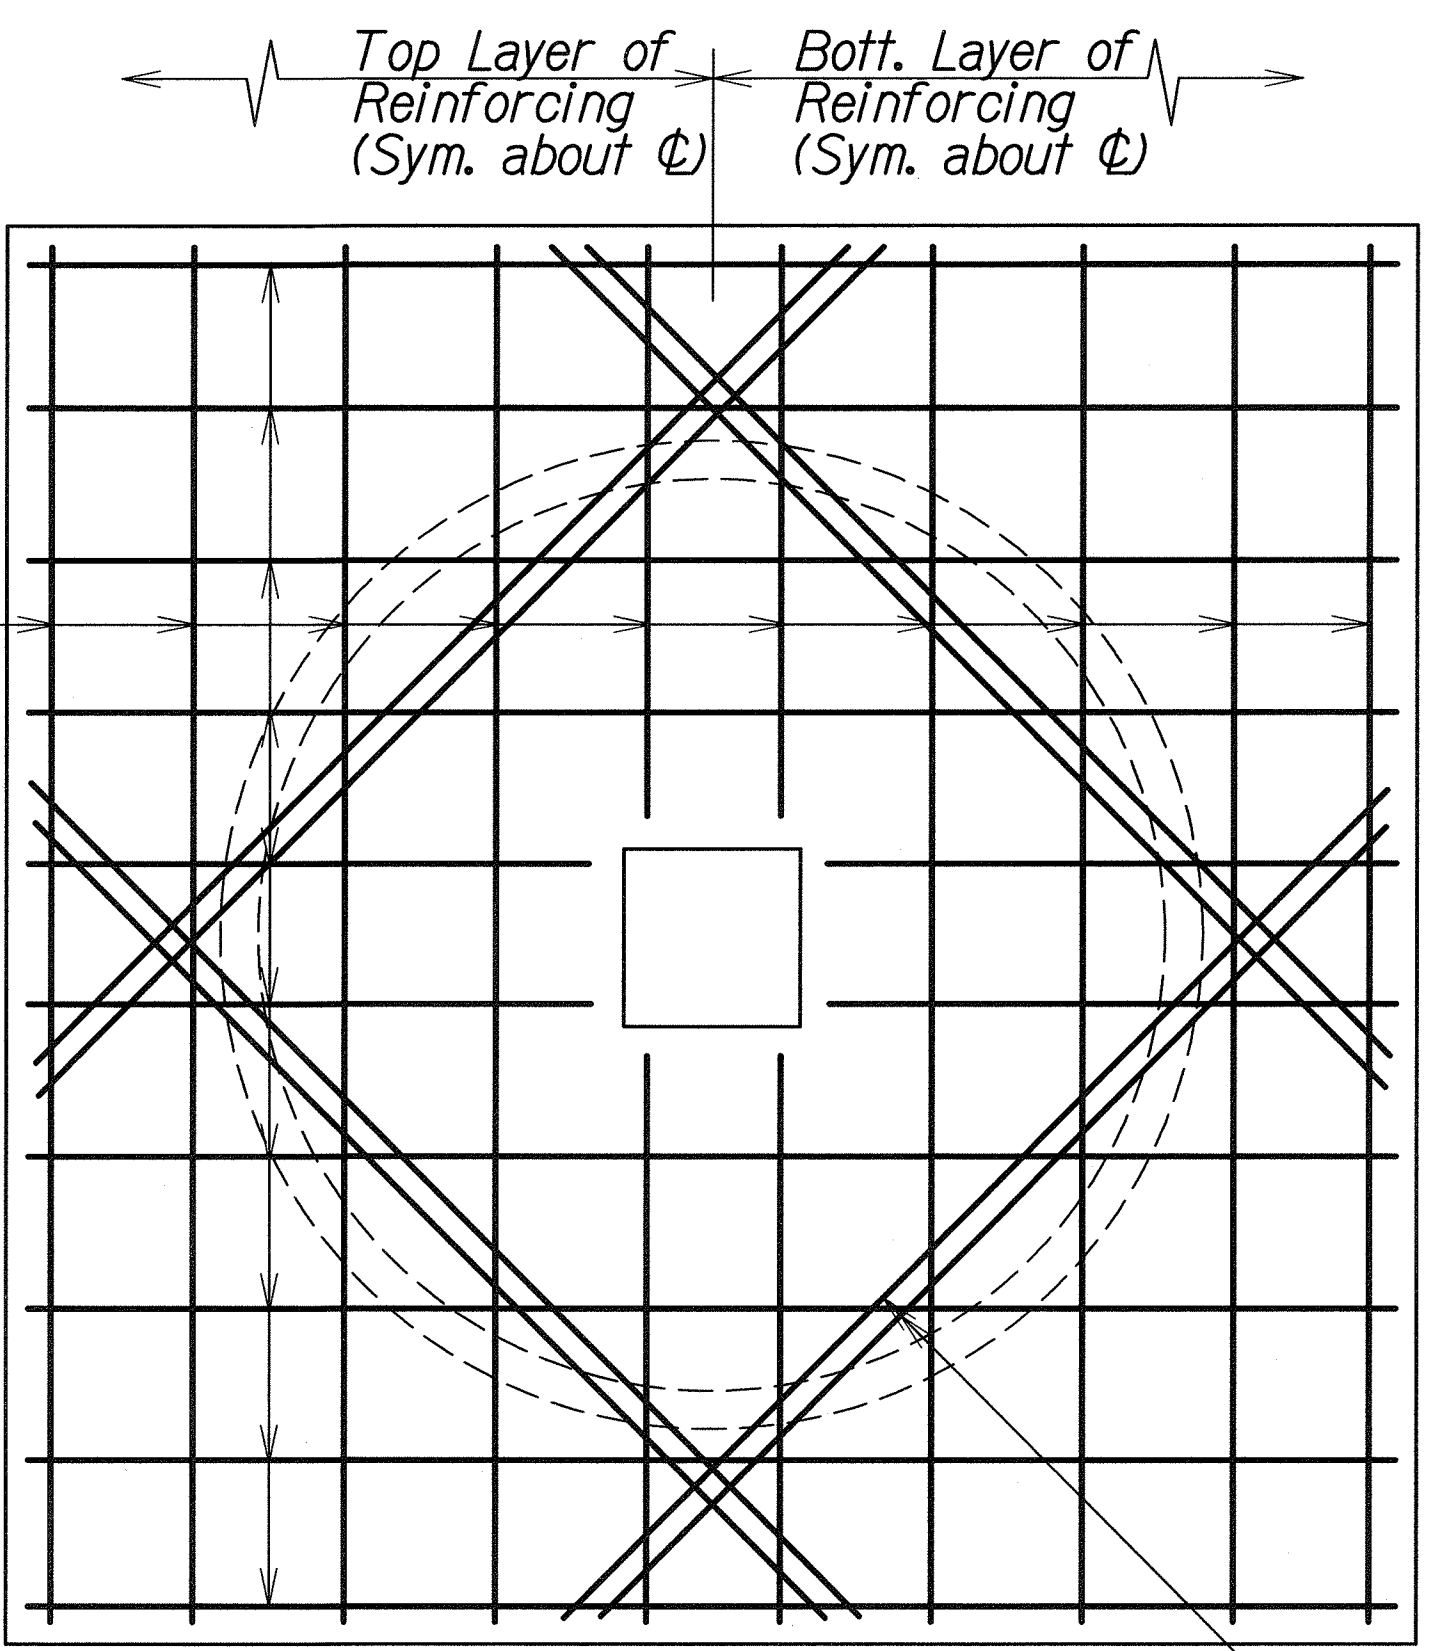

PLAN VIEW OF BOTTOM SLAB REINFORCING

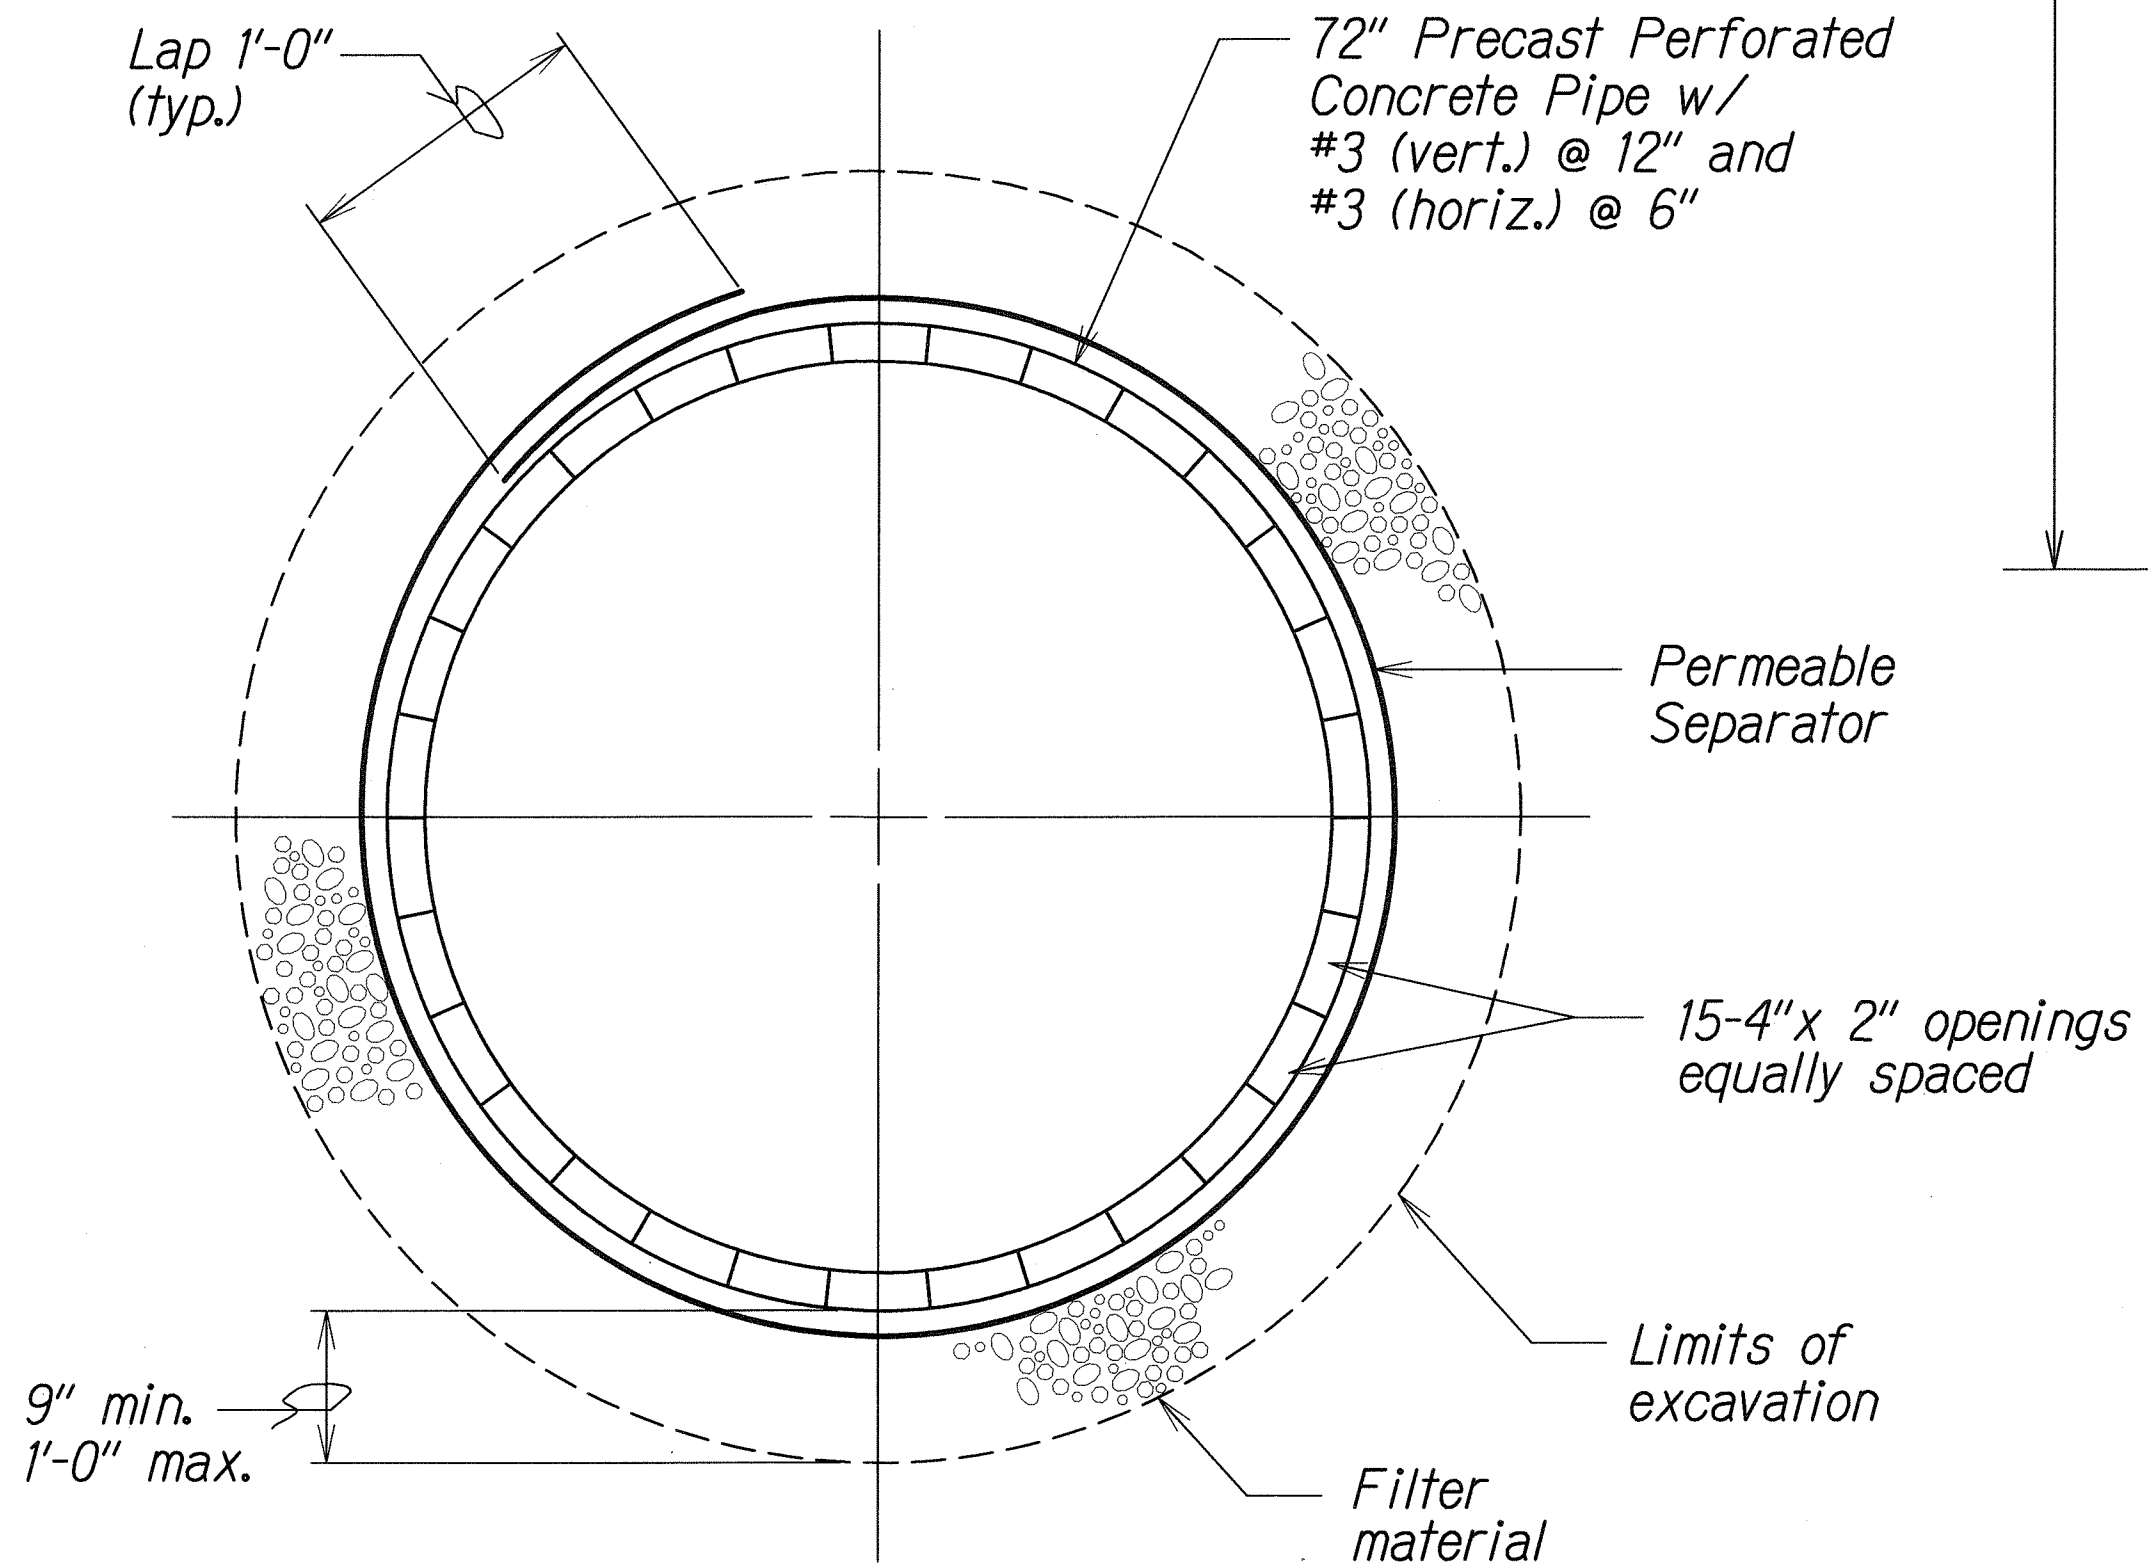

SECTION B
Scale: 3/4"=1'-0"

TYPICAL DETAILS OF NEW SEEPAGE TANK

LEGEND FOR AS-BUILT POSTINGS

	Squiggly line for as-built deletion
	Double line for as-built deletion
	Text for as-built posting

STATE OF HAWAII
DEPARTMENT OF TRANSPORTATION
HIGHWAYS DIVISION

PRE-CAST RING DETAILS FOR SEEPAGE PIT

HILO BASEYARD
INSTALLATION OF SEPTIC SYSTEMS
Project No. HWY-H-02-06M
Scale: As shown Date: April, 2006

SURVEY PLOTTED BY	DATE
DRAWN BY	
DESIGNED BY	
CHECKED BY	

"AS-BUILT"