

INDEX TO DRAWINGS	
SHEET NO.	DESCRIPTION
1	TITLE SHEET
2	STANDARD PLANS SUMMARY
3	GENERAL NOTES
4 - 5	WATER POLLUTION AND EROSION CONTROL NOTES
6	BASEYARD LOCATION PLAN
7 - 9	DETAILED SEPTIC PLANS BUILDINGS A, B/C & D
10	SEPTIC TANK AND LEACH FIELD NOTES AND DETAILS
11	SEPTIC TANK DETAILS
12	PRE-CAST RING DETAILS FOR SEEPAGE PIT

STATE OF HAWAII

DEPARTMENT OF TRANSPORTATION

HIGHWAYS DIVISION

HONOLULU, HAWAII

"AS-BUILT"

PLANS FOR

HILO BASEYARD

INSTALLATION OF SEPTIC SYSTEMS



HILO BASEYARD

PROJECT NO. HWY-H-02-06M

DISTRICT OF SOUTH HILO

ISLAND OF HAWAII

FED. ROAD DIST. NO.	STATE	PROJ. NO.	FISCAL YEAR	SHEET NO.	TOTAL SHEETS
HAWAII	HAW.	HWY-H-02-06M	2007	1	12

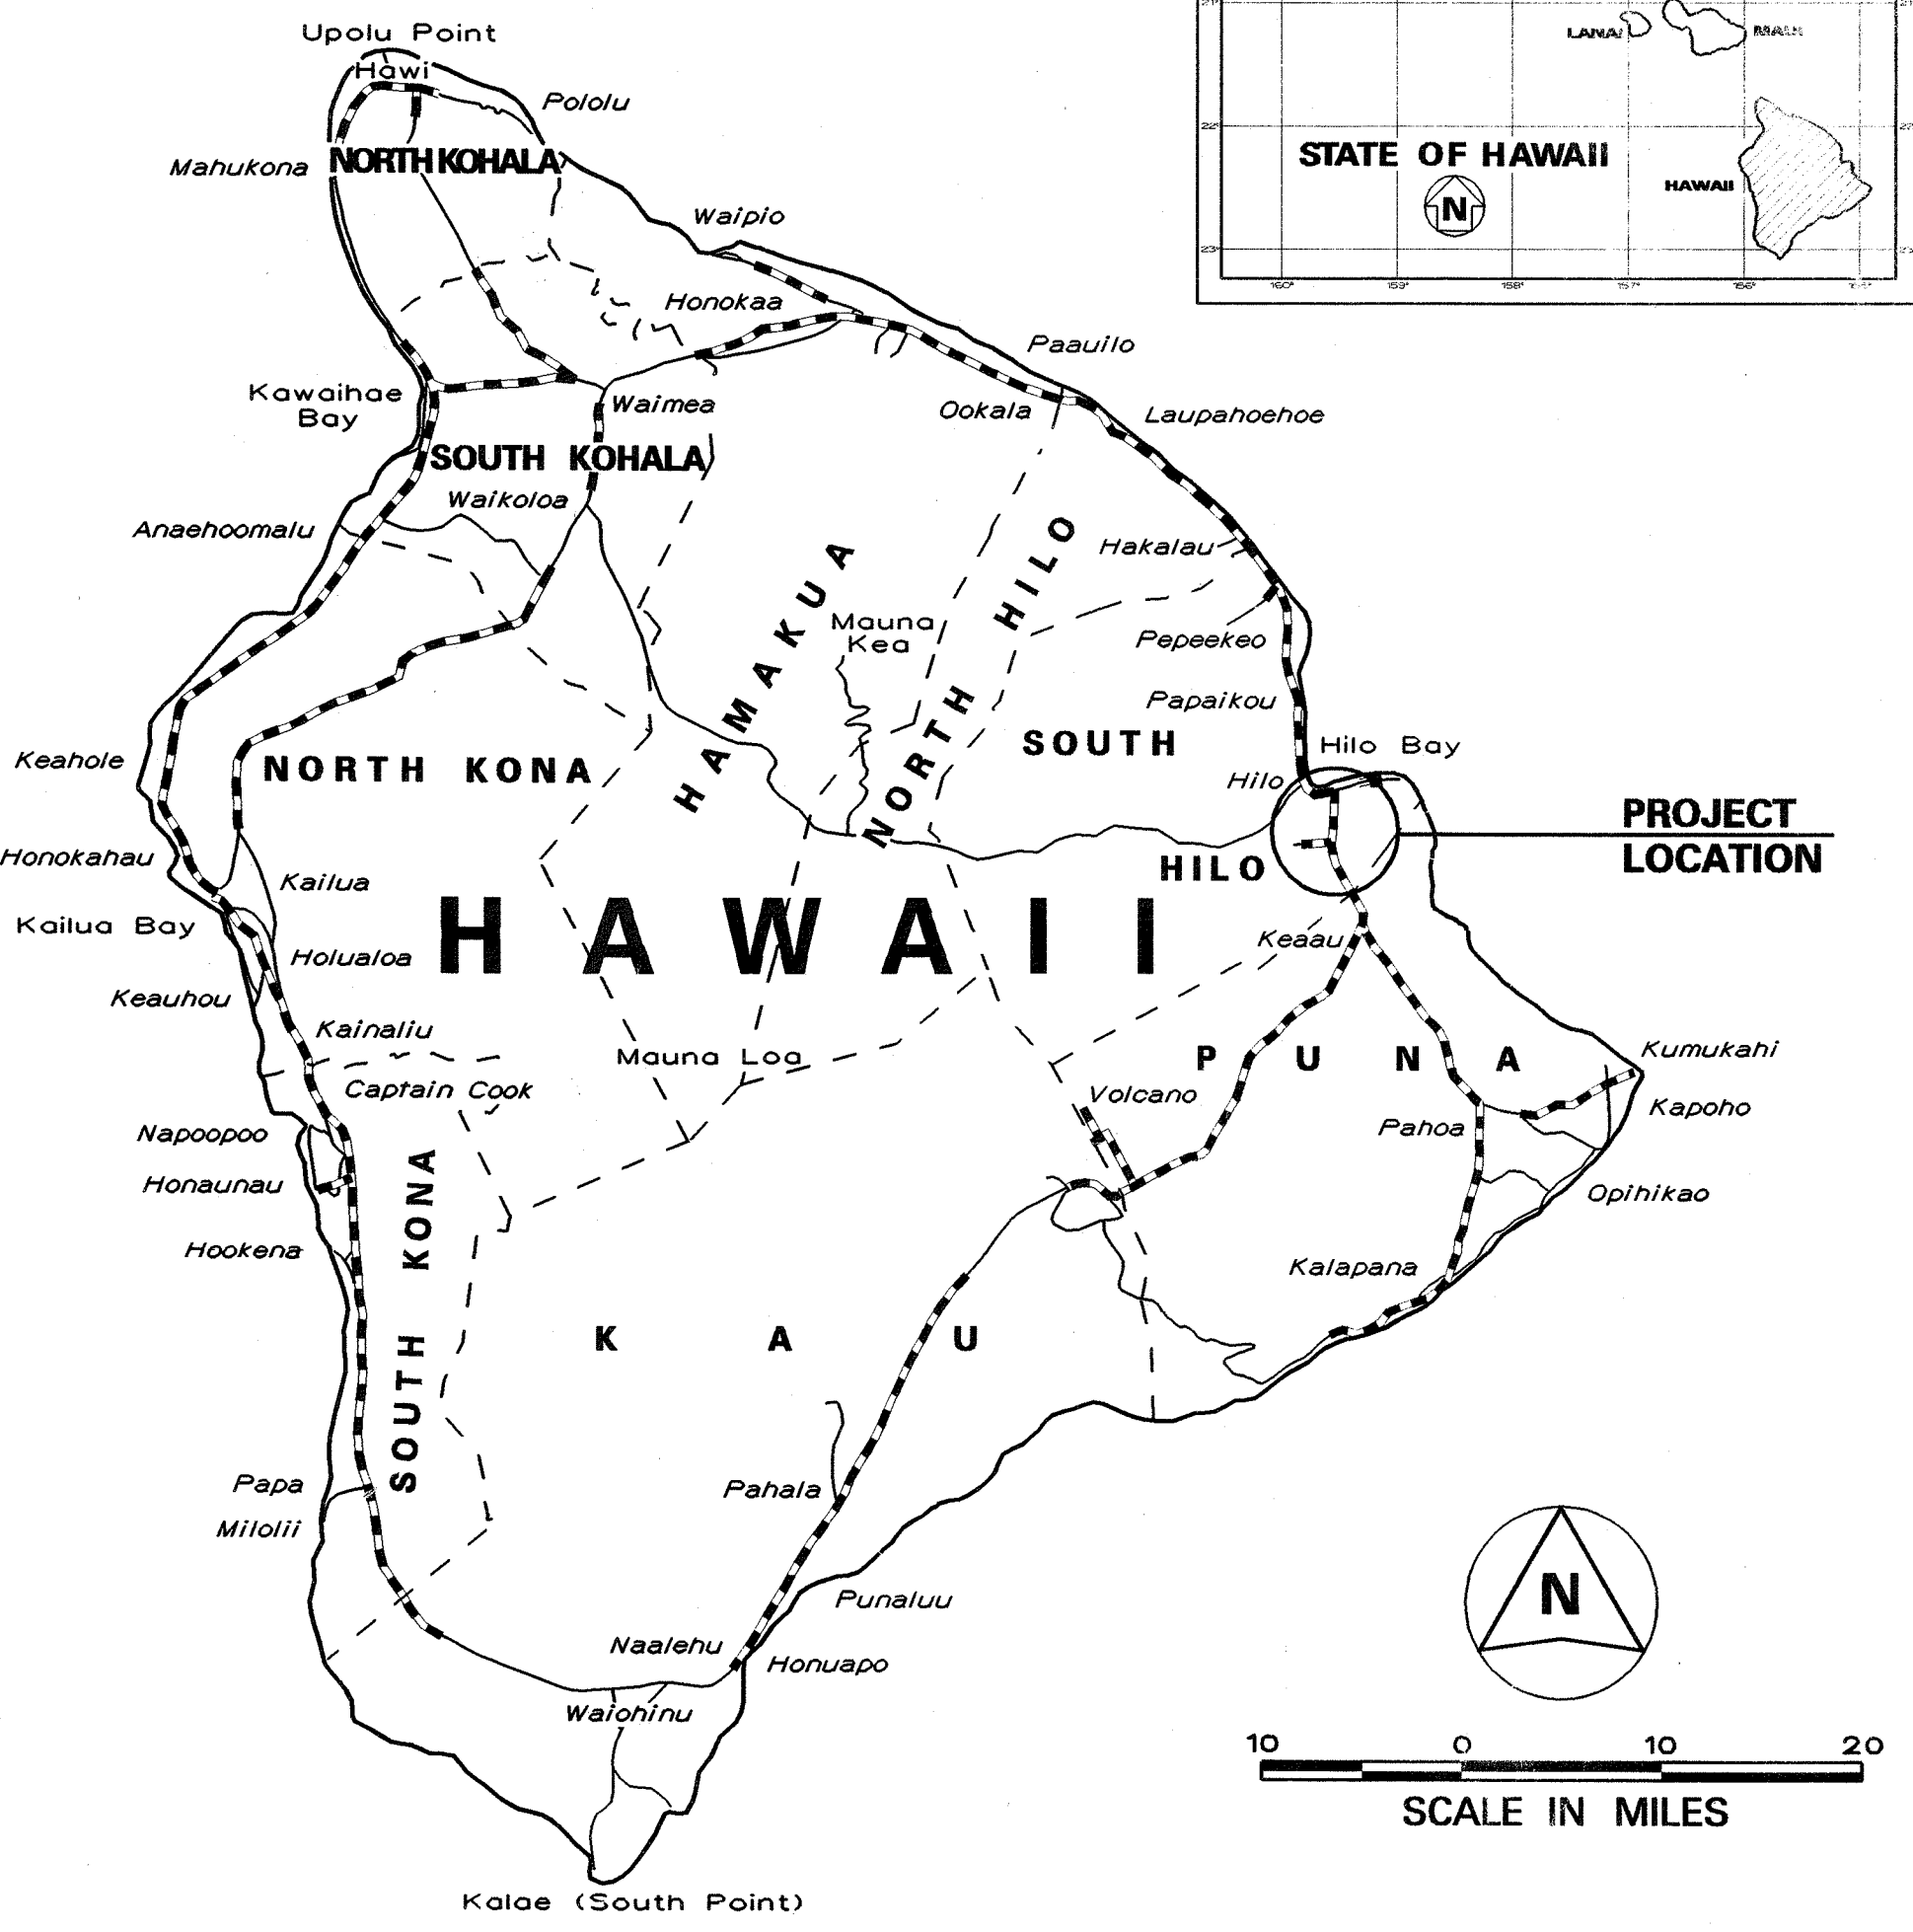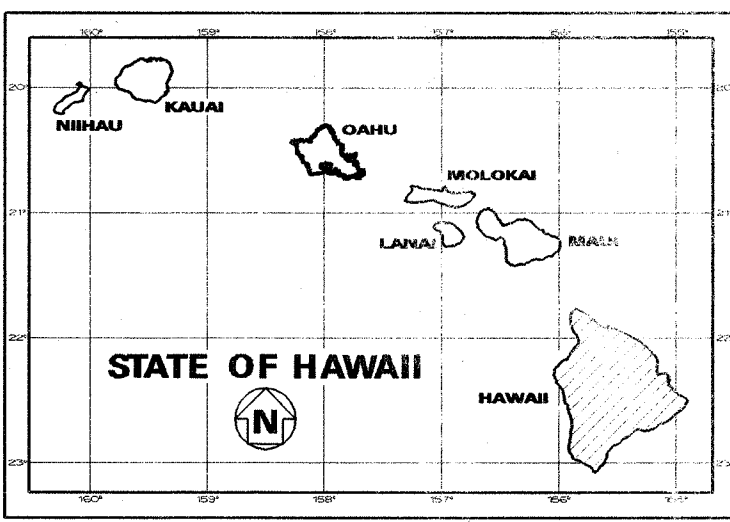


PROJECT SITE


TMK: (3) 2-2-50:75

50 Makaala Street

Hilo, Hawaii 96720

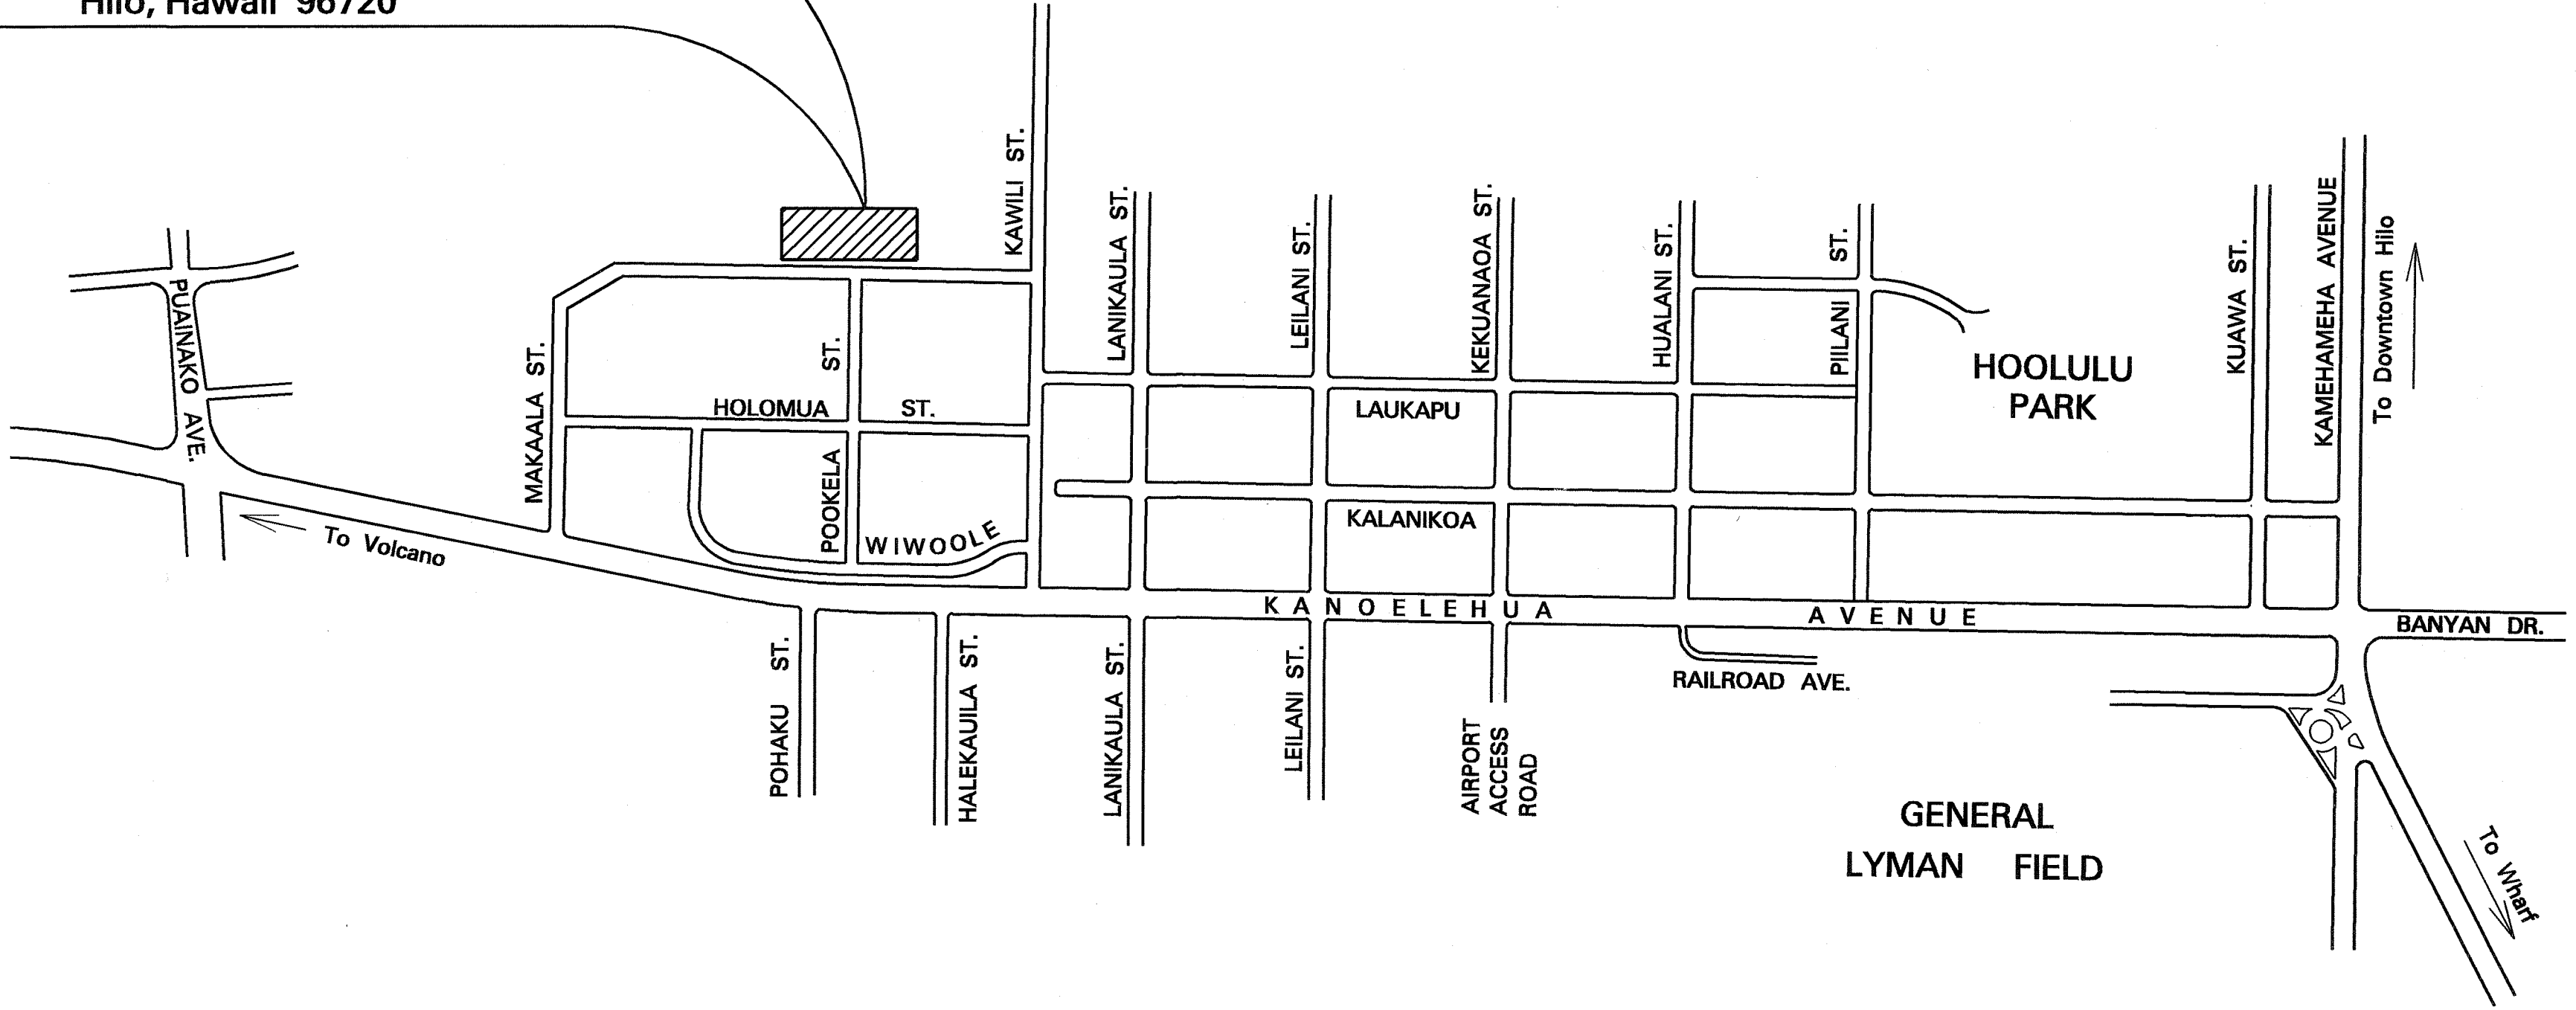

GENERAL LOCATION MAP

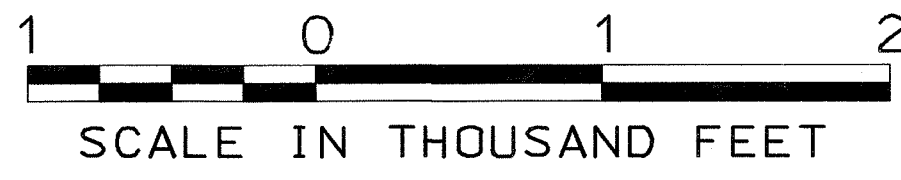

CHANGES MADE DURING CONSTRUCTION HAVE BEEN INCORPORATED ON THESE PLANS EXCEPT CHANGES IN THE ORIGINAL THEORETICAL QUANTITIES. FOR ACTUAL QUANTITIES, REFER TO PROJECT LEDGER AND/OR COMPUTATION BOOK.

Ronald P. Sheehan

6/30/10

DATE

DEPARTMENT OF TRANSPORTATION

STATE OF HAWAII

APPROVED:

g. Oscar m. jones

5-18-07

DIR. OF TRANSPORTATION

DATE

Hawaii District

DESIGNED BY

HWY-H-E

MANAGED BY

933-8866

PHONE

April, 2006

DATE