


FED. ROAD DIST. NO.	STATE	FED. AID PROJ. NO.	FISCAL YEAR	SHEET NO.	TOTAL SHEETS
HAWAII	HAW.	HWY-H-04-06M	2006	8	8




ORIGINAL PLAN	DATE
DATE	10/10/06
DRAWN BY	J. J.
DESIGNED BY	J. J.
CHECKED BY	J. J.

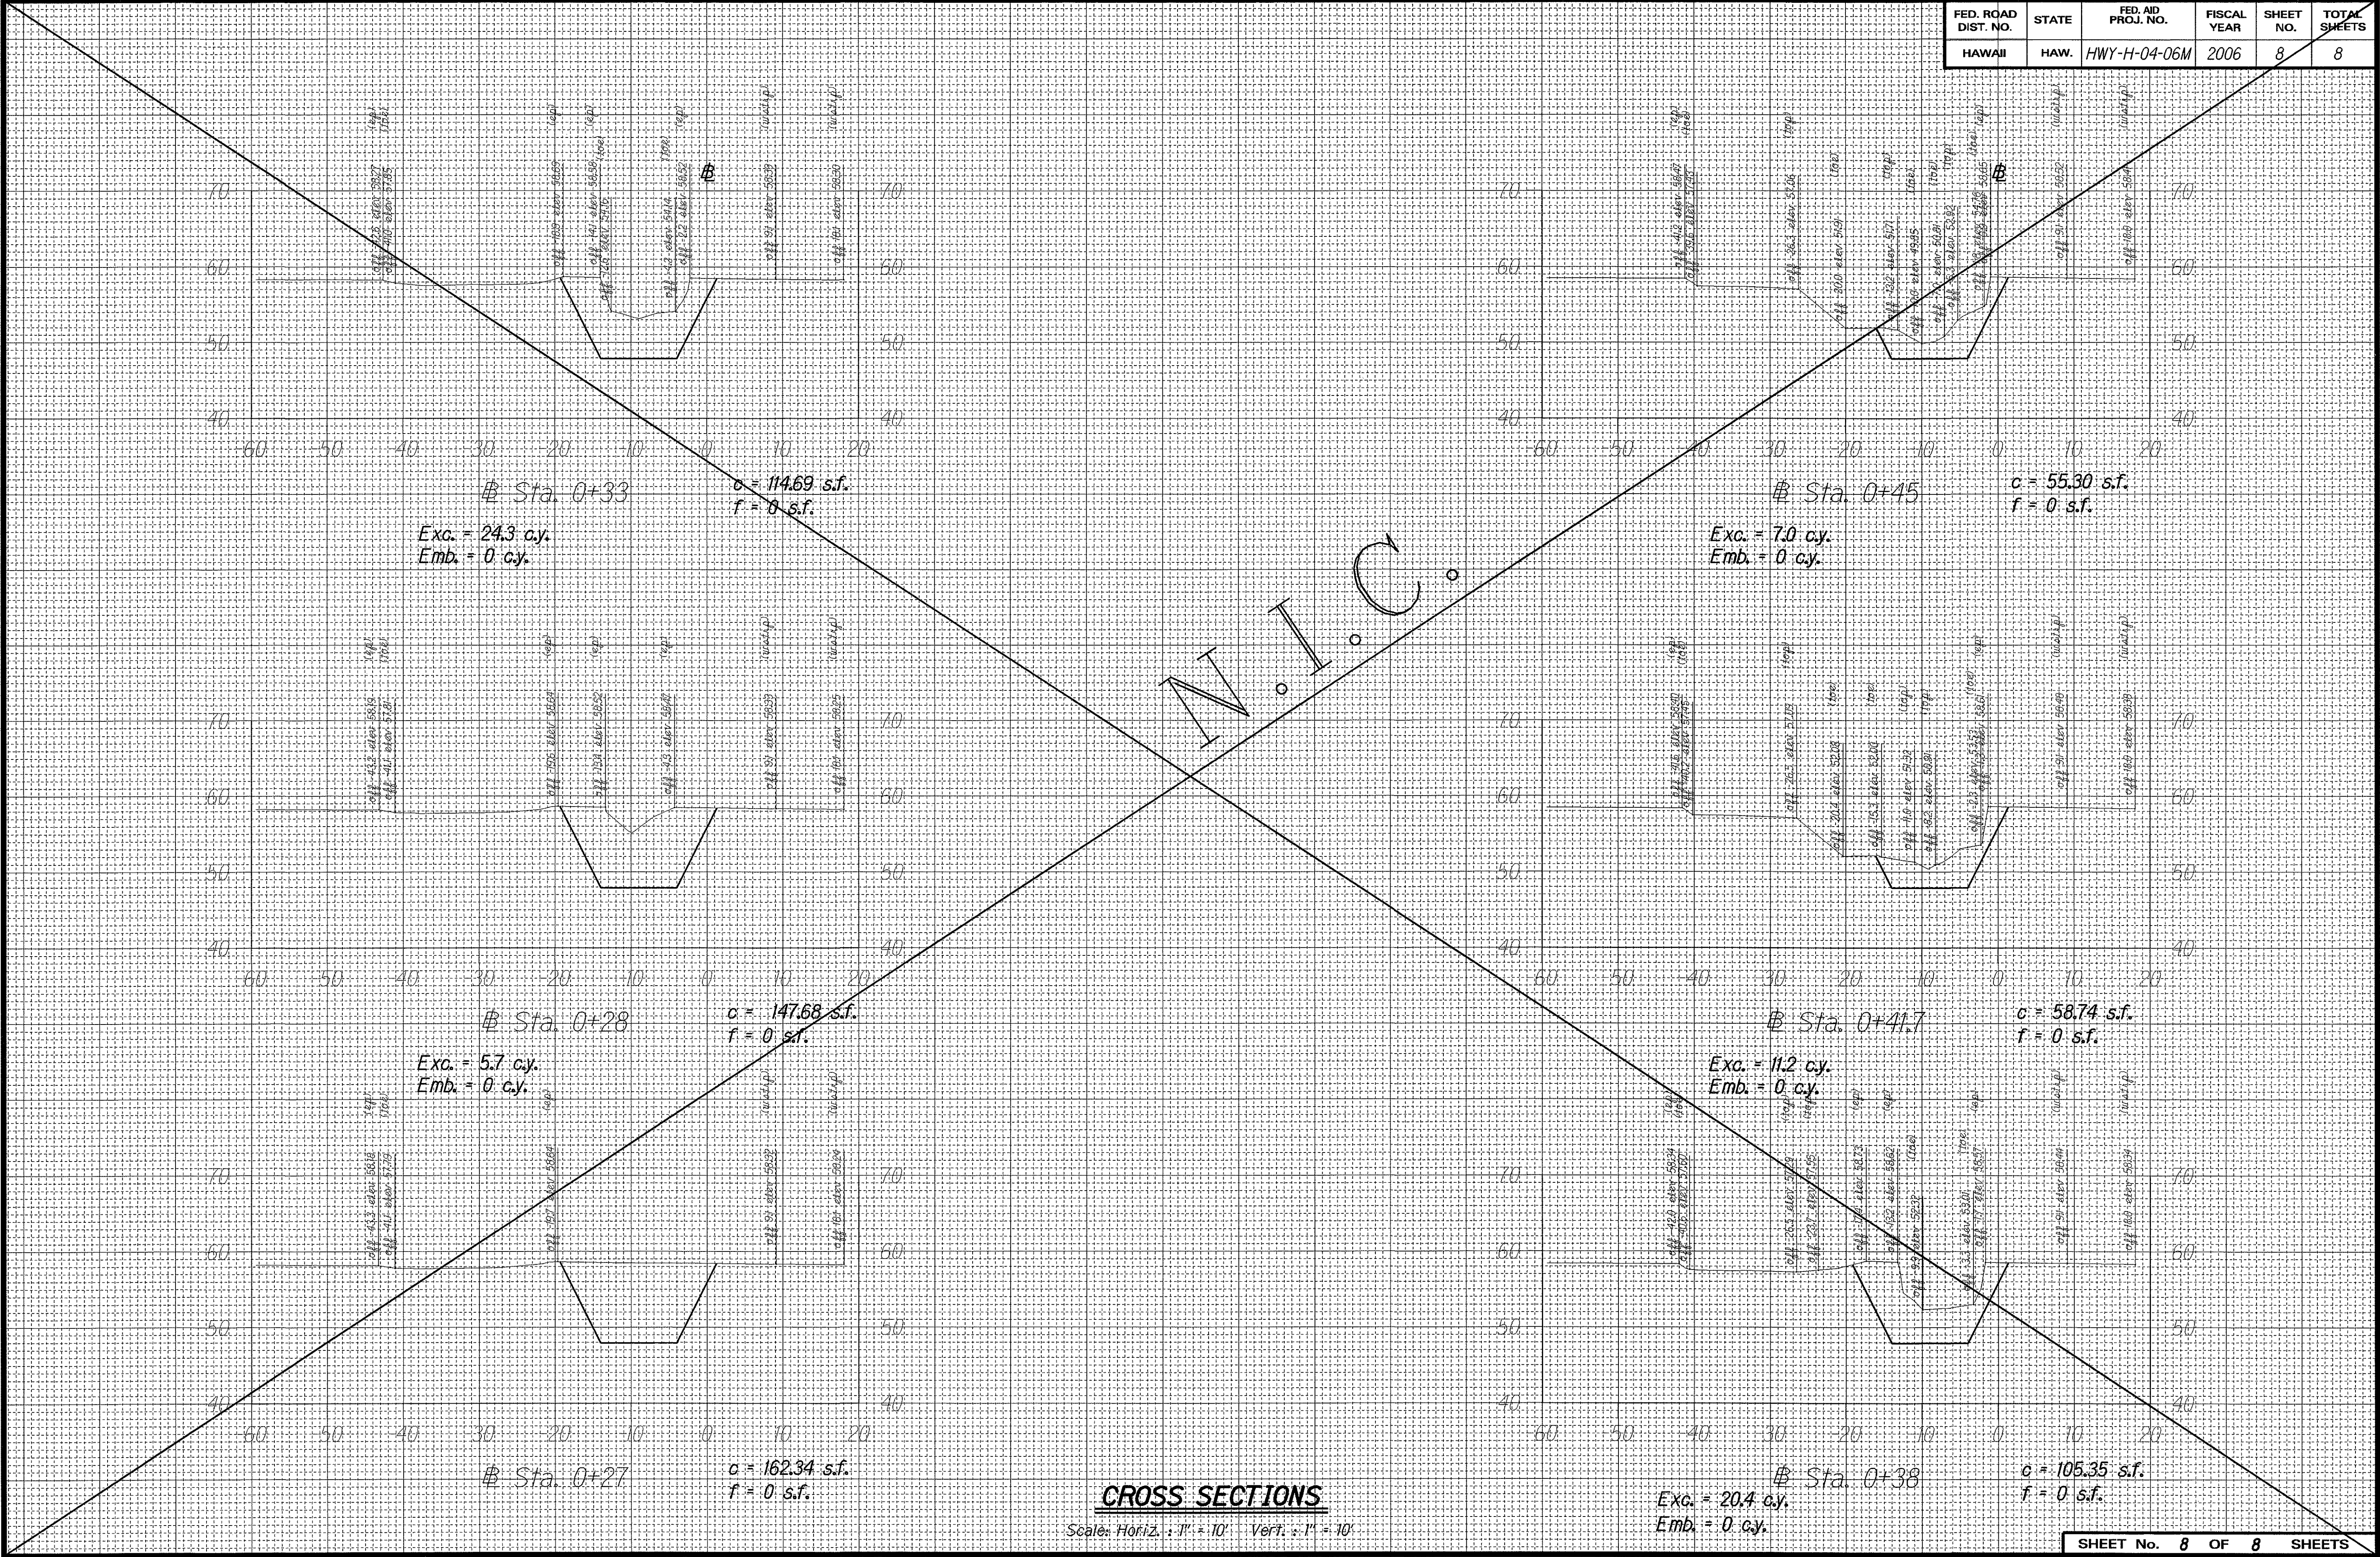

FED. ROAD DIST. NO.	STATE	FED. AID PROJ. NO.	FISCAL YEAR	SHEET NO.	TOTAL SHEETS
HAWAII	HAW.	HWY-H-04-06M	2006	C.C.O. 9	10


Note: This tracing prepared during "As-Built" posting.

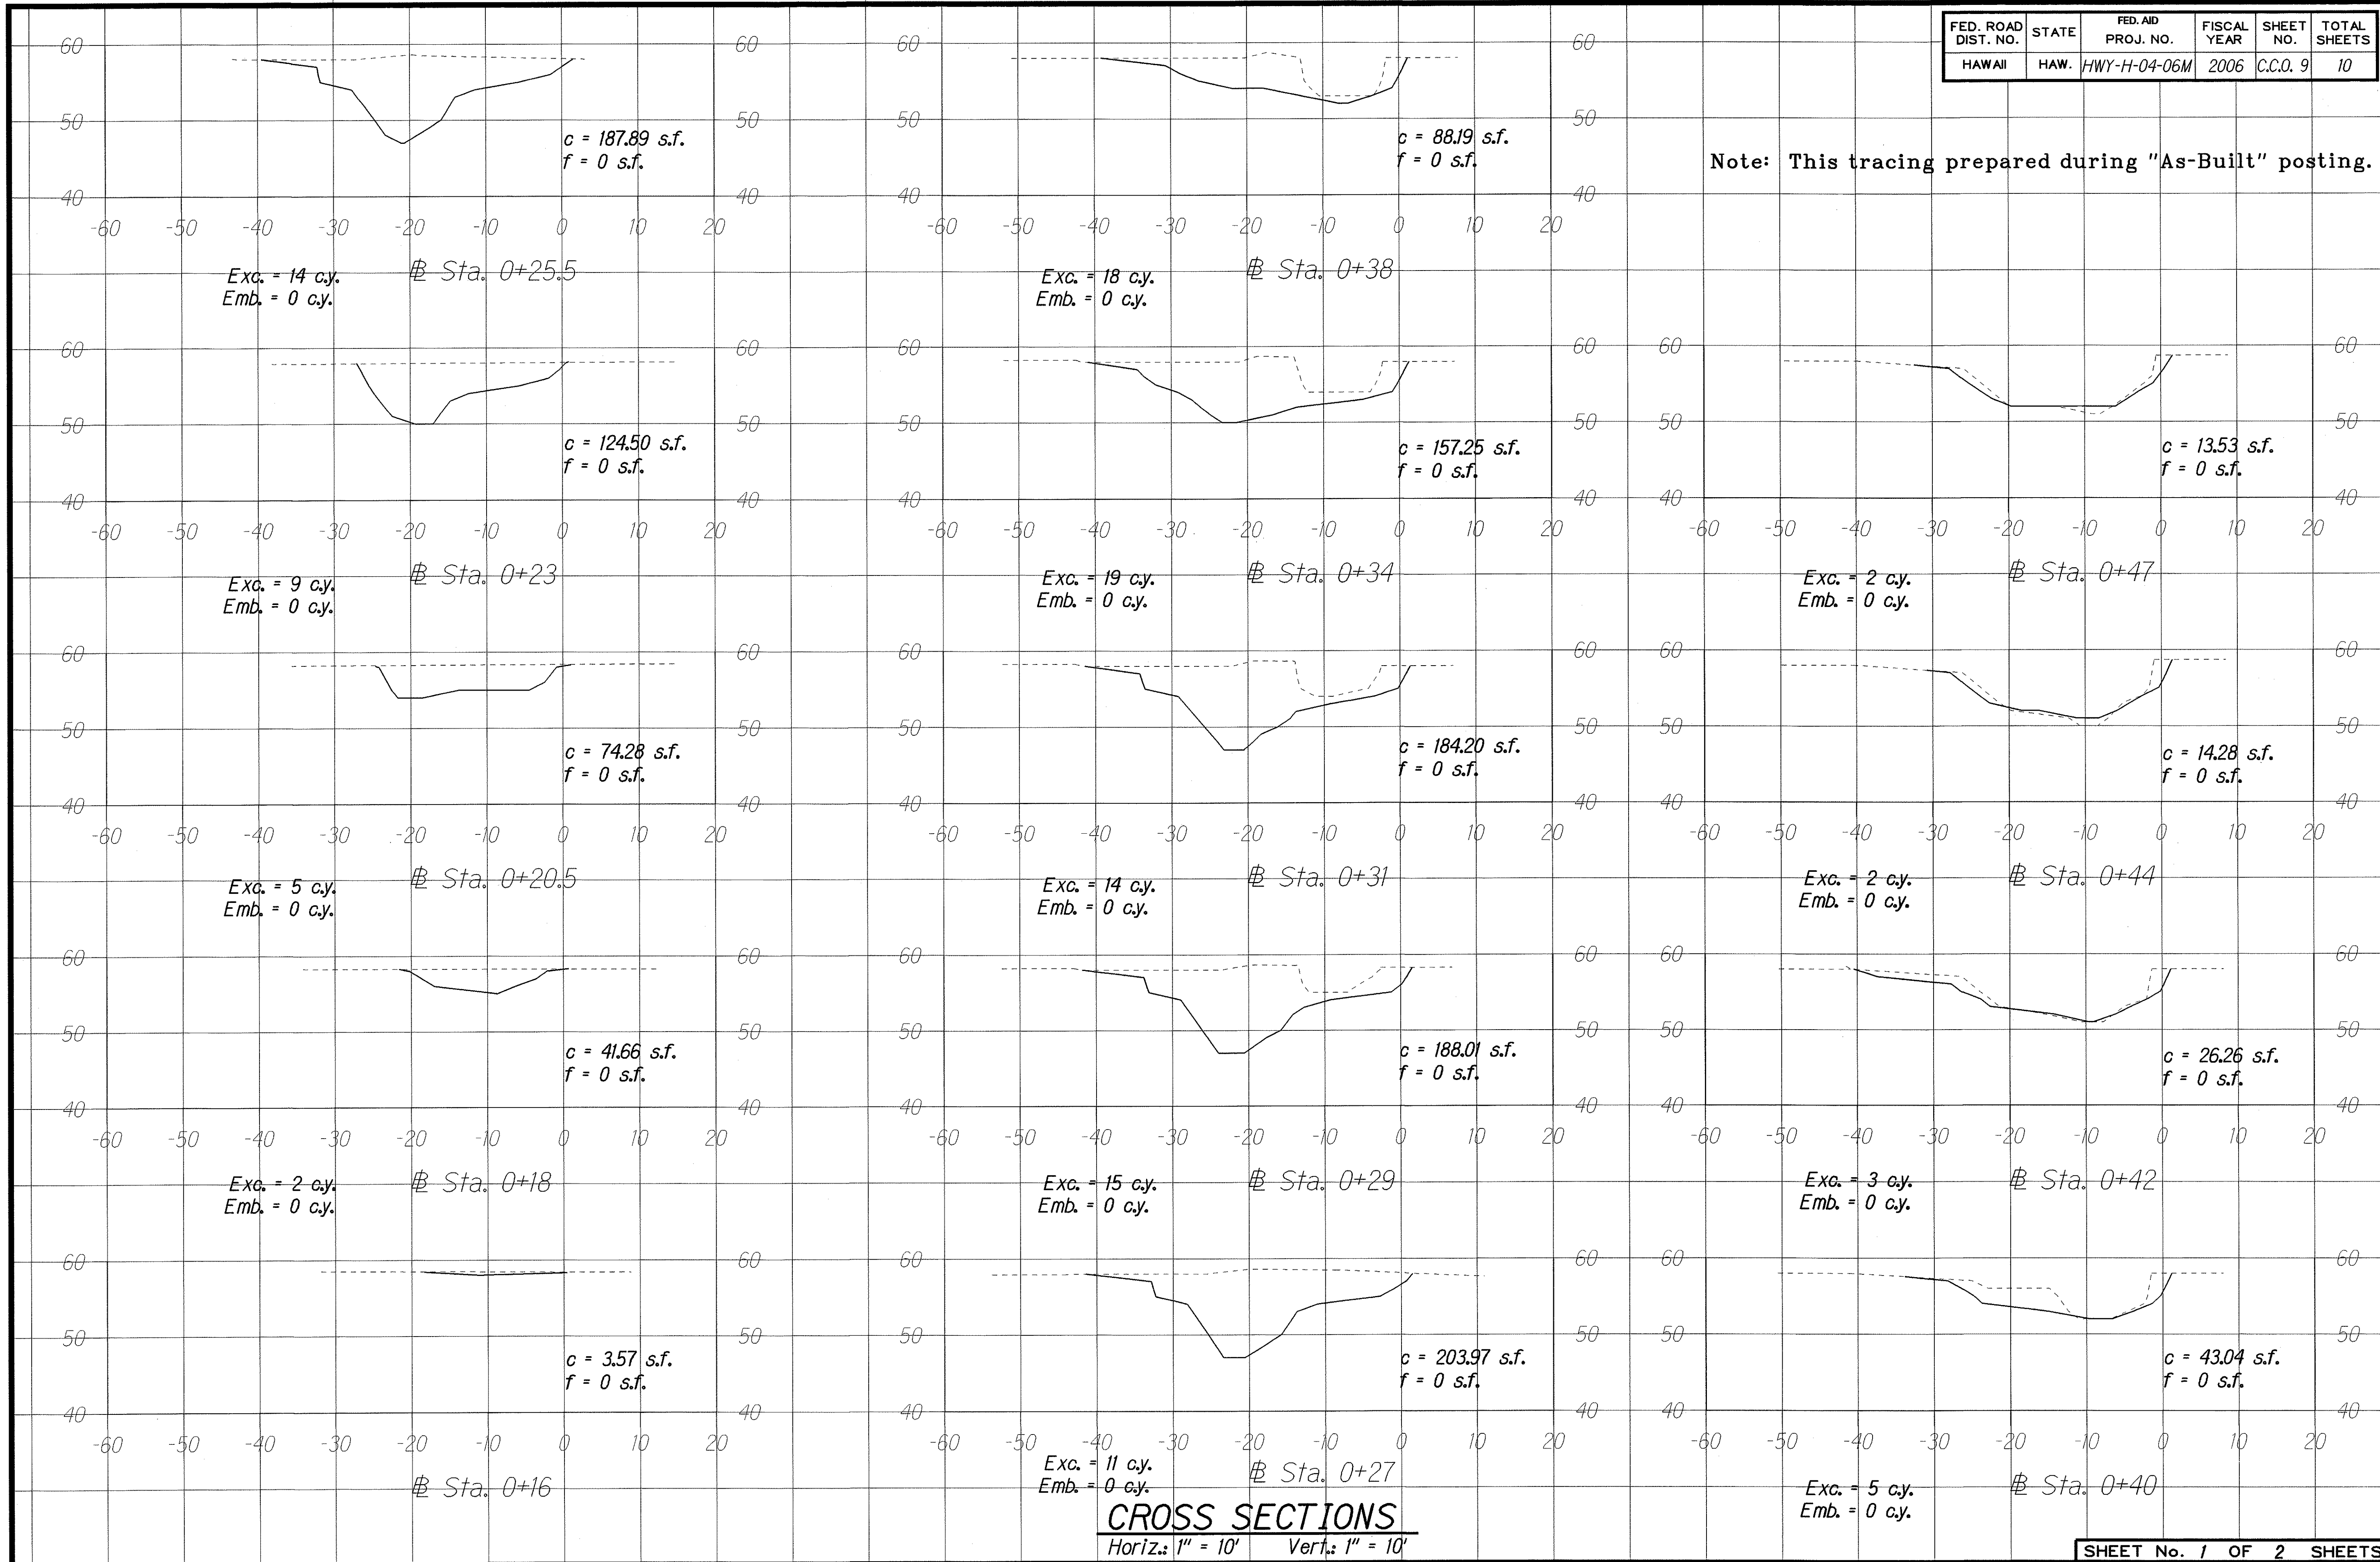

SURVEY PLOTTED BY	DATE
DRAWN BY	
DESIGNED BY	
QUANTITIES BY	
CHECKED BY	

CROSS SECTIONS  
 Horiz.: 1" = 10'  
 Vert.: 1" = 10'

FED. ROAD DIST. NO.	STATE	FED. AID PROJ. NO.	FISCAL YEAR	SHEET NO.	TOTAL SHEETS
HAWAII	HAW.	HWY-H-04-06M	2006	C.C.O. 10	10

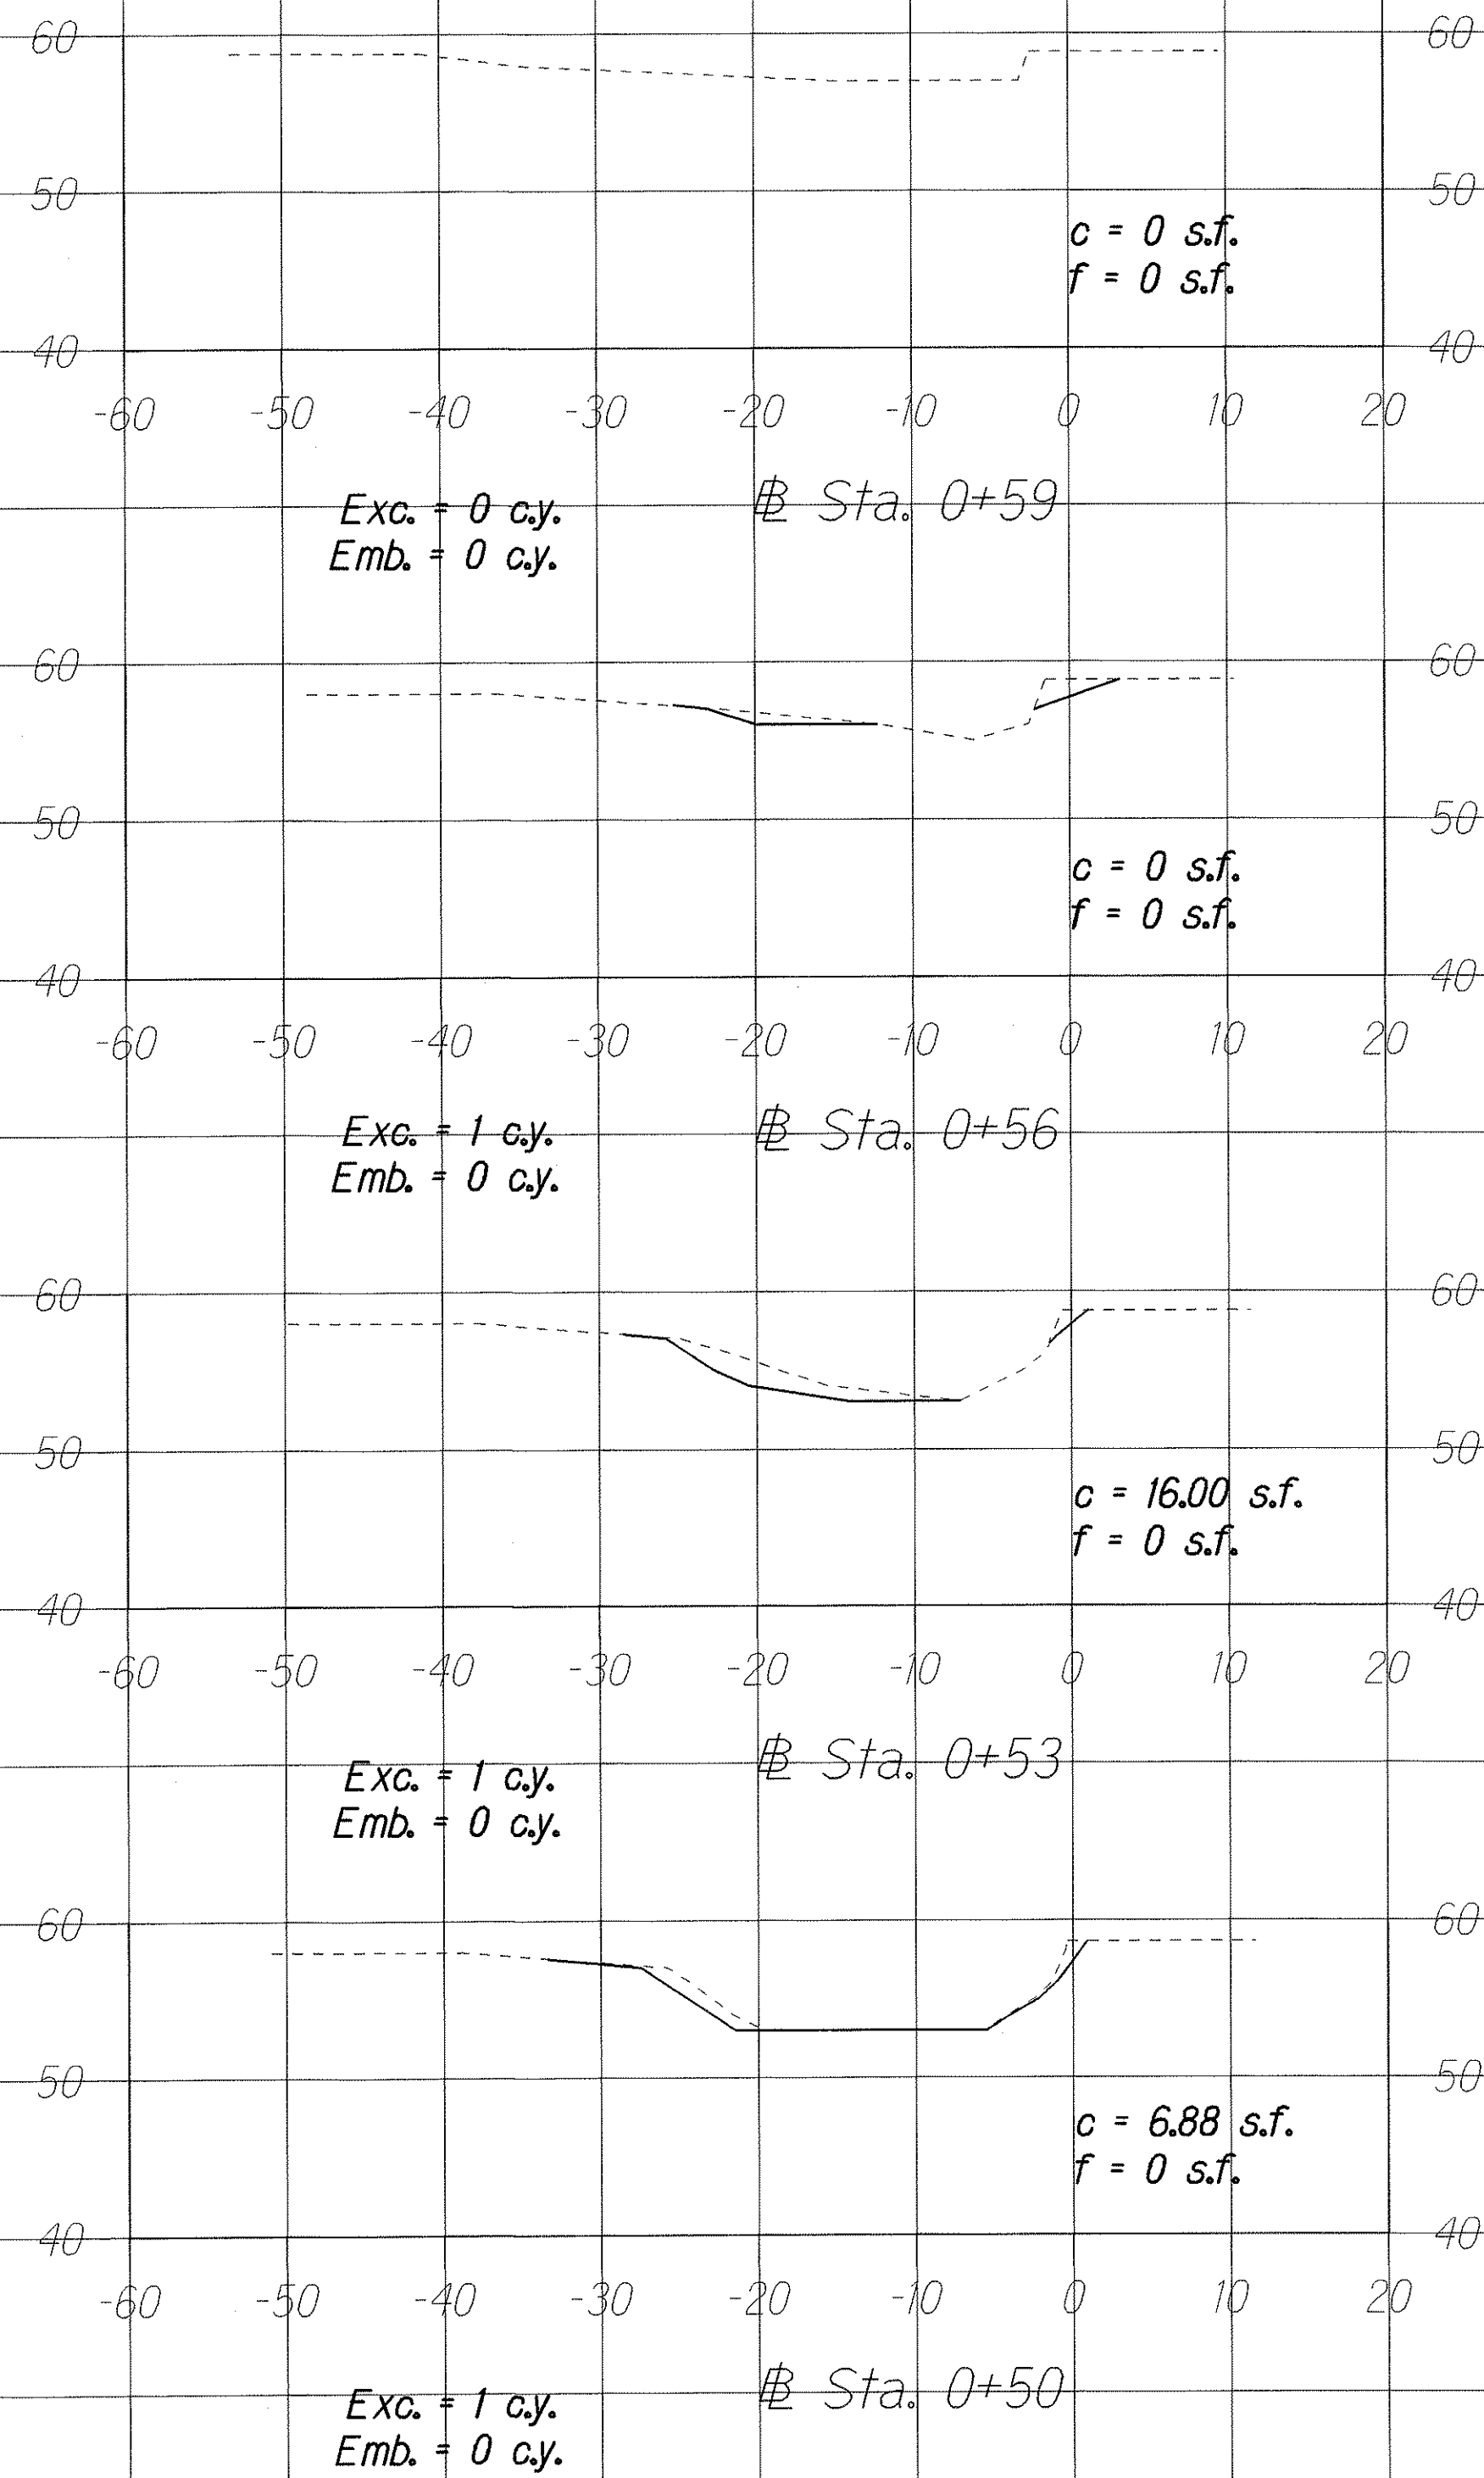

TOTAL ECCAVATION:  
111.00 cu. yds.

CROSS SECTIONS  
Horiz.: 1" = 10'    Vert.: 1" = 10'

Note: This tracing prepared during "As-Built" posting.