


STATE	PROJ. NO.	FISCAL YEAR	SHEET NO.	TOTAL SHEETS
HAW.	HWY-H-04-06M	2006	7	8

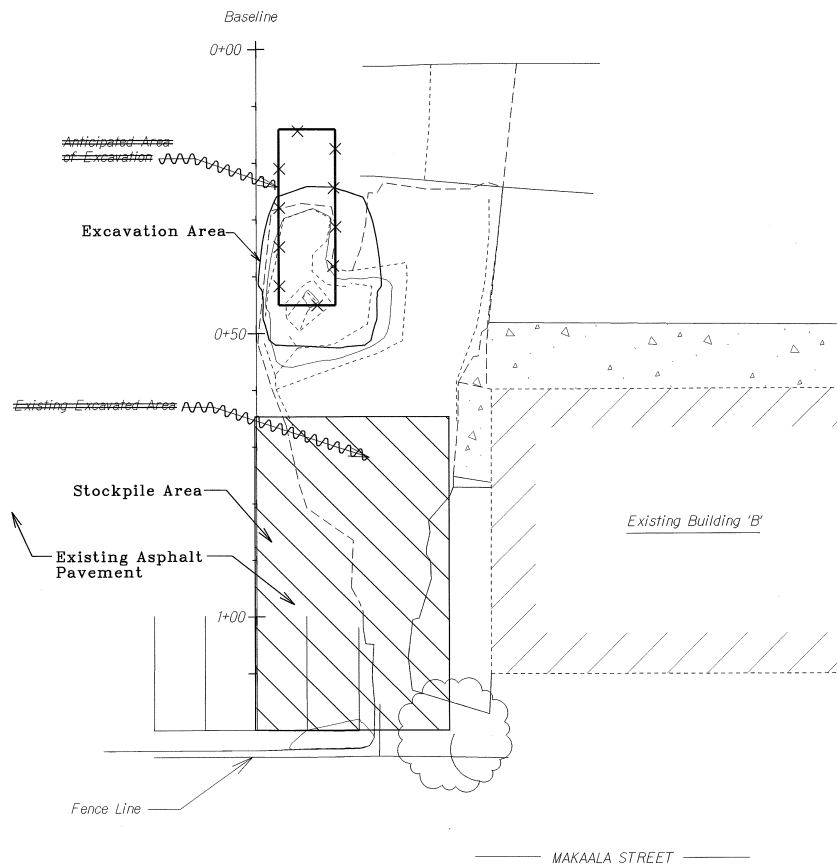

EXCAVATION PLAN
Scale: 1" = 10'

LEGEND FOR AS-BUILT POSTINGS	
	Squiggly line for as-built deletion
	Double line for as-built deletion
Roadway	Text for as-built posting

STATE OF HAWAII DEPARTMENT OF TRANSPORTATION HIGHWAYS DIVISION	
EXCAVATION PLAN	
HILO BASEYARD REMOVE CONTAMINATED SOILS VICINITY OF BUILDING 'B' PROJECT NO. HWY-H-04-06M	
Scale: Noted	Date: April, 2006
SHEET No. 1 OF 1 SHEETS	

"AS-BUILT" 7