


STATE	PROJ. NO.	FISCAL YEAR	SHEET NO.	TOTAL SHEETS
HAW.	HWY-H-04-06M	2006	6	8

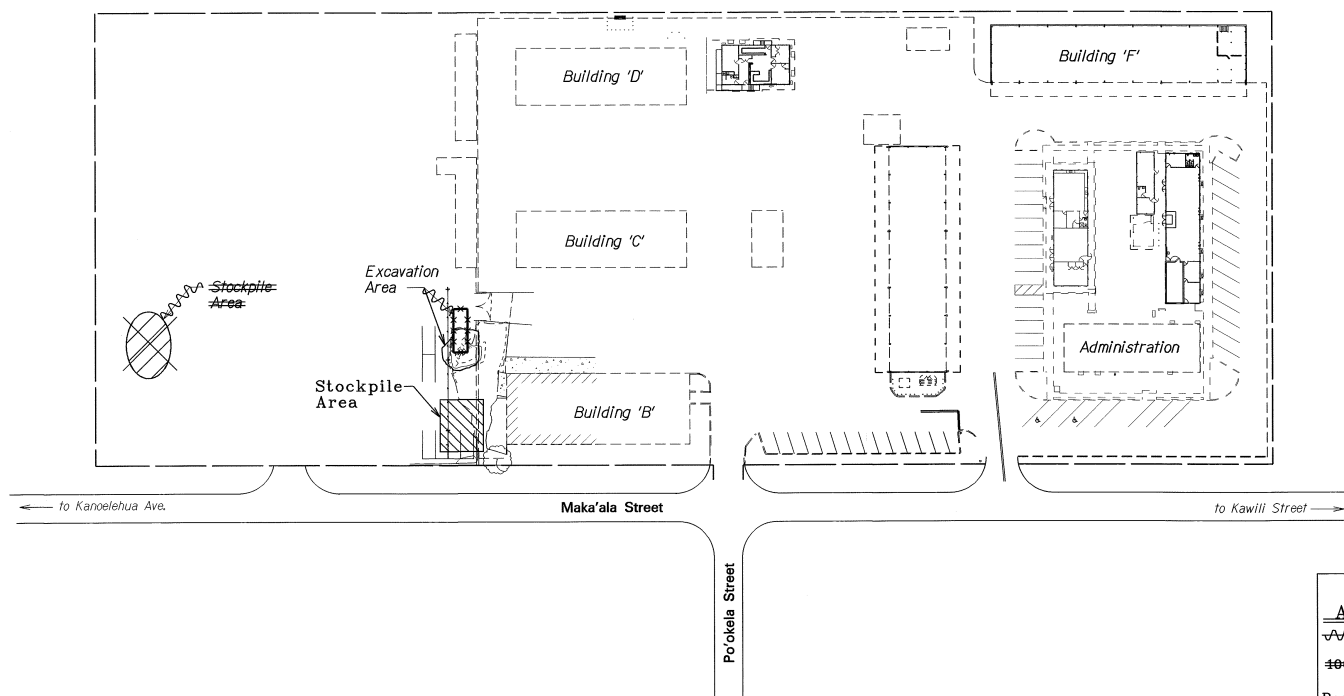

SITE PLAN
Scale: 1" = 40'

LEGEND FOR AS-BUILT POSTINGS	
	Squiggly line for as-built deletion
	Double line for as-built deletion
Roadway	Text for as-built posting

STATE OF HAWAII
DEPARTMENT OF TRANSPORTATION
HIGHWAYS DIVISION

SITE PLAN

HILO BASEYARD
REMOVE CONTAMINATED SOILS
VICINITY OF BUILDING 'B'
PROJECT NO. HWY-H-04-06M

Scale: Noted Date: April, 2006

SHEET No. 1 OF 1 SHEETS