
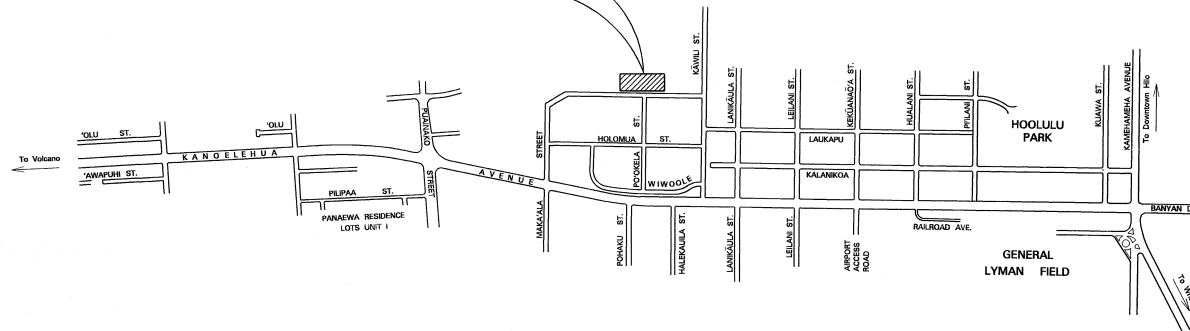


SHEET NOS. ① C.C.O. 9 + C.C.O. 10 ARE SUPPLEMENTAL TO THIS PROJECT. TOTAL SHEET COUNT AFTER "AS-BUILT" POSTING IS 10 SHEETS.

PROJECT SITE

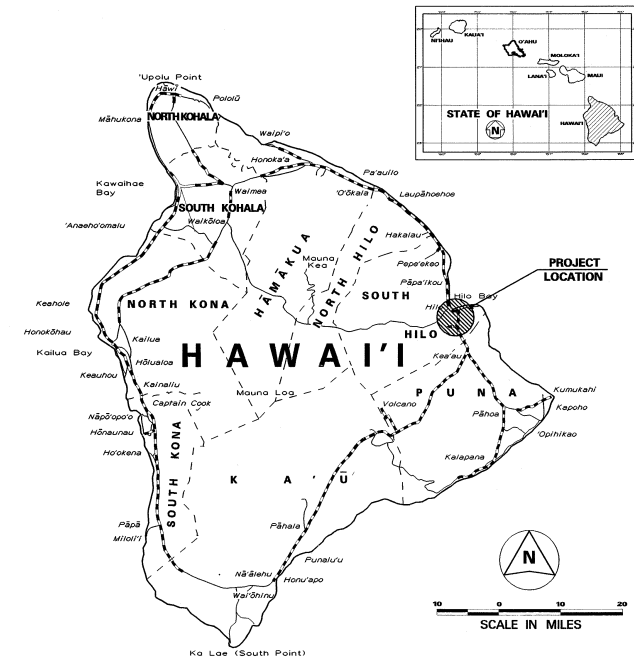

1 0 1 2
SCALE IN THOUSAND FEET

 FEDERAL AID PROJECTS PREVIOUSLY CONSTRUCTED
OR UNDER CONSTRUCTION

CHANGES MADE DURING CONSTRUCTION HAVE BEEN INCORPORATED ON THESE PLANS EXCEPT CHANGES IN THE ORIGINAL THEORETICAL QUANTITIES. FOR ACTUAL QUANTITIES, REFER TO PROJECT LEDGER AND/OR COMPUTATION BOOK.

[Signature] 3-6-07
 DESIGNER OR ENGINEER DATE

DEPARTMENT OF TRANSPORTATION STATE OF HAWAII	
APPROVED:	
<i>[Signature]</i> DIR. OF TRANSPORTATION	4-27-06 DATE

HAWAII DISTRICT DESIGNED BY	HWY-H MANAGED BY	933-8866 PHONE	APRIL, 2006 DATE
--------------------------------	---------------------	-------------------	---------------------