



FED. ROAD DIST. NO.	STATE	PROJ. NO.	FISCAL YEAR	SHEET NO.	TOTAL SHEETS
HAWAII	HAW.	HWY-H-04-92M	1992	2	2

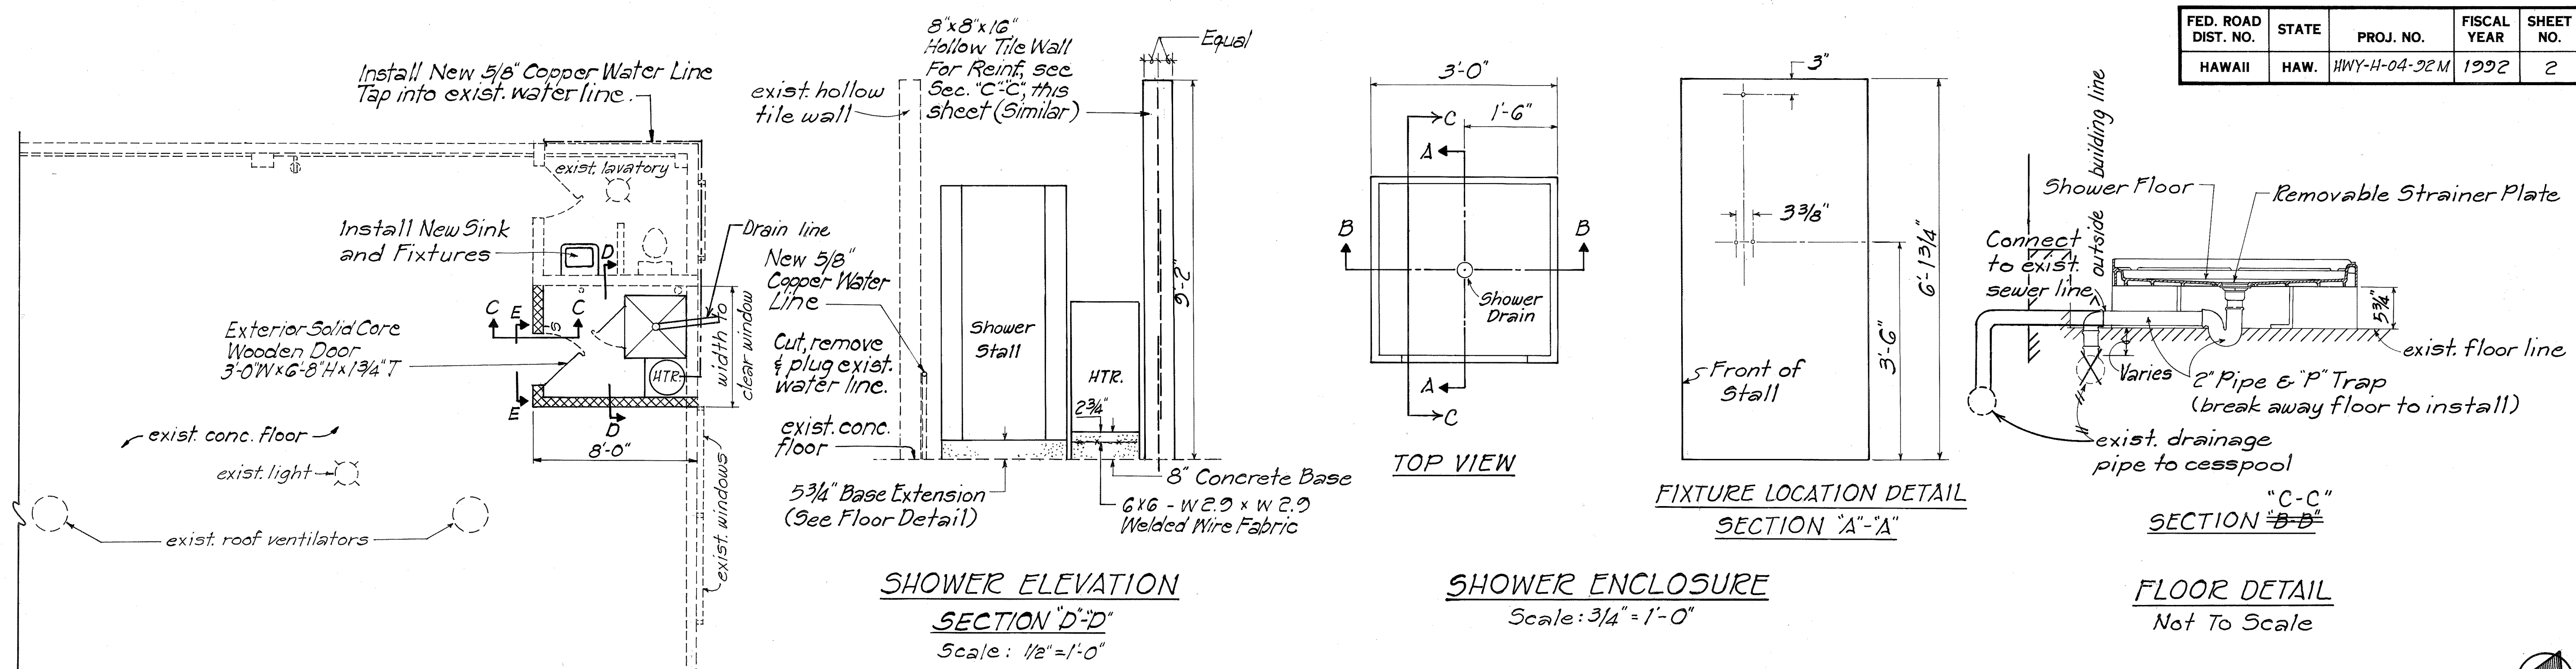

GENERAL NOTES:

- Contractor to Install complete and tested Shower Facility as per Specifications. Facility includes stand alone shower stall, hotwater heater with pedestal, lavatory sink, facility wall, door with frame and privacy lock, light and light switch, floor preparation and all applicable plumbing, fixtures and electrical hook-ups.
- Shower stall to be Fiat Deluxe Mariner with Neptune door and extendable base, or approved equivalent.
- Hotwater heater to be Morflo/American model EFR-90-300 30 gallon, or approved equivalent.
- All electrical and plumbing work shall comply with all applicable State and County Codes.
- Masonry Units shall be 8"x8"x16" Concrete Hollow Block, Grade-N-I Specified Compressive Strength shall be 1500 PSI, no special inspection. Mortar shall be Type S and Reinforcing Bars shall be Grade 40. Only cells with reinforcing bars shall be grouted.
- Lavatory sink to be Kohler K-2030, 8" on center, wall hung lavatory basin in white. Faucet to be Kohler Triton series K-7435 with goose neck spout. Equivalent products may be substituted with the approval of the Engineer.
- The Contractor is reminded of the requirements of Subsection 108.01-Subletting of Contract, to perform with its own organization, work amounting to not less than 50 percent of the total contract cost less deductible amounts allowed. Non compliance with this Subsection shall be grounds for rejection of bid.

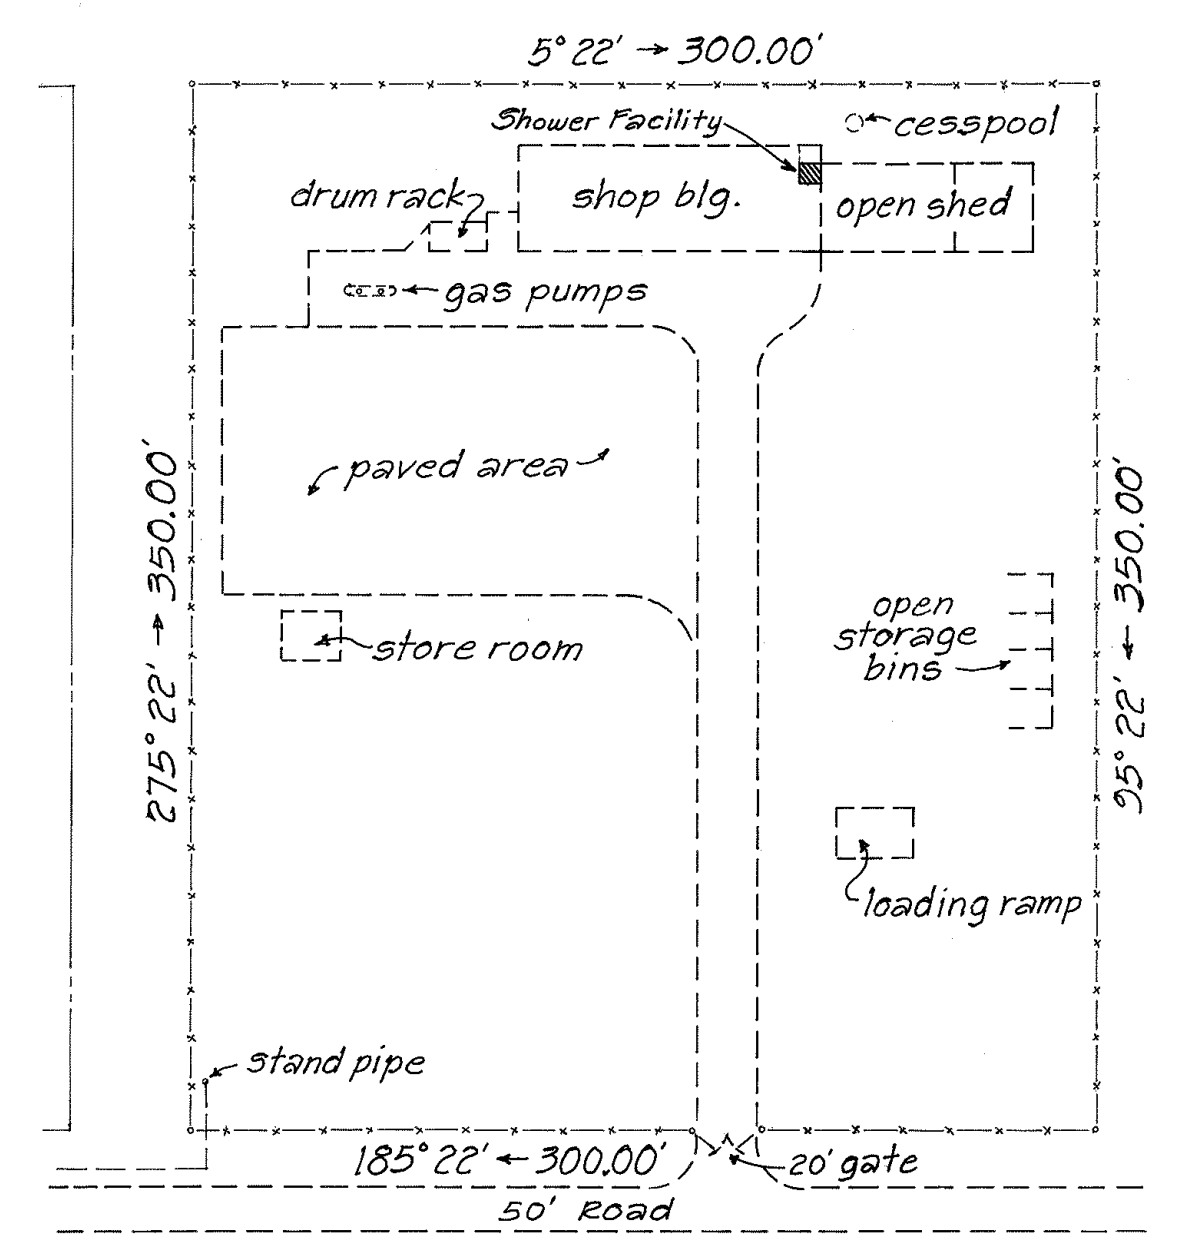

SITE PLAN
TMK 6-6-01:40
Not To Scale

STATE OF HAWAII
DEPARTMENT OF TRANSPORTATION
HIGHWAYS DIVISION

WAIMEA BASEYARD
SHOWER FACILITIES
PROJ. No. HWY-H-04-92M
SOUTH KOHALA, HAWAII
Scale: As Noted Date: Mar. 1992
SHEET No. 1 OF 1 SHEETS

DATE	
SURVEY PLOTTED BY	
ORIGINAL PLAN	
DESIGNED BY	
NOTED BY	
CHECKED BY	
NO.	