office sold	
	INDEX TO DRAWINGS
SHEET NO.	DESCRIPTION
1	TITLE SHEET
2	SHOWER FACILITY DETAILS
	`

STATE OF HAWAII

DEPARTMENT OF TRANSPORTATION


HIGHWAYS DIVISION
HONOLULU, HAWAII


AS-BUILT

PLANS FOR

WAIMEA BASEYARD SHOWER FACILITIES PROJECT NO. HWY-H-04-92M

DISTRICT OF SOUTH KOHALA
ISLAND OF HAWAII

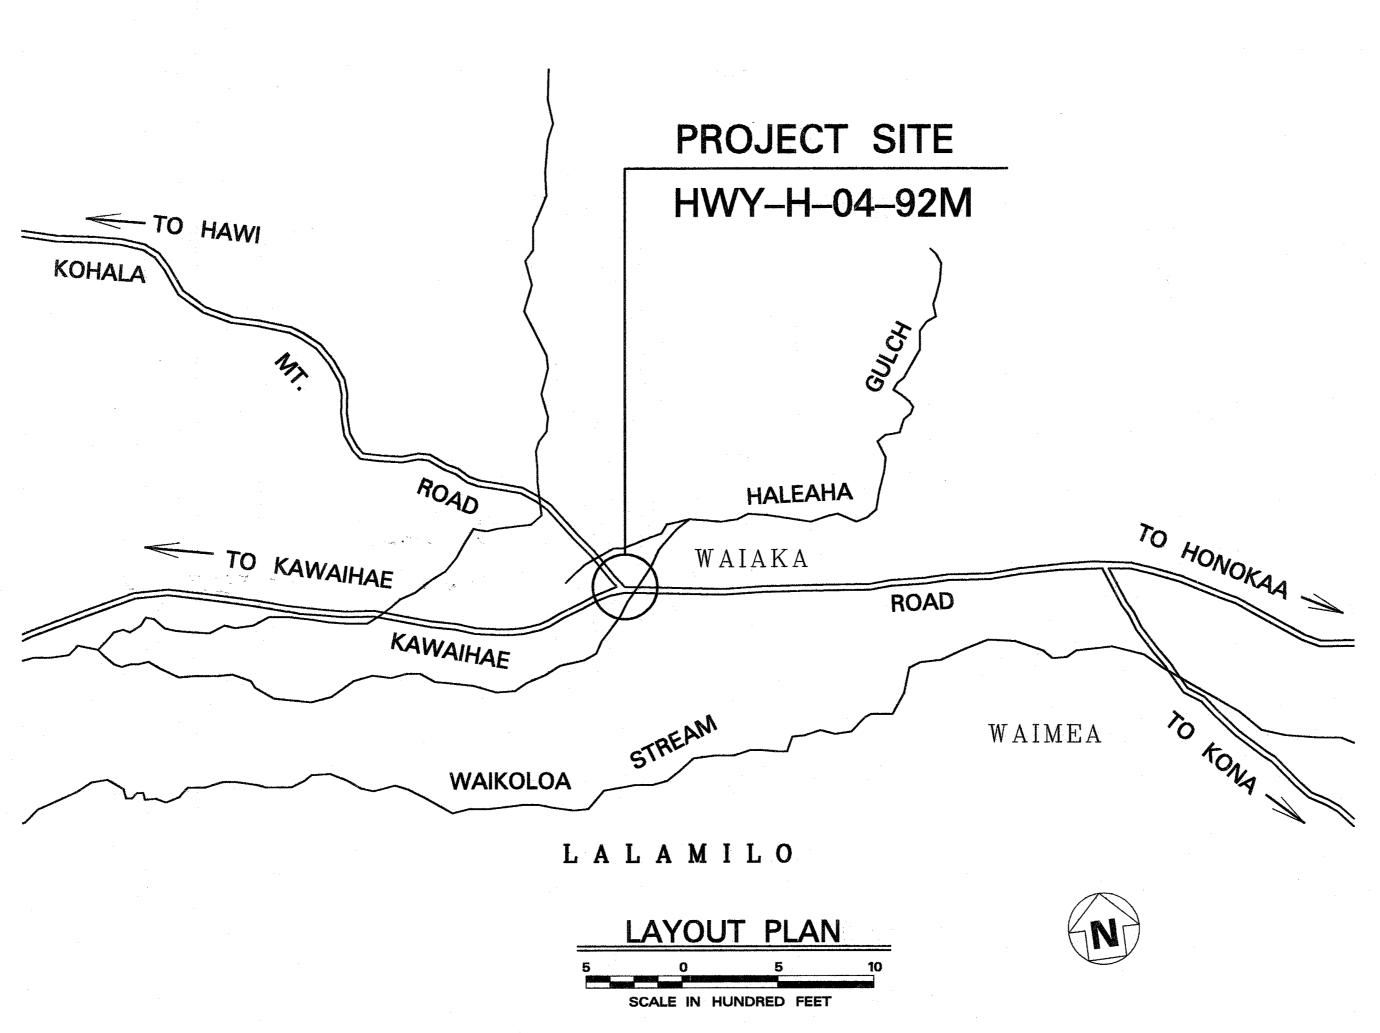

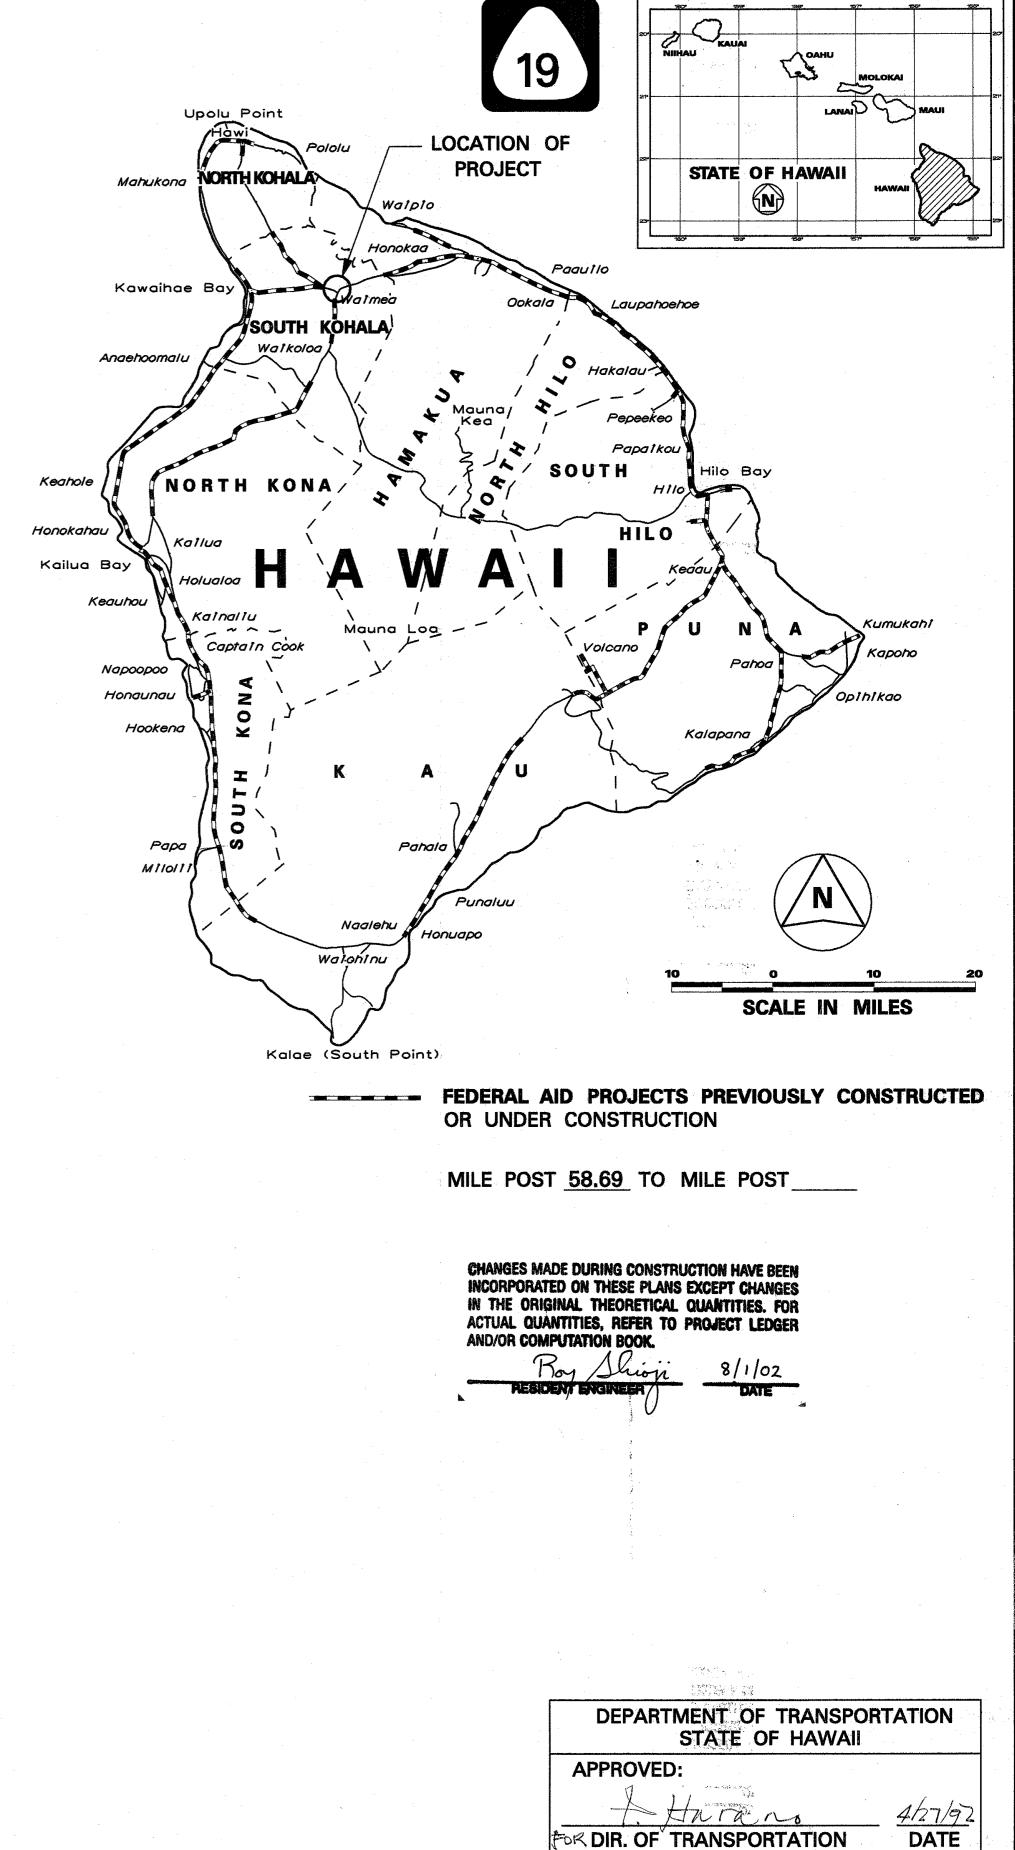

FISCAL YEAR

PROJ. NO.

HAW. HWY-H-04-92M

587–2246 APRIL, 19
PHONE DATE

JULIUS B. FRONDA 587-2246
P. S. & E. BY PHONE

HAWAII DISTRICT J