




FED. ROAD DIST. NO.	STATE	PROJ. NO.	FISCAL YEAR	SHEET NO.	TOTAL SHEET
HAWAII	HAW.	HWY H-02-92M	1992	2	11

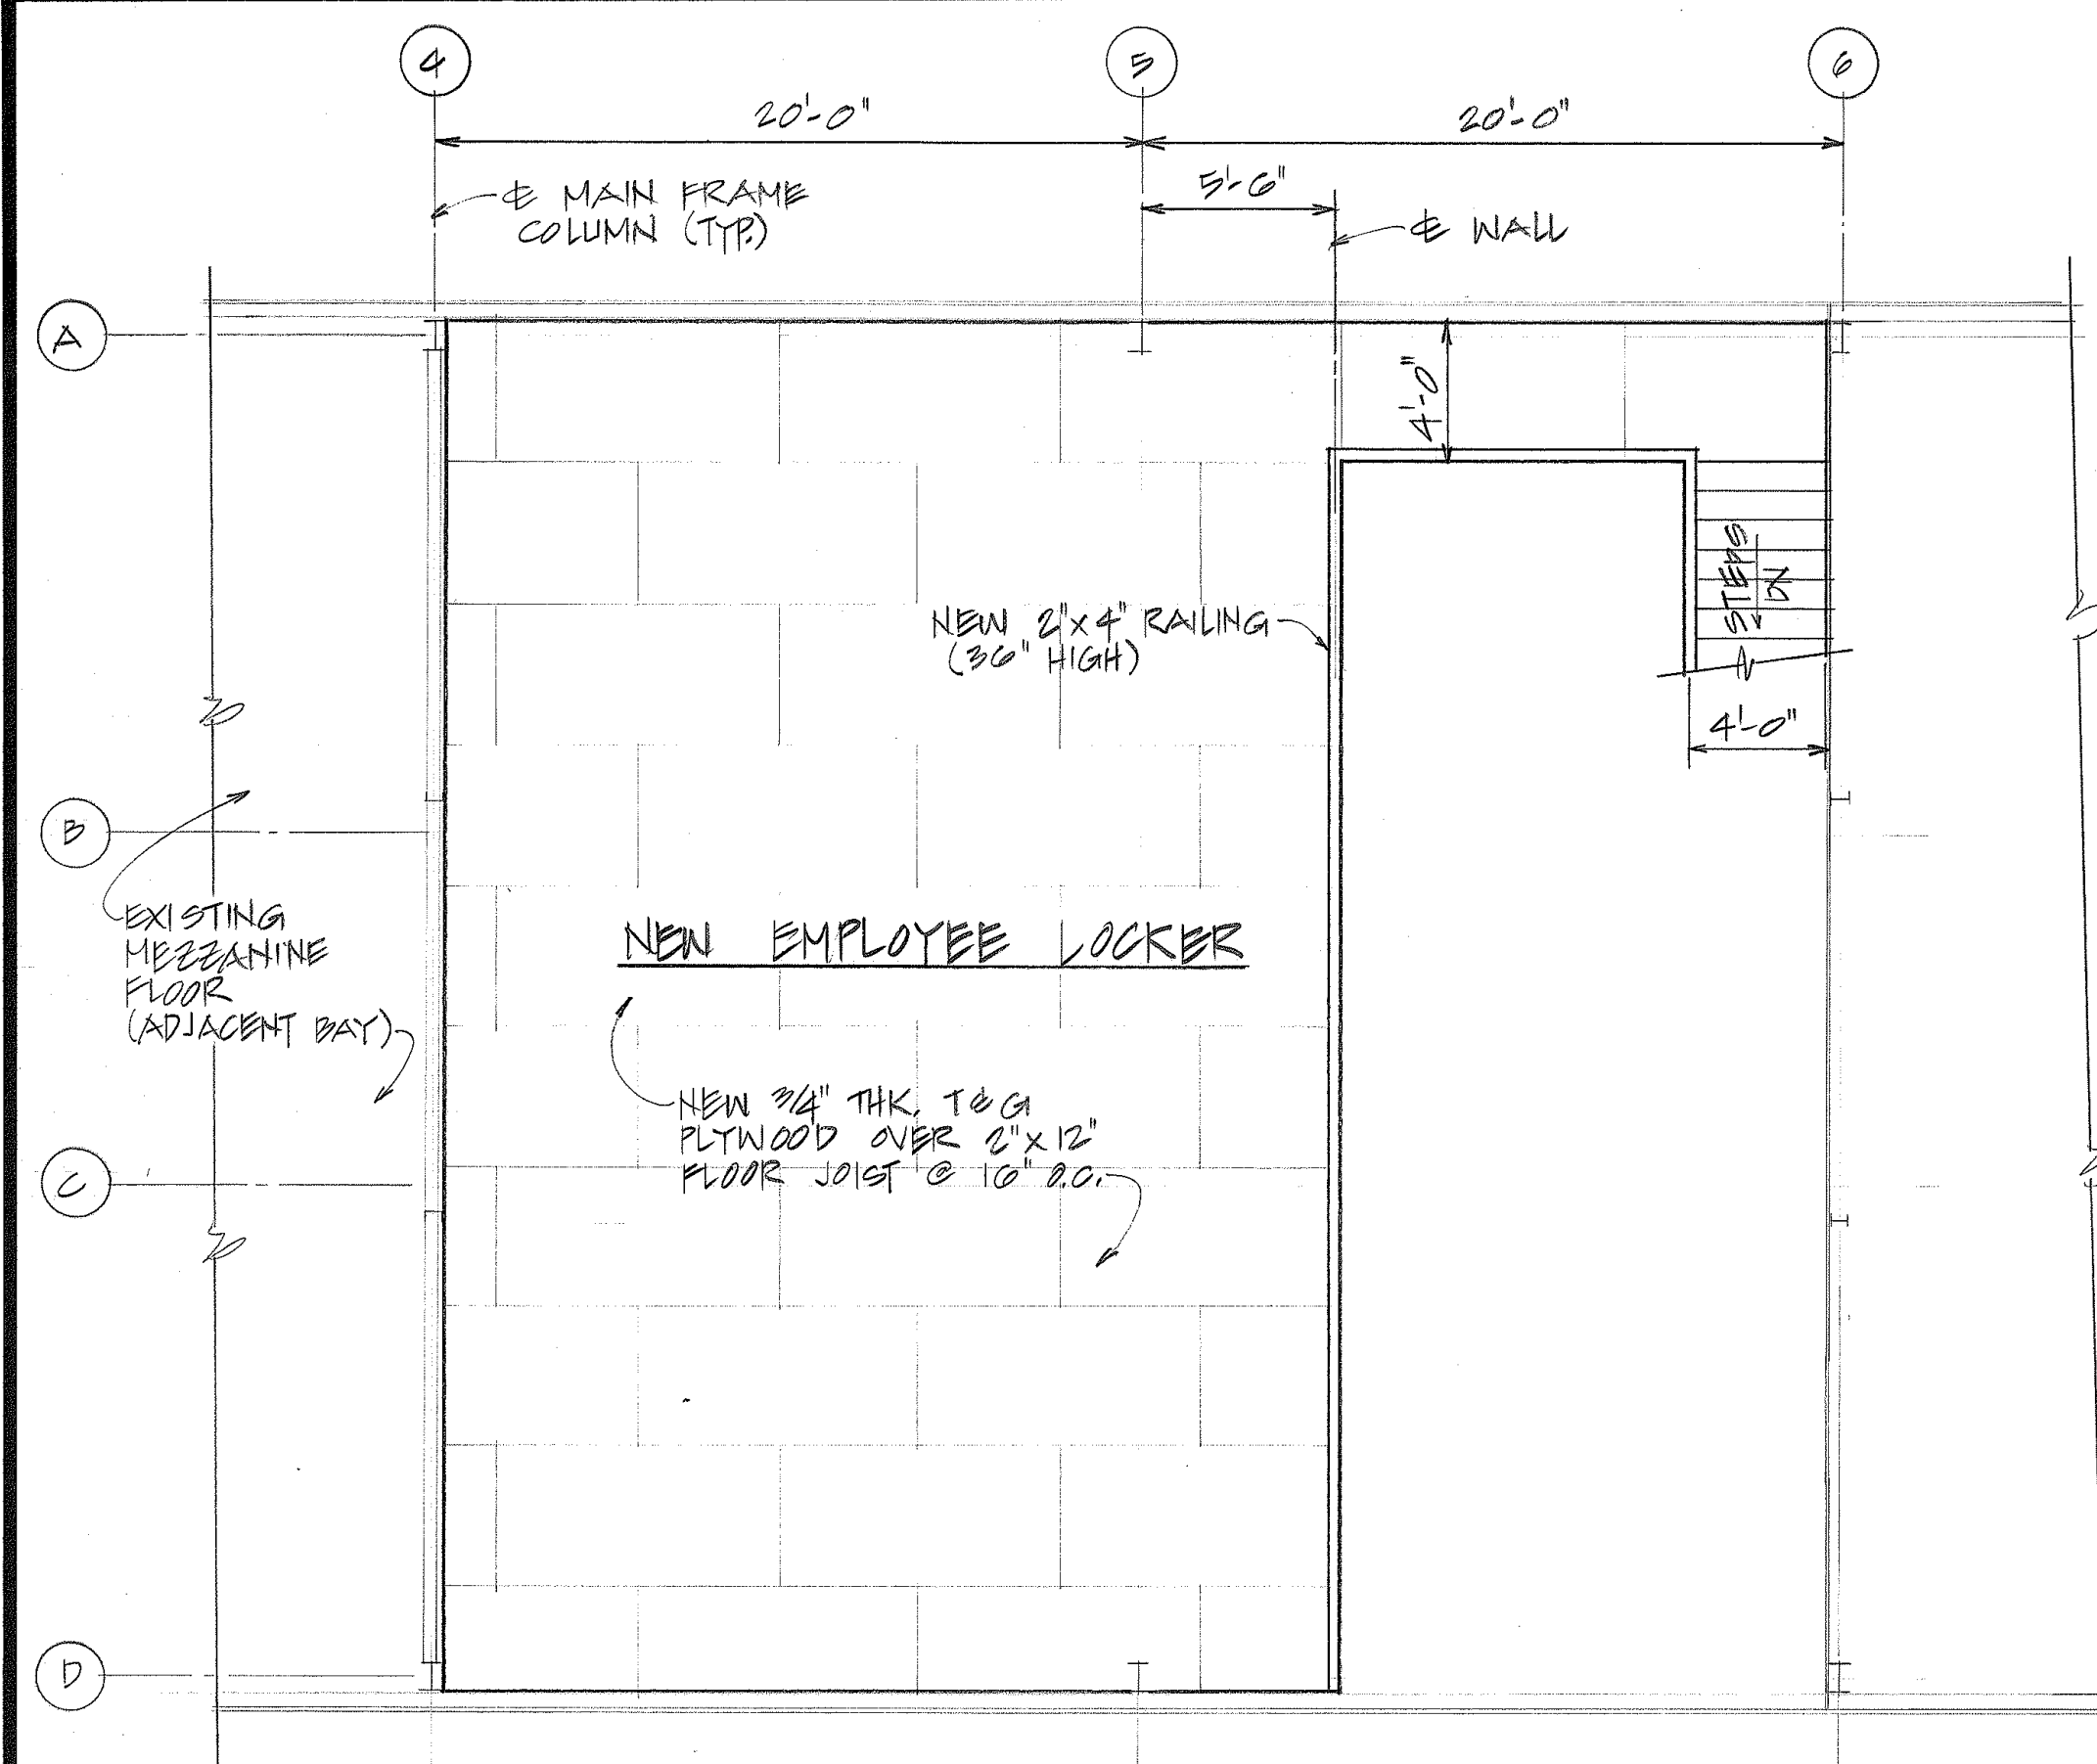


FLOOR PLAN - BLD'G 'D' (PARTIAL) - MEZZANINE FLOOR

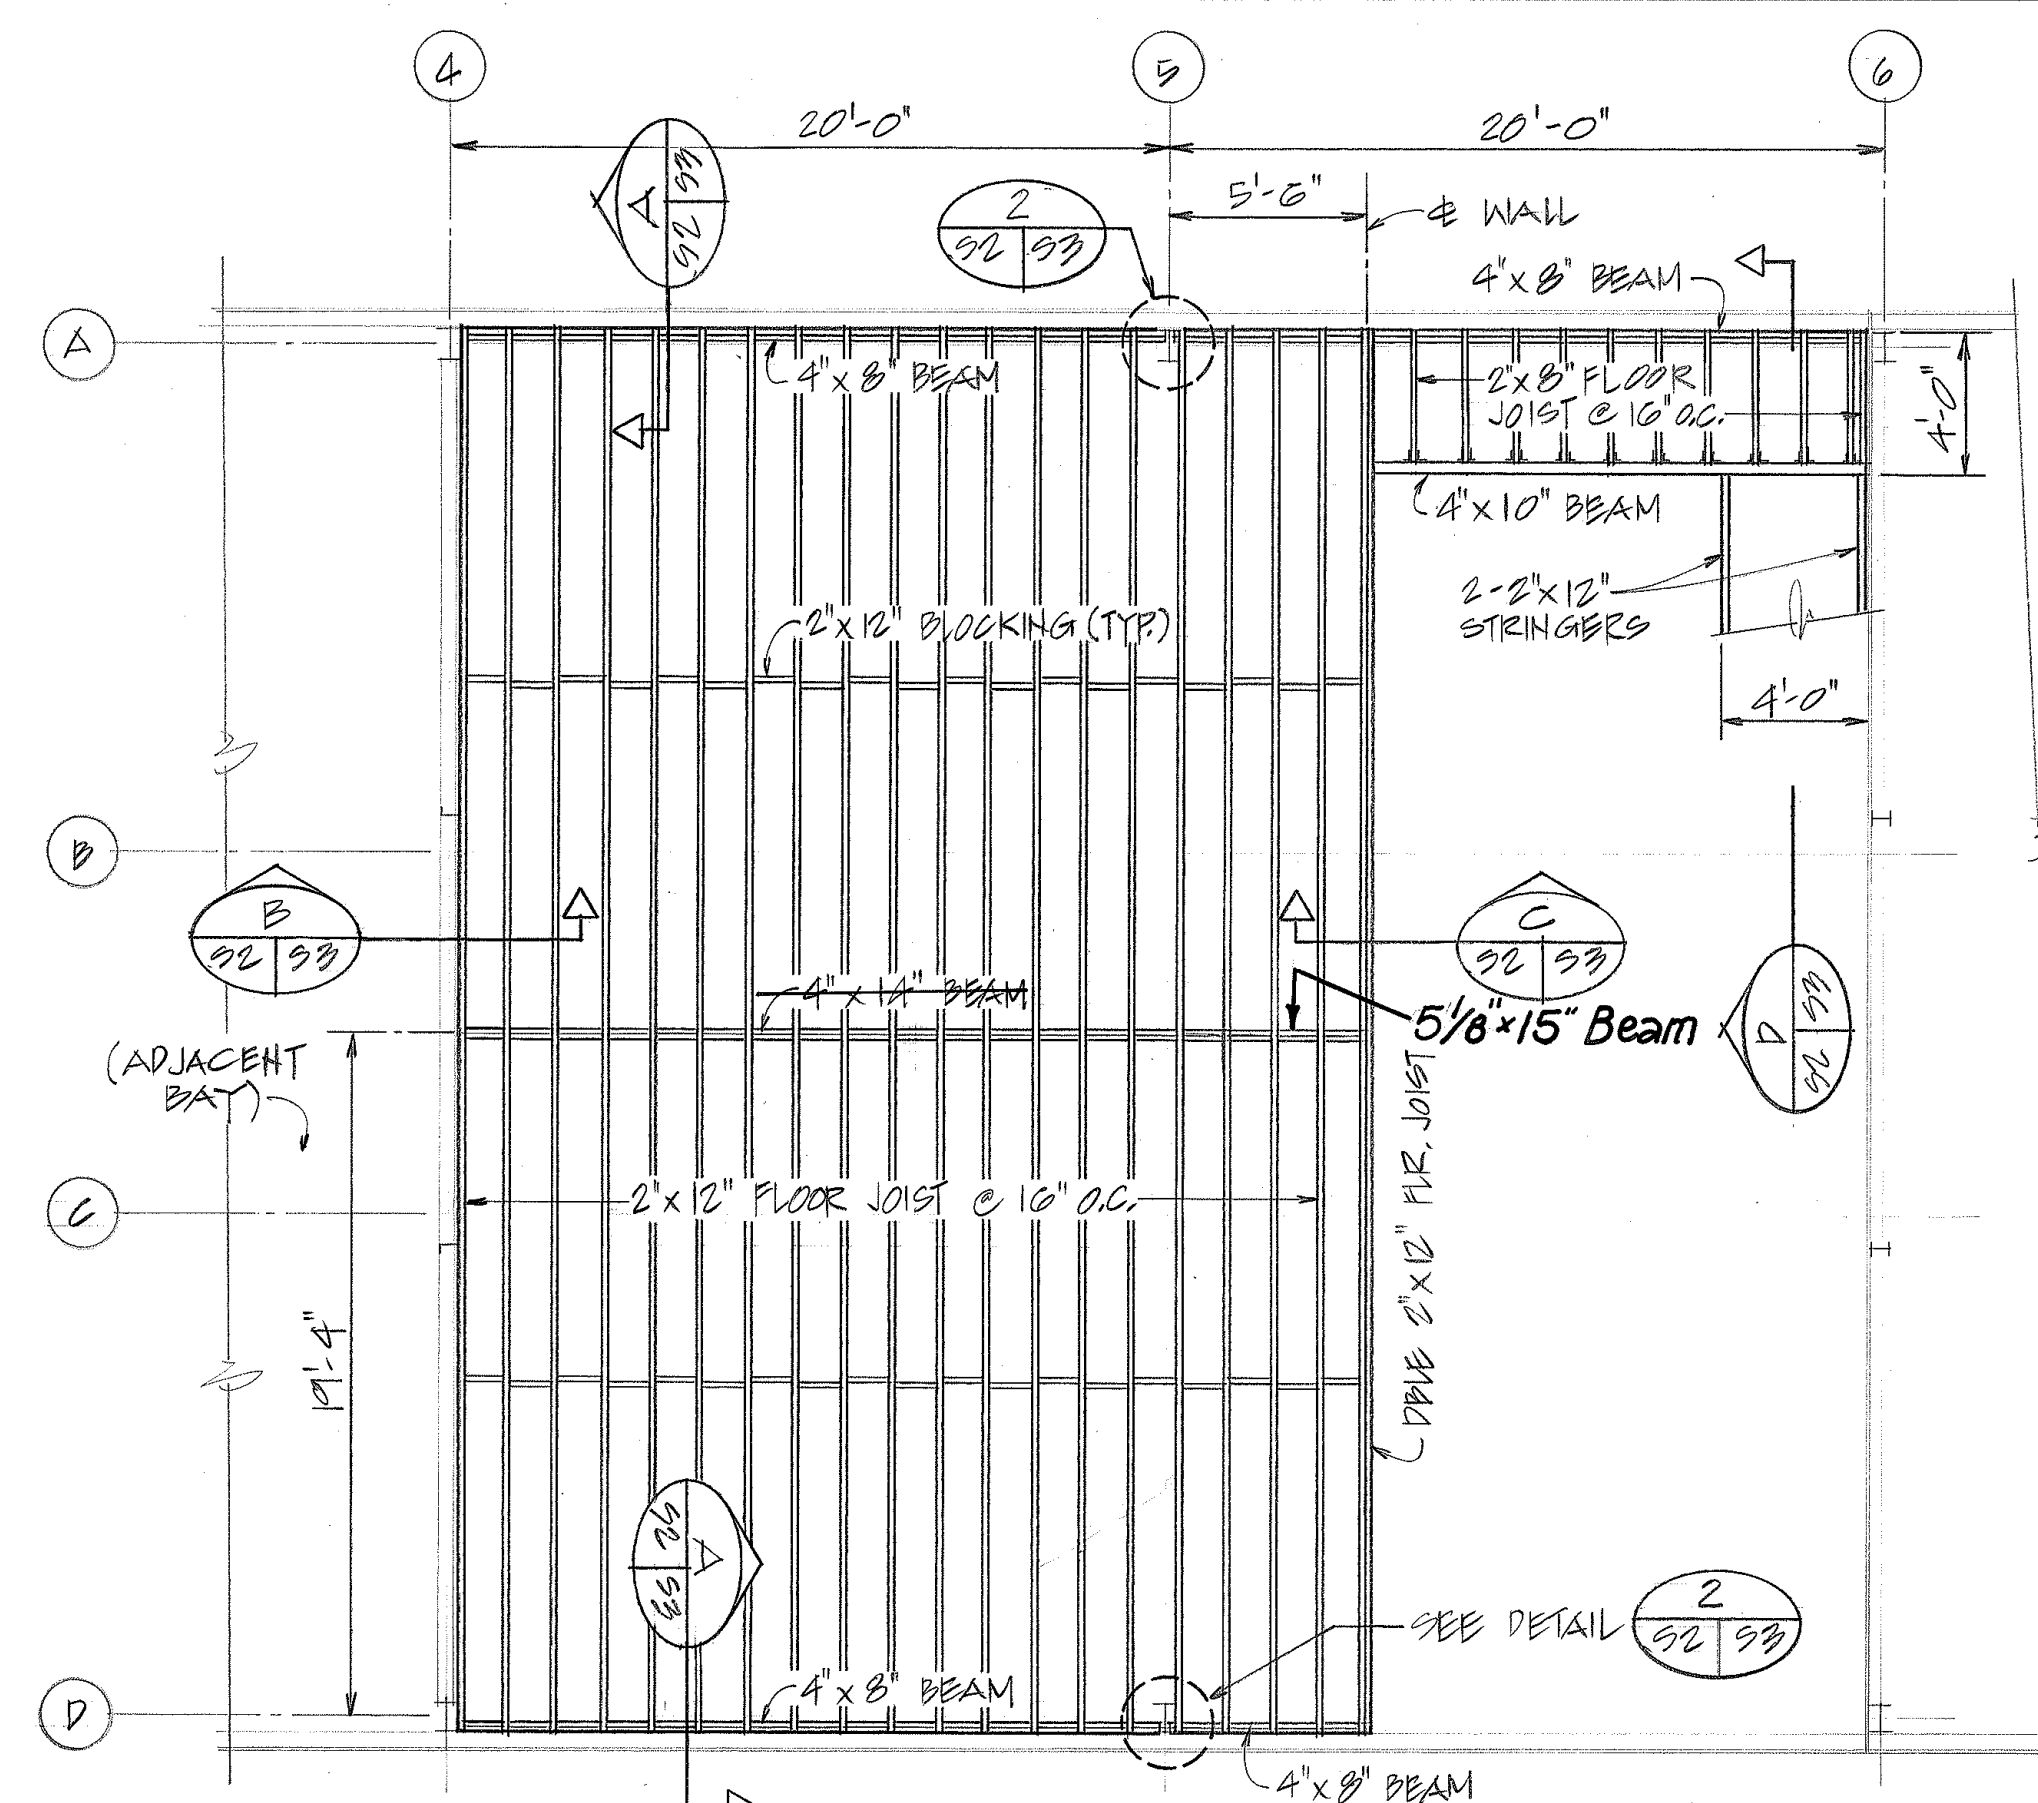

FLOOR FRAMING PLAN - BLDG 'D' - MEZZANINE FLOOR

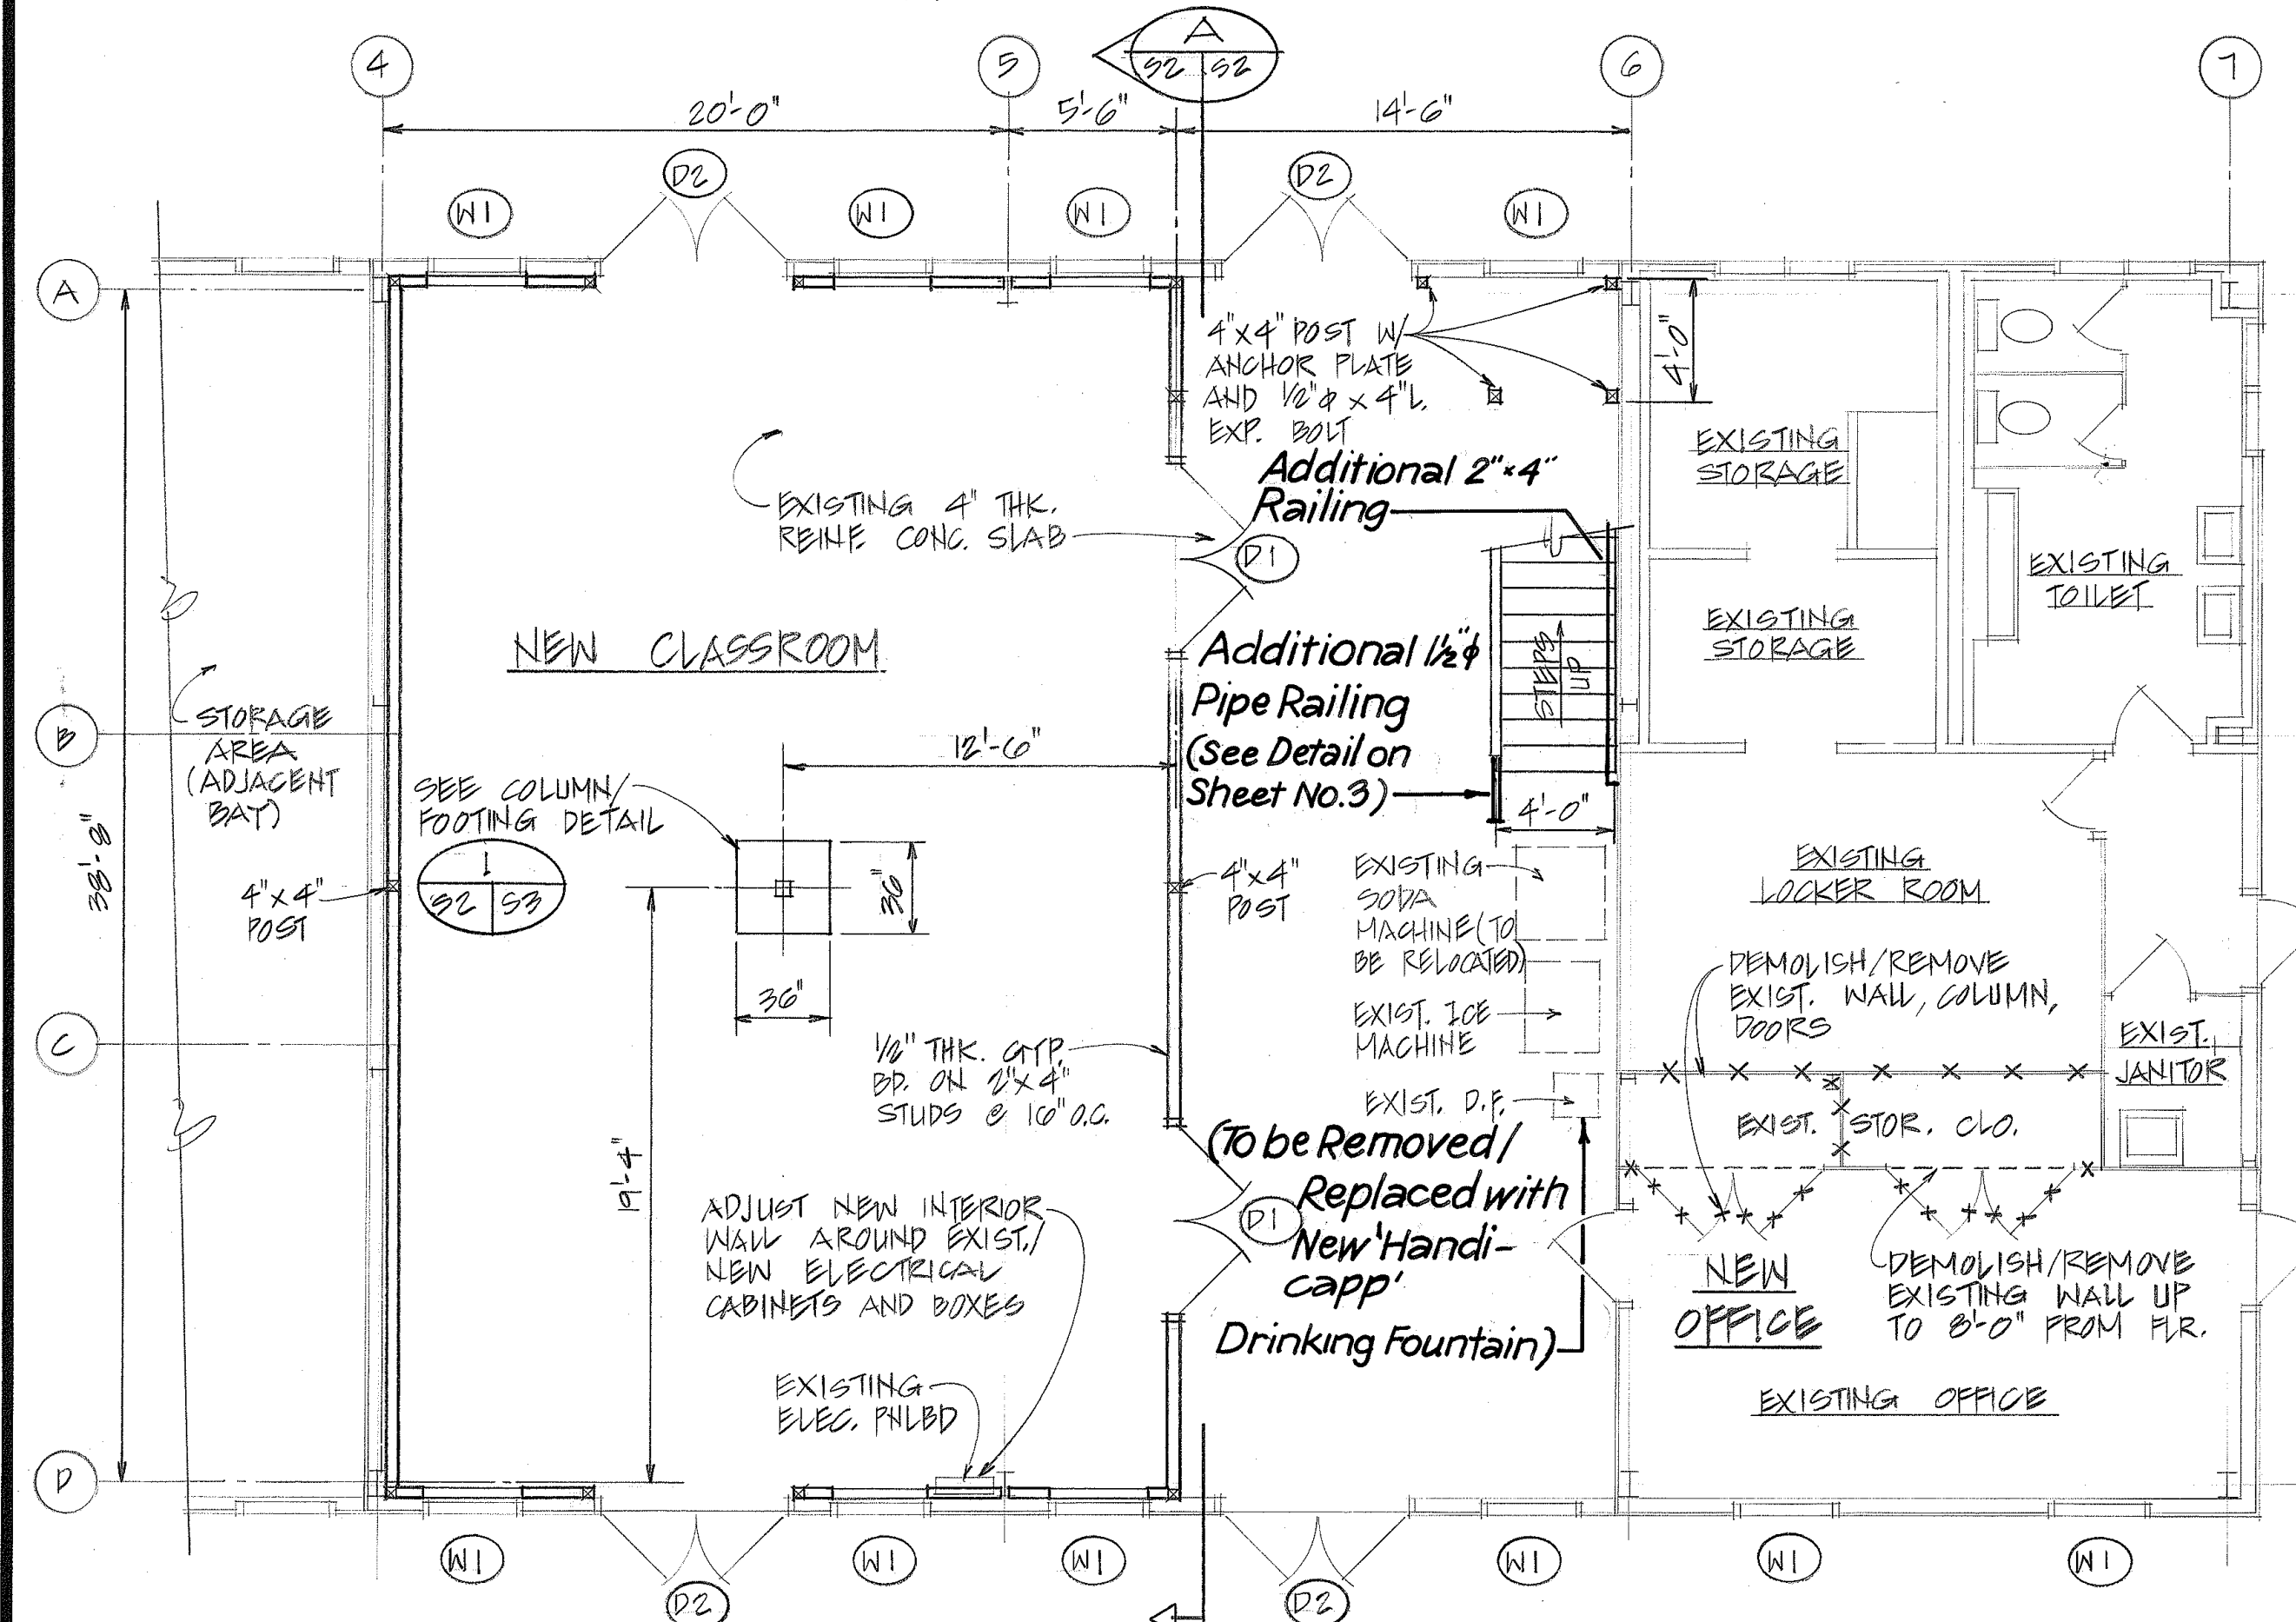


GROUND FLOOR PLAN - BLD'G 'D' (PARTIAL)
SCALE: 3/16" = 1'-0"

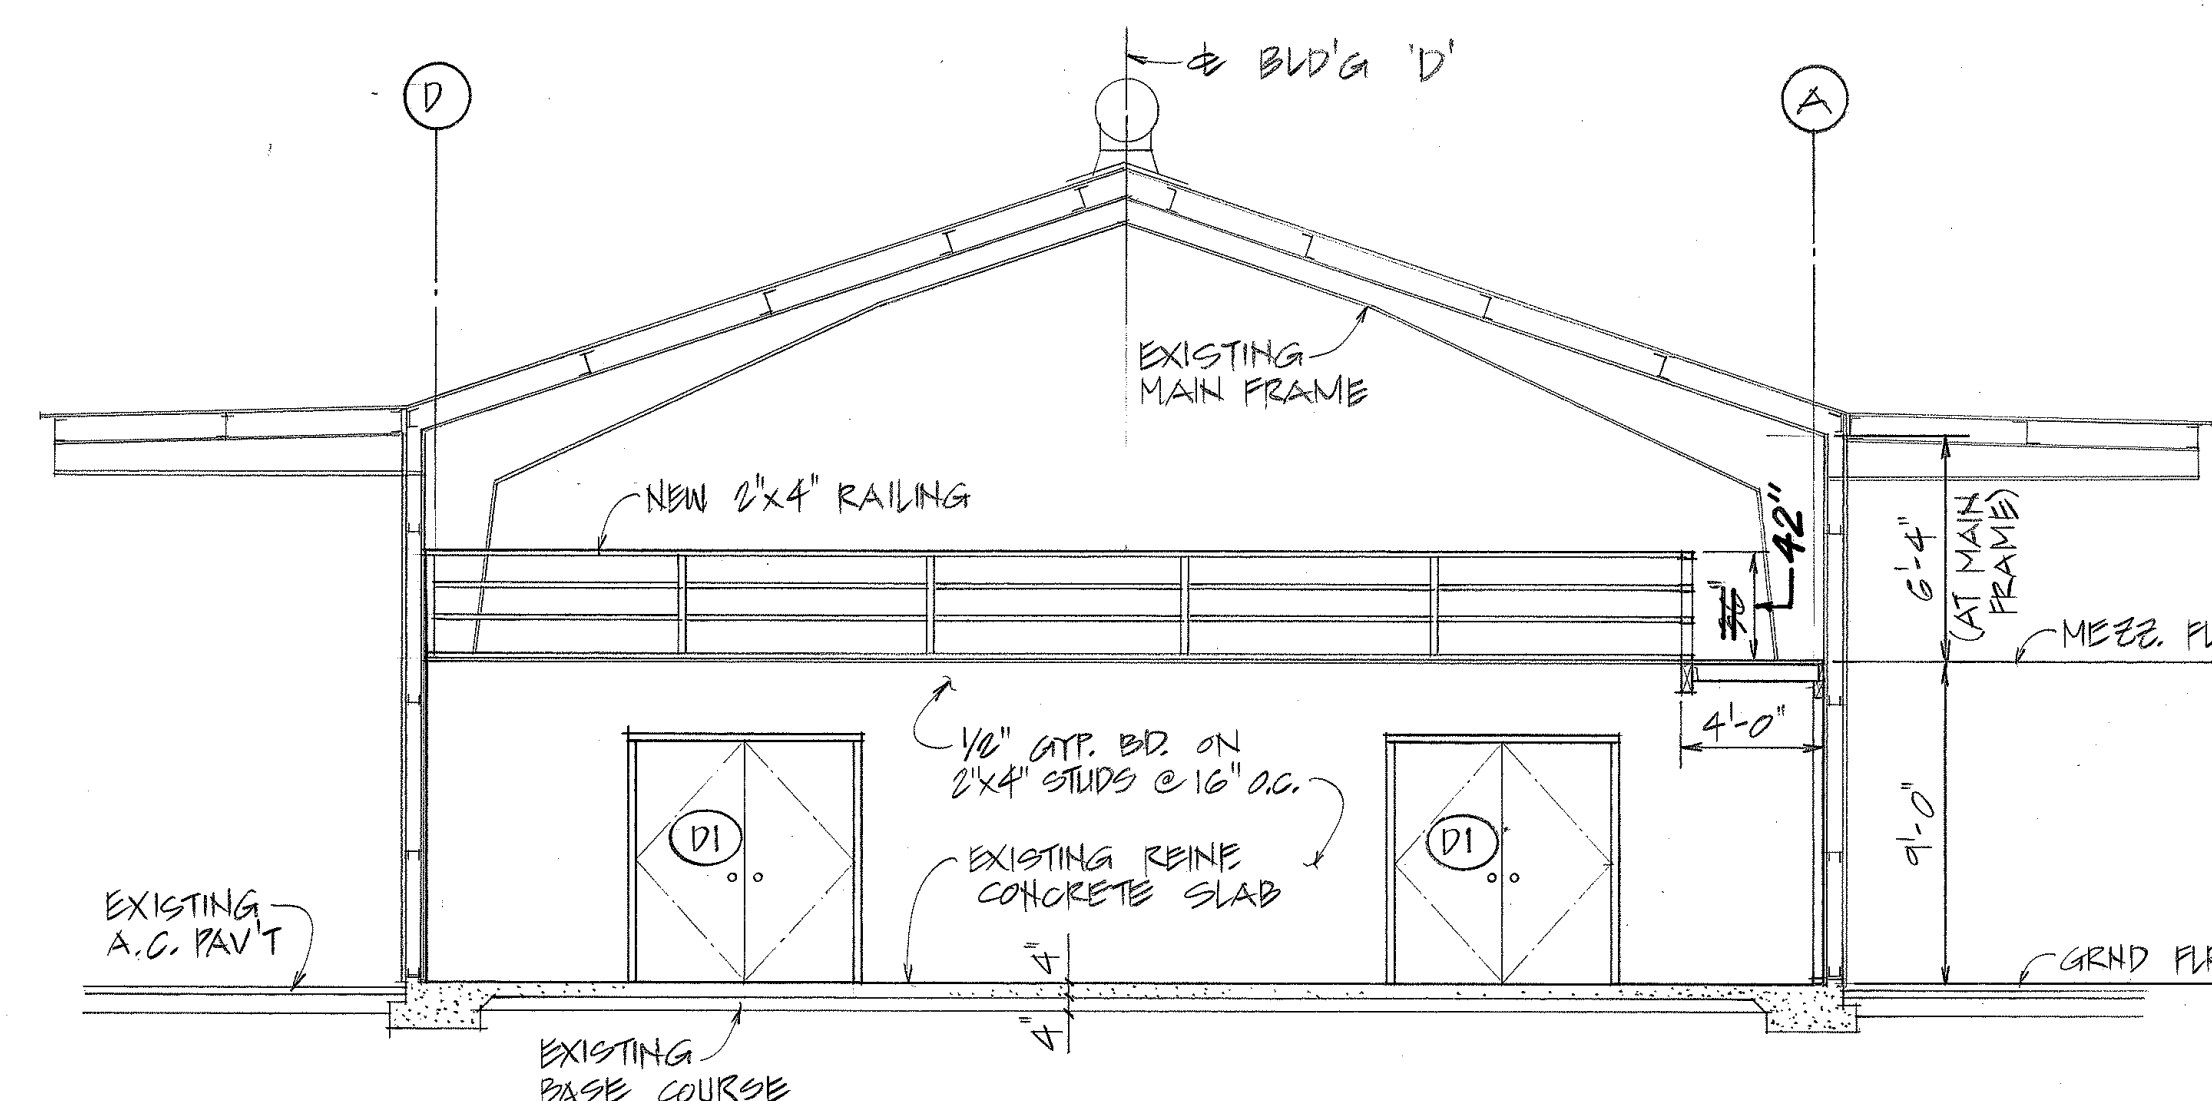


SECTION THRU BLD'G 'D'

SCALE: 3/16" = 1'-0"

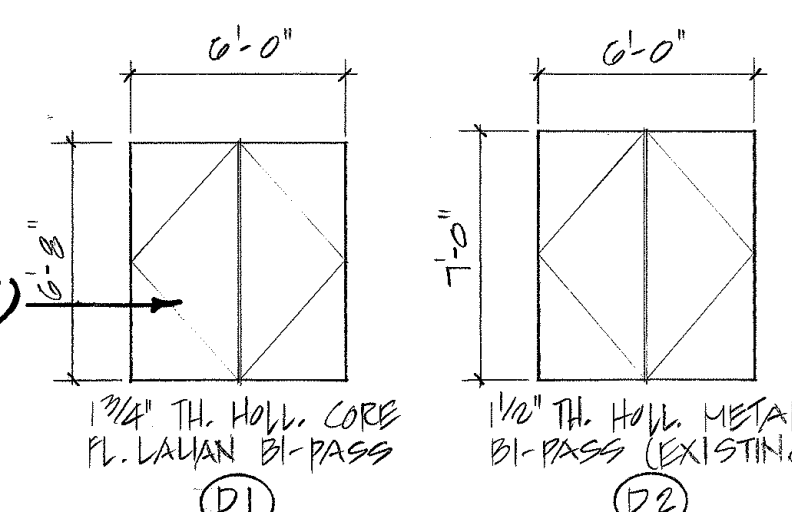

DOOR SCHEDULE
NOT TO SCALE

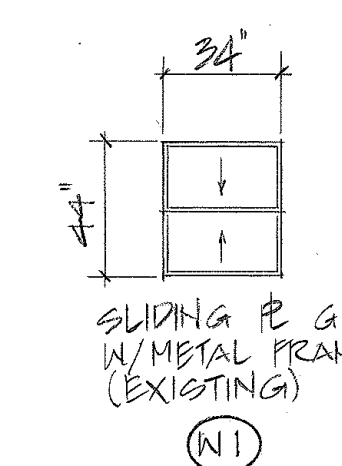

WINDOW SCHEDULE
NOT TO SCALE

Note:
Door Hardware to be
'Handicapp' type for
Easy Access (for Door D

STATE OF HAWAII
DEPARTMENT OF TRANSPORTATION
HIGHWAYS DIVISION

BUILDING 'D'
FLOOR PLANS & TYPICAL SECTION

HILO BASEYARD BUILDING 'D'
OFFICE RENOVATION
PROJ. NO. HNT-H-02-92M



SCALE: AS NOTED DATE: APRIL 1992

SHEET NO. 1 OF 2 SHEETS


"AS-BUILT"

2


FED. ROAD DIST. NO.	STATE	PROJ. NO.	FISCAL YEAR	SHEET NO.	TOTAL SHEETS
HAWAII	HAW.	HNT-H-02-92M	1992	3	11

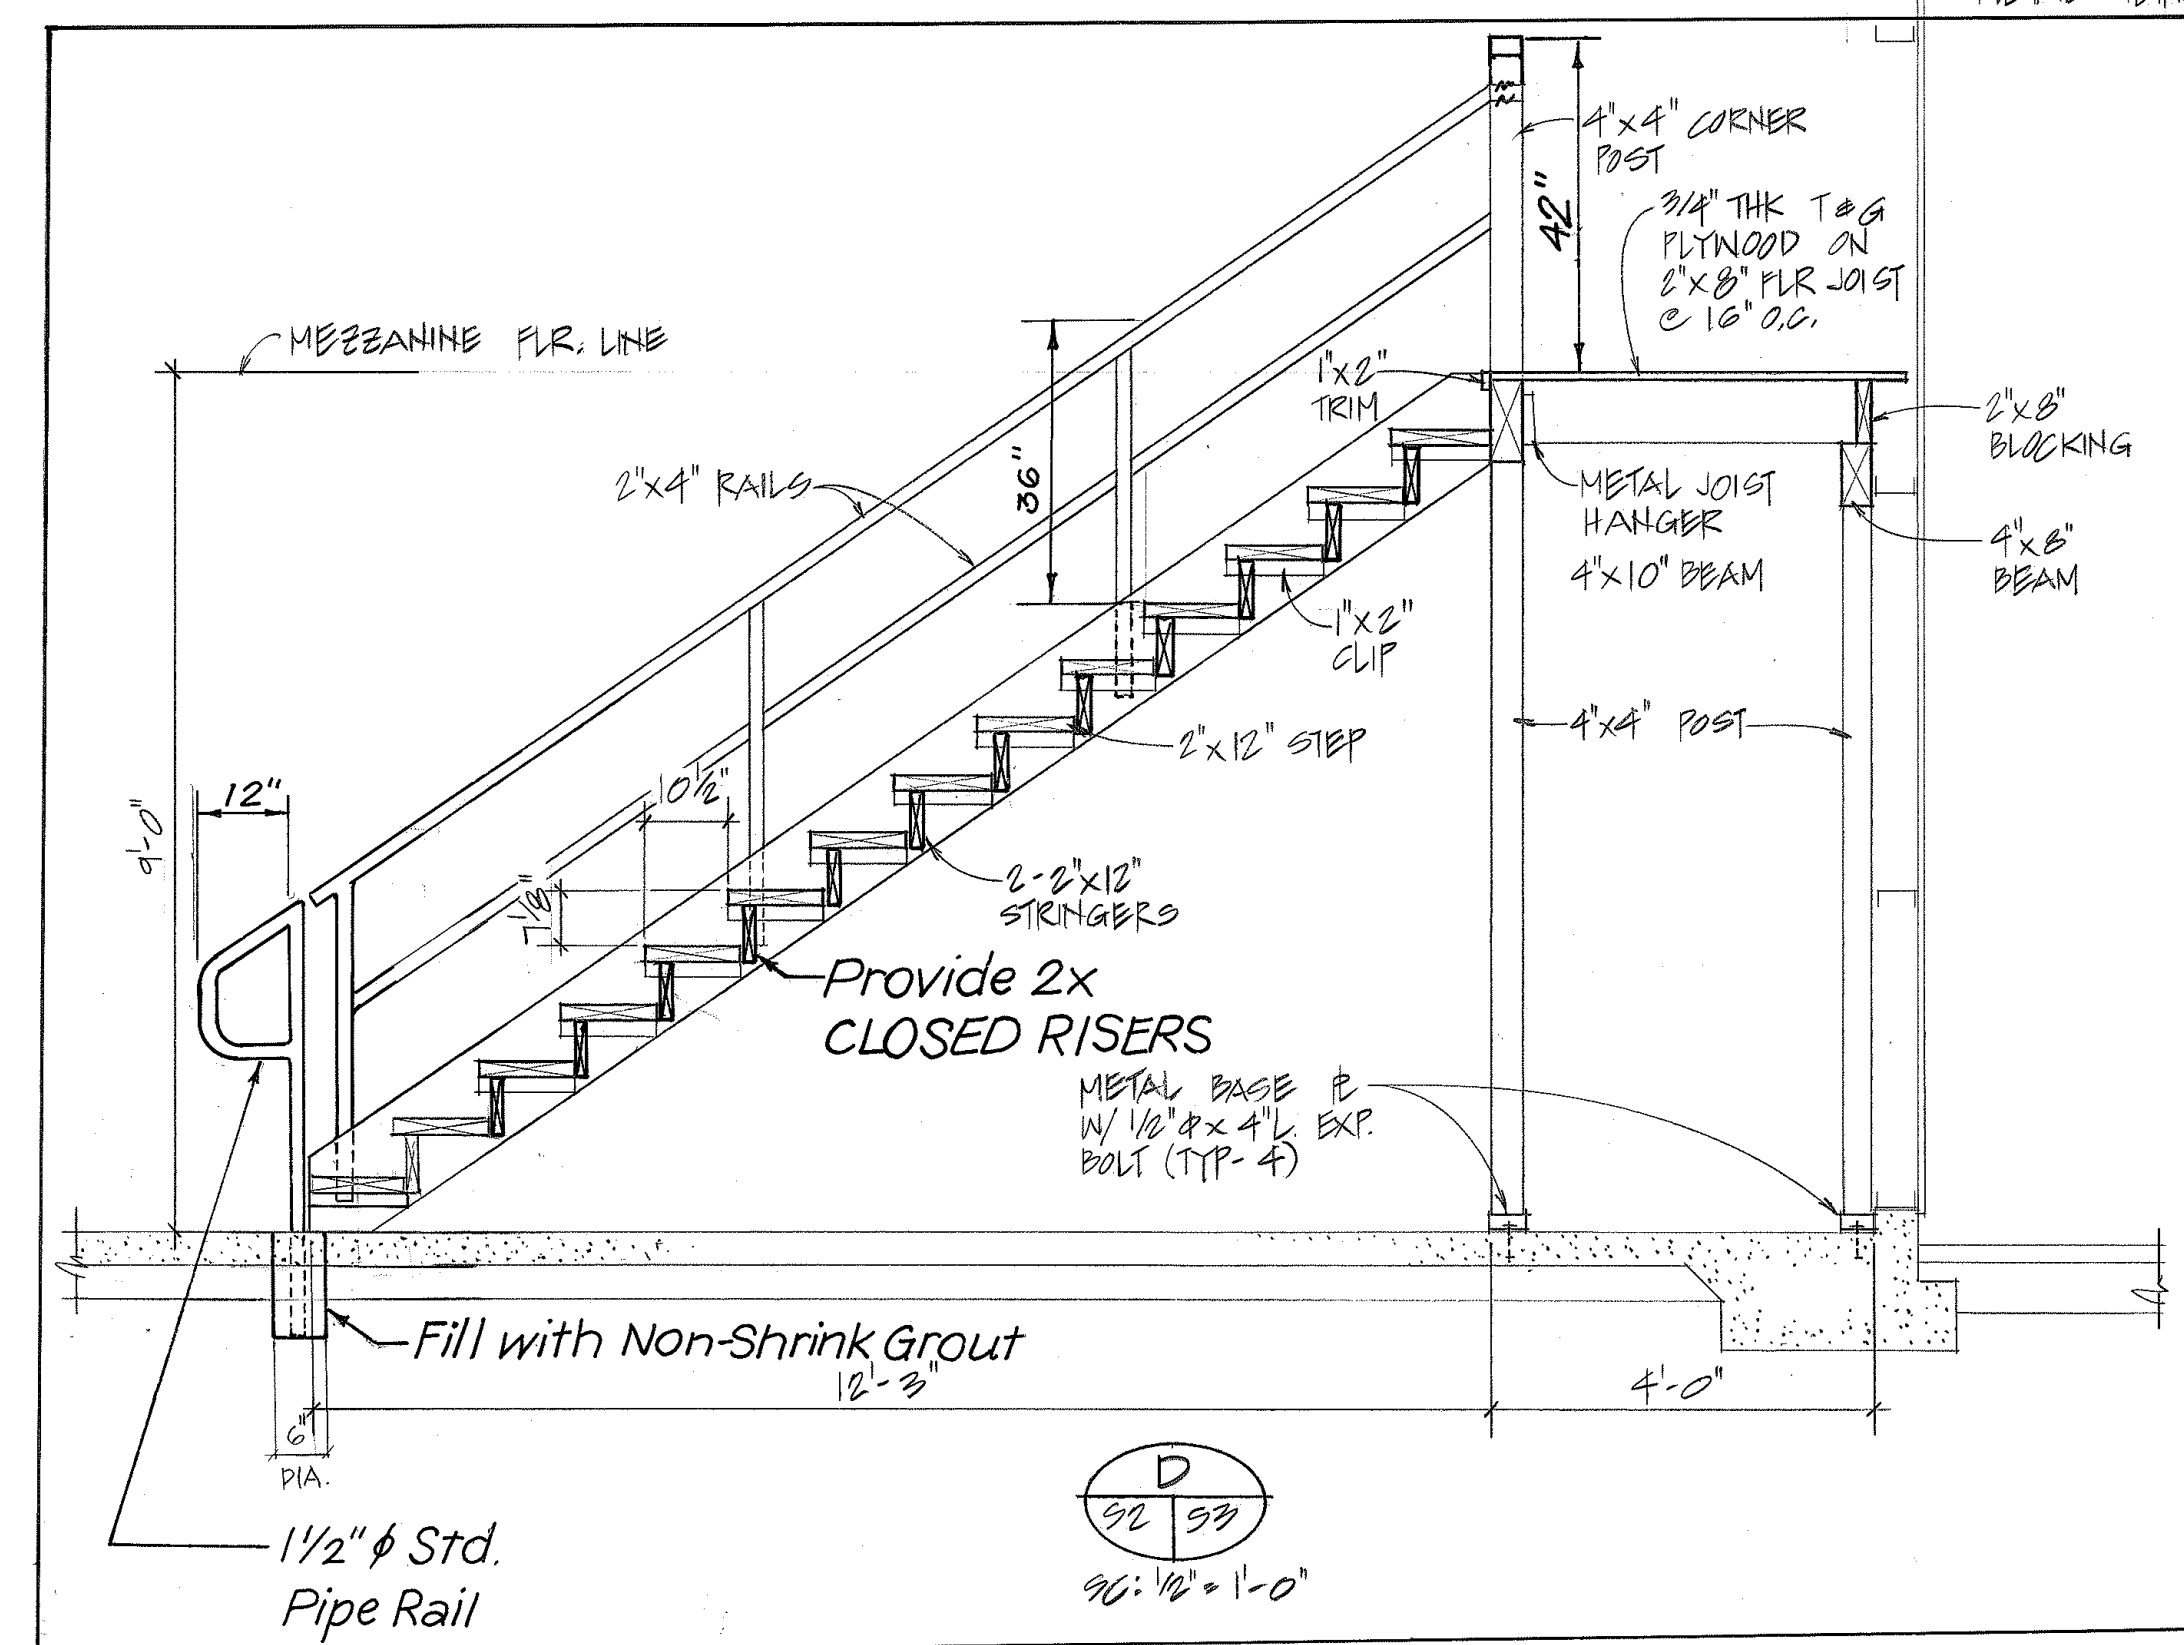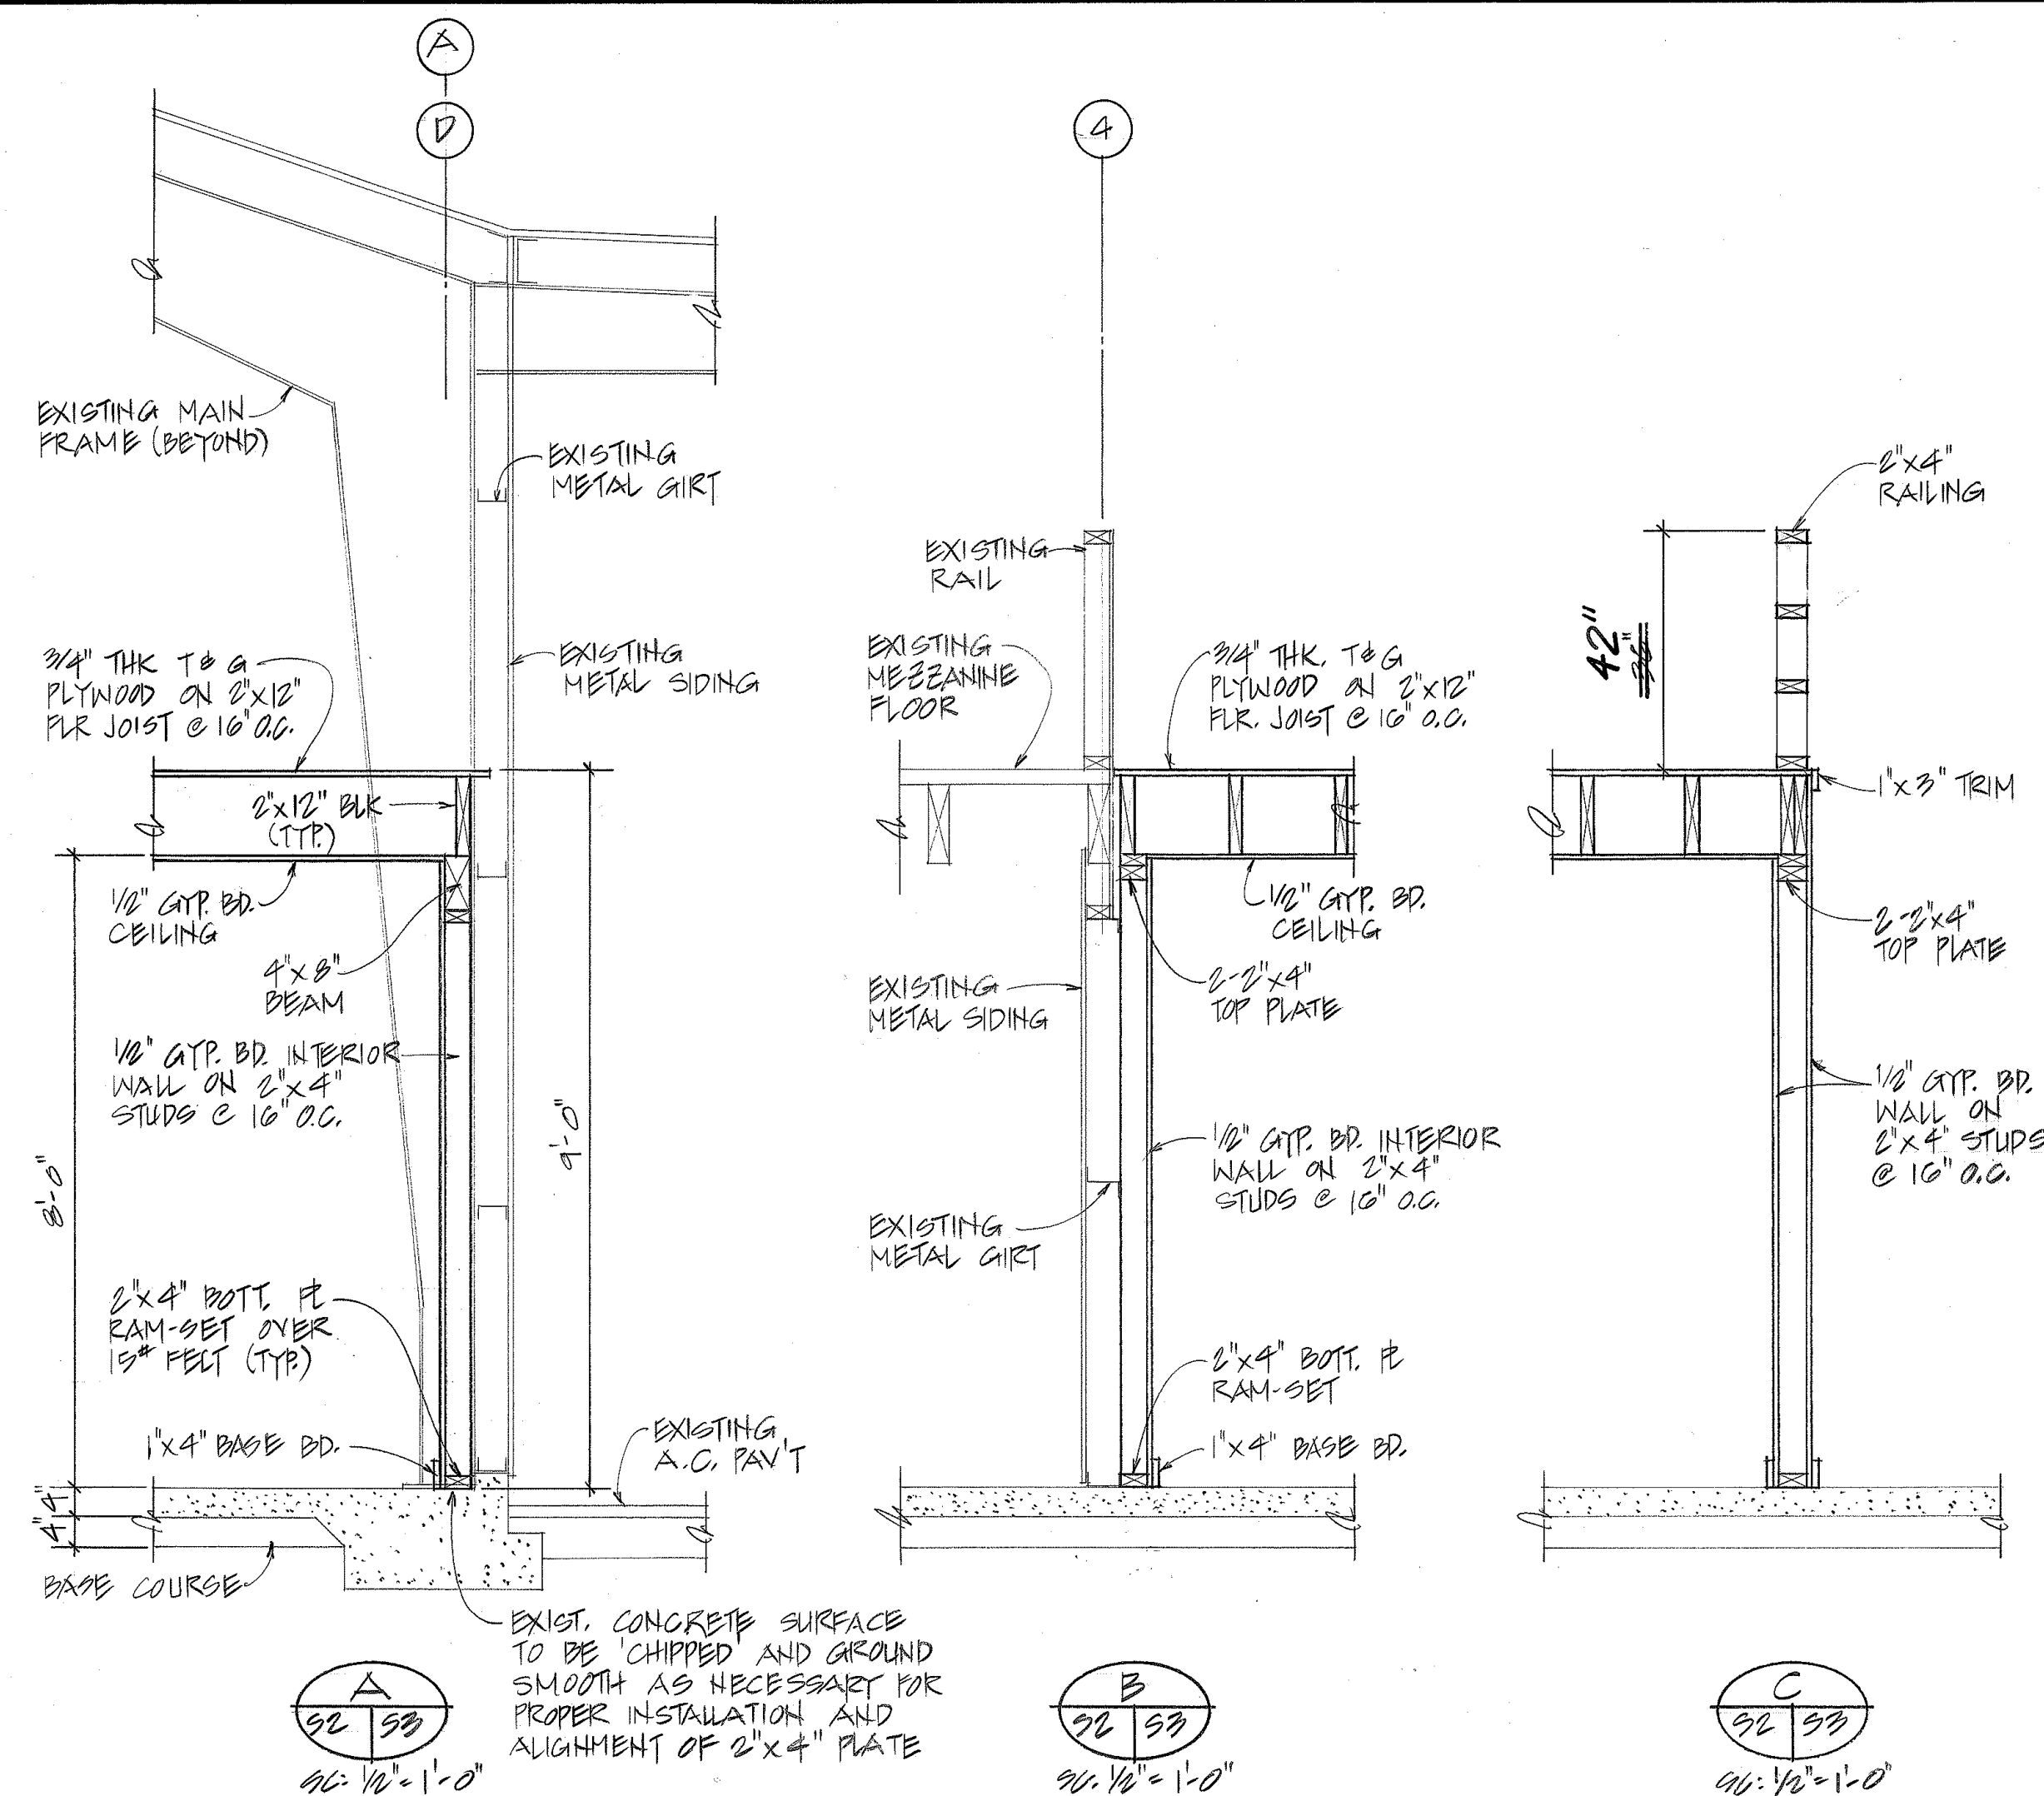


"As-Built within drawn in black"

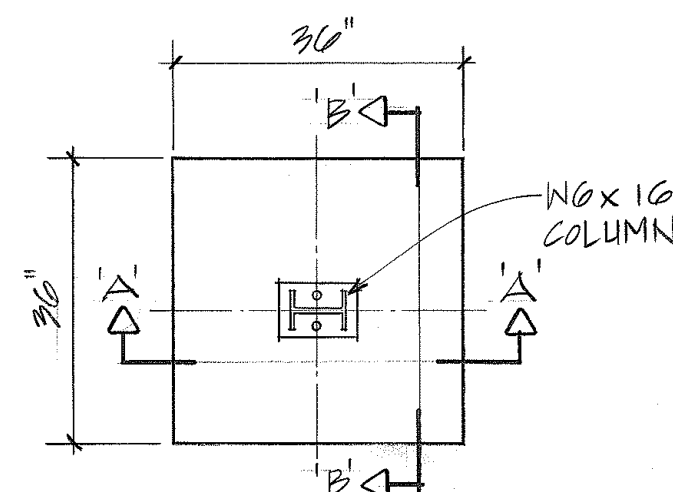

PLAN

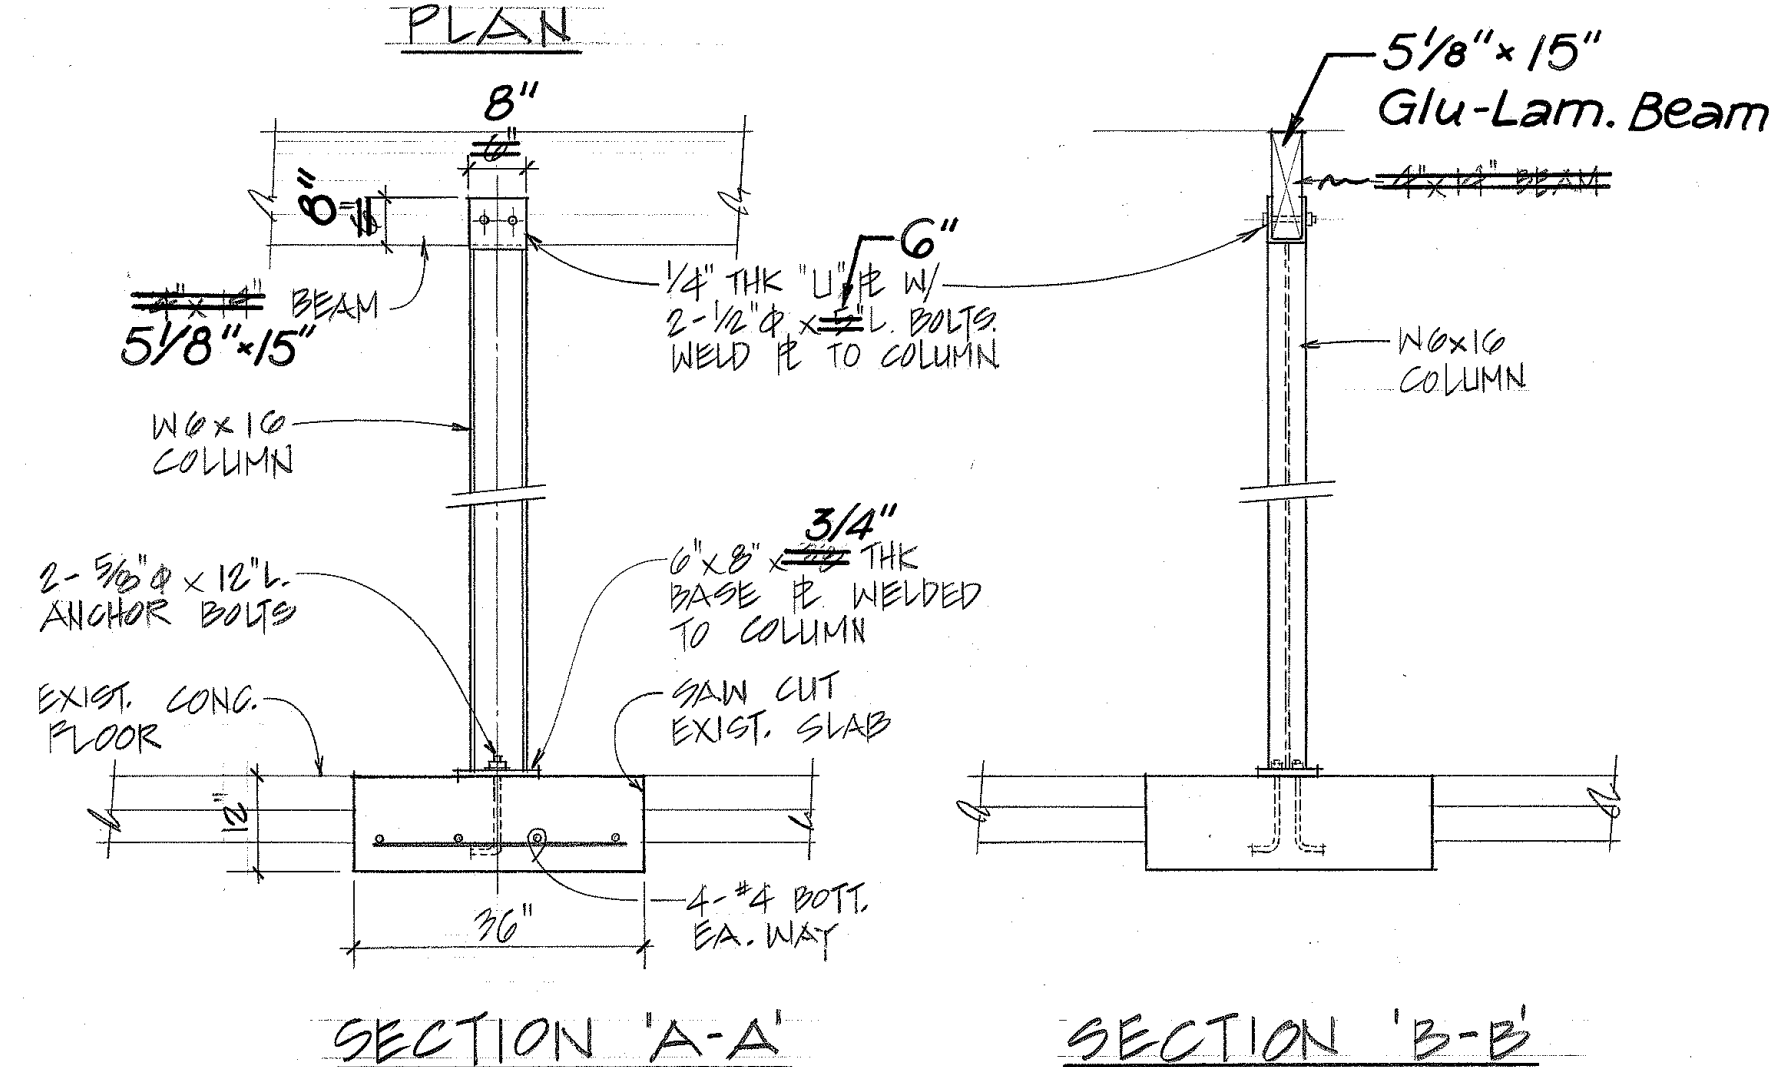

DETAIL 1
SCALE: 1/2" = 1'-0"

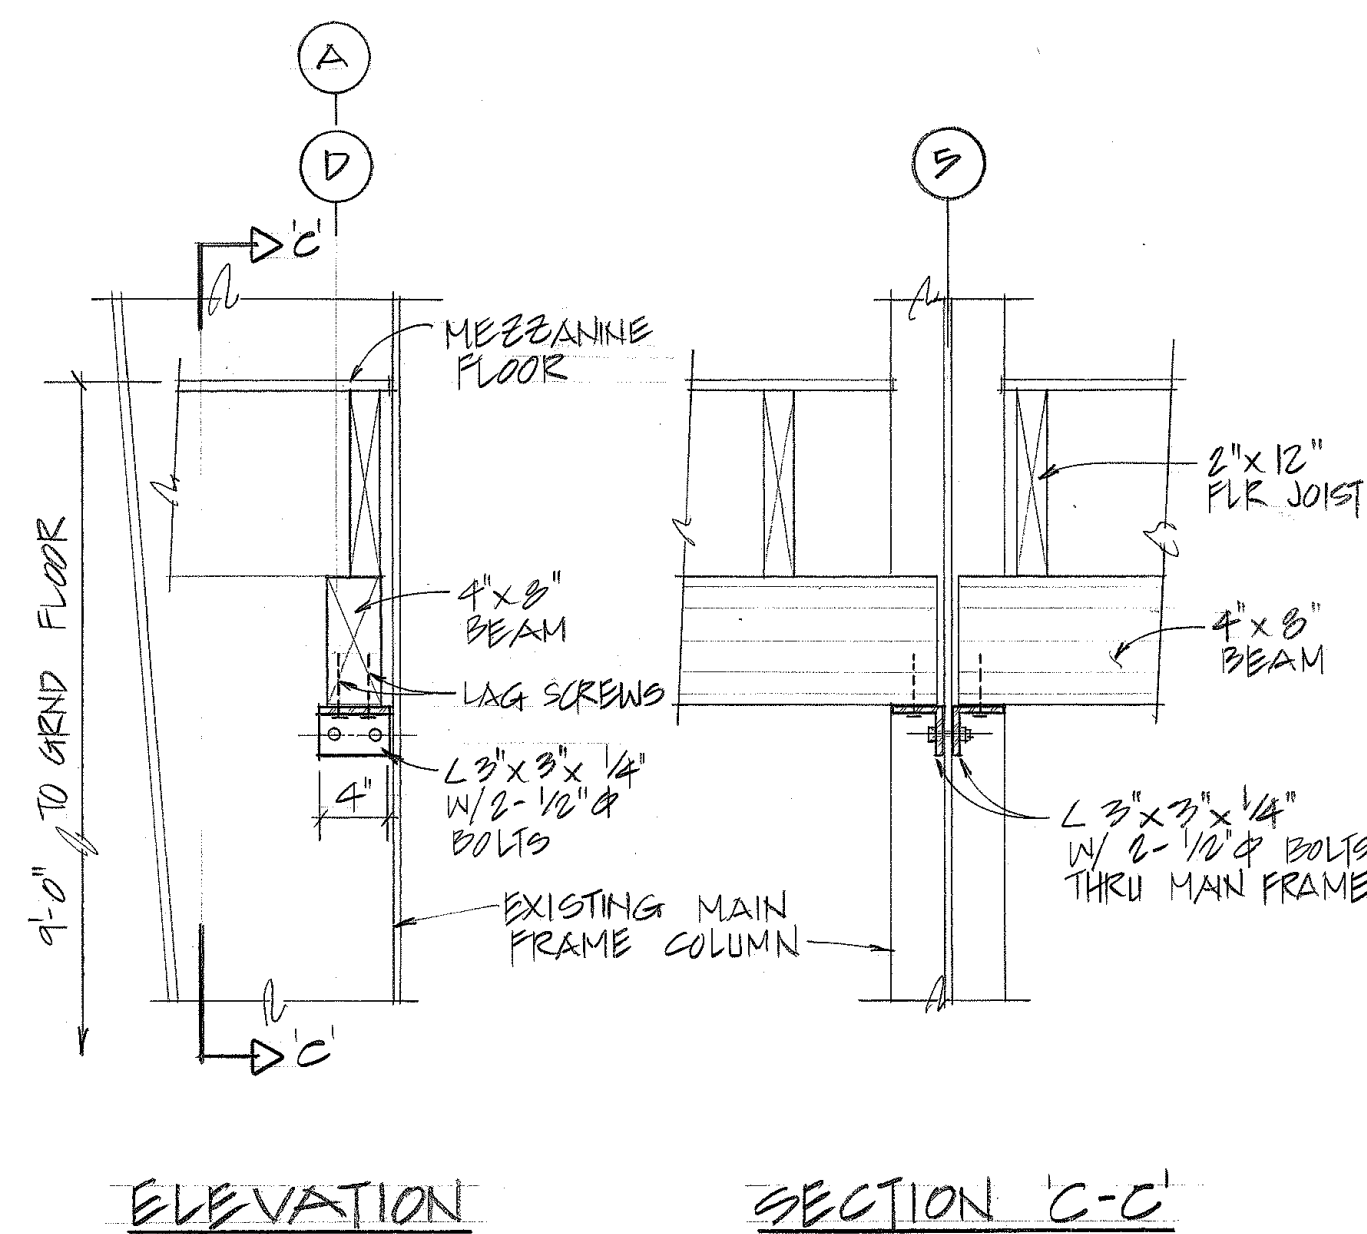

DETAIL 2
SCALE: 1" = 1'-0"

STATE OF HAWAII
DEPARTMENT OF TRANSPORTATION
HIGHWAYS DIVISION

BUILDING 'D'
SECTIONS & DETAILS

HILLO BASEYARD BUILDING 'D'
OFFICE RENOVATION
PROJ. NO. HNT-H-02-92M
SCALE: AS NOTED DATE: APRIL 1992

SHEET NO. 2 OF 2 SHEETS

"AS-BUILT"

3