
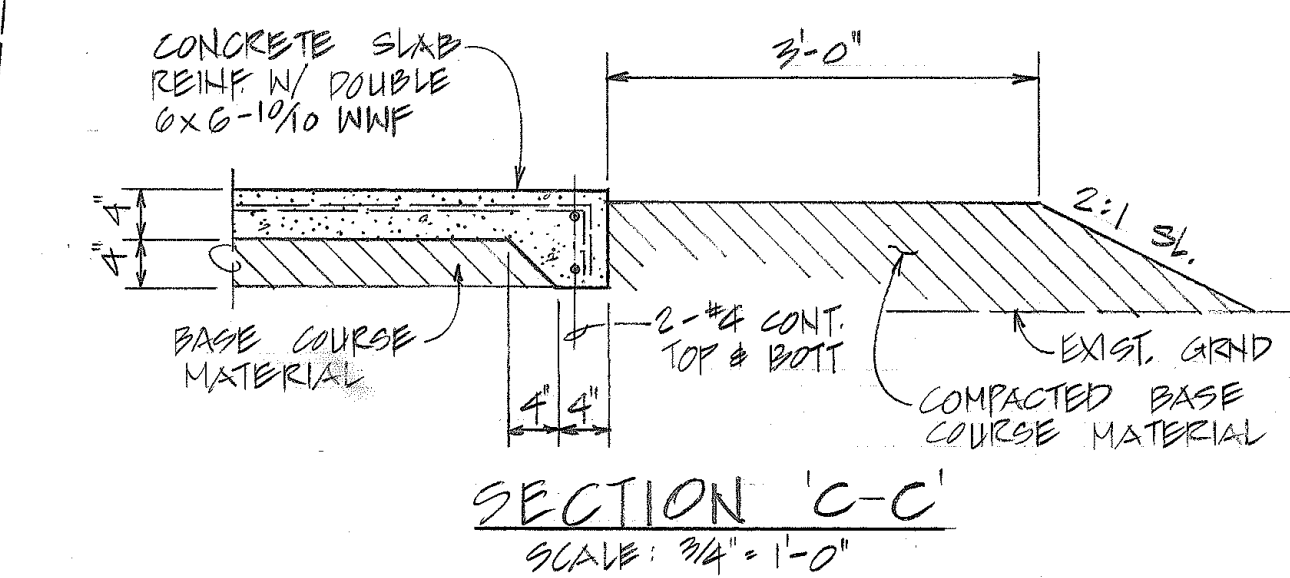
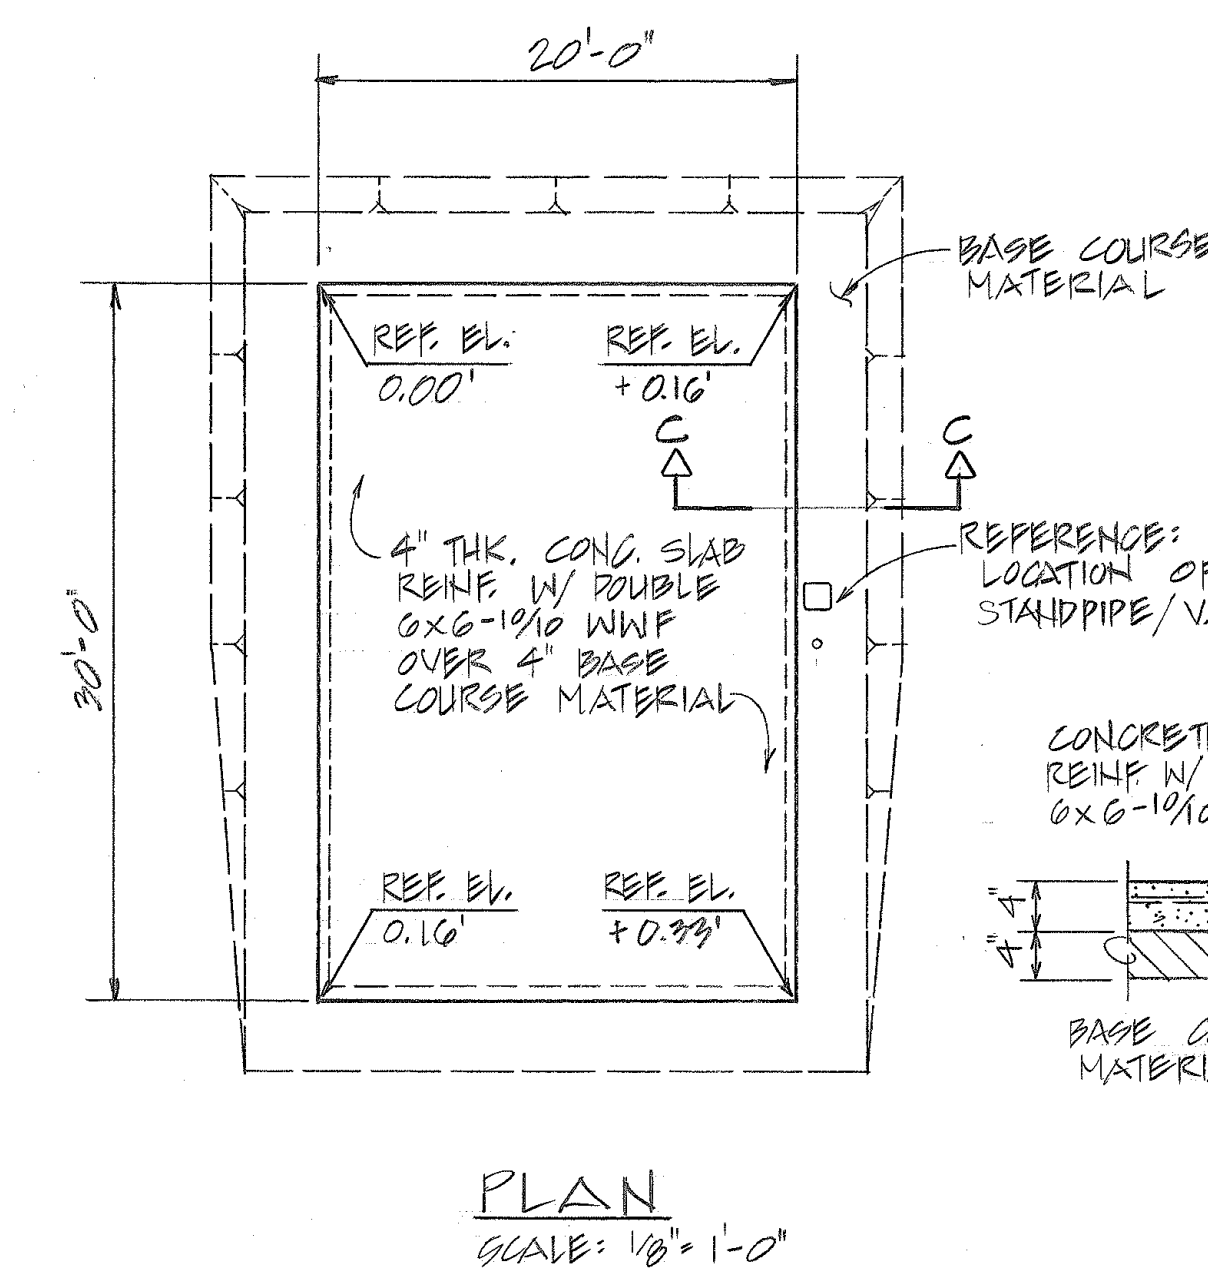
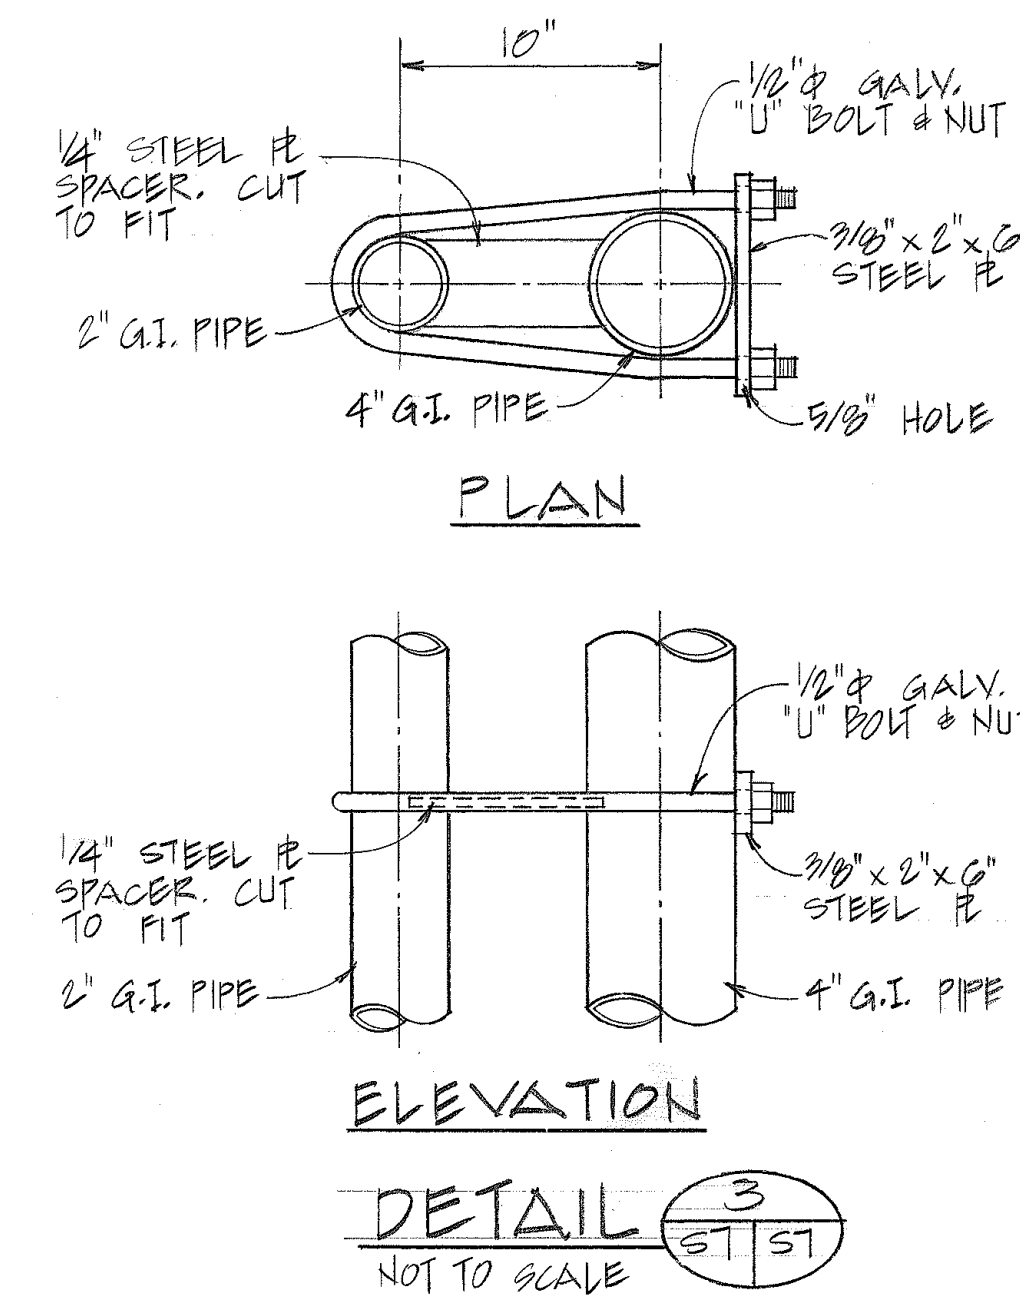
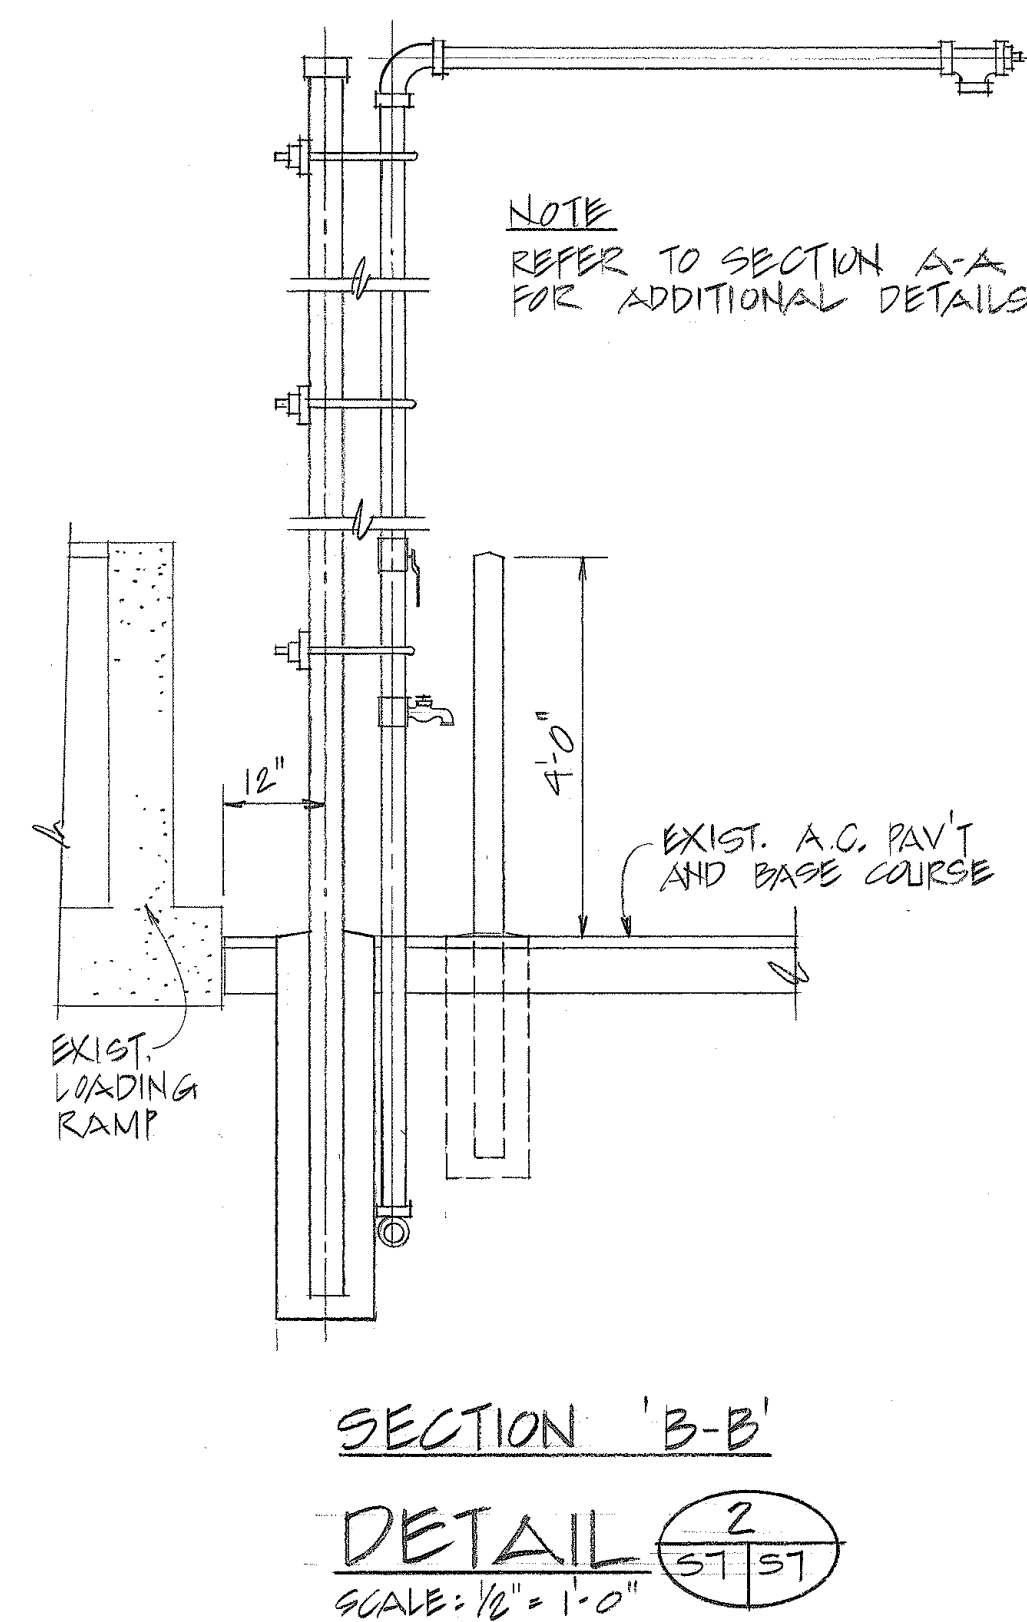
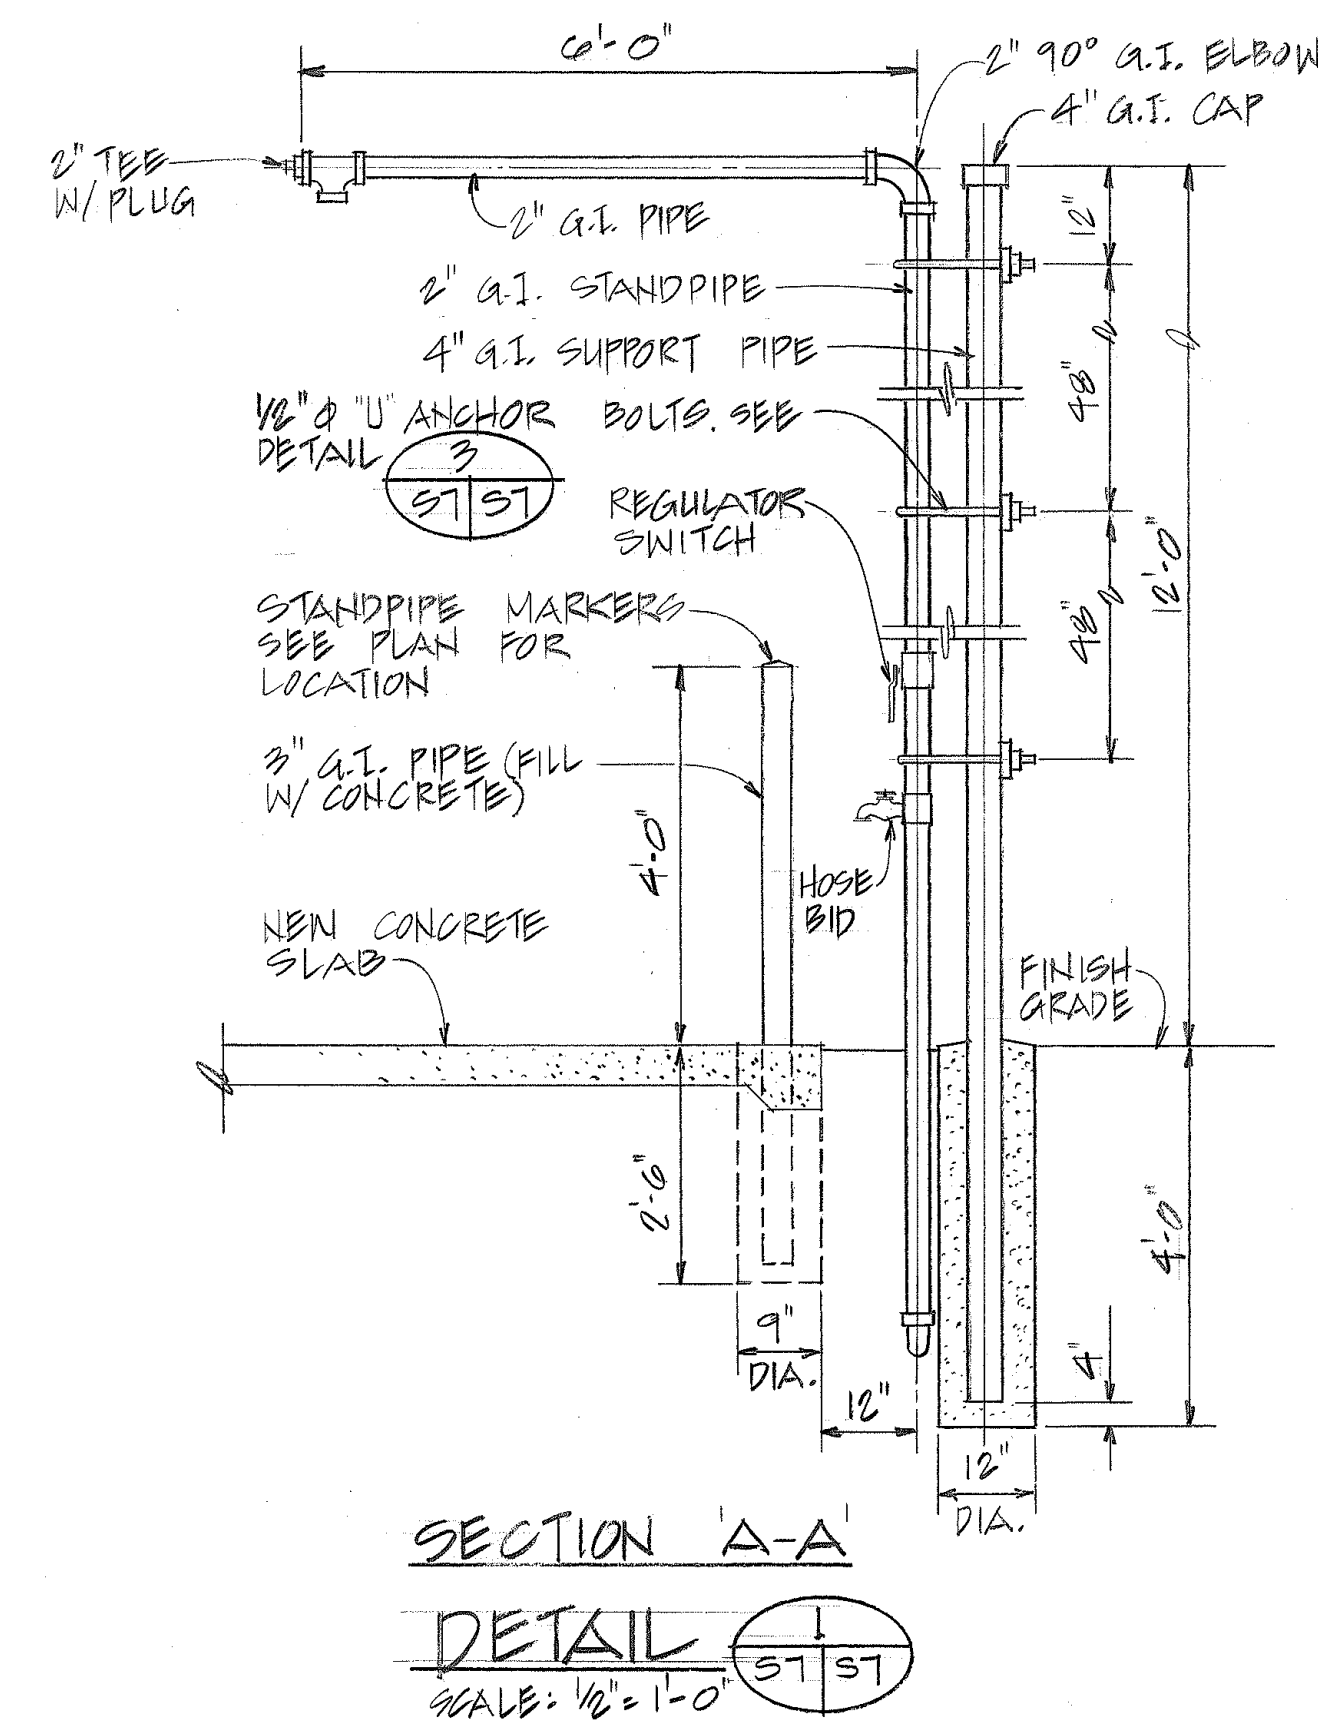
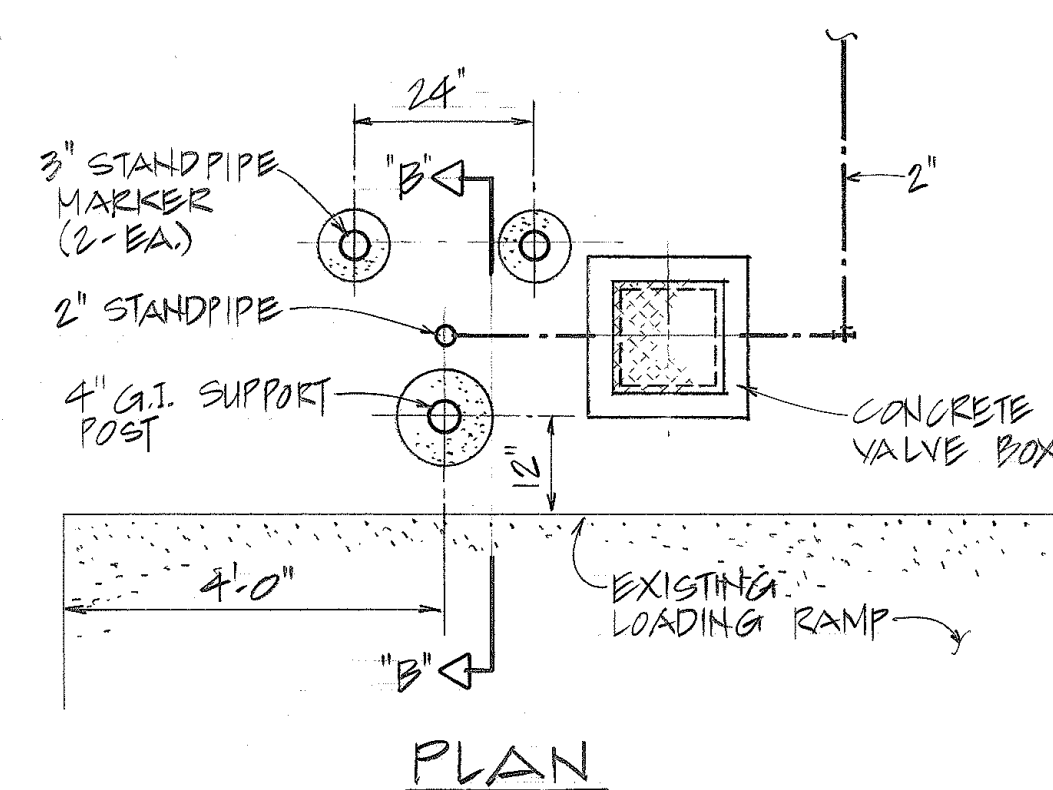
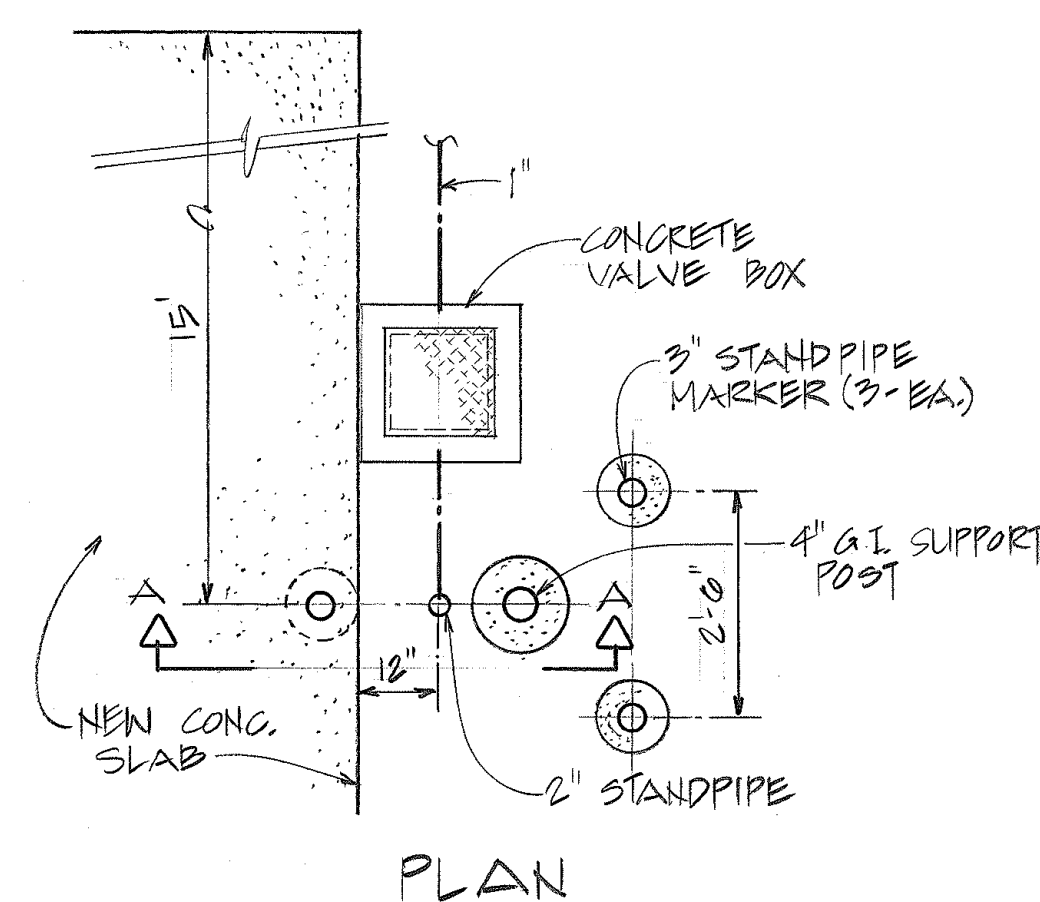
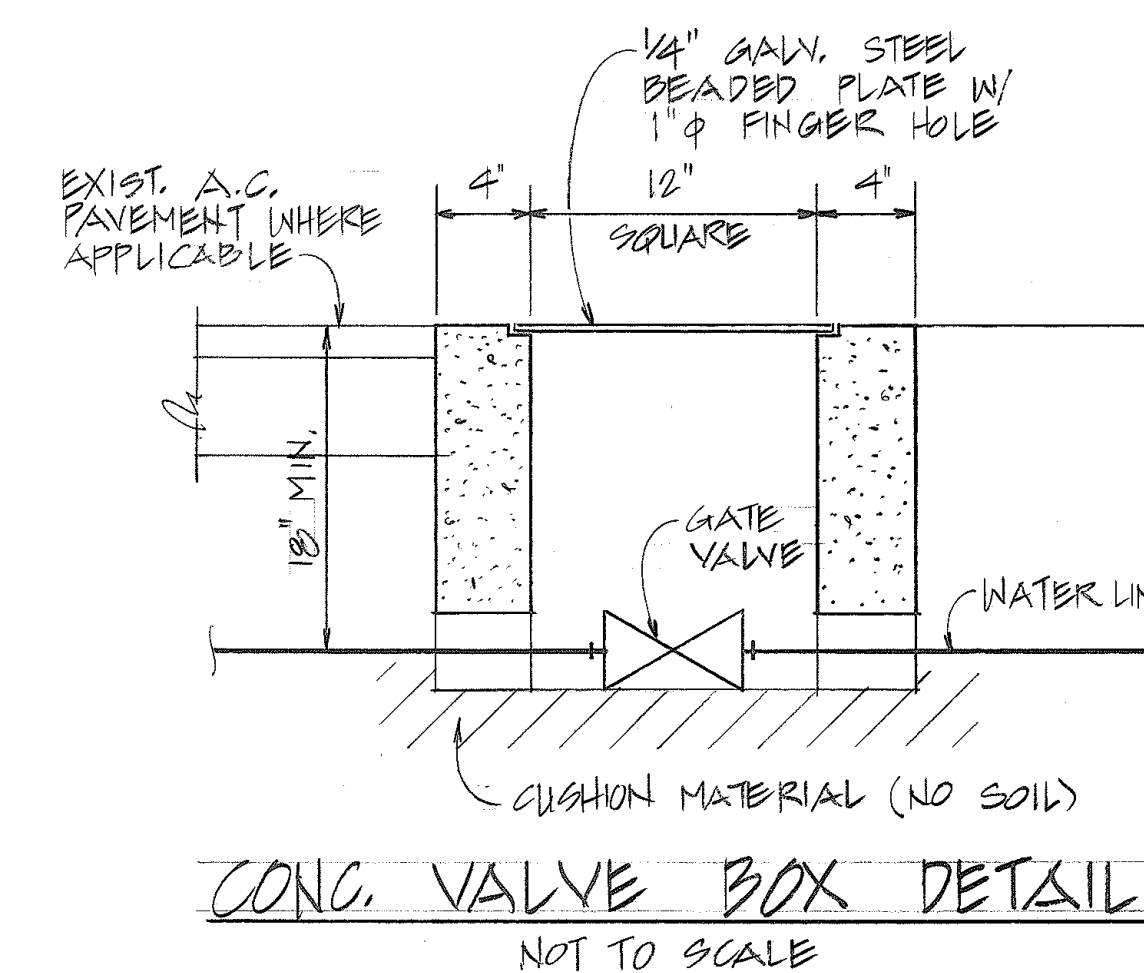
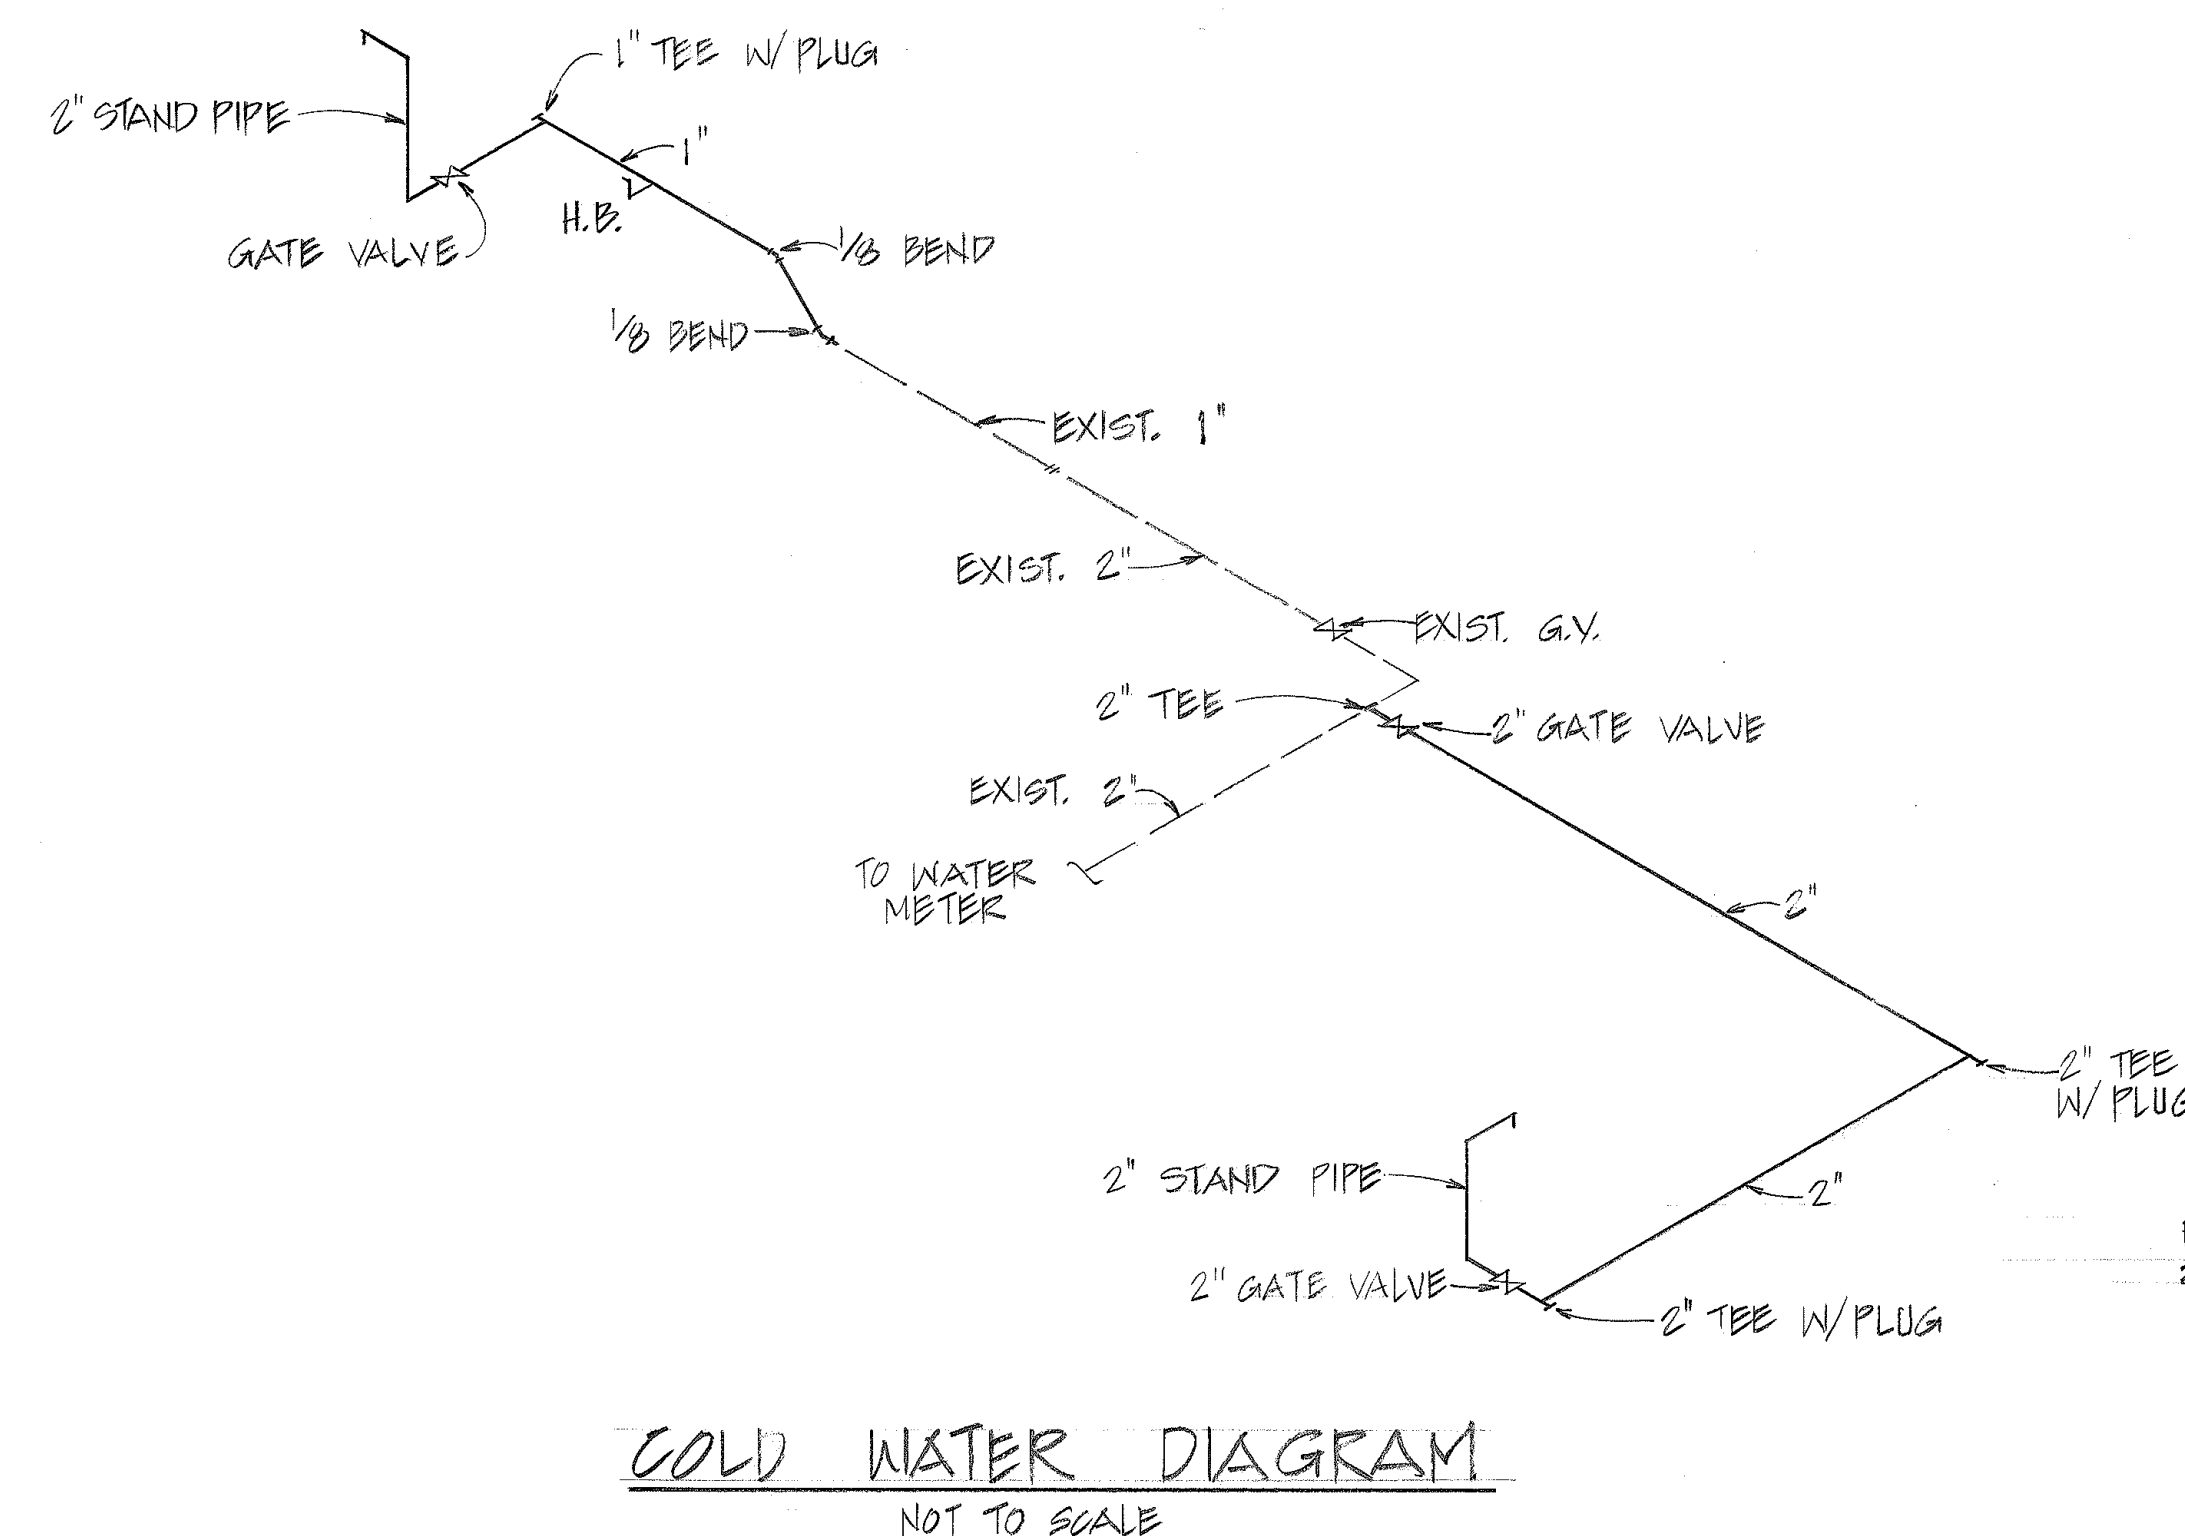


FED. ROAD DIST. NO.	STATE	PROJ. NO.	FISCAL YEAR	SHEET NO.	TOTAL SHEETS
HAWAII	HAW.	Hwy H-02-92M	1992	7	11

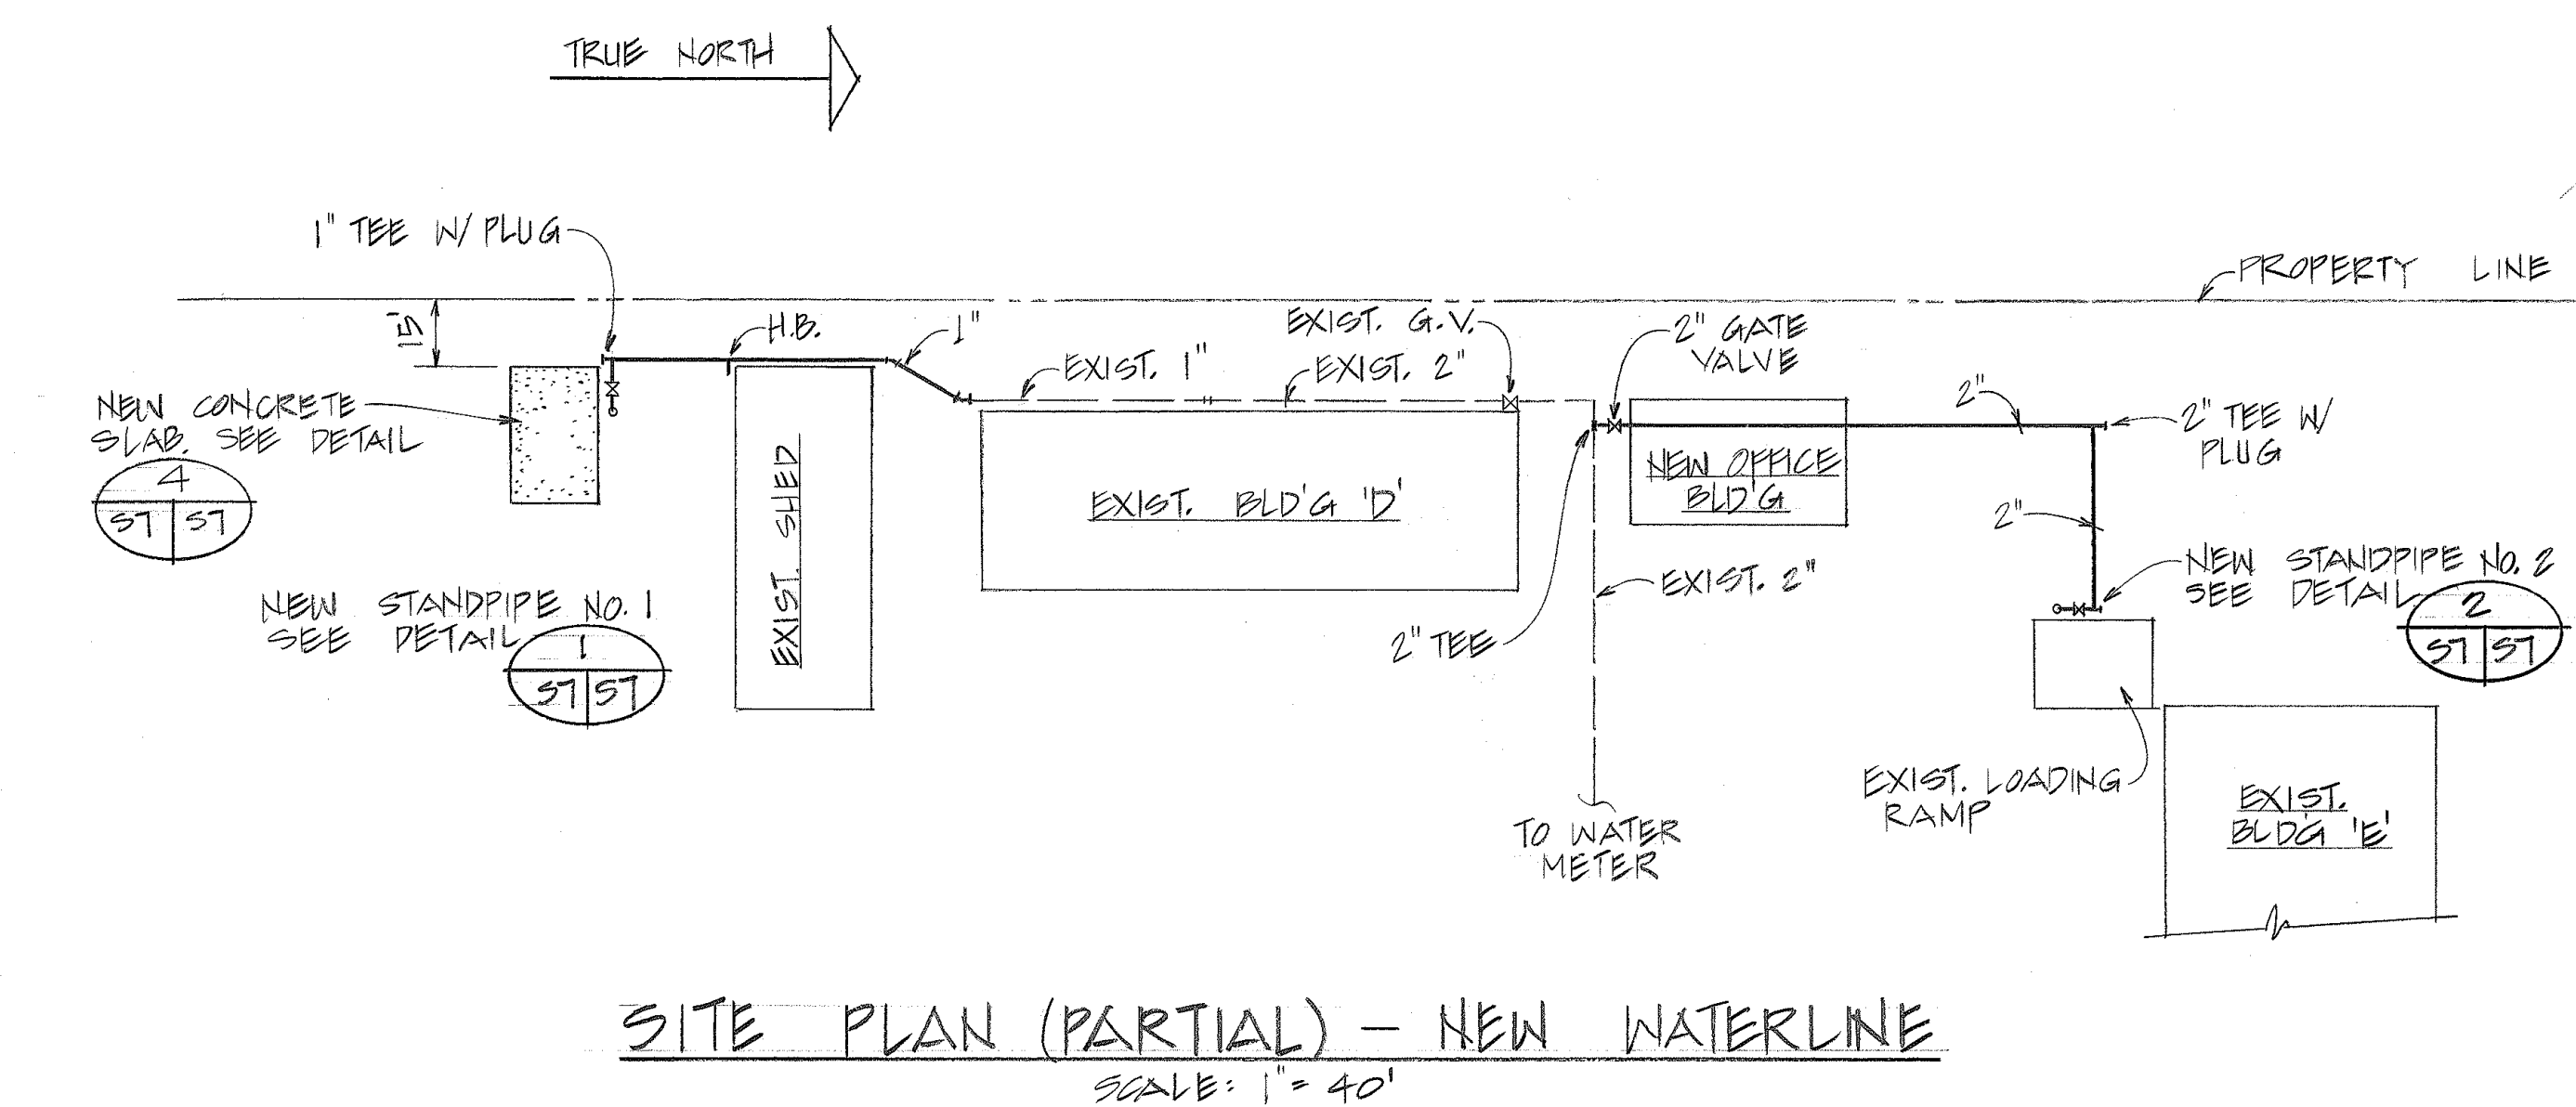

ORIGINAL PLAN	SURVEY PLOTTED BY _____ DATE _____
NOTE BOOK	DRAWN BY _____
	TRACED BY _____
	DESIGNED BY _____
	QUANTITIES BY _____
No. _____	CHECKED BY _____

STATE OF HAWAII
DEPARTMENT OF TRANSPORTATION
HIGHWAYS DIVISION

STANDPIPE & MISC. DETAILS

HILLO BASEYARD, BUILDING 'D'
OFFICE RENOVATION
PROJ. NO. HNY-H-02-92M

SCALE: AS NOTED DATE: APRIL 1992

SHEET No. | OF | SHEETS