	INDEX TO DRAWINGS
SHEET NO.	DESCRIPTION
	TITLE SHEET
2,3	BUILDING 'D' - PLANS & DETAILS
4 - 6	NEW OFFICE BUILDING PLANS & DETAILS
7	STAND PIPE & MISC. DETAILS
8	A/C LAYOUT & DETAILS
9-11	ELECTRICAL PLANS & DETAILS
C.C.O, 6A	NEW COVERED STORAGE AREA-PLANS
	& DETAILS
į.	
	1

STATE OF HAWAII

DEPARTMENT OF TRANSPORTATION


HIGHWAYS DIVISION HONOLULU, HAWAII

"AS-BUILT"

PLANS FOR

HILO BASEYARD, BUILDING "D" OFFICE RENOVATION PROJECT NO. HWY-H-02-92M

DISTRICT OF SOUTH HILO ISLAND OF HAWAII

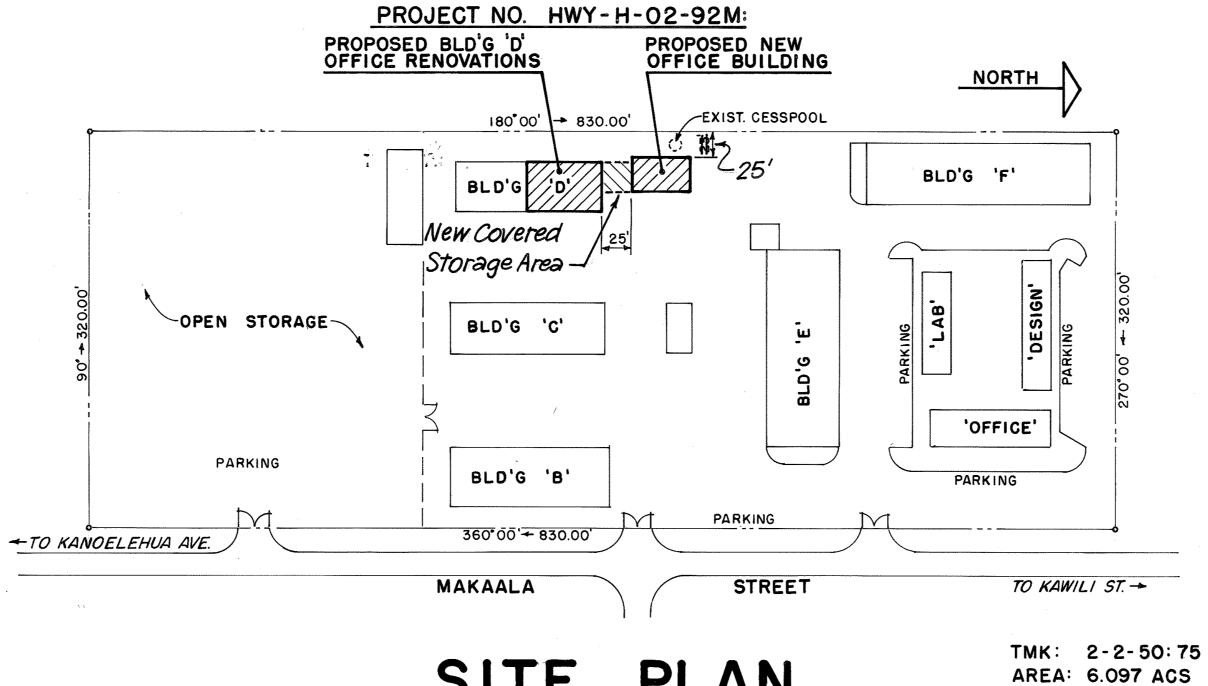

SITE PLAN



LOCATION OF PROJECT HILO BASEYARD SCALE IN MILES FEDERAL AID PROJECTS PREVIOUSLY CONSTRUCTED OR UNDER CONSTRUCTION ALL CHANGES MADE DURING CONSTRUCTION HAVE BEEN NOTED IN RED ON THESE TRACINGS AND CHECKED BY 3/21/96 PROJECT ENGINEER DATE

FED. ROAD DIST. NO.

STATE

PROJ. NO.

HWY-H-02-92M 1992

STATE OF HAWAII

DEPARTMENT OF TRANSPORTATION STATE OF HAWAII

5/27/92 DATE

APPROVED:

THE DIR. OF TRANSPORTATION

FISCAL SHEET TOTAL YEAR NO. SHEETS

MAY, 1992 DATE 587-2244 PHONE

A. NISHIMURA P. S. & E. BY HAWAII DISTRICT DESIGNED BY