



FED. ROAD DIST. NO.	STATE	FED. AID PROJ. NO.	FISCAL YEAR	SHEET NO.	TOTAL SHEETS
HAWAII	HAW.	HWY-H-02-93M	1993	3	6

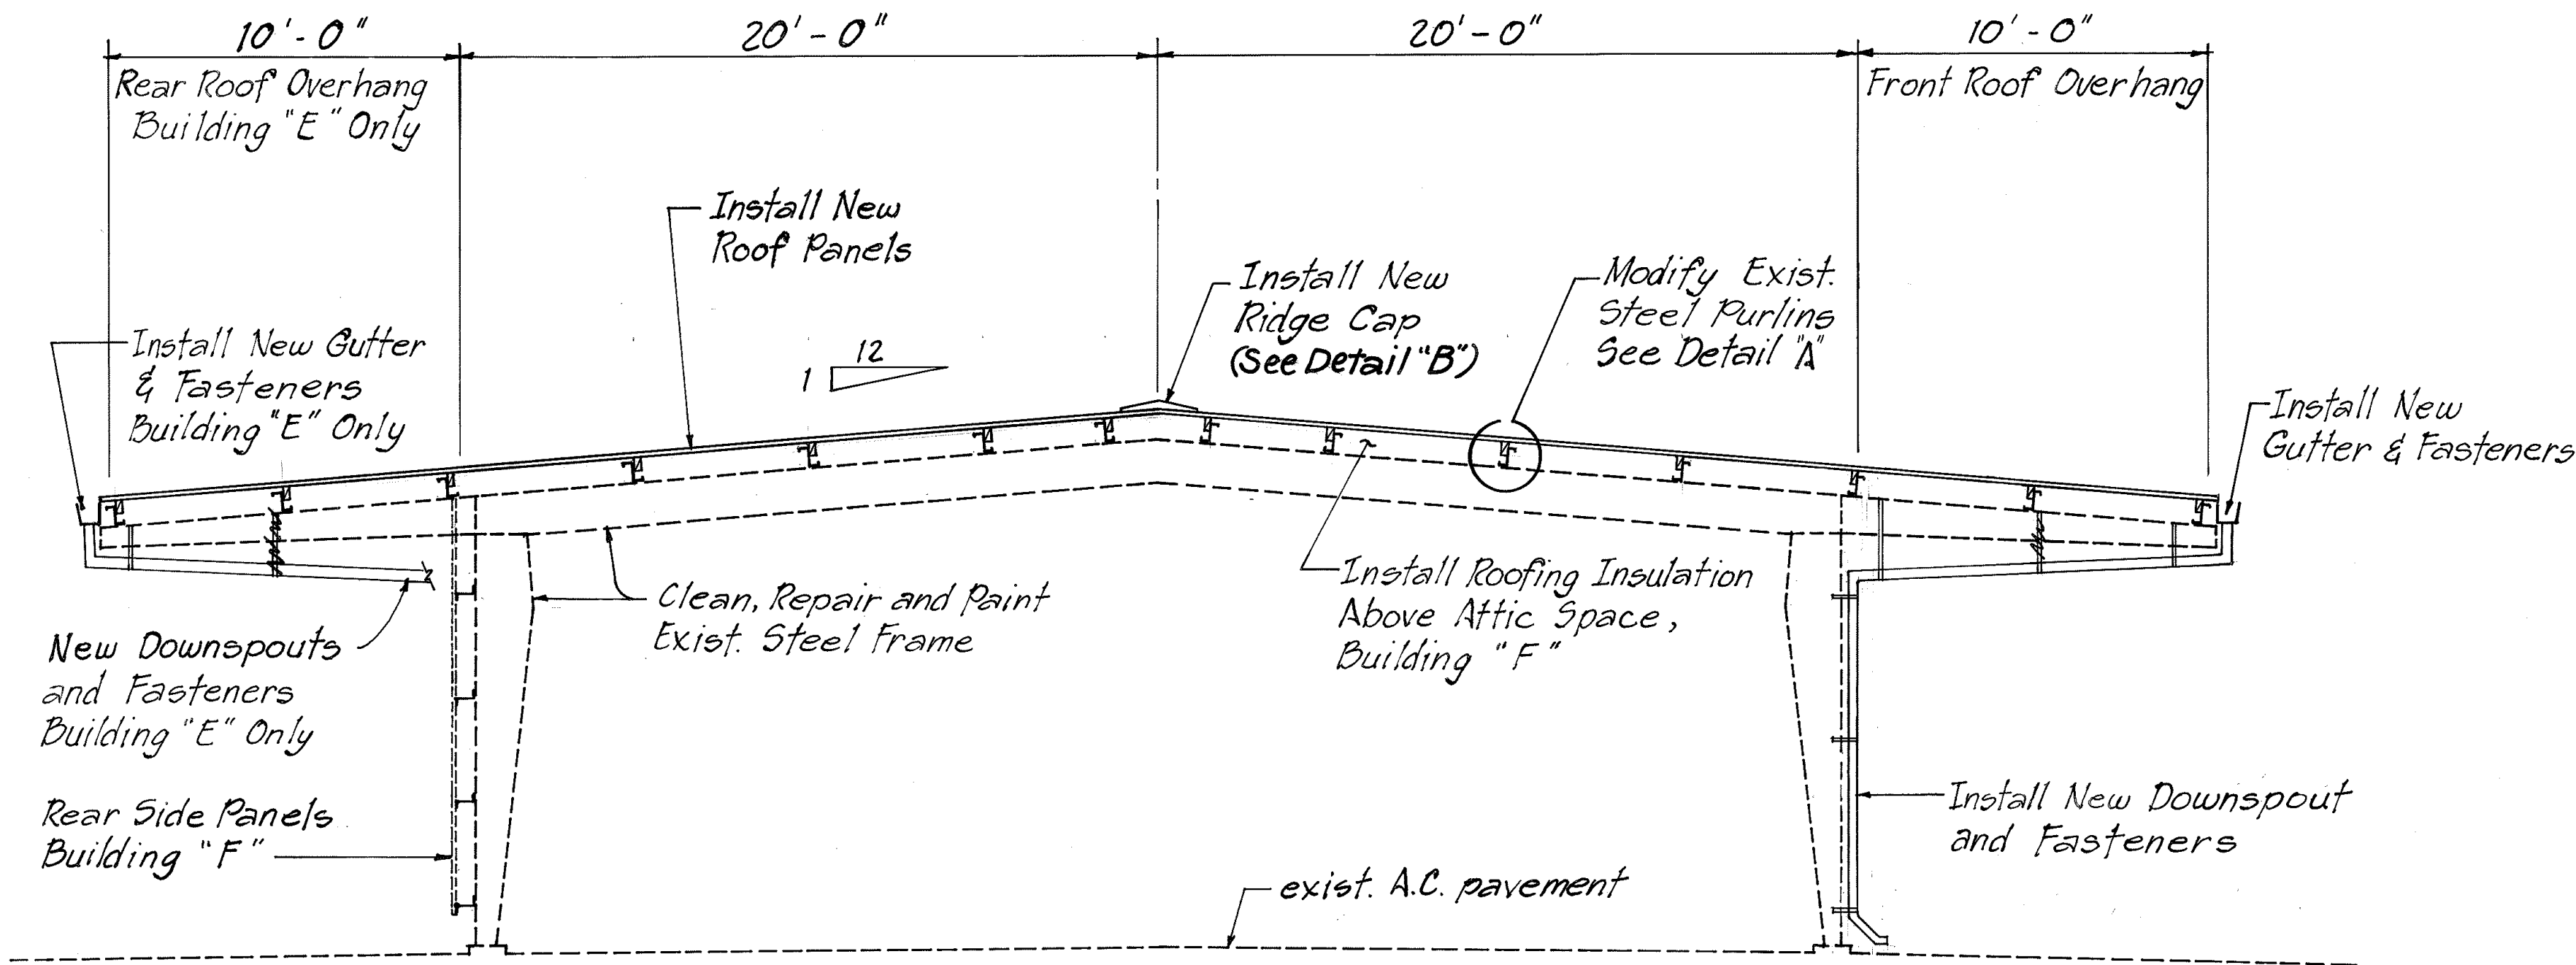

TYPICAL SECTION for BUILDINGS "E" & "F"

Not To Scale

Note:
Clean and Repair Side Panels.
Paint Exterior Surfaces of all Side Panels.
Replace All Damaged Flashing

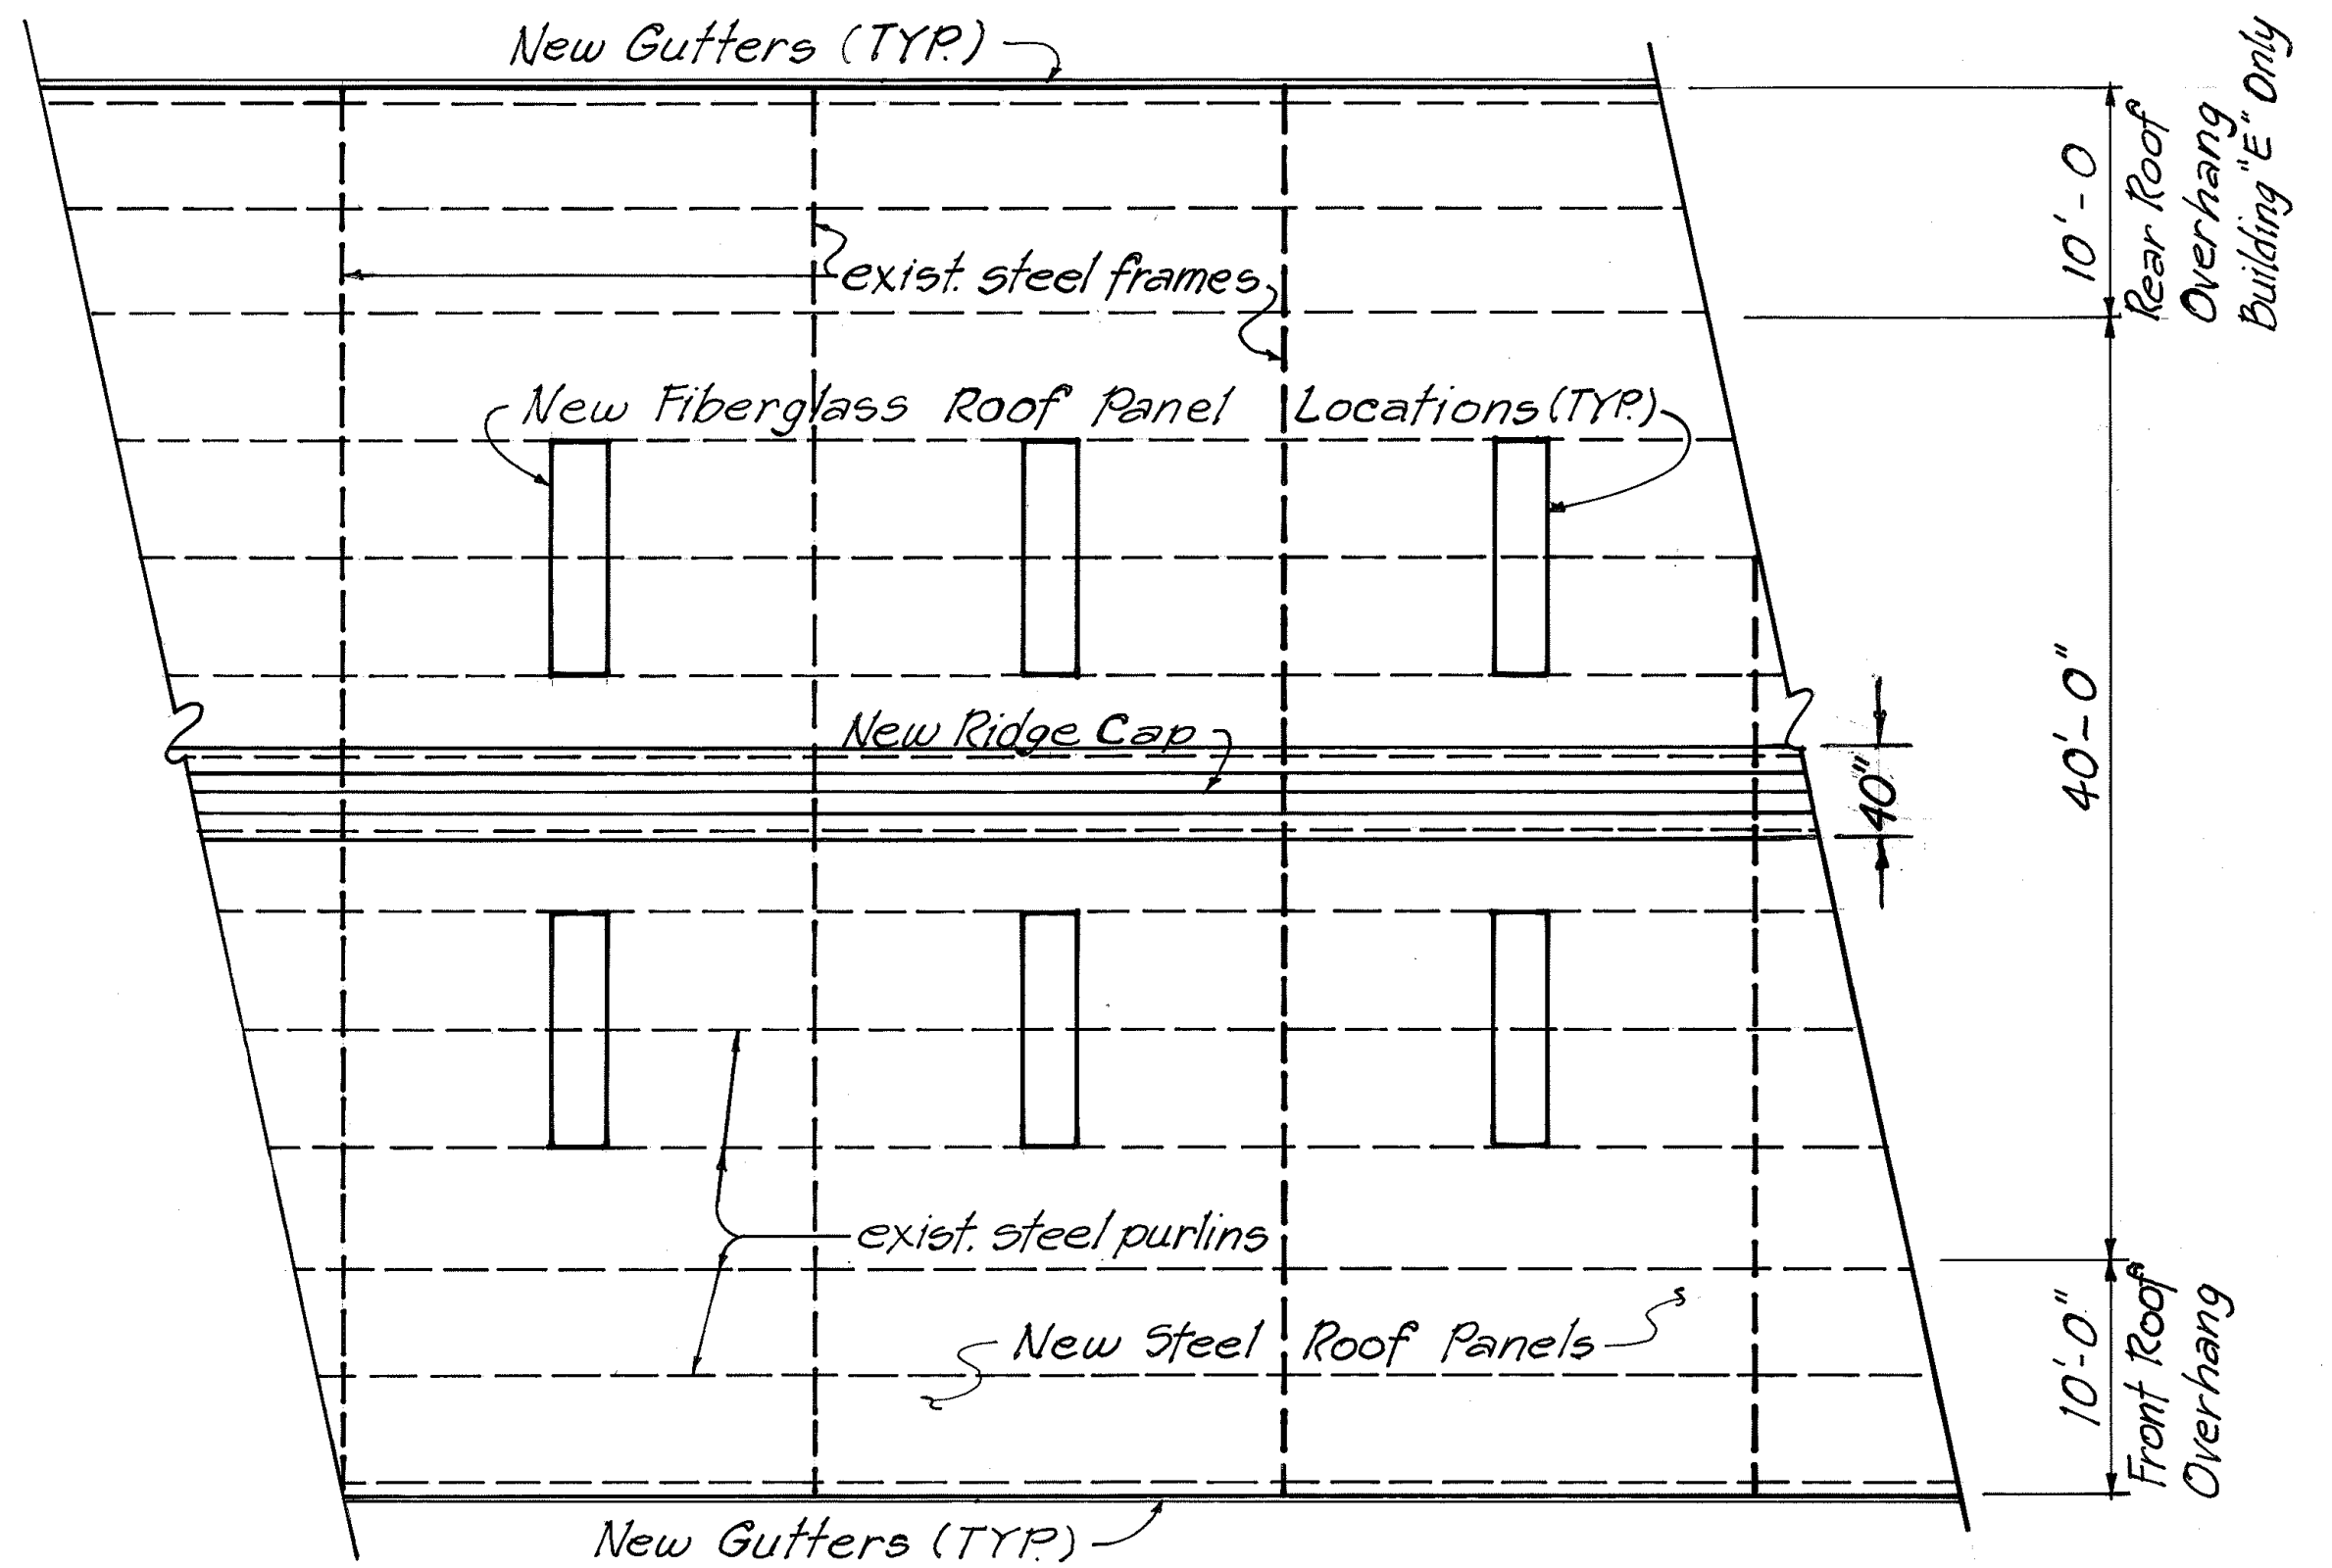



PARTIAL ROOF PLAN

Not To Scale


Note:
No Rear Roof Overhang, Building "F".
Do Not Install Gutters on Rear of Building "F".

NOTES:

- For Materials and Construction Details Refer to Special Provisions Section 606.
- Subject to the approval of the Engineer, minor adjustments may be made to the locations of the fiberglass panels to suit the sizes of available roofing panels.
- Roof panel laps to be 24" minimum.
- Roof panels to be one continuous sheet from ridge to gutters except where necessary to install fiberglass panels.
- All corrosion damage uncovered by the contractor during roofing removal shall be reported to the Engineer. Details for repair to be submitted to the Engineer for review and approval prior to repair.
- Purlin modifications to be made without changing existing pitch of roof.

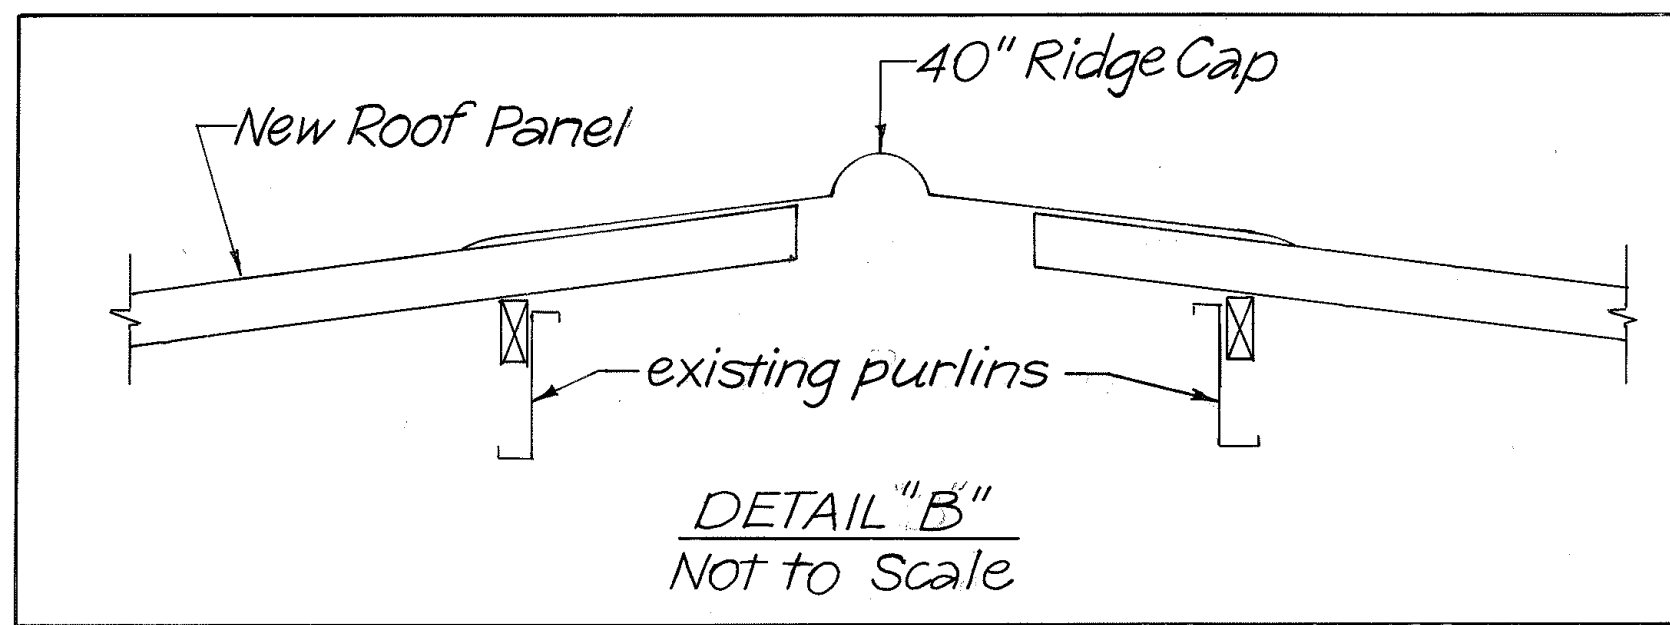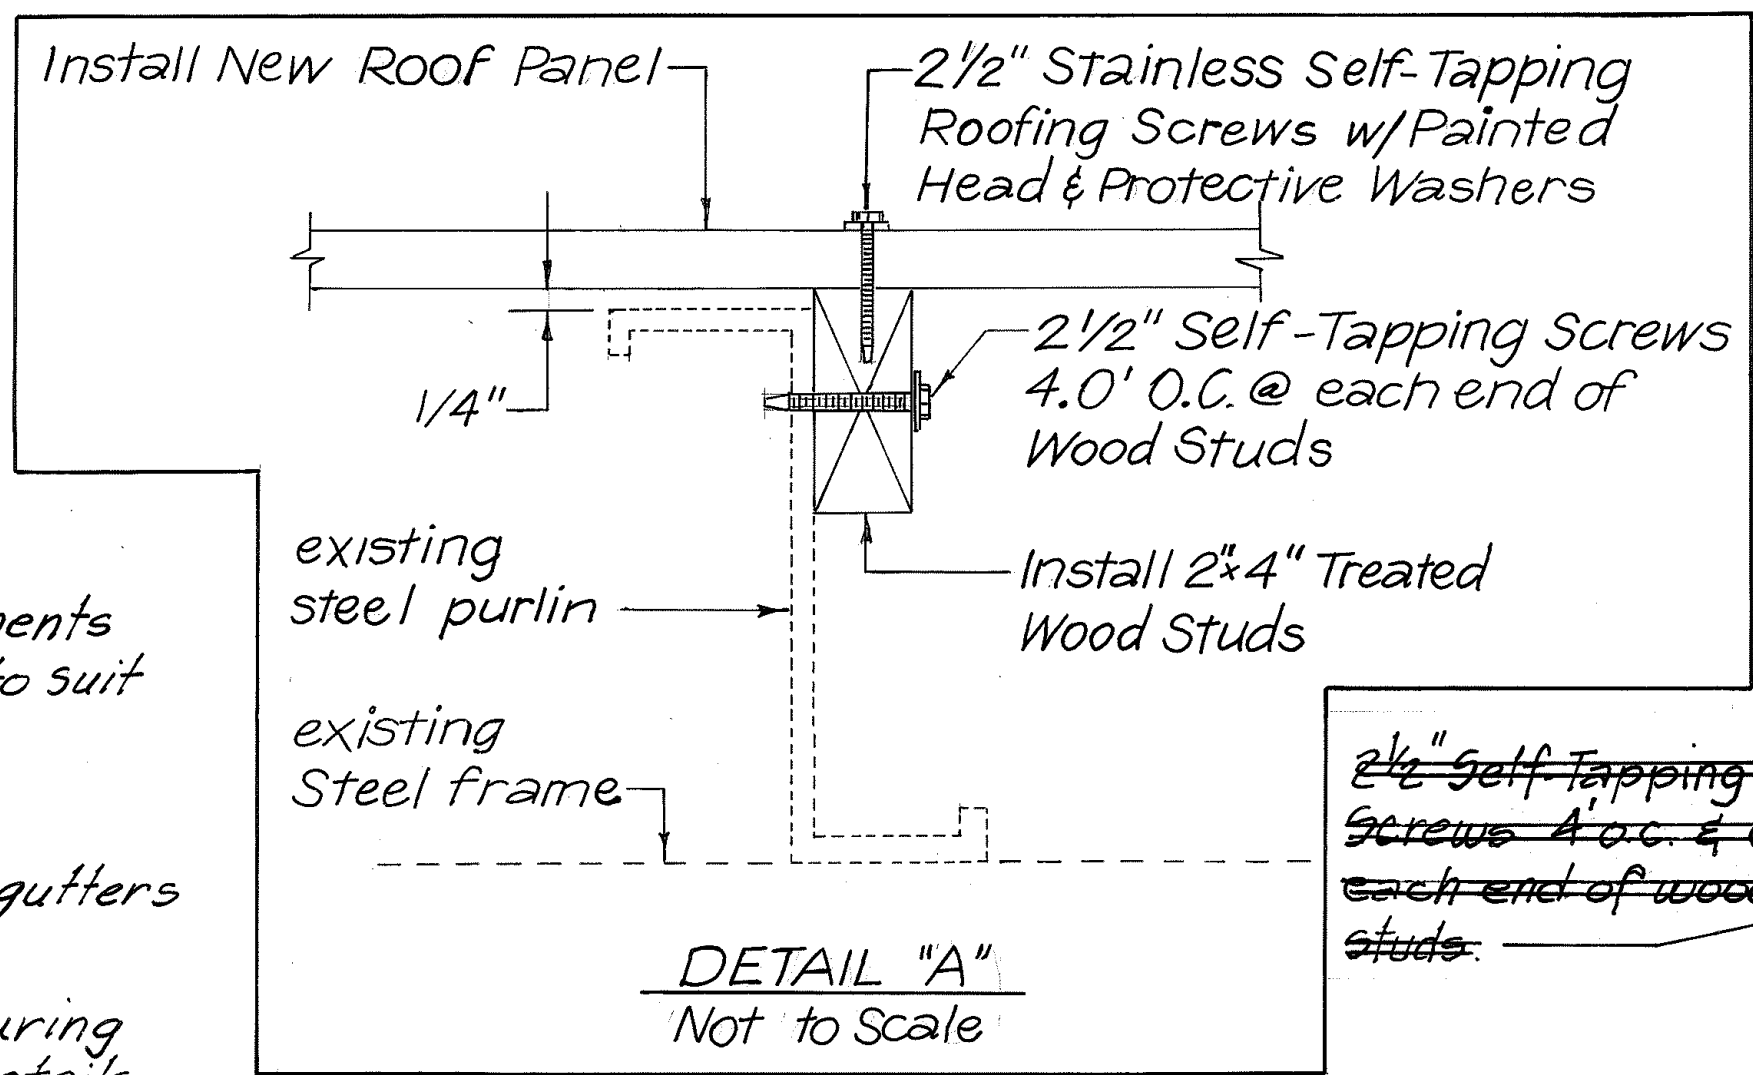

Ridge Cap Detail - Building "F"

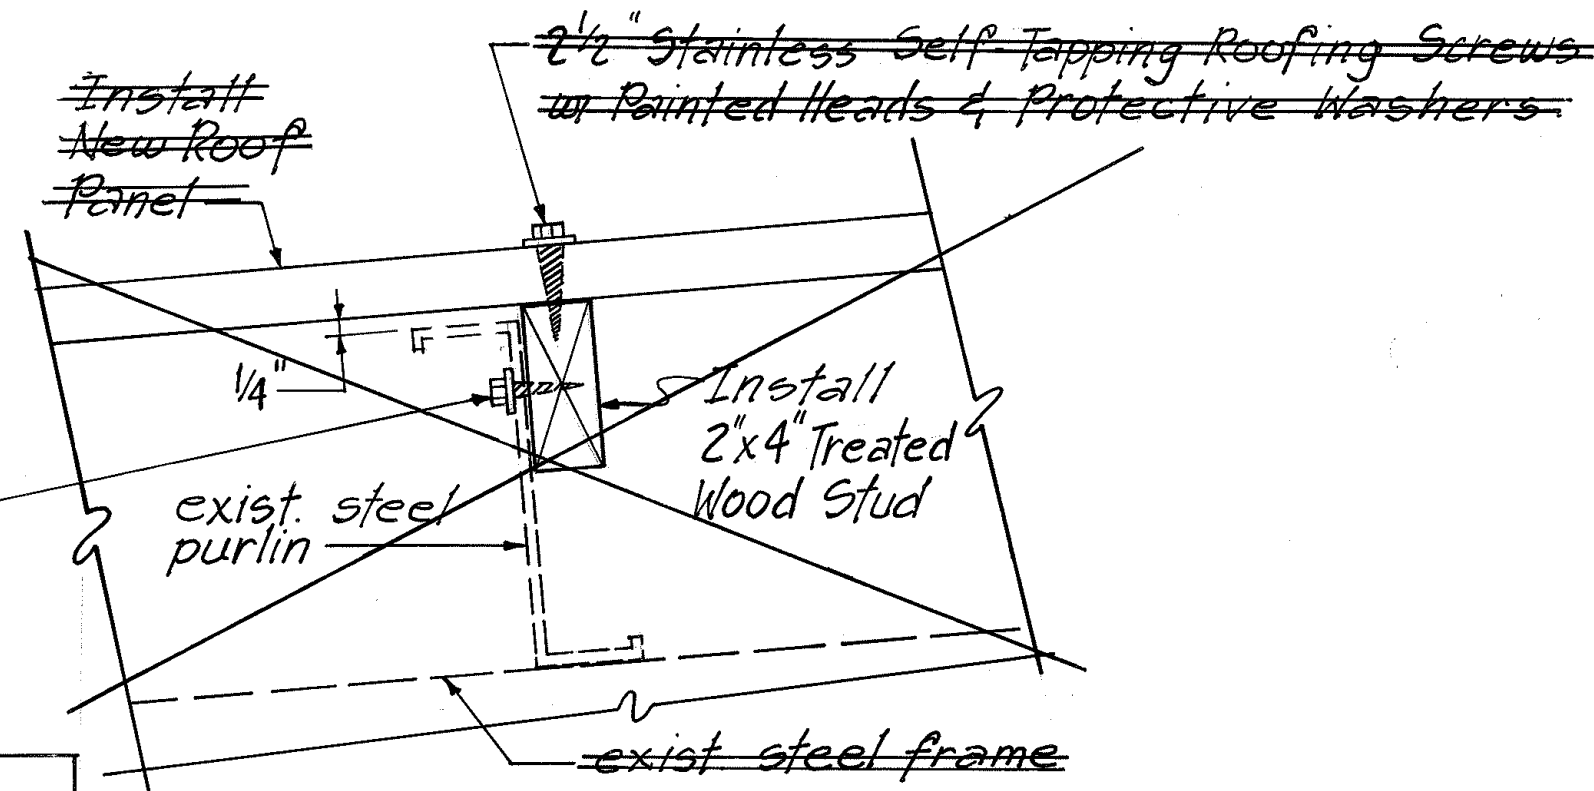

STATE OF HAWAII DEPARTMENT OF TRANSPORTATION HIGHWAYS DIVISION
TYPICAL SECTION, ROOF PLAN AND DETAILS
BASEYARD IMPROVEMENTS OF MAINTENANCE BUILDINGS, HILO BASEYARD PROJ. NO. HWY-H-02-93M
Scale: As Noted Date: May 1993
SHEET NO. 1 OF 1 SHEETS

SURVEY PLOTTED BY	DATE
DRAWN BY	
DESIGNED BY	
QUANTITIES BY	
CHECKED BY	
ORIGINAL PLAN	
NOTE BOOK	
NO.	