

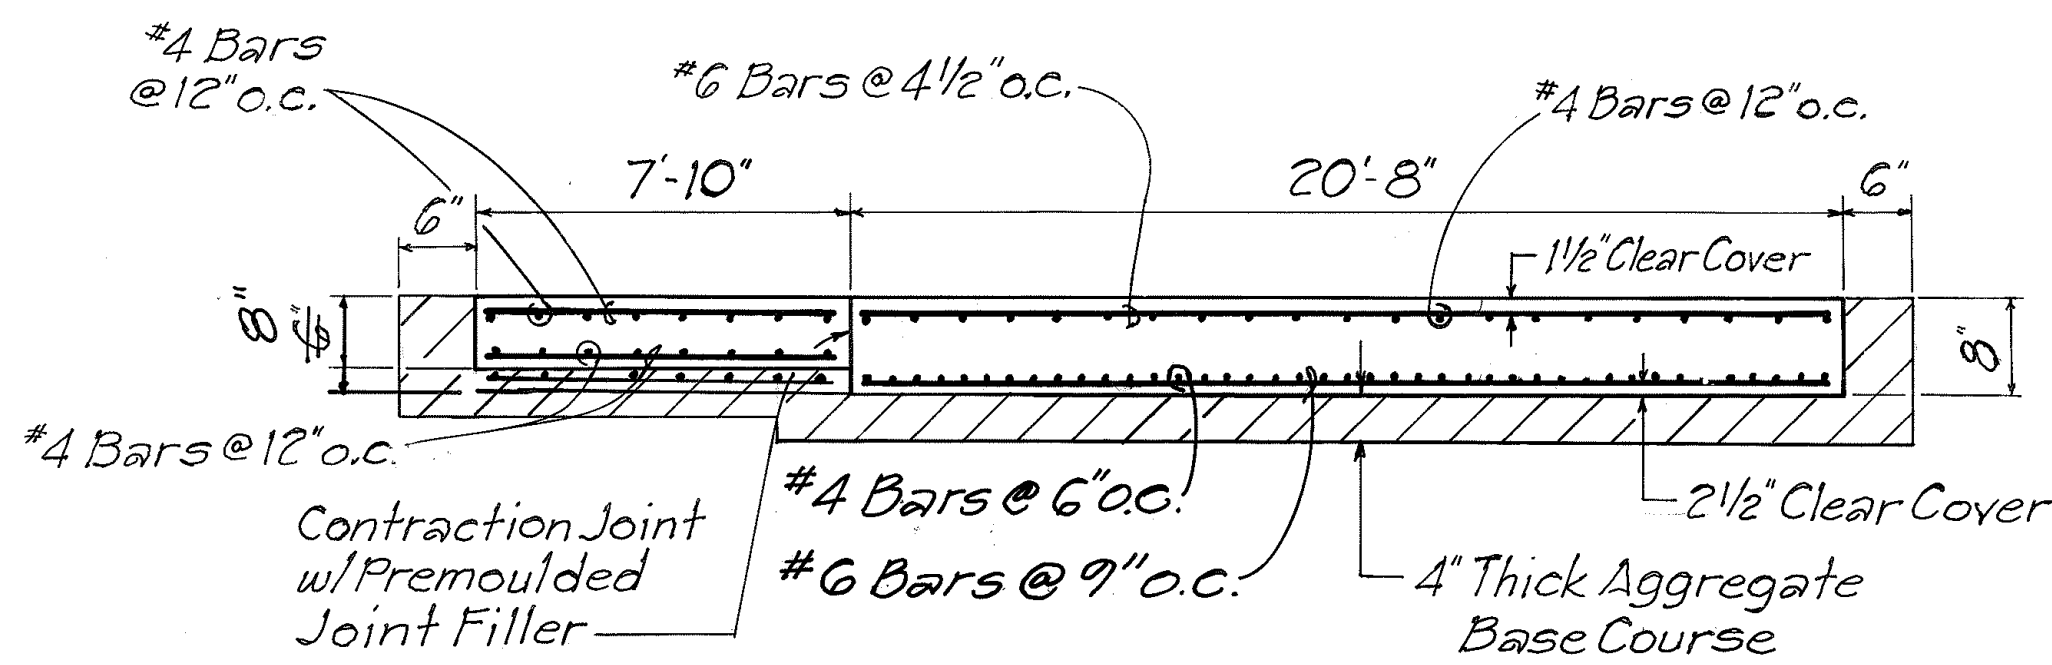
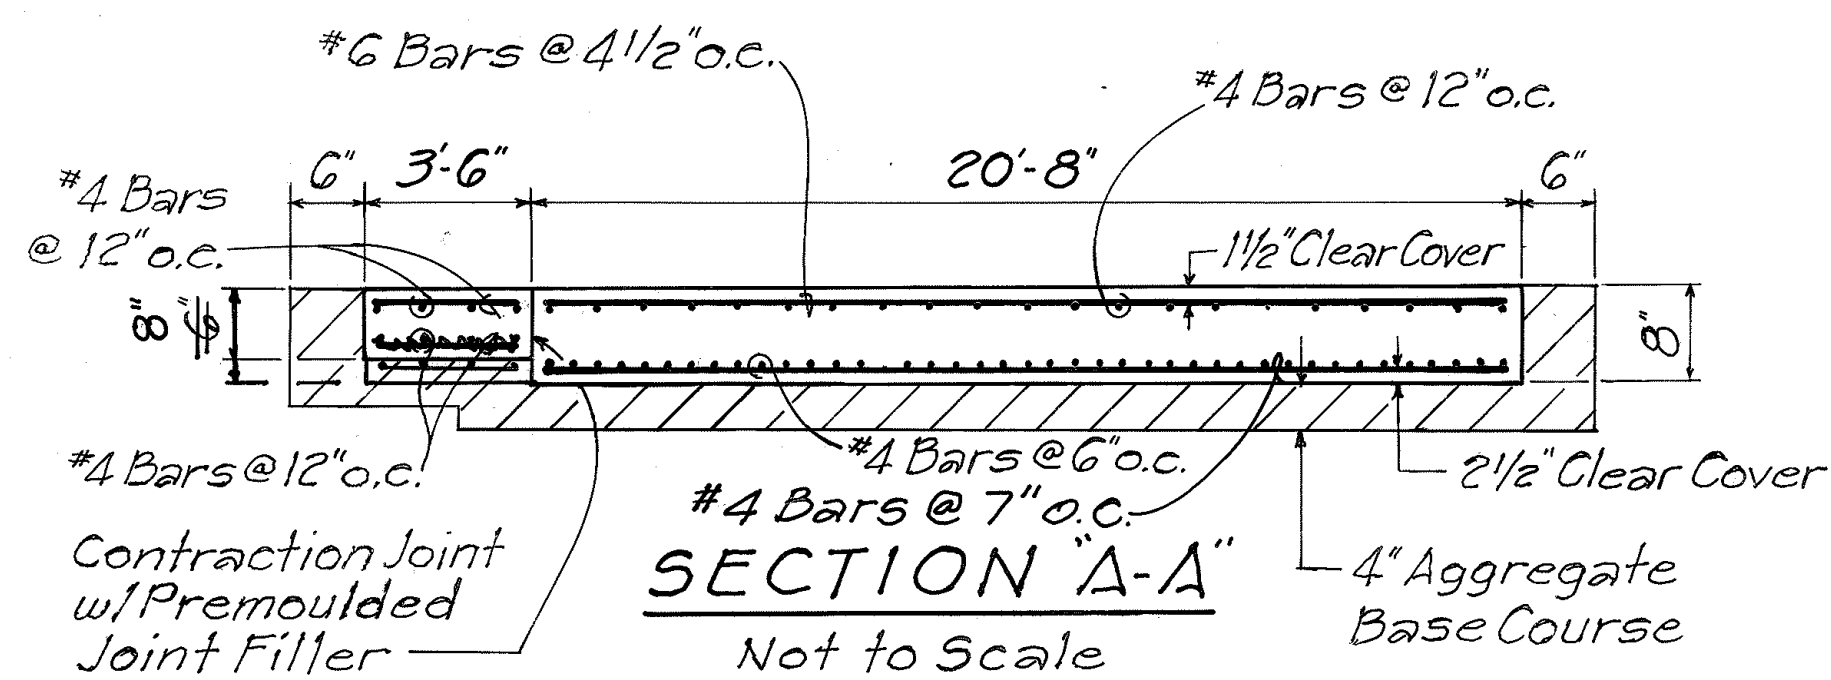
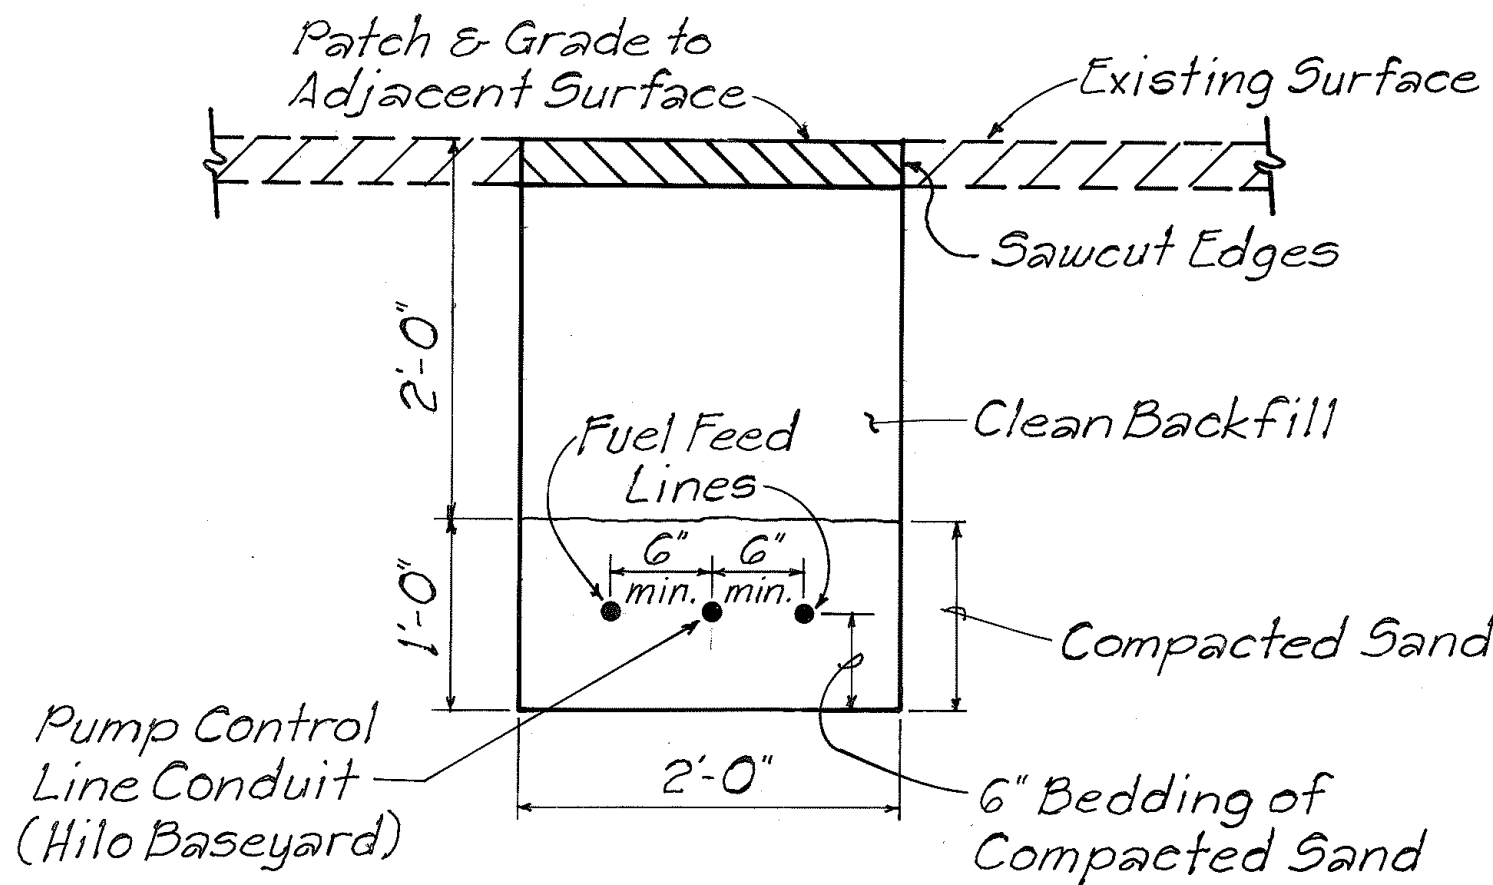


FED. ROAD DIST. NO.	STATE	PROJ. NO.	FISCAL YEAR	SHEET NO.	TOTAL SHEETS
HAWAII	HAW.	HWY-H-01-23M	1993	7	8

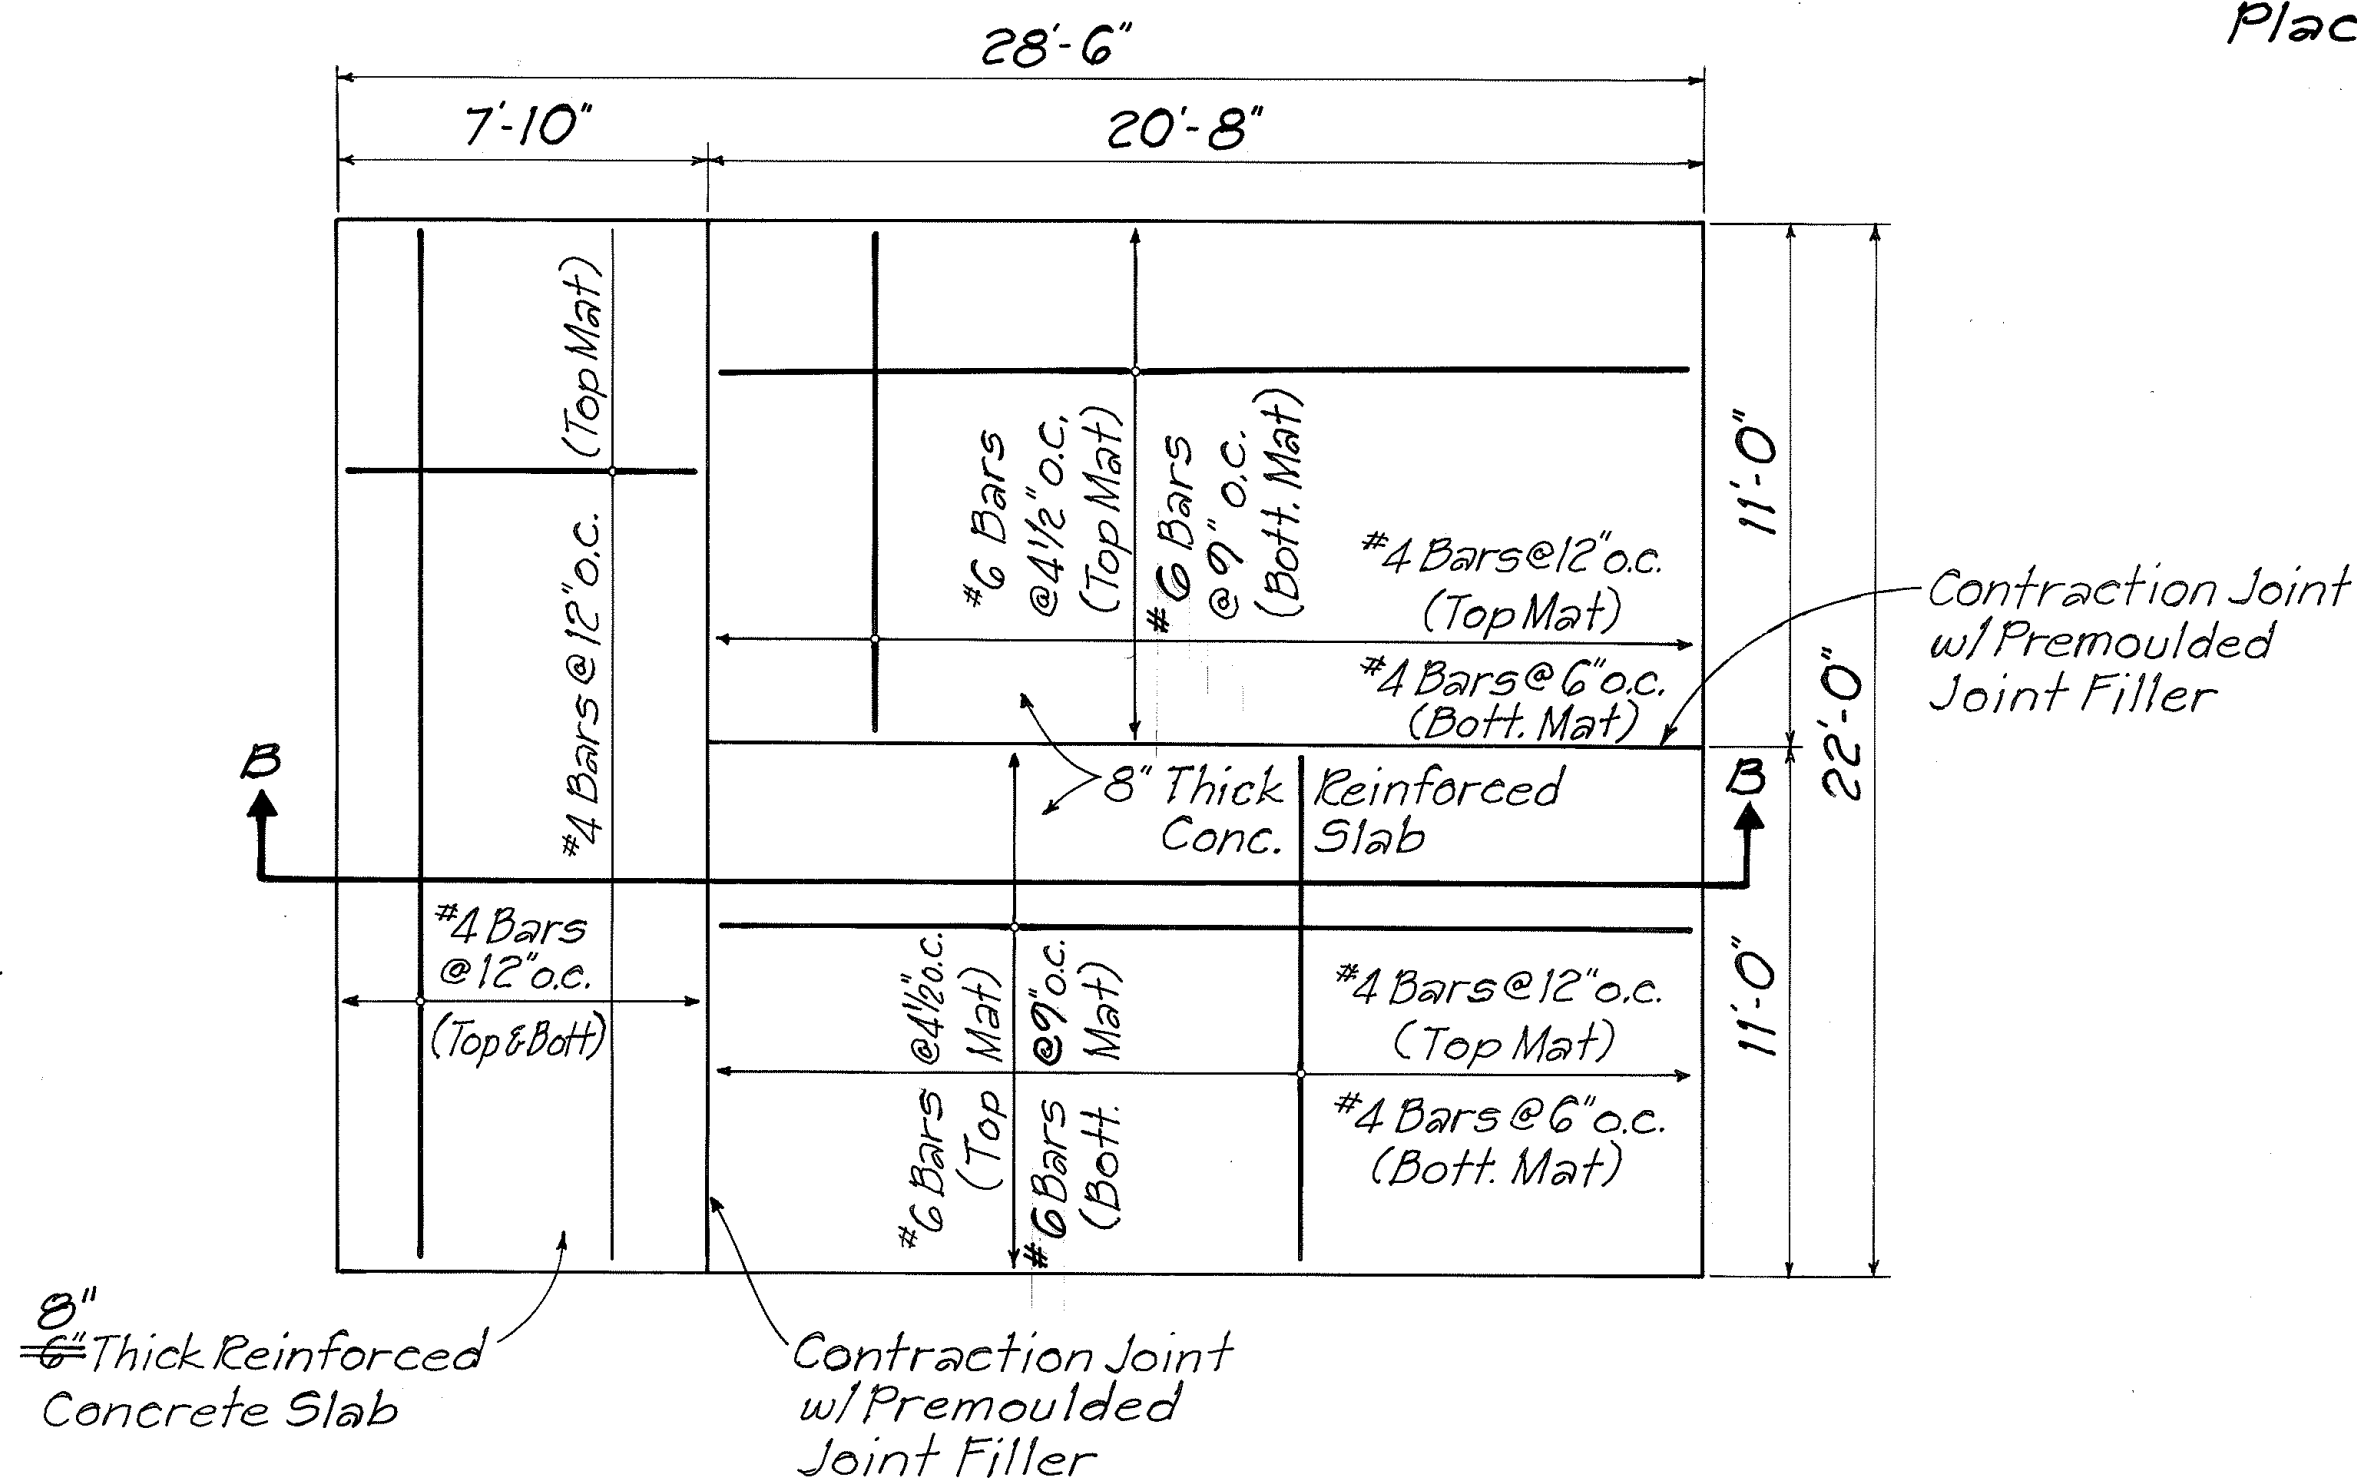

SLAB NOTES:

All concrete to have 28 days compressive strength of 3,000 psi. Reinforcing steel shall comply with ASTM A615 Grade 60 or ASTM A706 Grade 60. Bar bending and placement shall comply with the latest ACI Standards. Equivalent Area $F_y = 65,000$ psi ASTM A185 or A497 Reinforcing Cages may be utilized in lieu of Grade 60 Reinforcing Bars. Contractor to Provide Shop Drawings for Approval Prior to Placing and Pouring Reinforced Concrete Slab. Contractor shall Prepare and Compact Subgrade Prior to Placing 4" thick Aggregate Base Course.

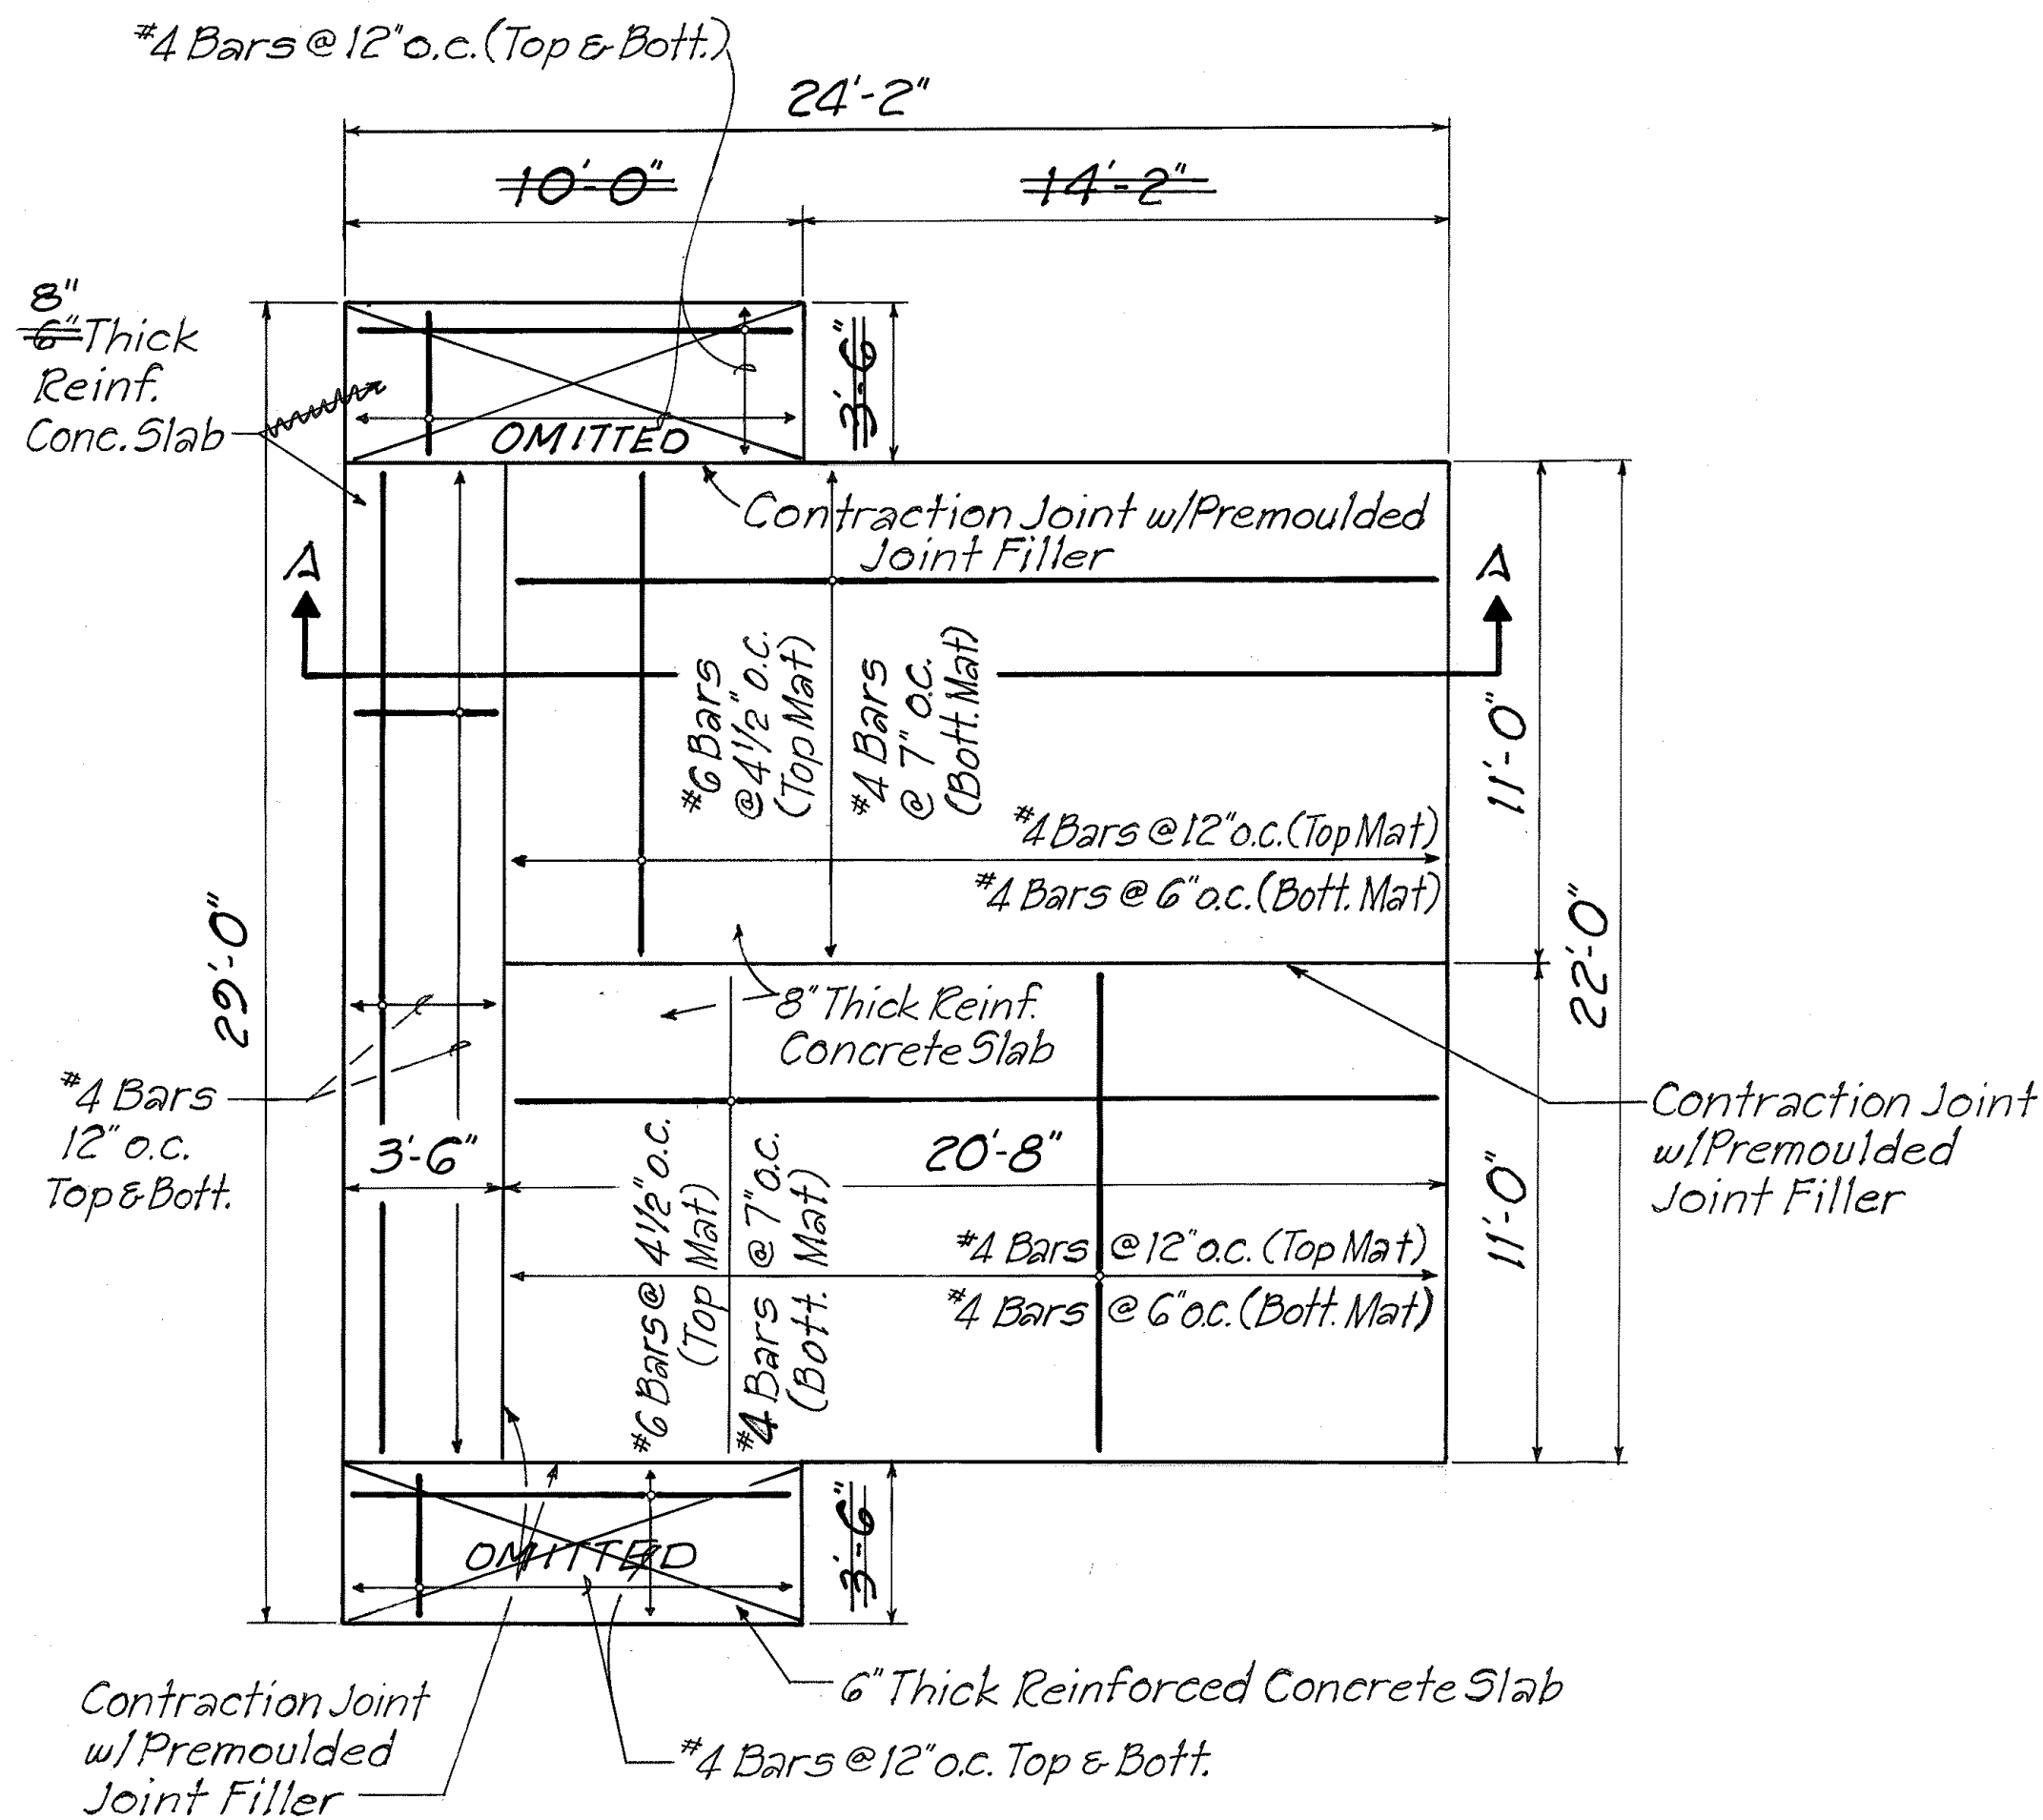

FUEL PIPE TRENCH DETAILS

Not to Scale

NOTE:

Trench to be Excavated with Sawcutting of Existing Surface. Trench to be Backfilled in 6" Lifts Compacted to 95% Maximum Density.

SLAB REINFORCING PLAN

WAIMEA BASEYARD

Not to Scale

SLAB REINFORCING PLAN

HILO BASEYARD

Not to Scale

STATE OF HAWAII
DEPARTMENT OF TRANSPORTATION
HIGHWAYS DIVISION

SLAB DETAILS
HILO AND WAIMEA BASEYARD
PROJ. No. HWY-H-01-23M

Scale: As Noted Date: March 1993
SHEET No. 1 OF 2 SHEETS

SURVEY PLOTTED BY	DATE
DRAWN BY	
DESIGNED BY	
QUANTITIES BY	
CHECKED BY	
ORIGINAL PLAN	
NOTE BOOK	
No.	