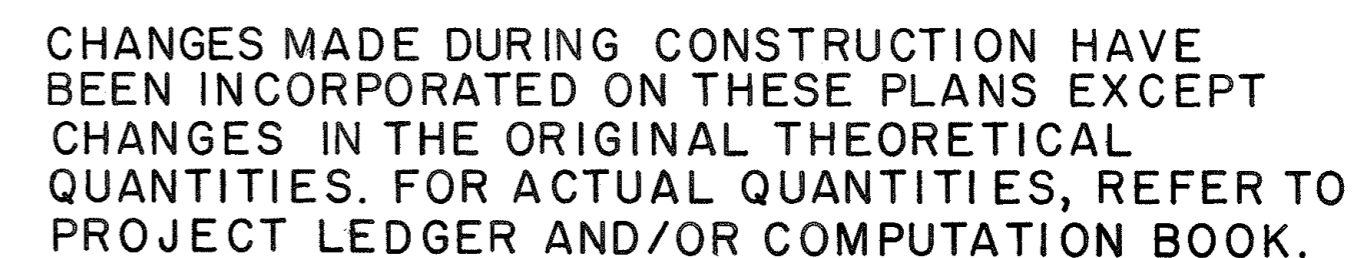


A map of the State of Hawaii showing the locations of the islands of Nihoa, Kauai, Oahu, Molokai, Lanai, Maui, and Hawaii. The map includes latitude and longitude markings and a north arrow.

HONOLULU, HAWAII

REMOVE AND REPLACE FUEL DISPENSING SYSTEMS

DISTRICT OF SOUTH HILO AND SOUTH KOHALA
ISLAND OF HAWAII

5/10/96
DATE

DEPARTMENT OF TRANSPORTATION STATE OF HAWAII	
APPROVED:	
<i>A. L. L. L.</i>	5/14/93
FOR DIR. OF TRANSPORTATION	DATE