
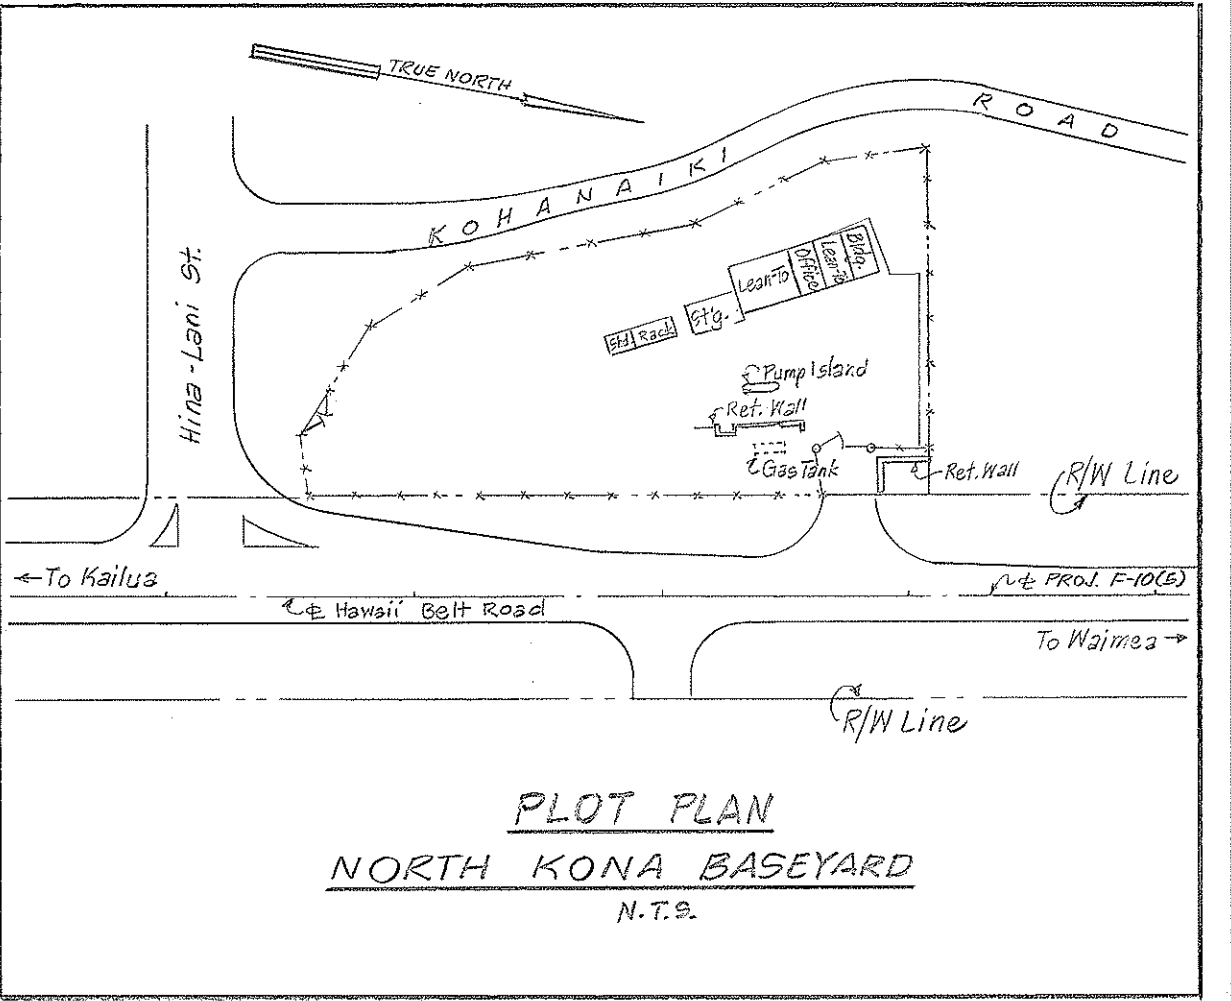


FED. ROAD DIST. NO.	STATE	PROJ. NO.	FISCAL YEAR	SHEET NO.	TOTAL SHEETS
HAWAII	HAW.	HWY-H-04-94M	1994	4	8

- NOTES:
1. All removal and installation notes are applicable whether or not referenced from this plan.
 2. For removal notes see Sheet Nos. 3&5.
 3. For installation notes see Sheet Nos. 3&6.

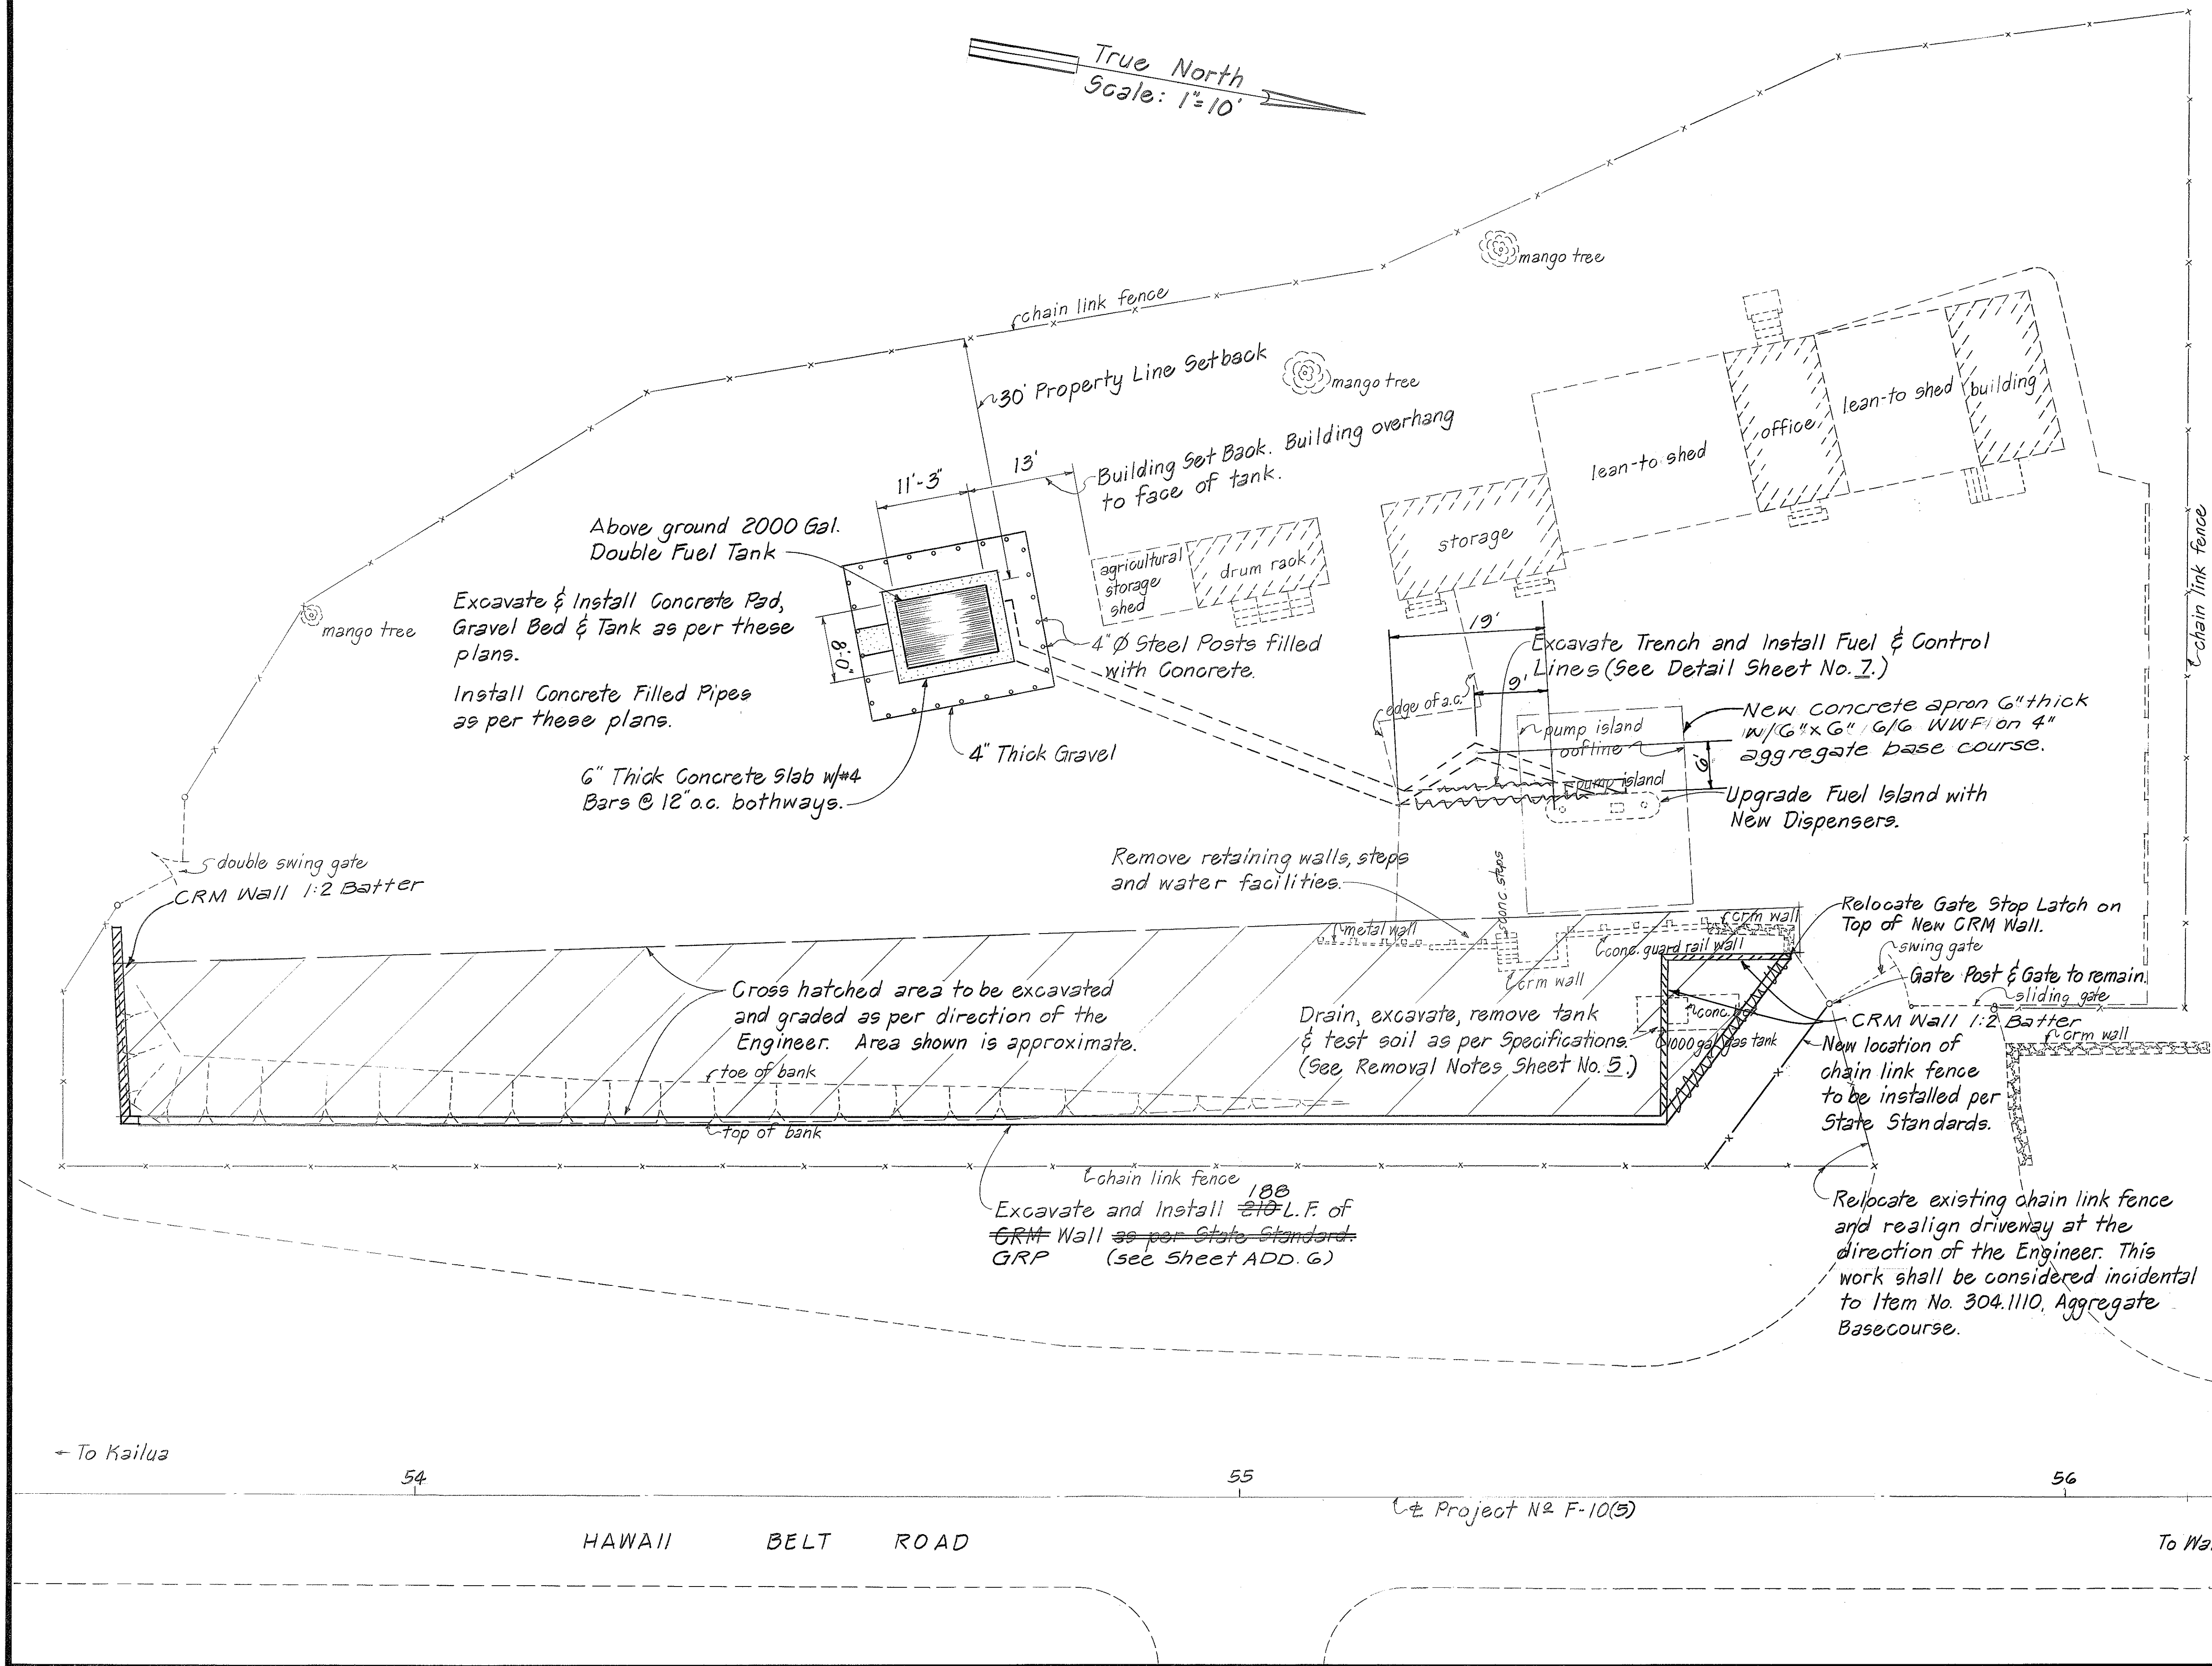

DATE	_____
SURVEY PLOTTED BY	_____
DRAWN BY	_____
DESIGNED BY	_____
CHECKED BY	_____
NOTE BOOK	_____
NO.	_____

STATE OF HAWAII
DEPARTMENT OF TRANSPORTATION
HIGHWAYS DIVISION

**REMOVAL/REPLACEMENT
RELOCATION & GRADING PLAN**

REMOVE & REPLACE FUEL DISPENSING
SYSTEM-NORTH KONA BASEYARD
PROJECT NO. HWY-H-04-94M

Scale: 1"=10' Date: May 1994

SHEET NO. 1 OF 1 SHEETS