

DD-C-1-9

INDEX TO DRAWINGS	
SHEET NO.	DESCRIPTION
1	TITLE SHEET
2	GENERAL NOTES


Sht. Nos. 2S-1 & 2S-2 are supplementary sheets to this project. Total sheet count after "As-Built" postings: 4 sheets.

STATE OF HAWAII
DEPARTMENT OF TRANSPORTATION
HIGHWAYS DIVISION
HONOLULU, HAWAII


"AS-BUILT"
PLANS FOR

HILO BASEYARD - OFFICE, DRAFTING AND
LABORATORY BUILDINGS AIR CONDITIONING
PROJECT NO. HWY-H-01-88M

DISTRICT OF SOUTH HILO
ISLAND OF HAWAII

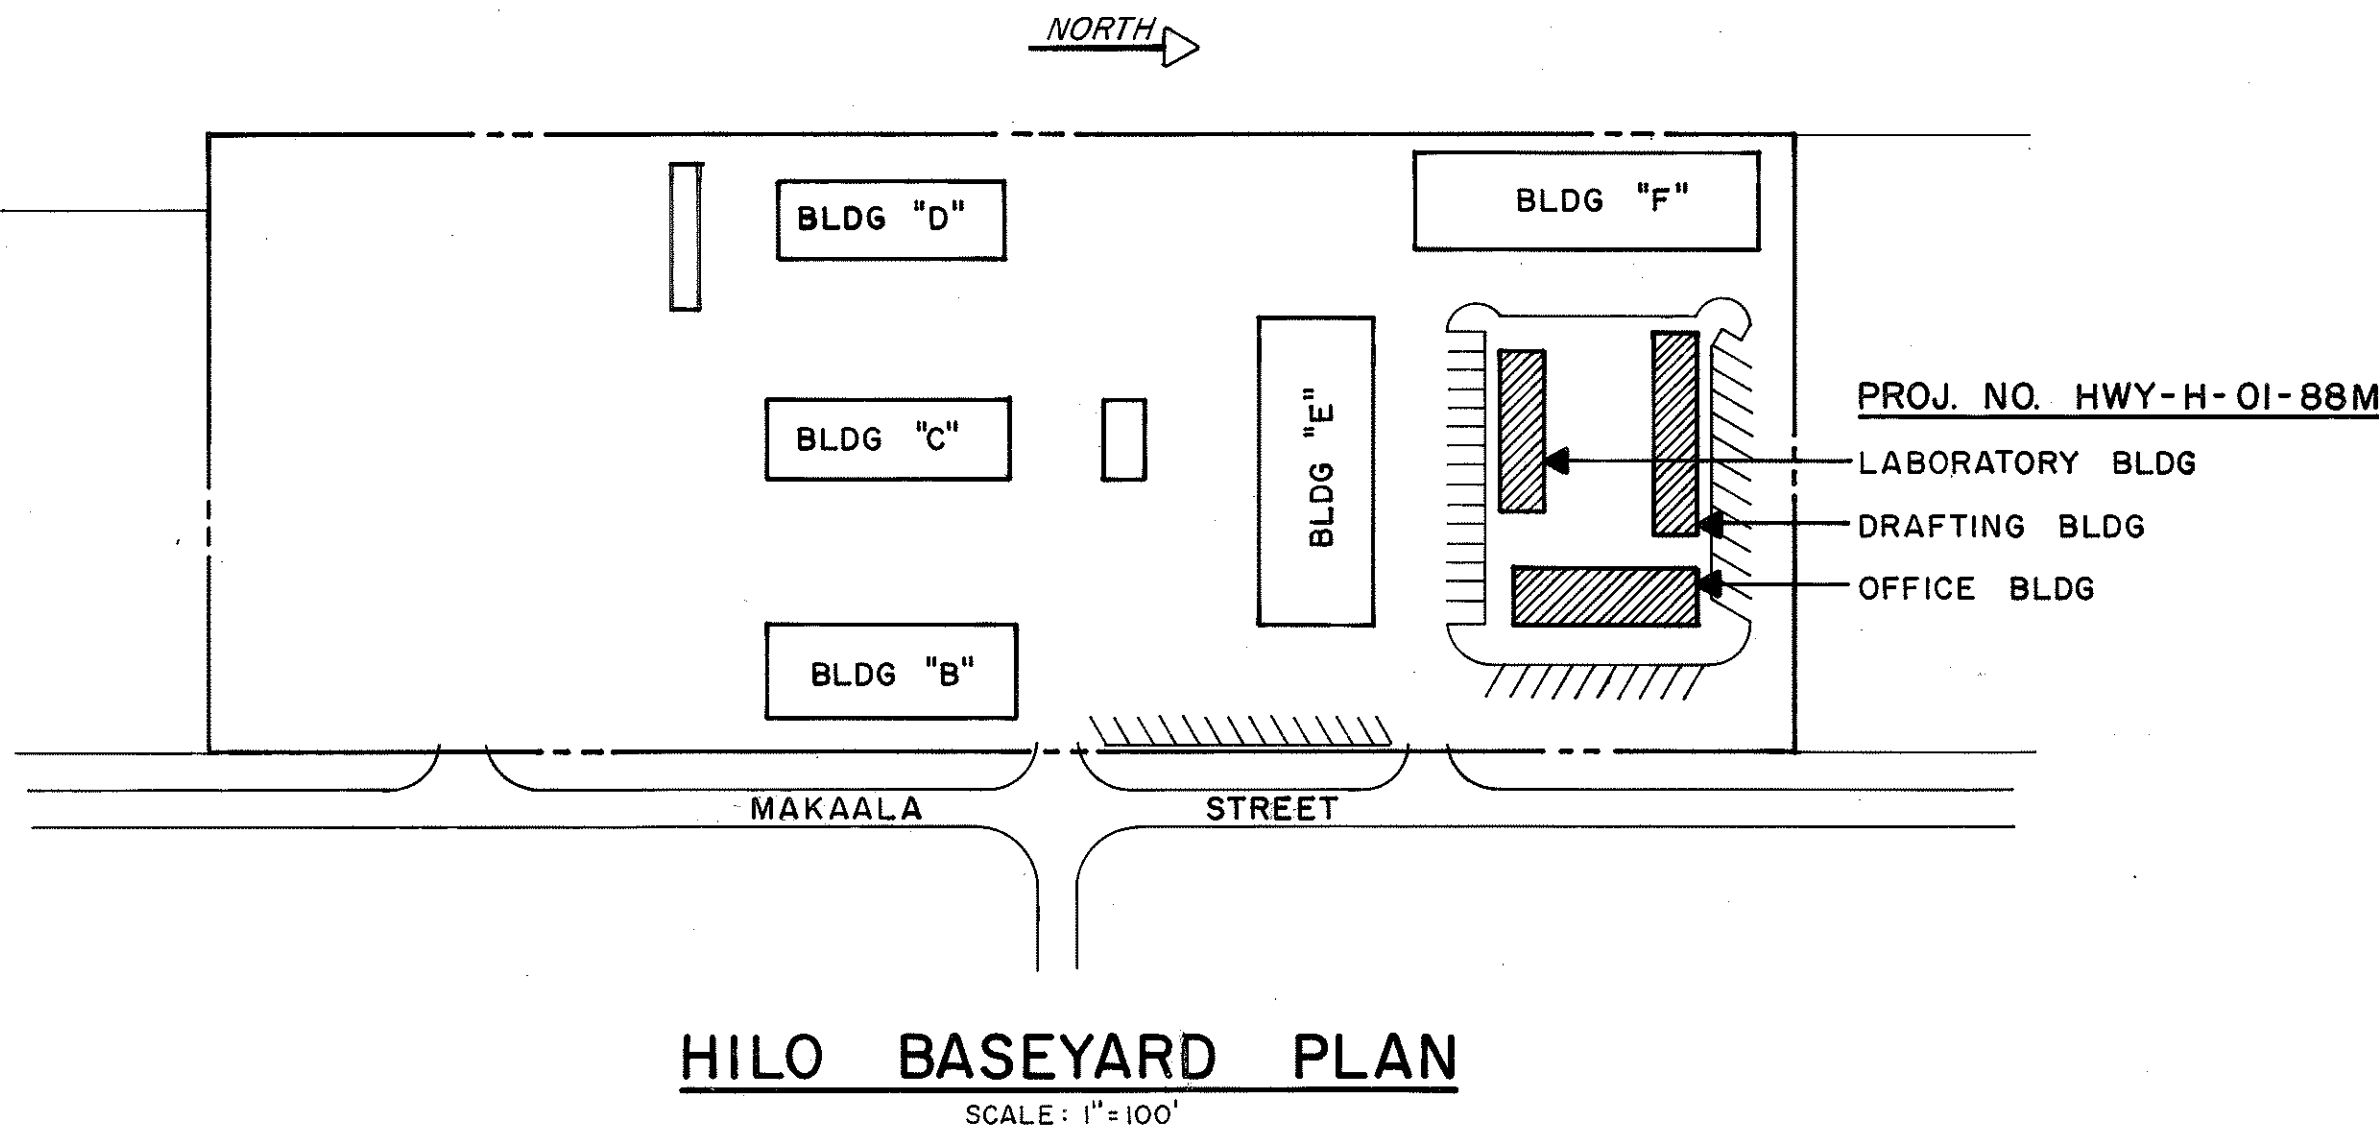

FED. ROAD DIST. NO.	STATE	FED. AID PROJ. NO.	FISCAL YEAR	SHEET NO.	TOTAL SHEETS
HAWAII	HAW.	HWY-H-01-88M	1988	1	2

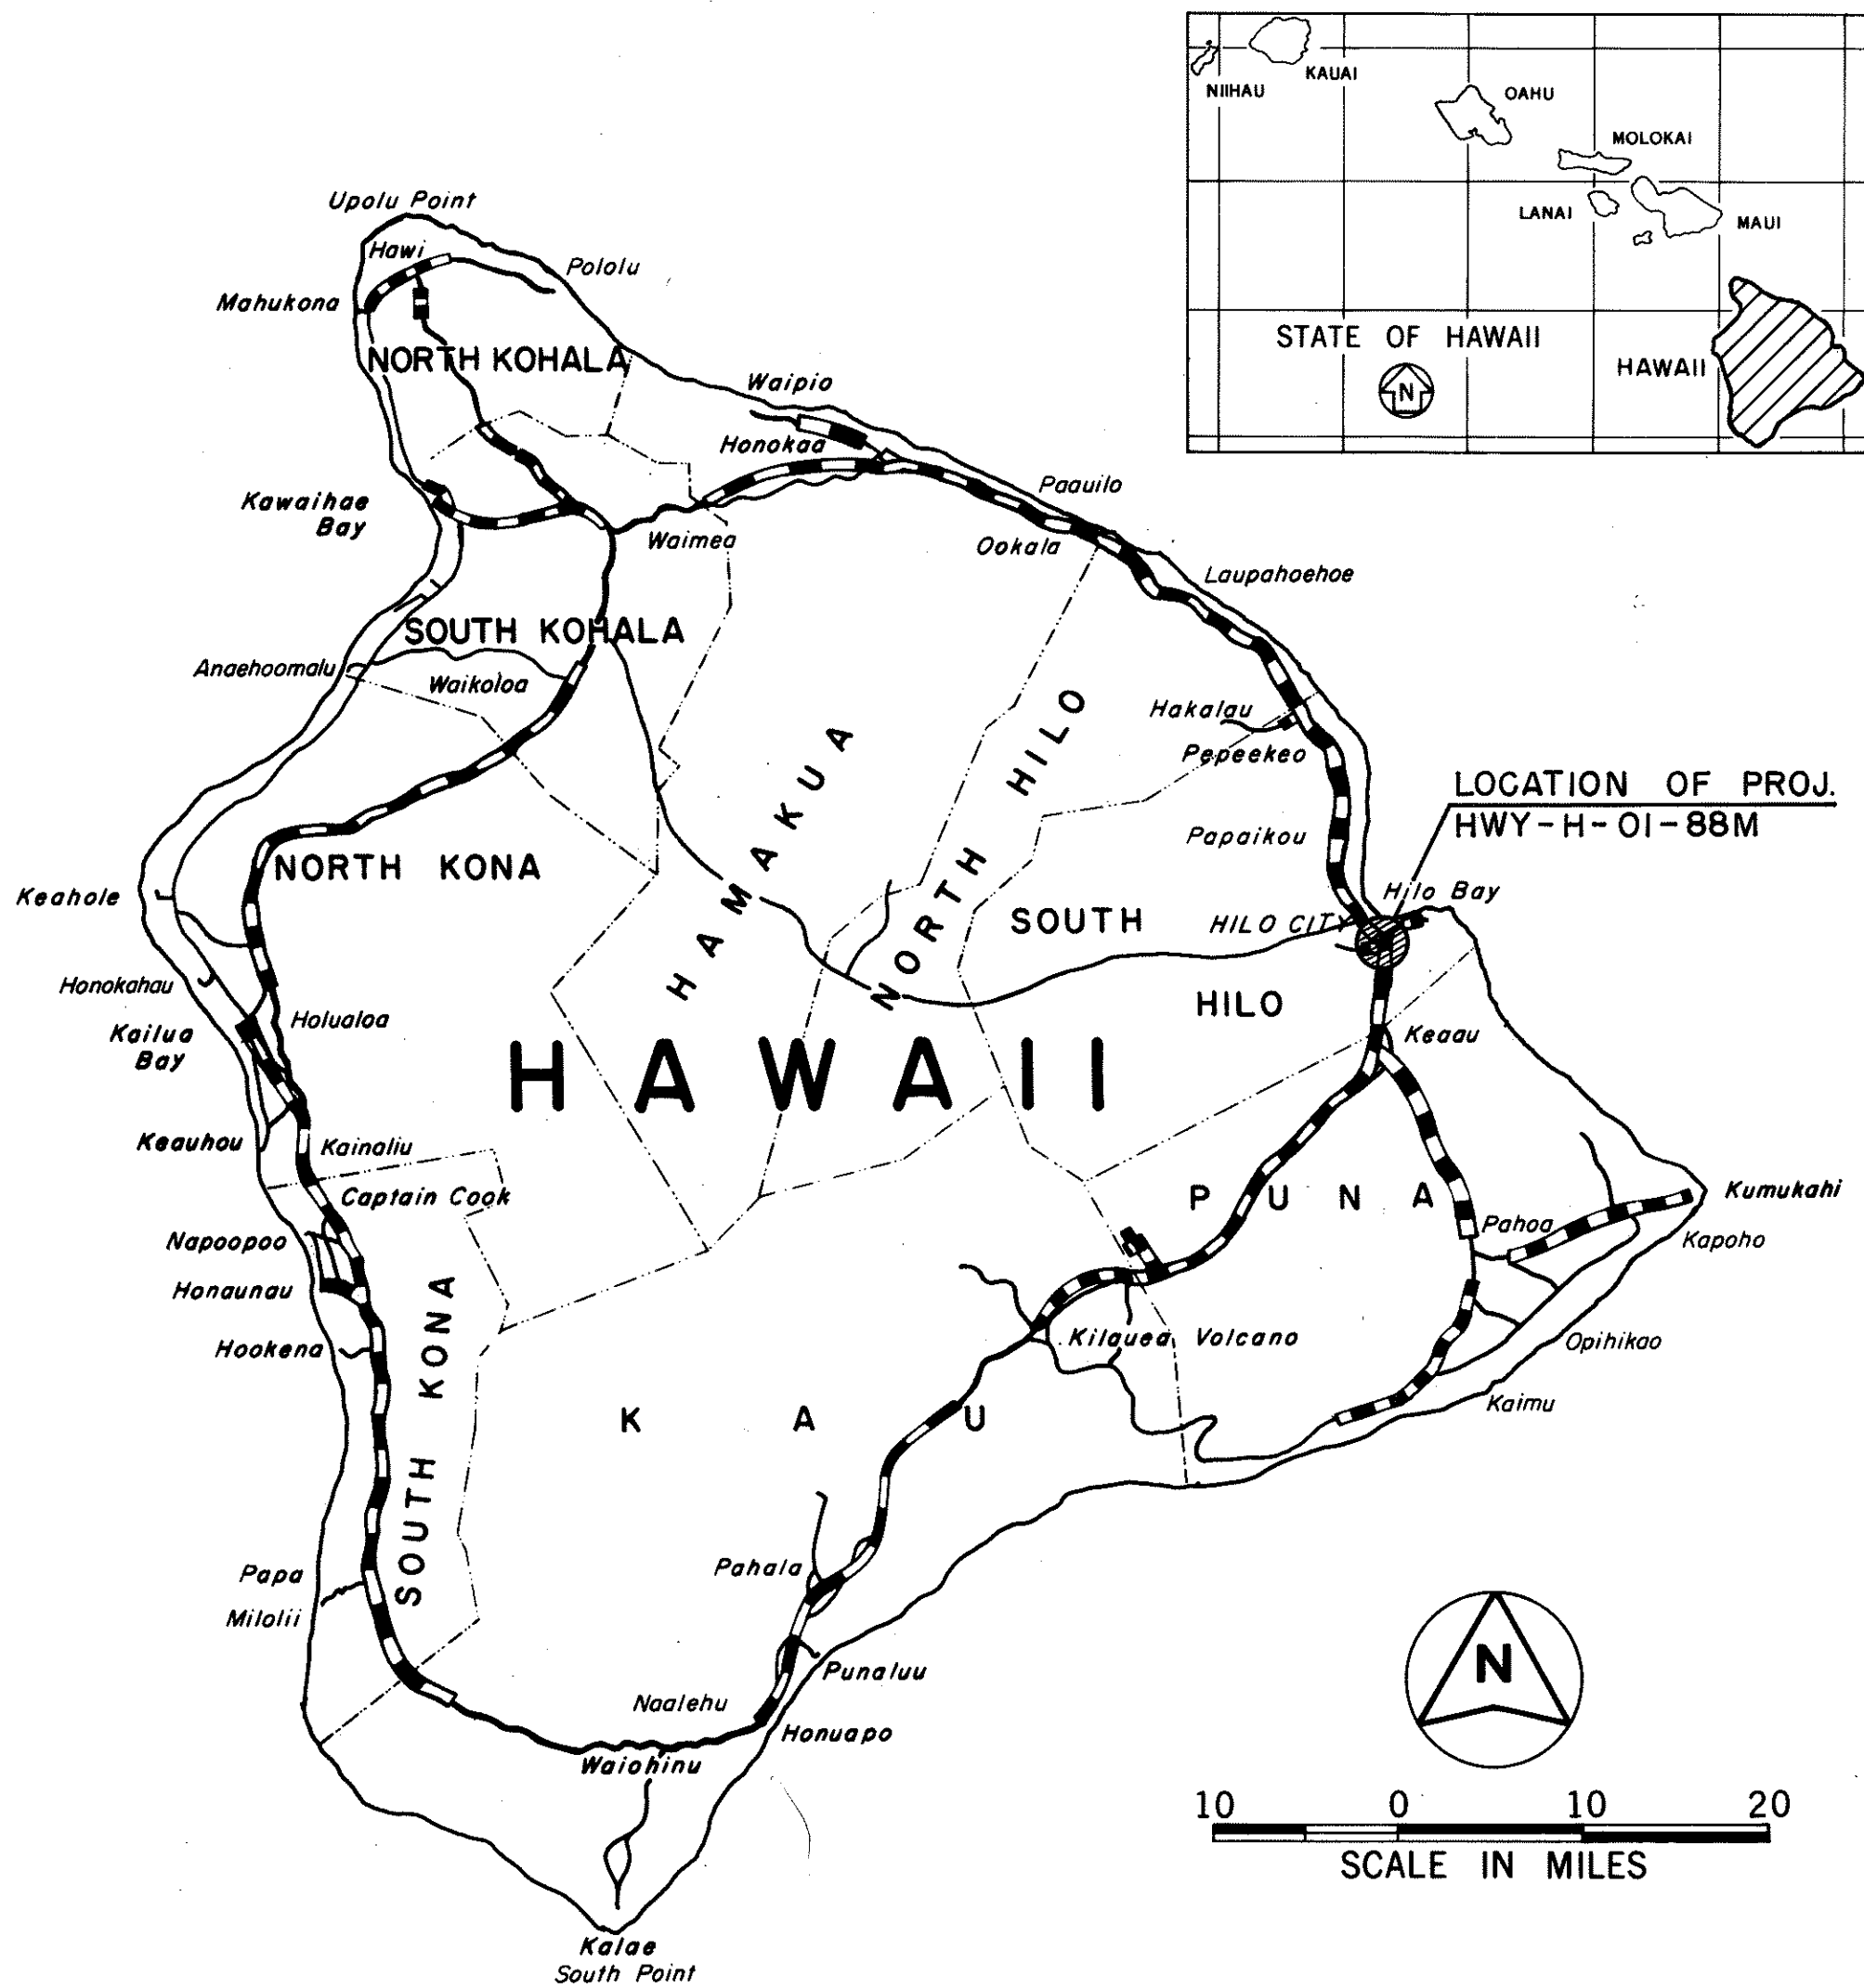

CHANGES MADE DURING CONSTRUCTION HAVE BEEN INCORPORATED ON THESE PLANS EXCEPT CHANGES IN THE ORIGINAL THEORETICAL QUANTITIES. FOR ACTUAL QUANTITIES, REFER TO PROJECT LEDGER AND/OR COMPUTATION BOOK.

Robert W. Lee, Jr.
RESIDENT ENGINEER

6/13/89
DATE

DEPARTMENT OF TRANSPORTATION STATE OF HAWAII	
APPROVED:	
Edward J. Smith	6/16/88
DIR. OF TRANSPORTATION	DATE

HAWAII DISTRICT
DESIGNED BY
R. TAKAESU
P. S. & E. BY
548-4125
PHONE
JUNE 1988
DATE