


DATE _____
BY _____
SURVEYED _____
PLOTTED _____
NOTE BOOK _____
AREAS _____
CHECKED _____
NO. _____


DATE _____
BY _____
ORIGINAL SURVEY _____
PLOTTED _____
NOTE BOOK _____
AREAS _____
CHECKED _____
NO. _____

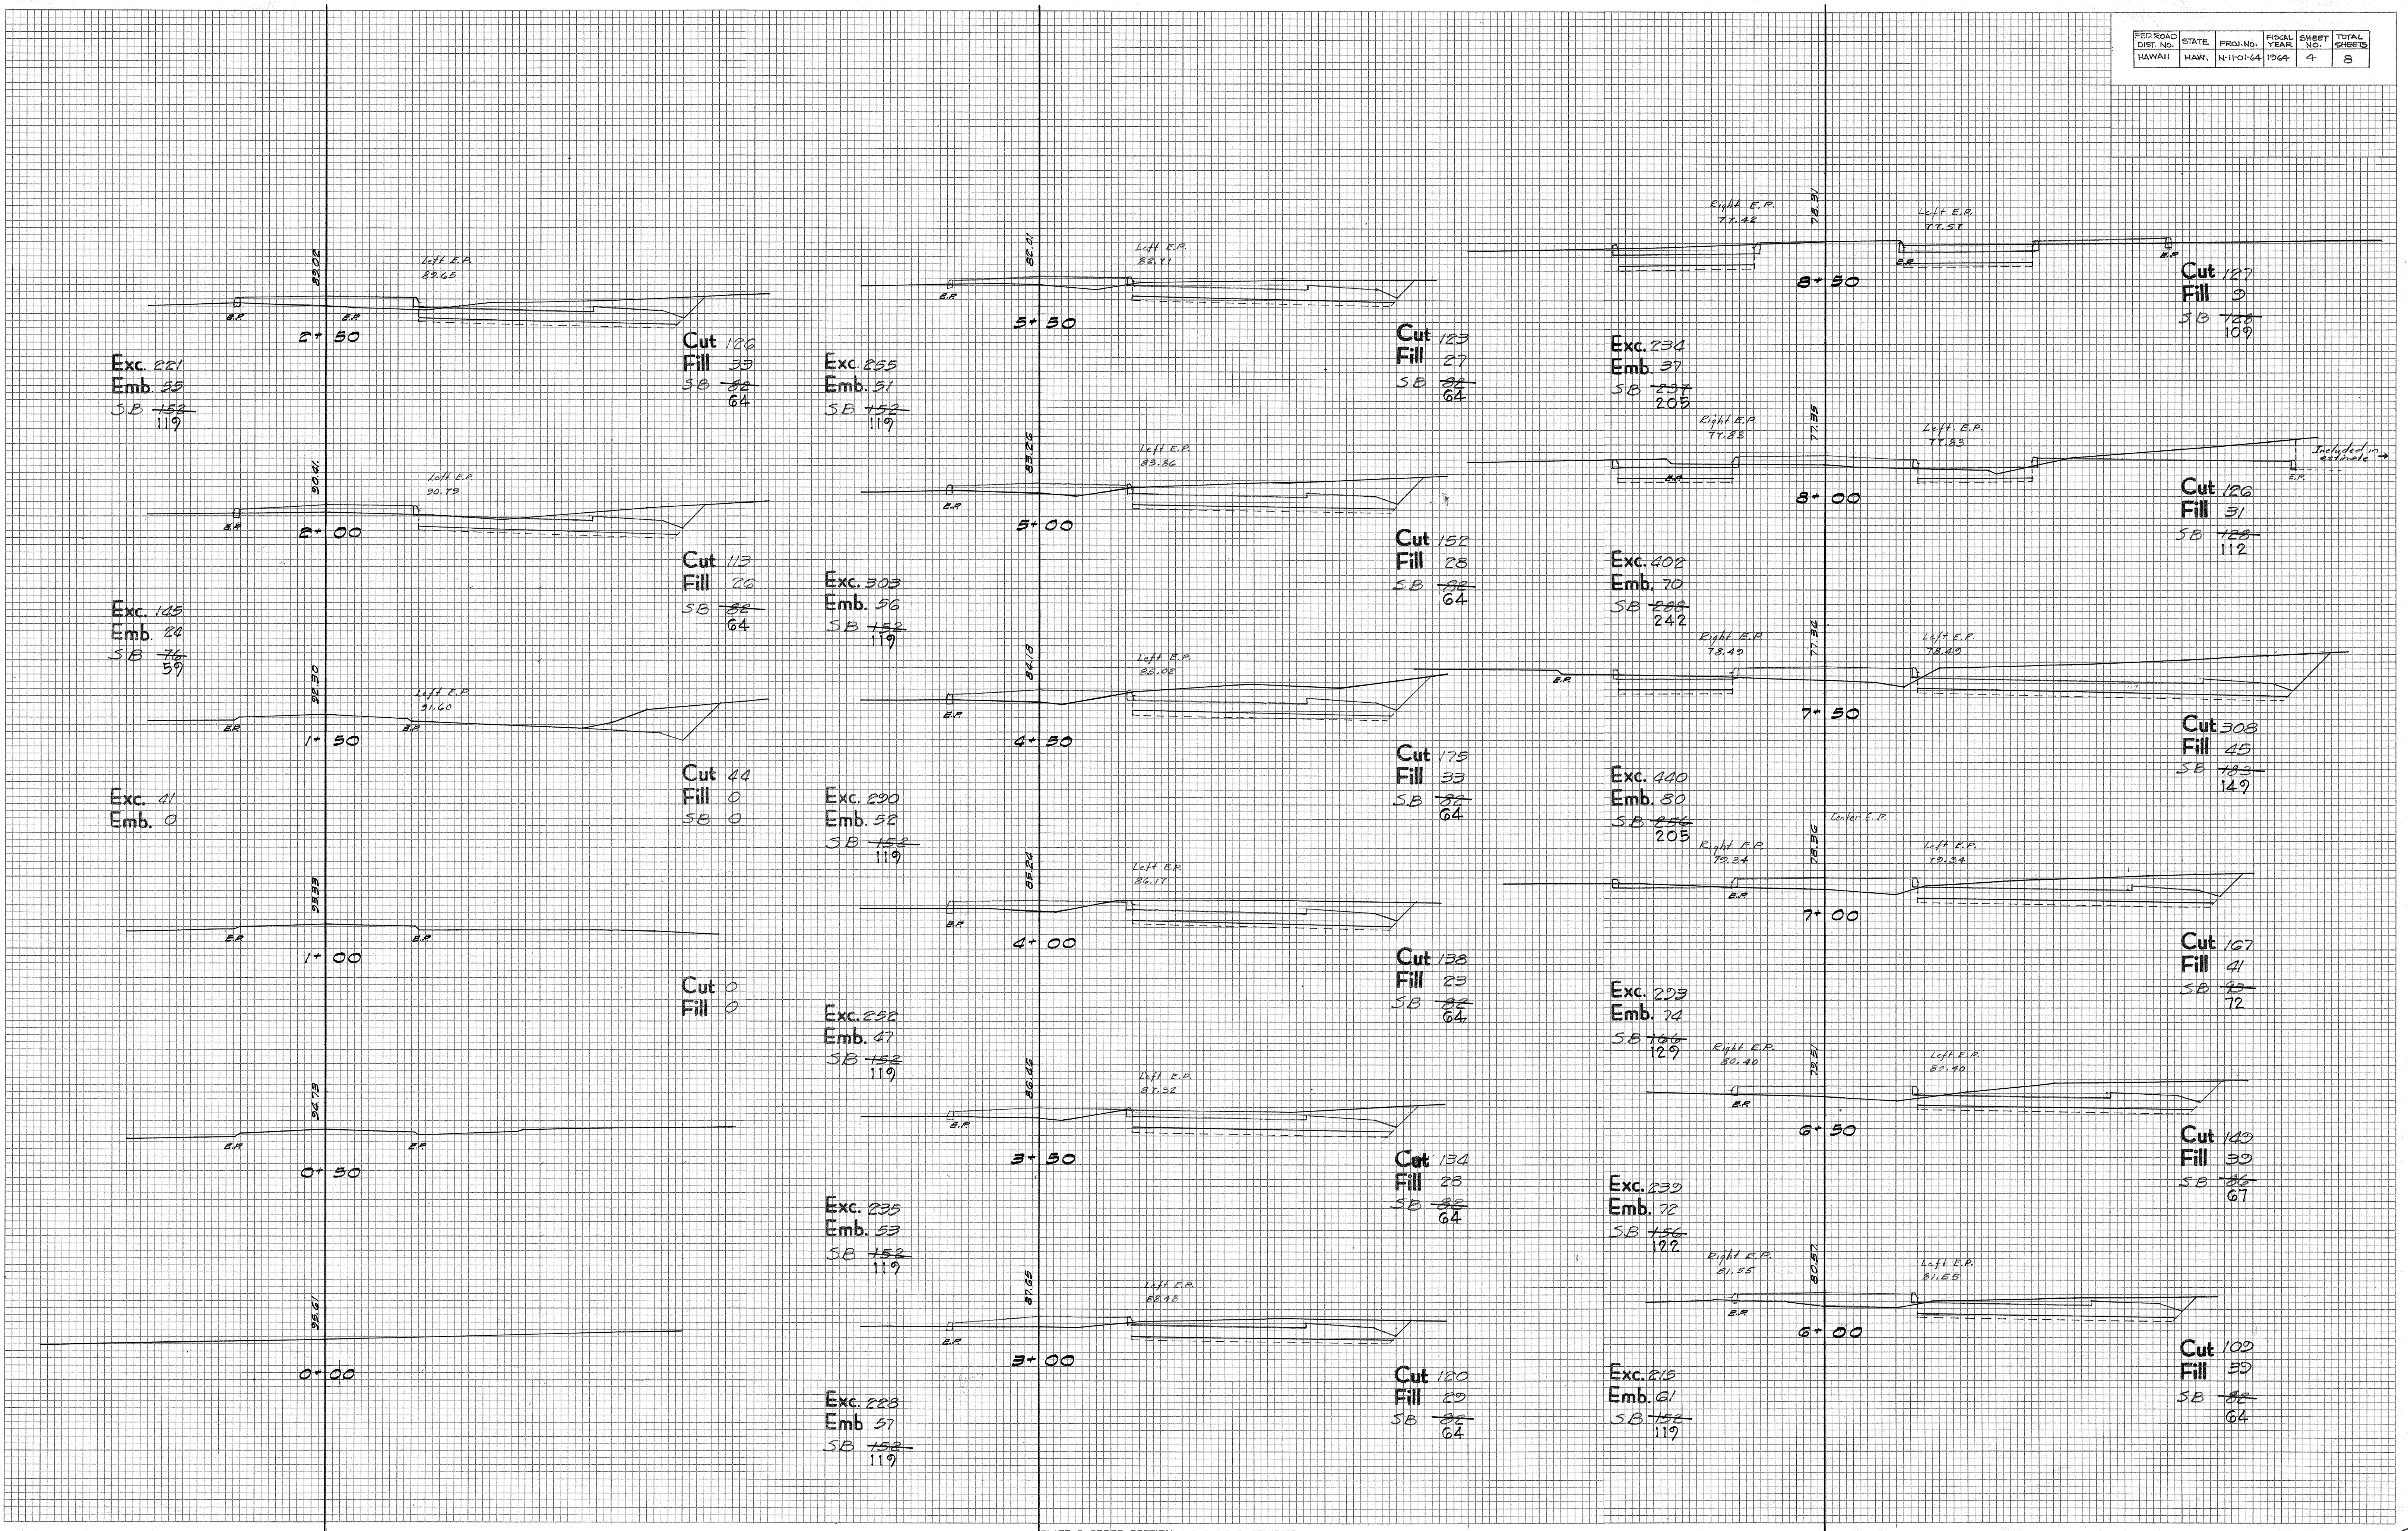

FED. ROAD DIST. NO.	STATE	PROJ. NO.	FISCAL YEAR	SHEET NO.	TOTAL SHEETS
HAWAII	HAWAII	H-11-01-64	1964	4	8

DATE	BY
NO.	


DATE	BY
NO.	

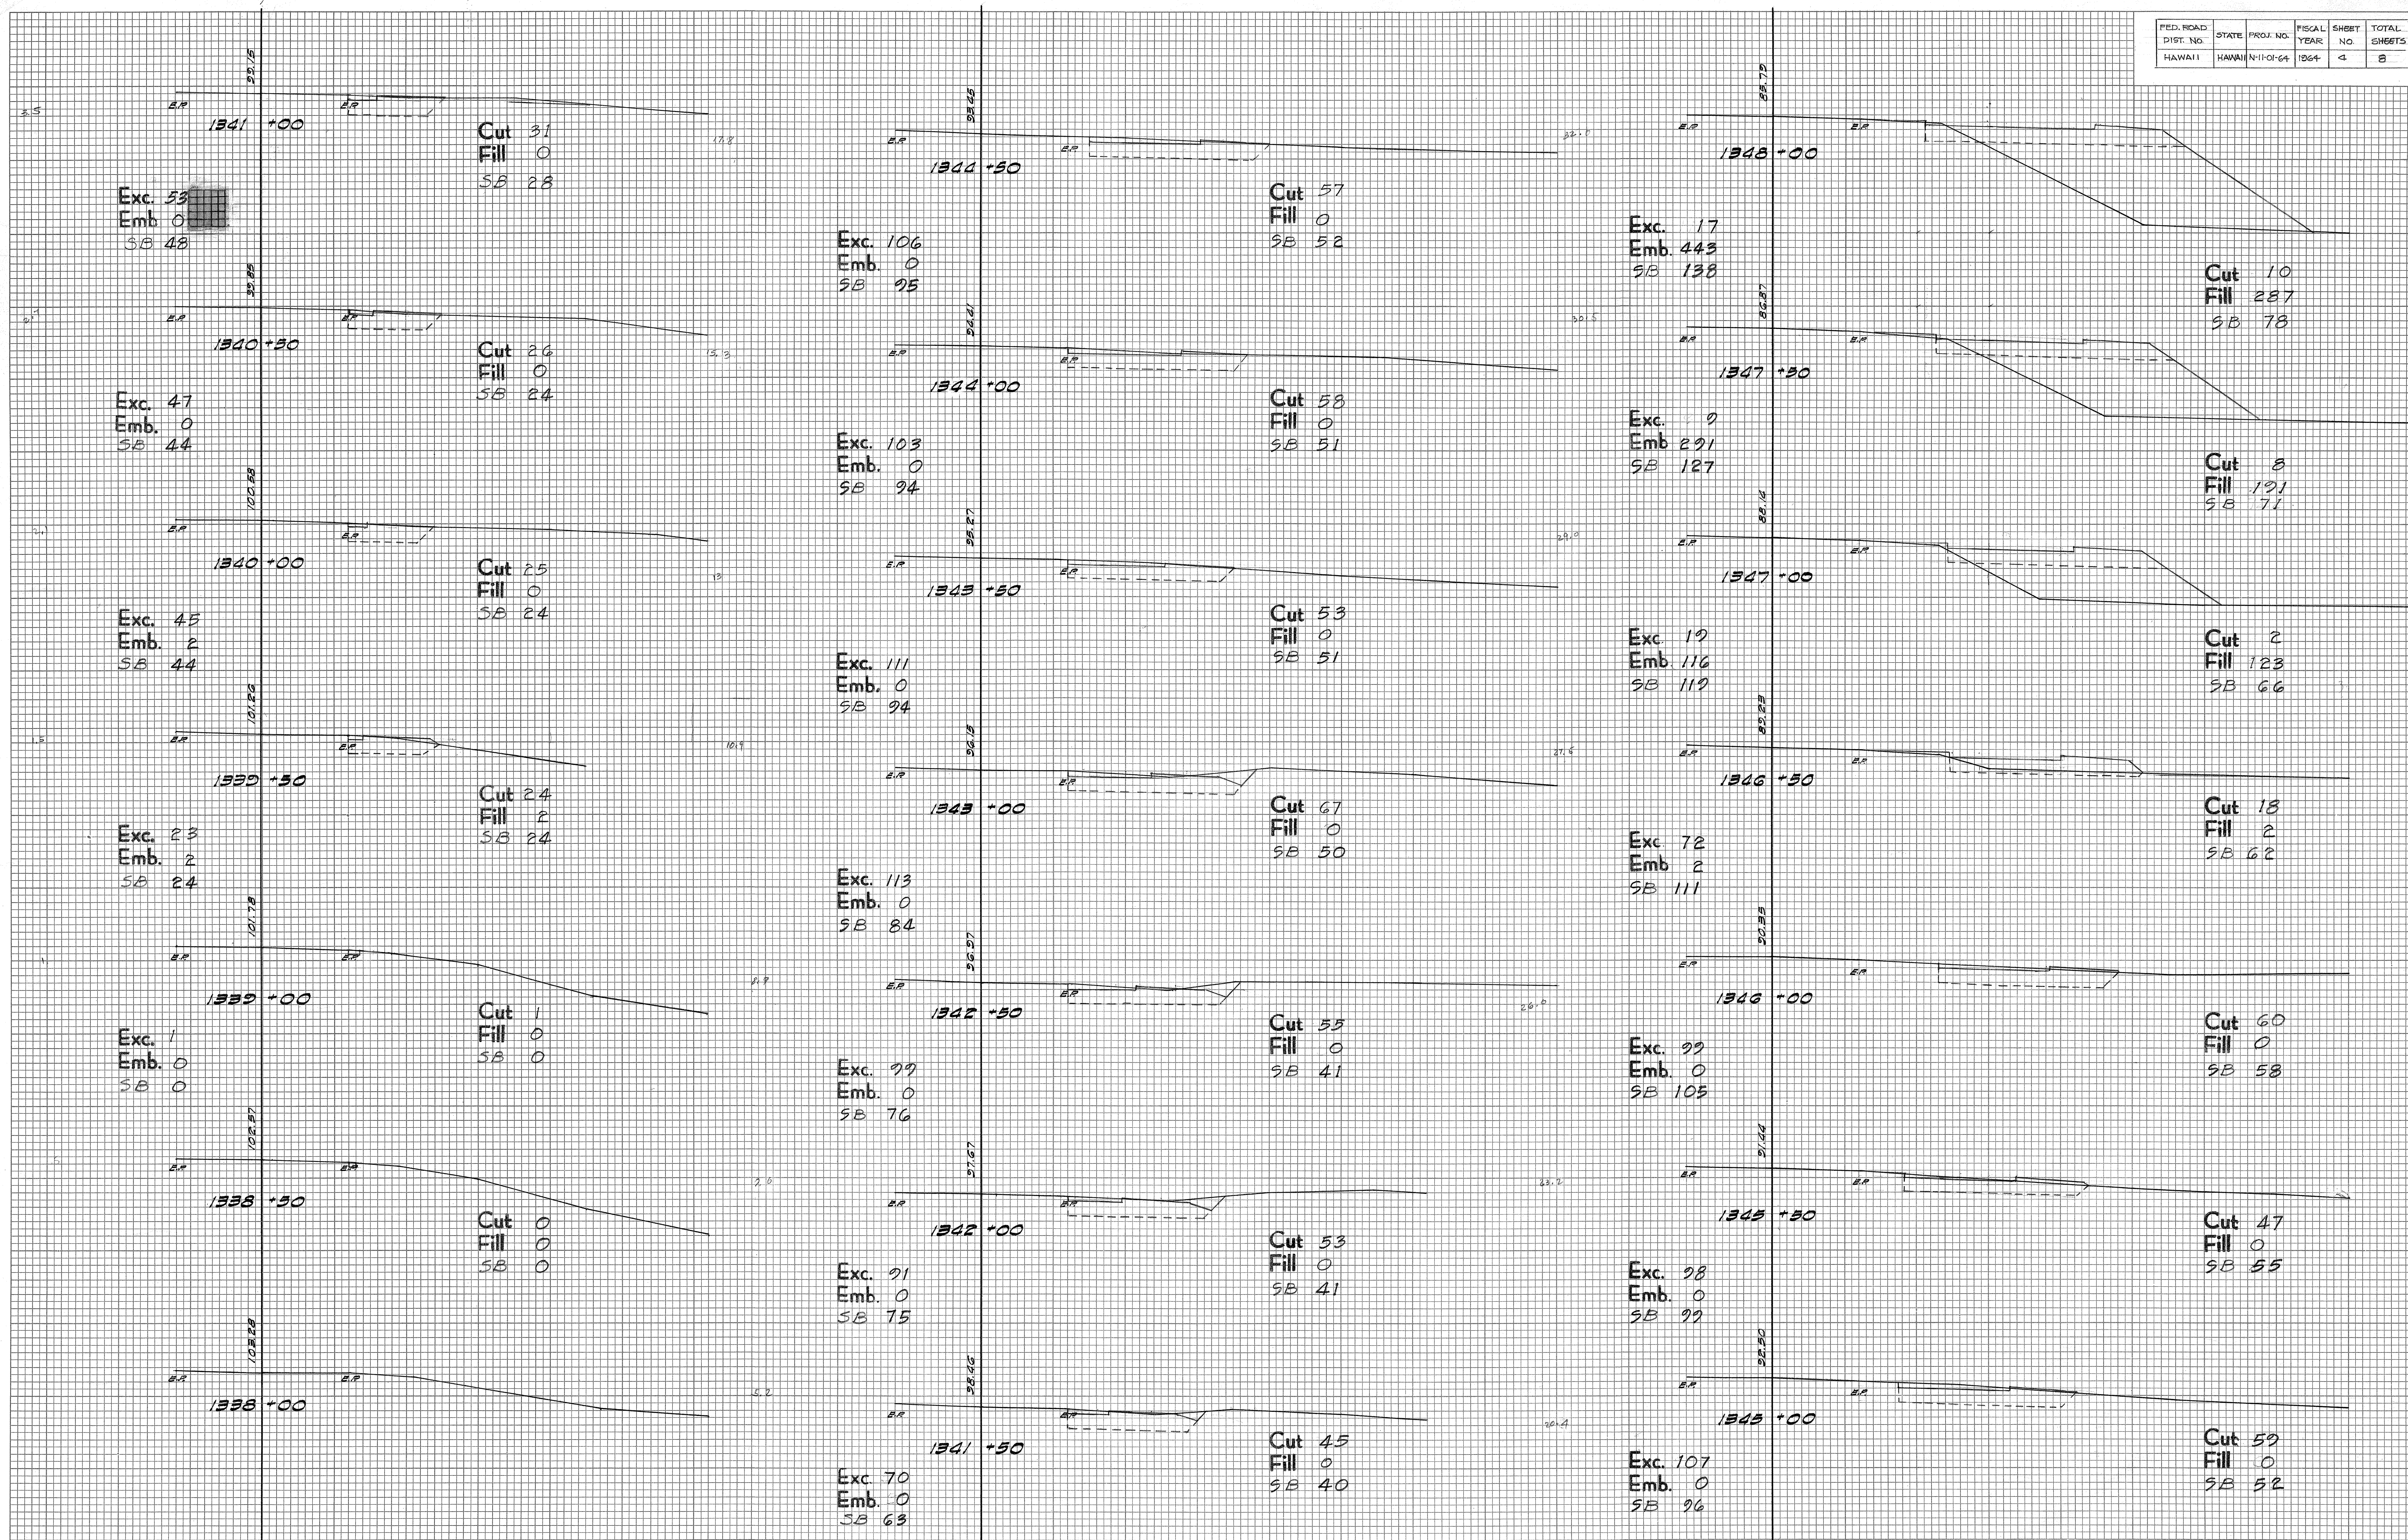

FED. ROAD DIST. NO.	STATE	PROJ. NO.	FISCAL YEAR	SHEET NO.	TOTAL SHEETS
HAWAII	HAW	H-101-64	1964	5	8



DATE	BY	DATE	BY
FINAL SURVEY		SURVEYED	
NOTE BOOK		PLOTTER	
NO.		NO.	
AREAS CHECKED		AREAS CHECKED	

DATE	BY	DATE	BY
ORIGINAL SURVEY		SURVEYED	
NOTE BOOK		PLOTTER	
NO.		NO.	
AREAS CHECKED		AREAS CHECKED	

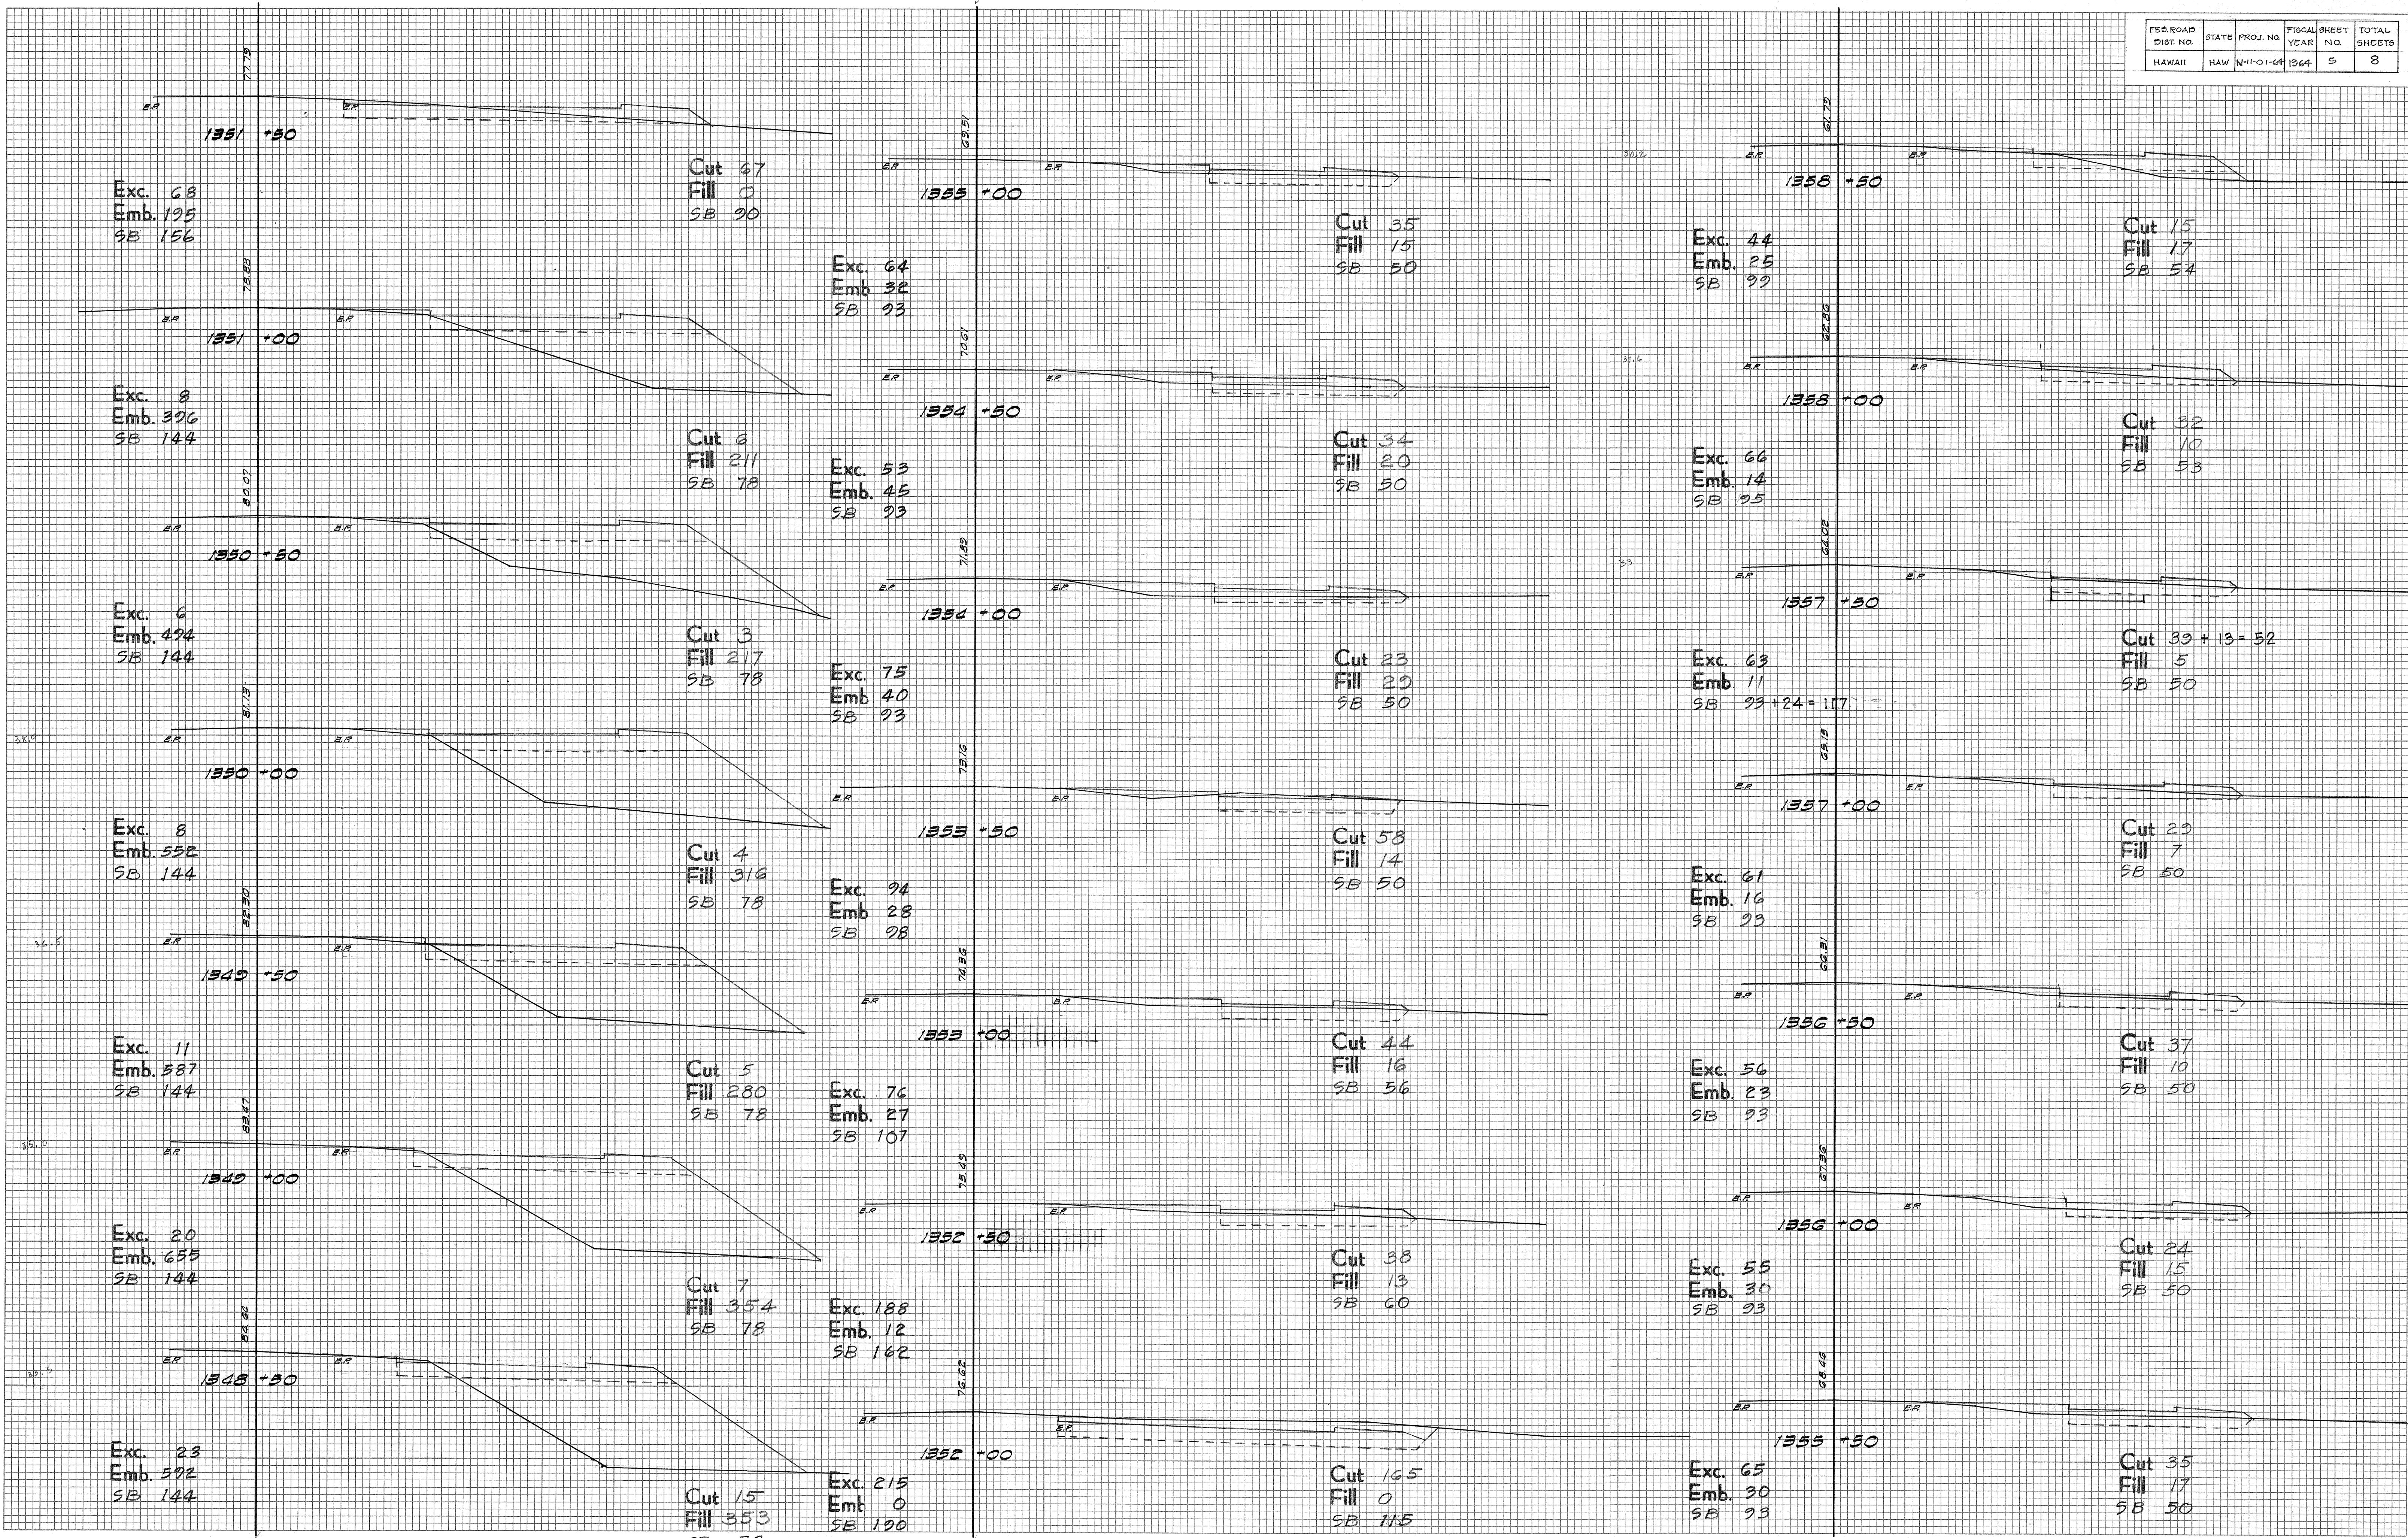


FINAL SURVEY	SURVEYED PLOTTED	DATE
NO.	NO.	NO.

ORIGINAL SURVEY	SURVEYED PLOTTED	DATE
NO.	NO.	NO.

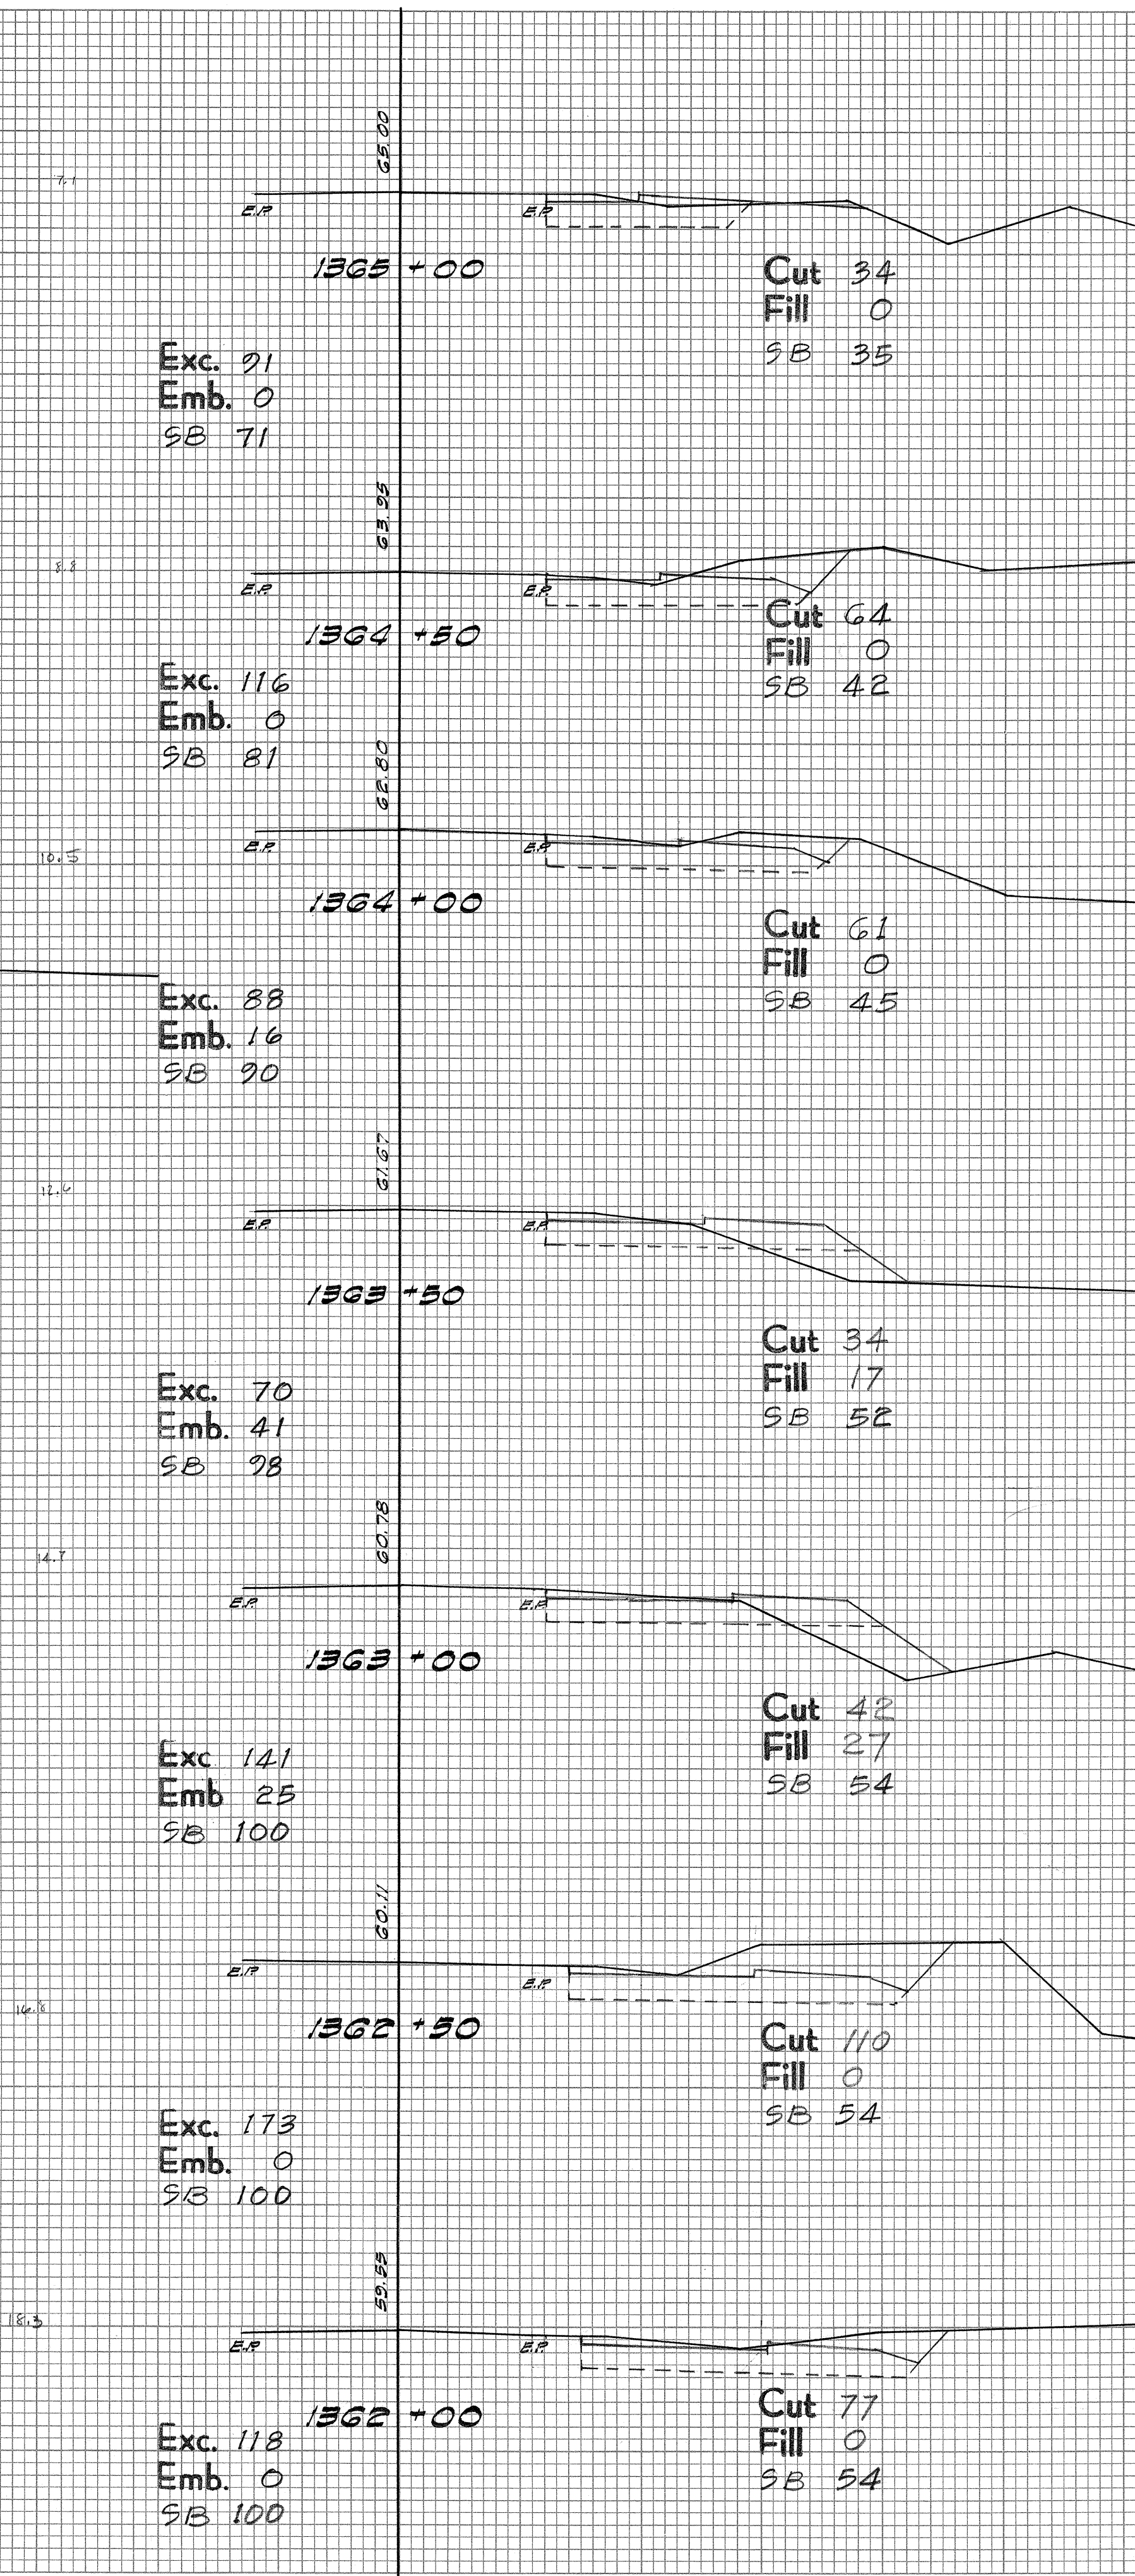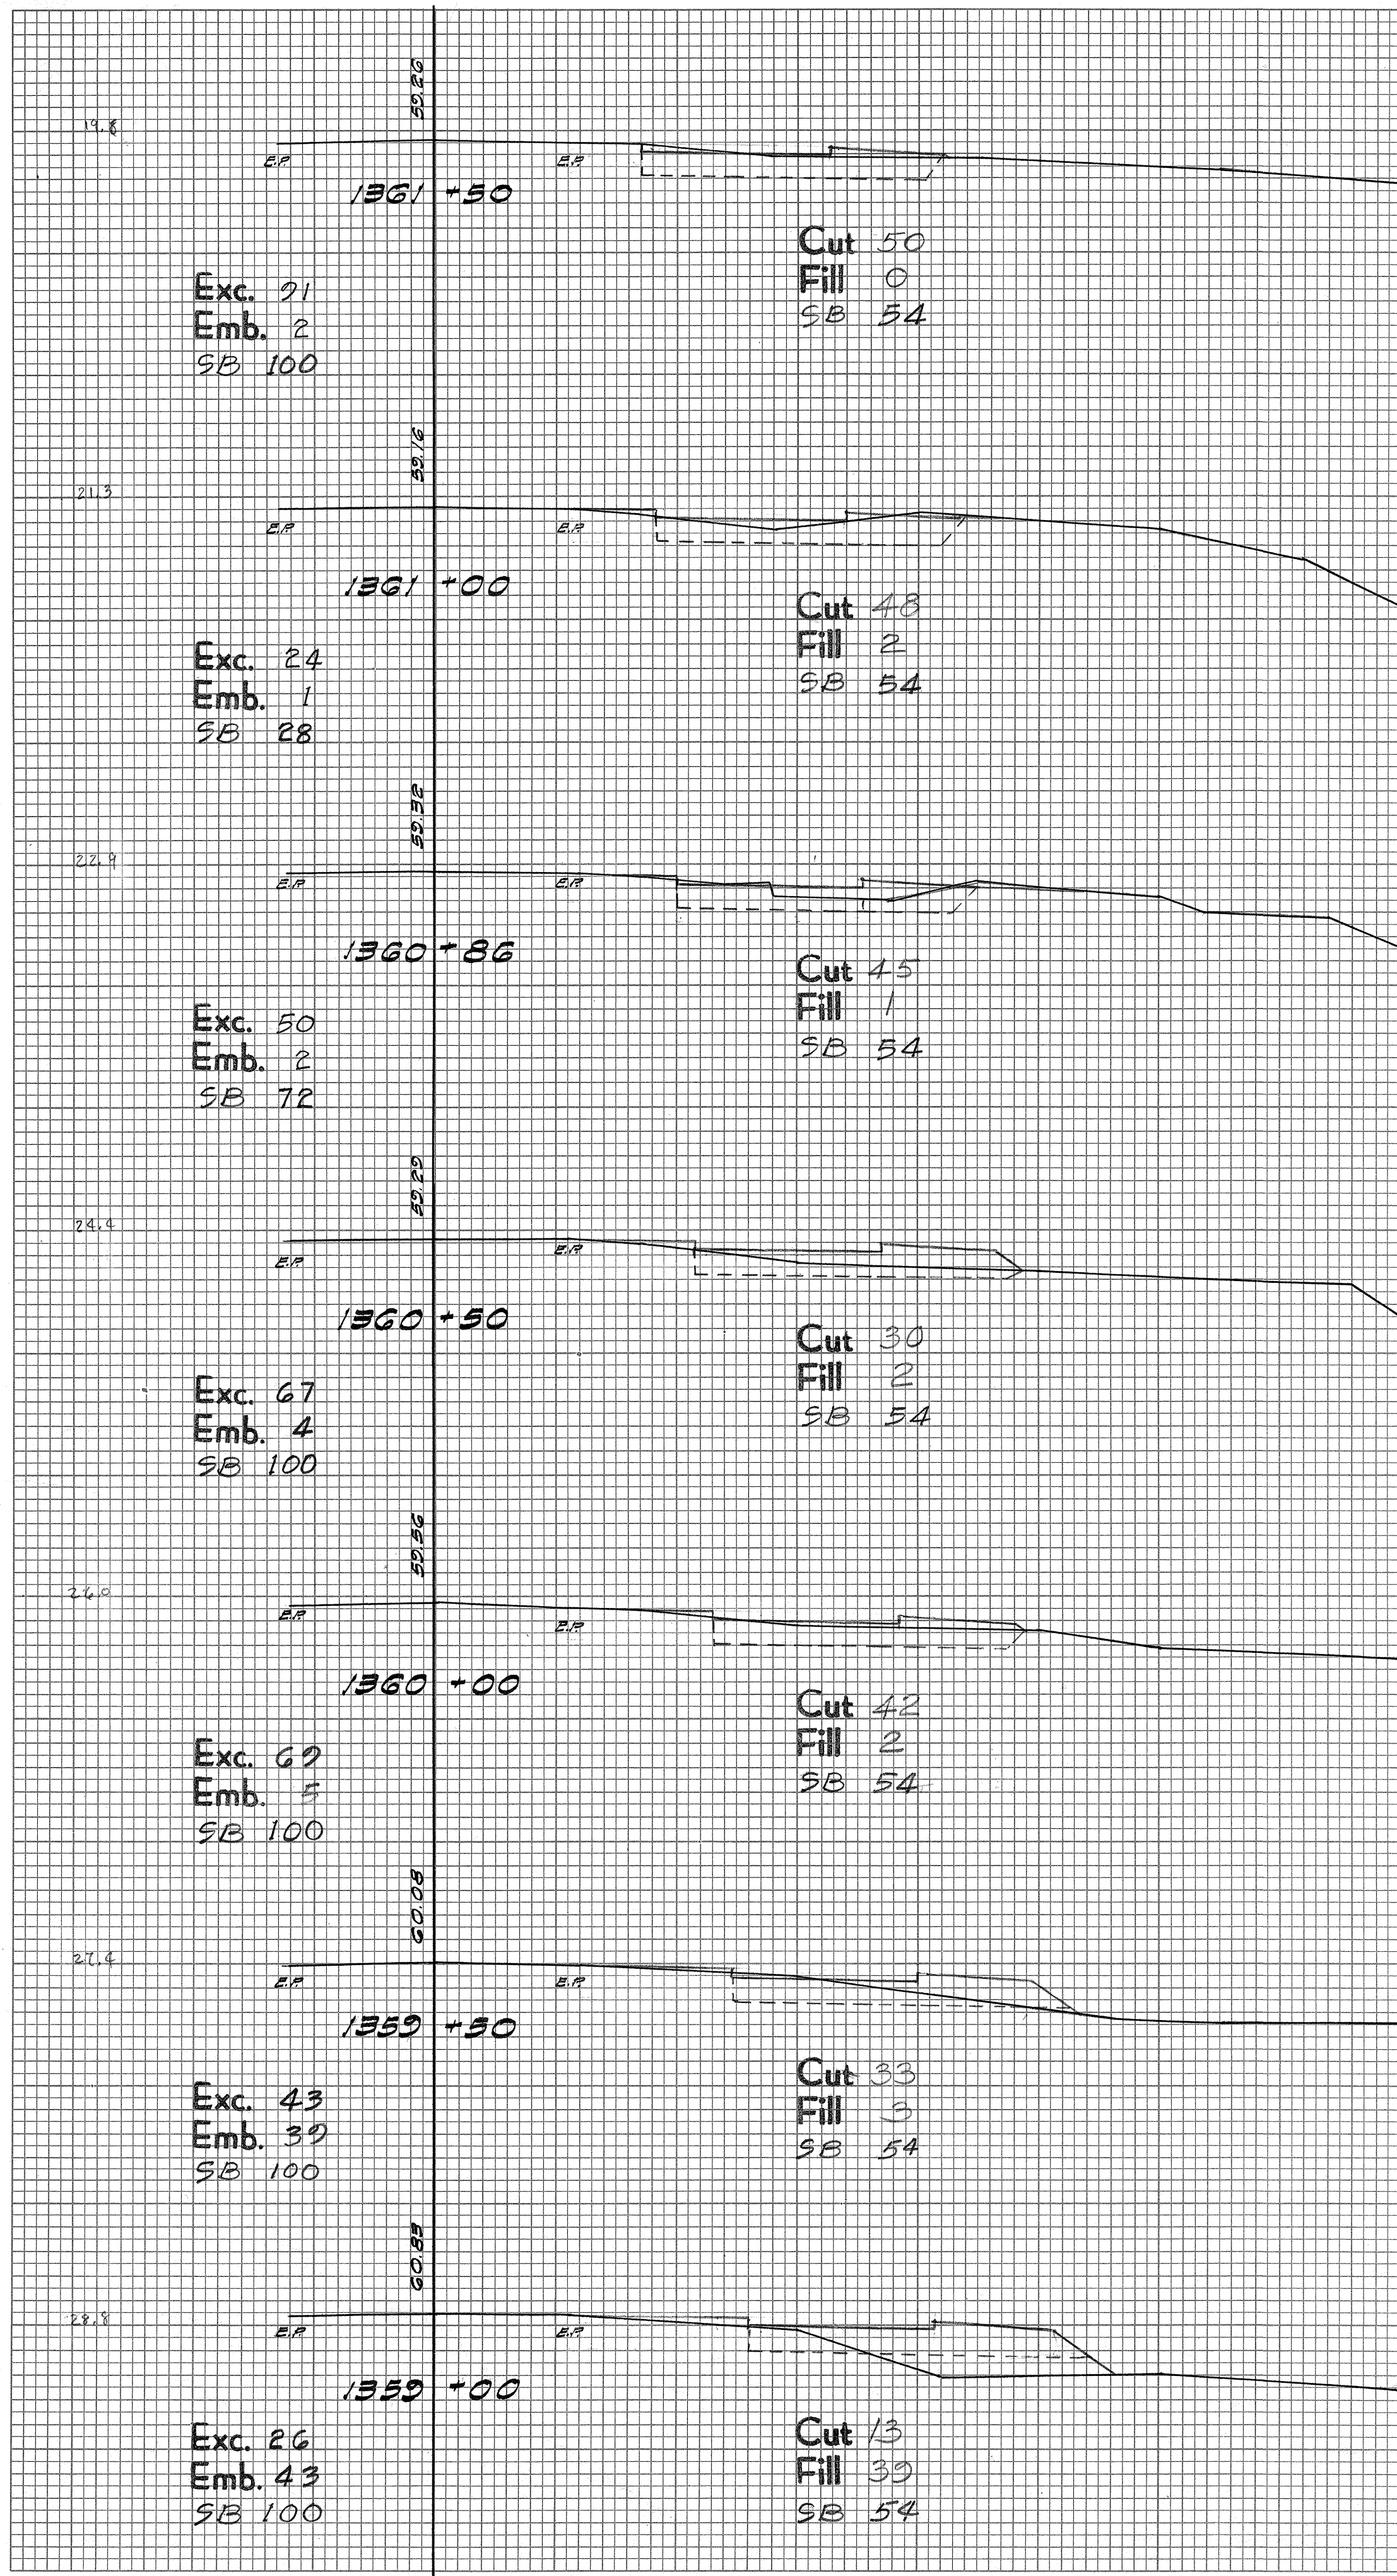

SUMMARY			
	EXCAVATION	SELECT BORROW	UNTREATED BASE
PUAINAKO ST.	3,866 c.y.	1,786 c.y.	388 c.y.
KANOELEHUA AVE.	4,685 c.y.	5,532 c.y.	814 c.y.
TOTAL:	8,551 c.y.	7,318 c.y.	1,197 c.y.

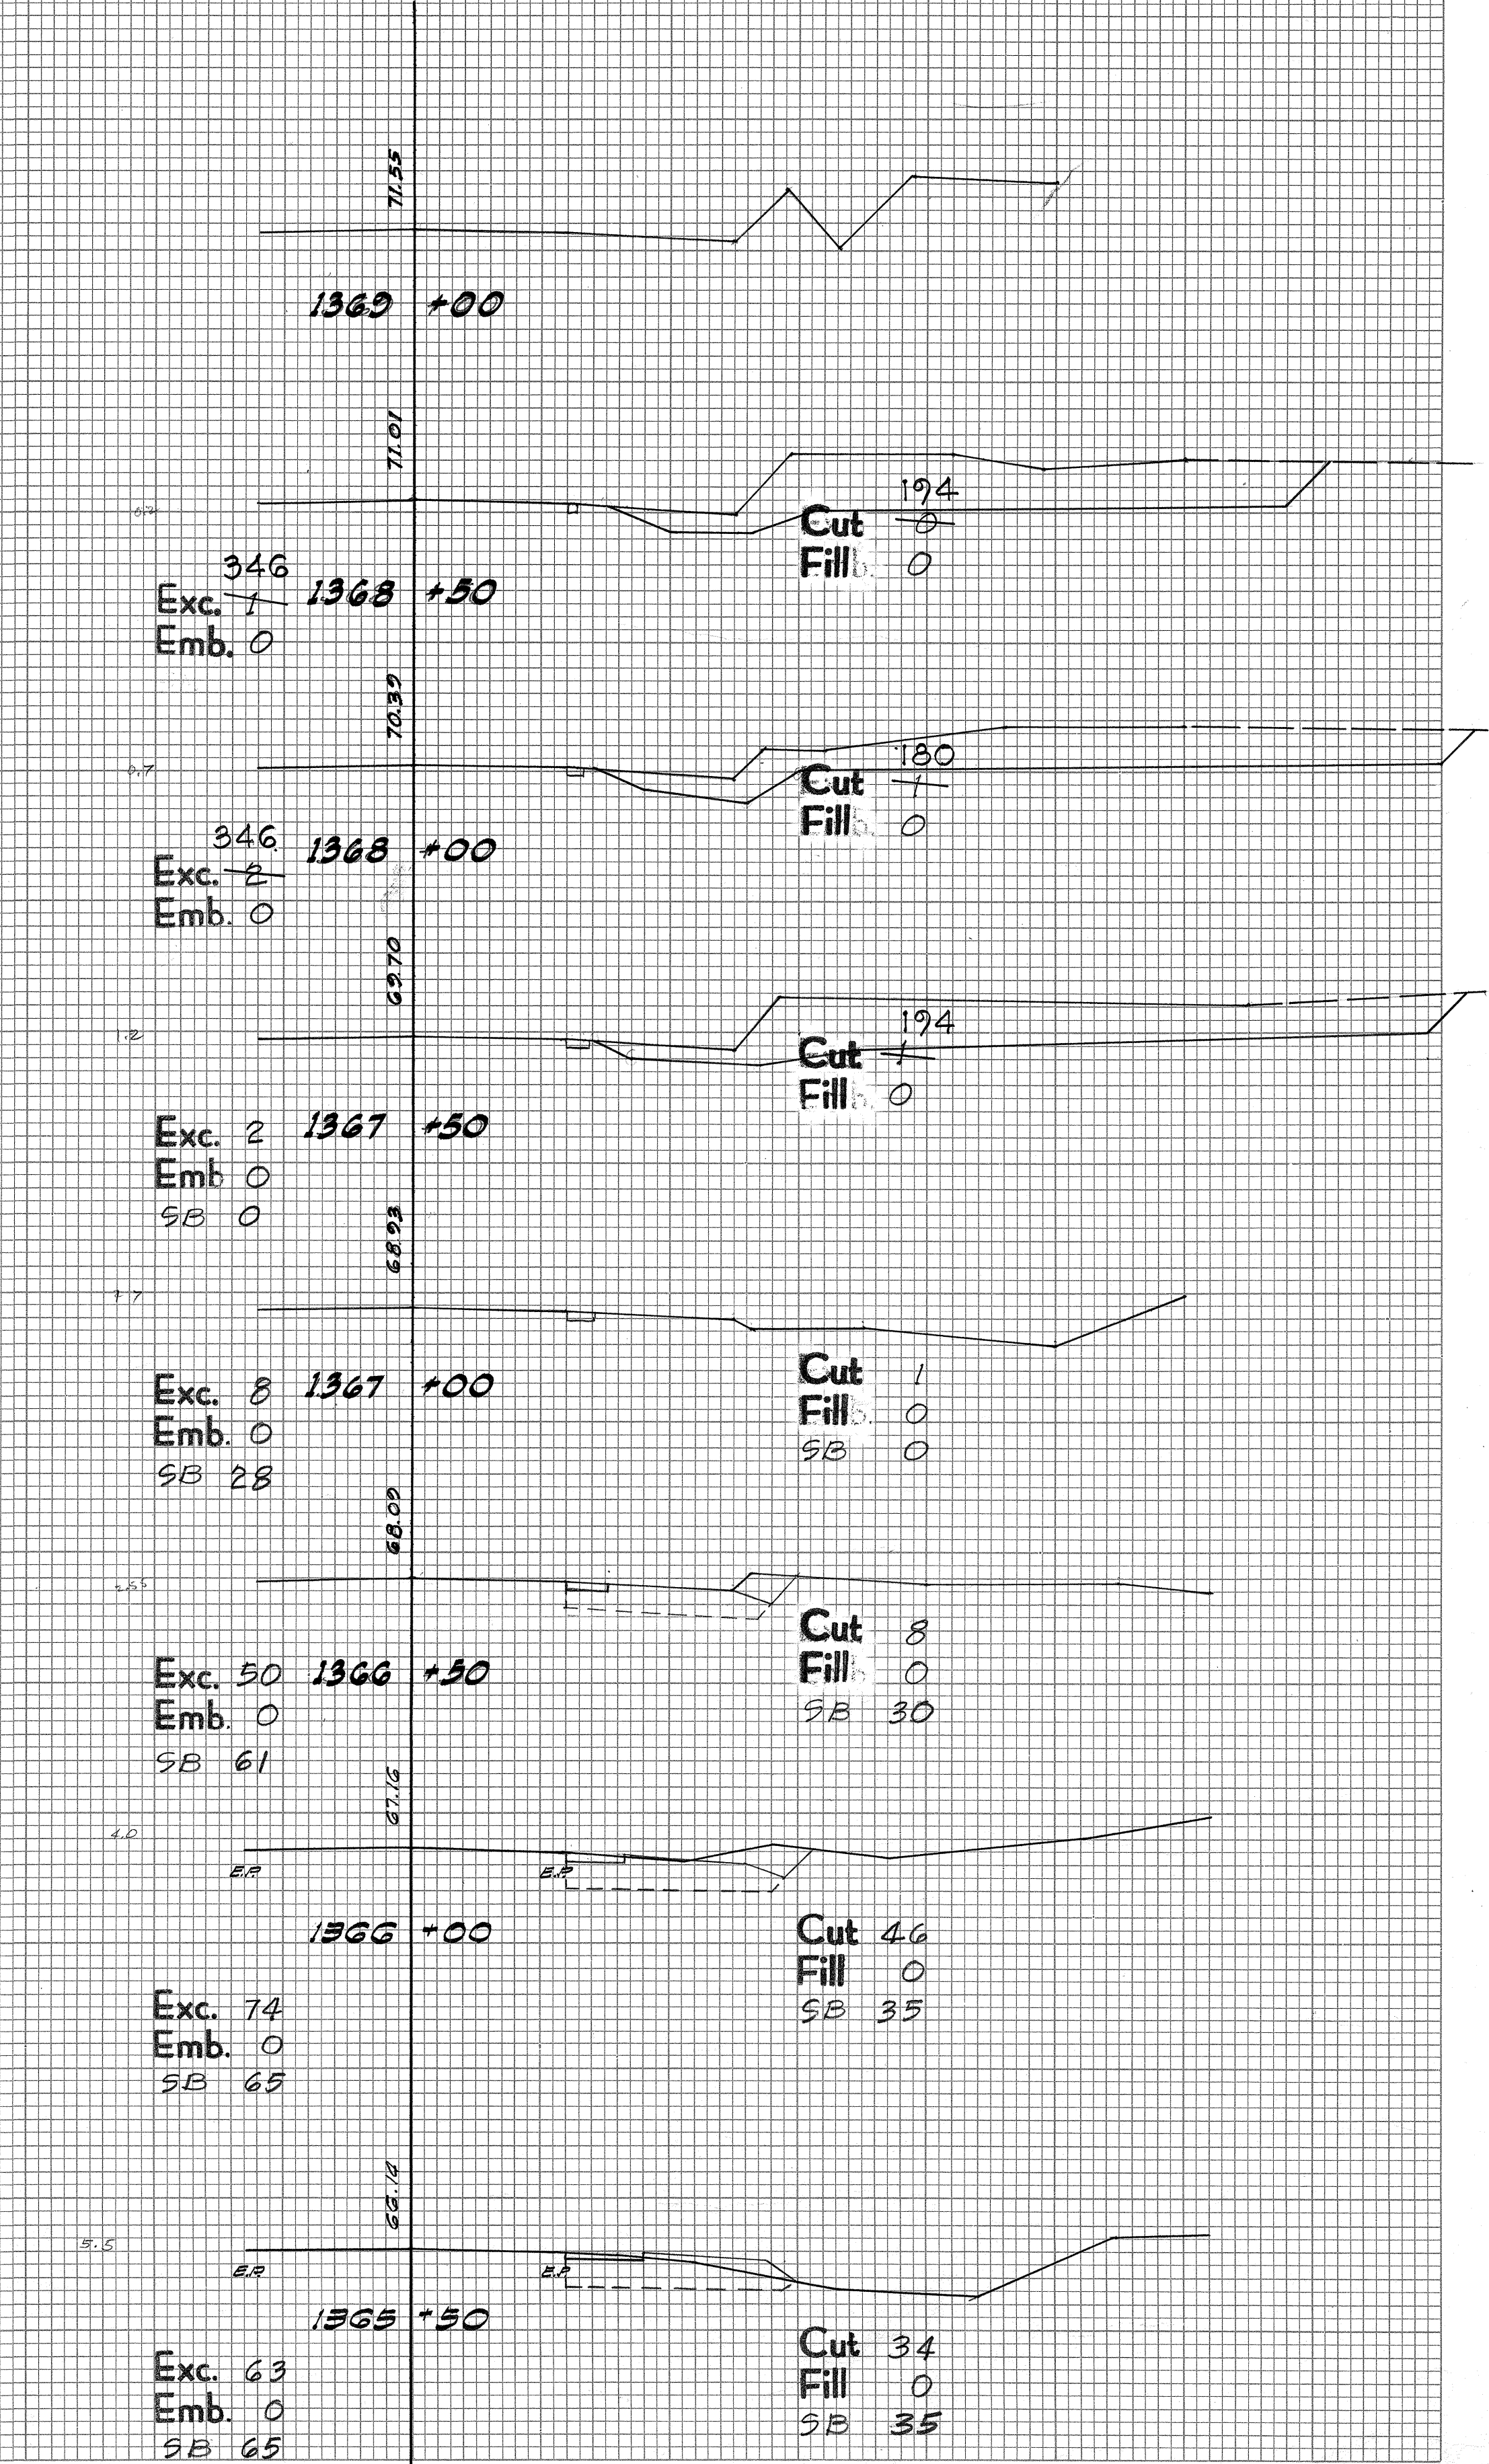

FEDERAL DISTRICT	STATE	PROJ. NO.	FISCAL YEAR	SHEET NO.	TOTAL SHEETS
HAWAII	HAW	N-11-O-64	1964	6	6