



FED. ROAD DIST. NO.	STATE	FED. AID PROJ. NO.	FISCAL YEAR	SHEET NO.	TOTAL SHEETS
HAWAII	HAW.	LSF-011-1(1)	1967	2	9

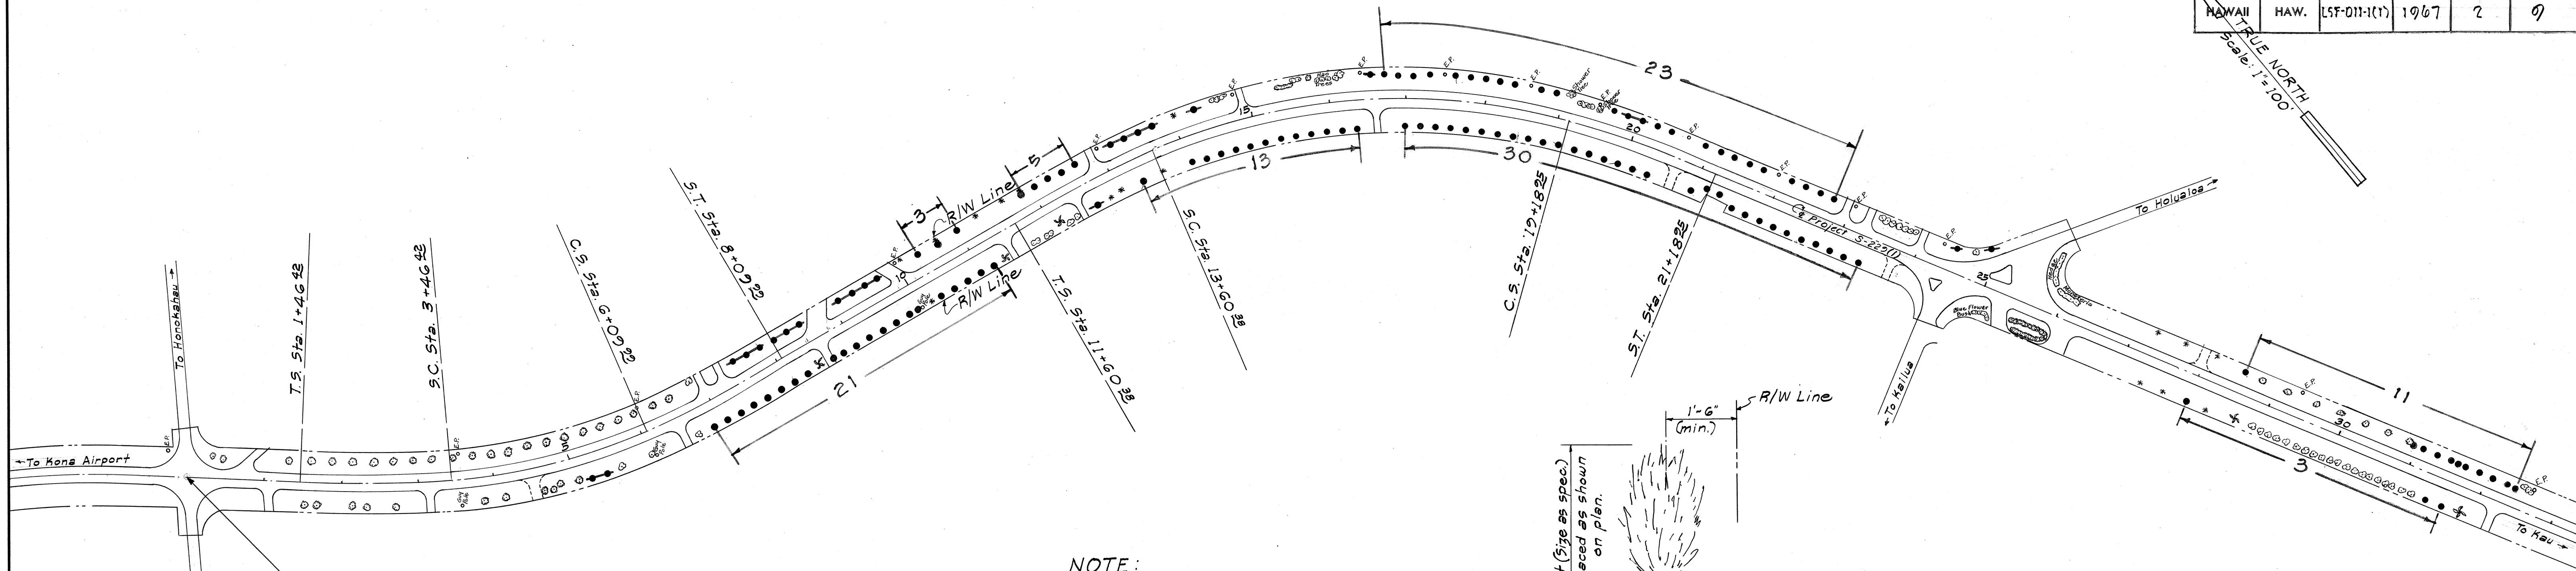

BEGIN PROJ. NO. LSF-011-1(1)
STA. 0+00


NOTE:

1. Planting hole shall be larger by 6" or more all around the plant root ball.
2. Backfill shall be a mixture of top soil and 10-10-10 commercial fertilizer or 50% top soil and 50% manure.
3. The plant hole shall be 12" deeper in coral, rock or hard pan.

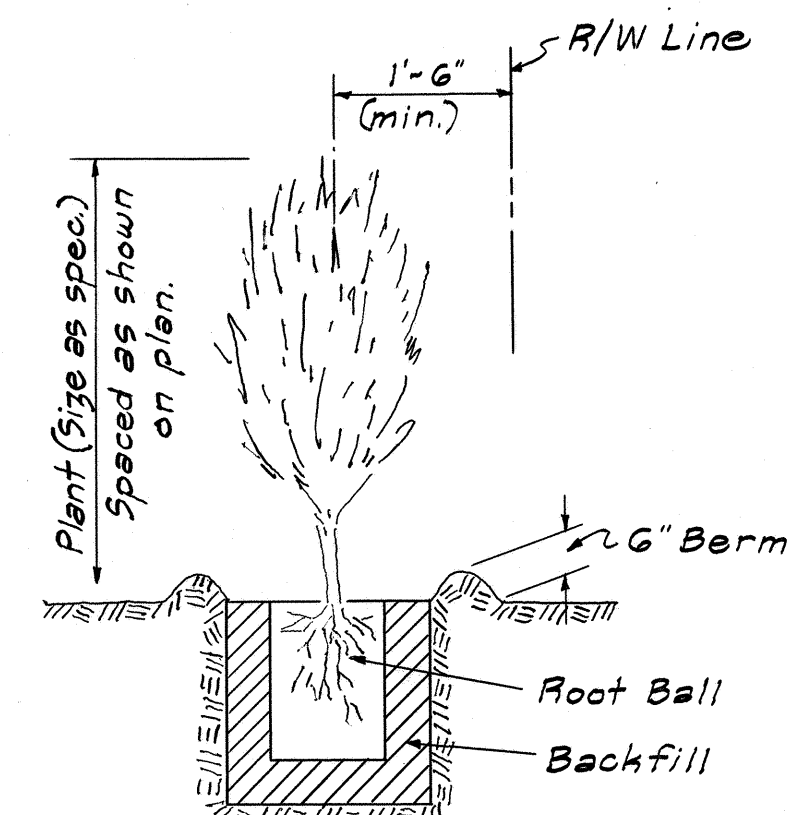

TYPICAL PLANTING DETAIL

Not to Scale

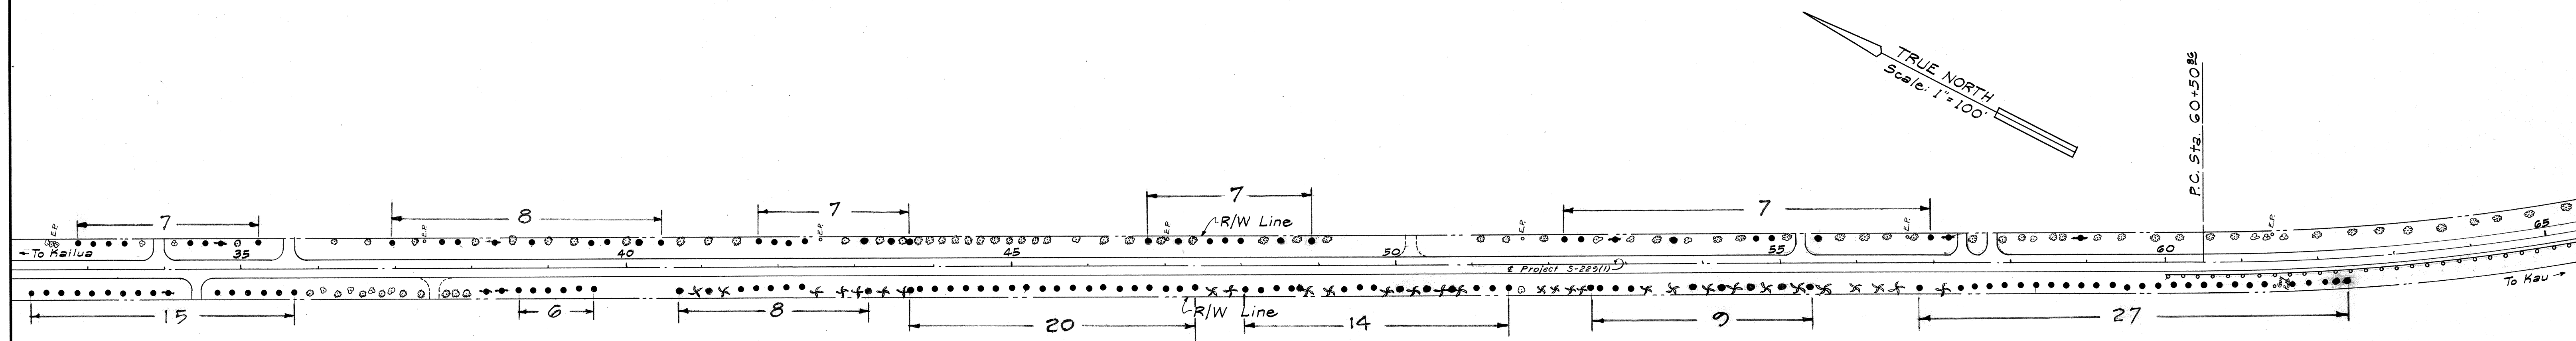

LEGEND: (PROJ. NO. LSF-011-1(1))

- Existing Plumeria Plants
 - Existing Coconut Trees
 - Existing Royal Poinsettia Trees
 - Existing Bougainvillea Plants
 - New Bougainvillea Plants
- Other existing plants are noted on plans.

ESTIMATED QUANTITIES


Bougainvillea (gallon size) 260 each

- Note 1. Bougainvillea shall be furnished in heights of not less than one (1) foot.
2. Plant Bougainvillea spaced 20' apart or as shown on the plans.


STATE OF HAWAII
DEPARTMENT OF TRANSPORTATION
PROJECT NO. LSF-011-1(1)
KUAKINI
HIGHWAY BEAUTIFICATION
A PORTION OF
KUAKINI HIGHWAY
PROJECT NO. S-229(1)
Scale: 1"=100'
SHEET NO. 1 OF 2 SHEETS

ORIGINAL PLAN	SURVEYED BY	DATE
NOTE BOOK	DRAWN BY	
No.	DESIGNED BY	
	CHECKED BY	

FED. ROAD DIST. NO.	STATE	FED. AID PROJ. NO.	FISCAL YEAR	SHEET NO.	TOTAL SHEETS
HAWAII	HAW.	LSF-011-1(1) LSF-019-1(1)	1967	3	7

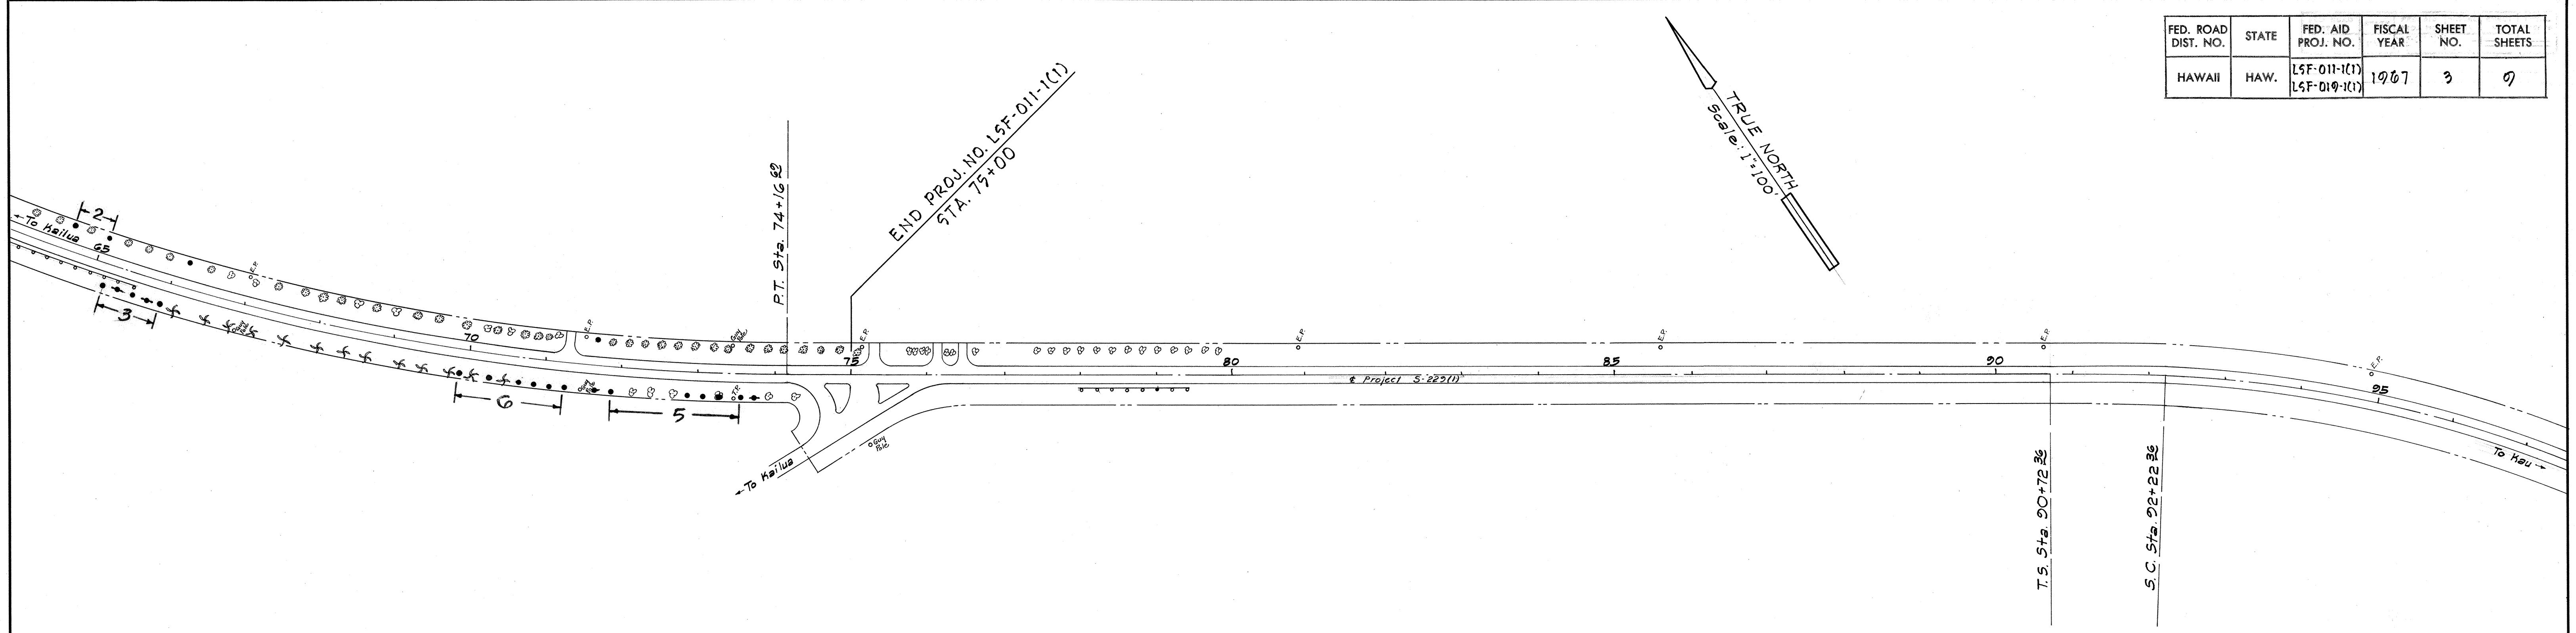


PLANS OF
KUAKINI HIGHWAY BEAUTIFICATION
PROJECT NO LSF-011-1(1)
Scale: As Shown

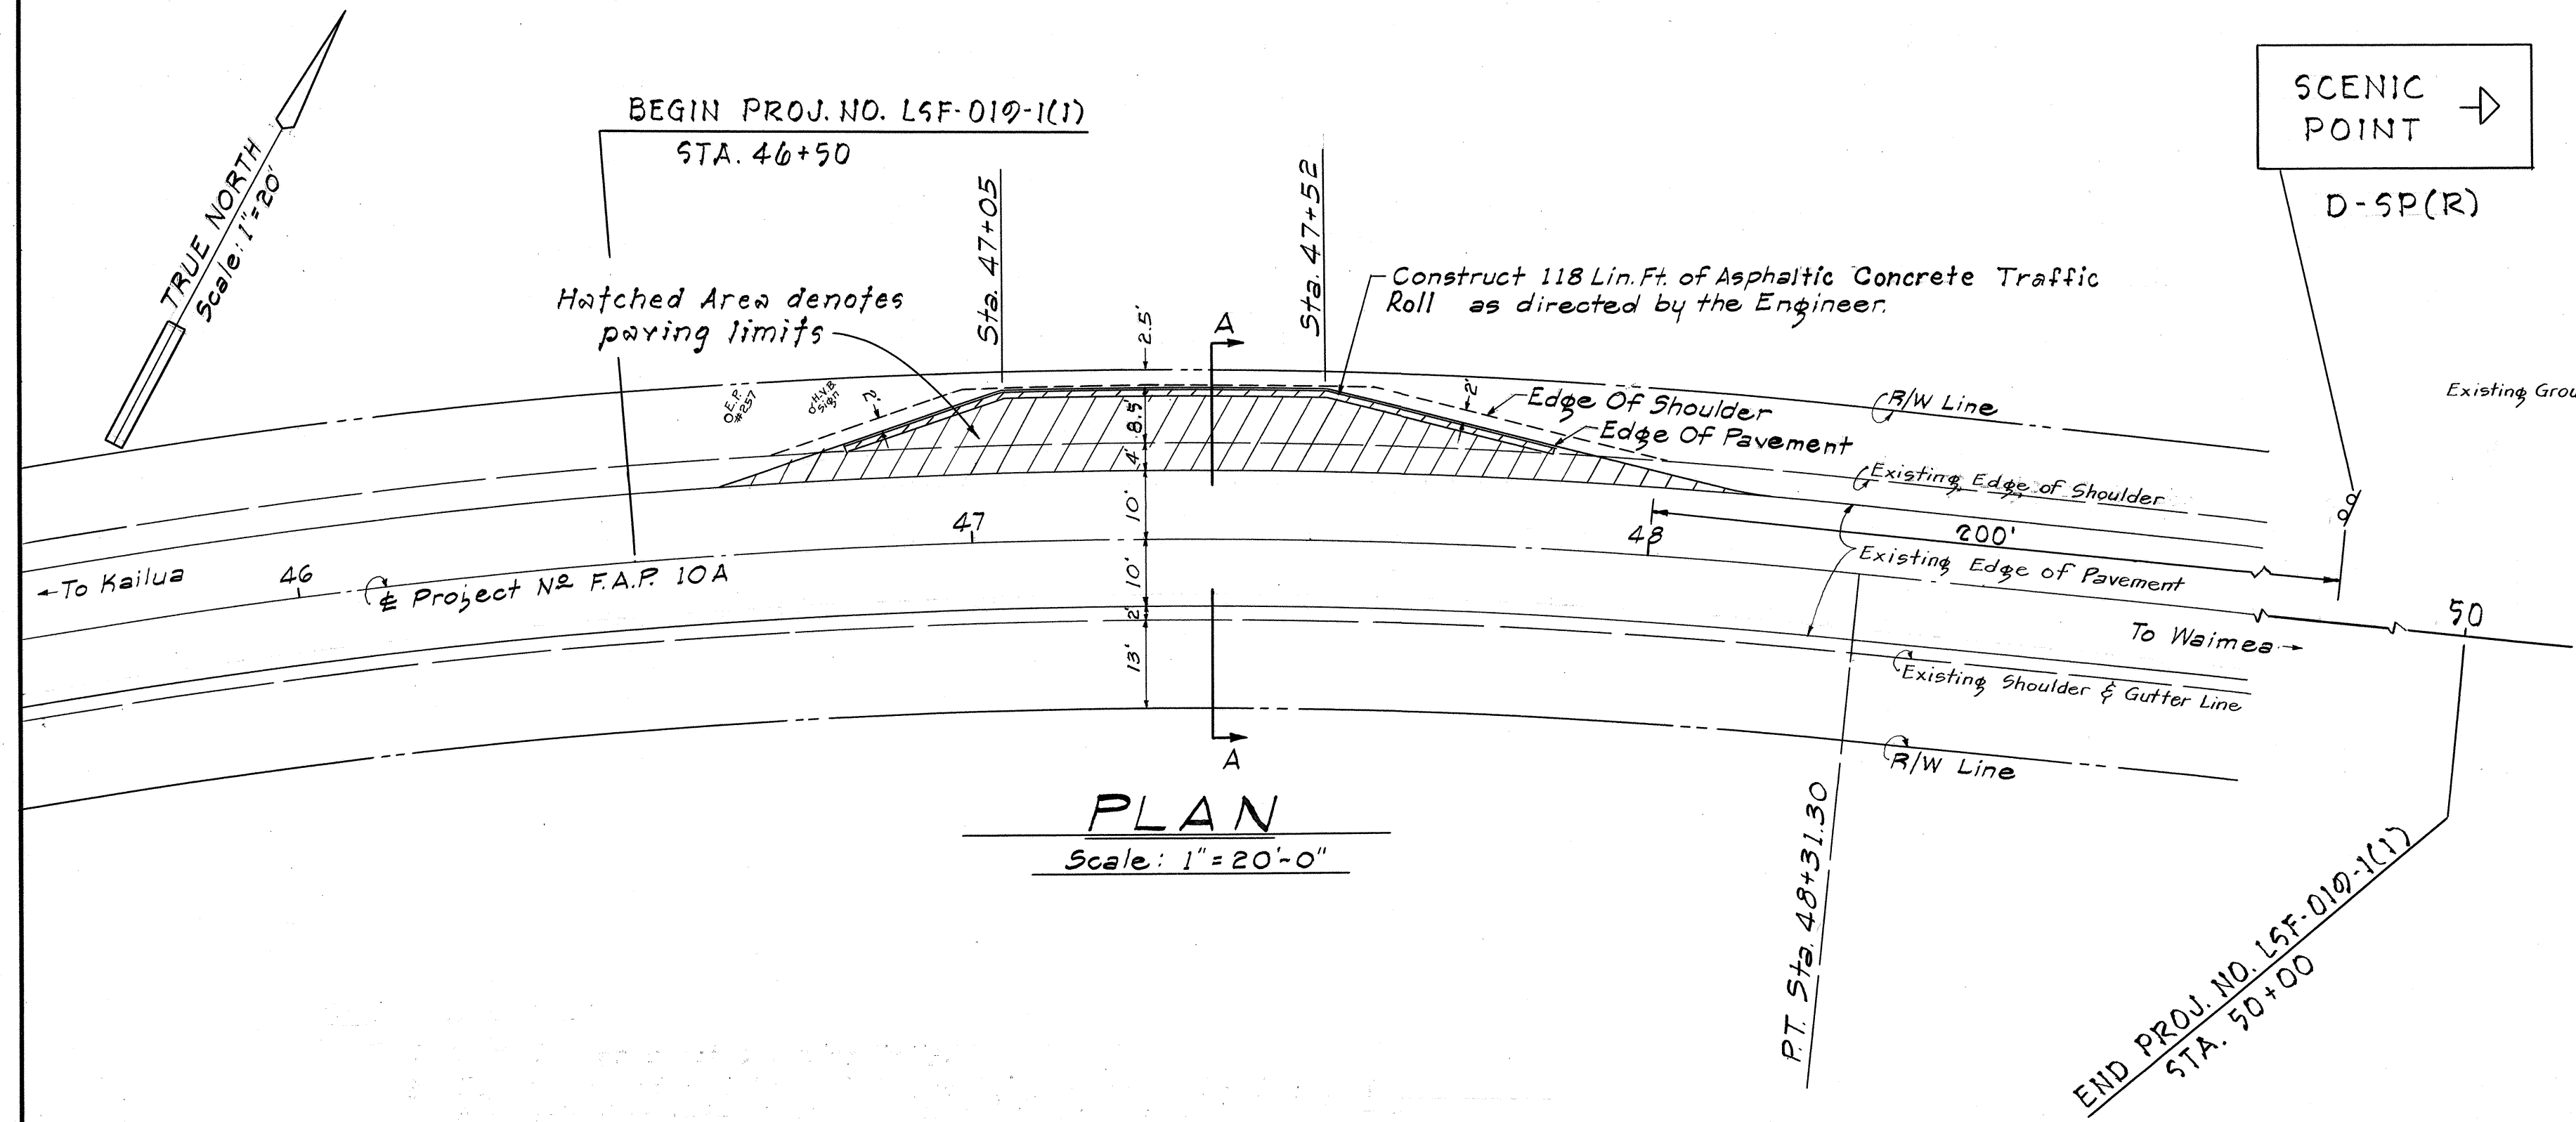


PLAN
Scale: 1" = 20'-0"

SCENIC POINT
D-SP(R)

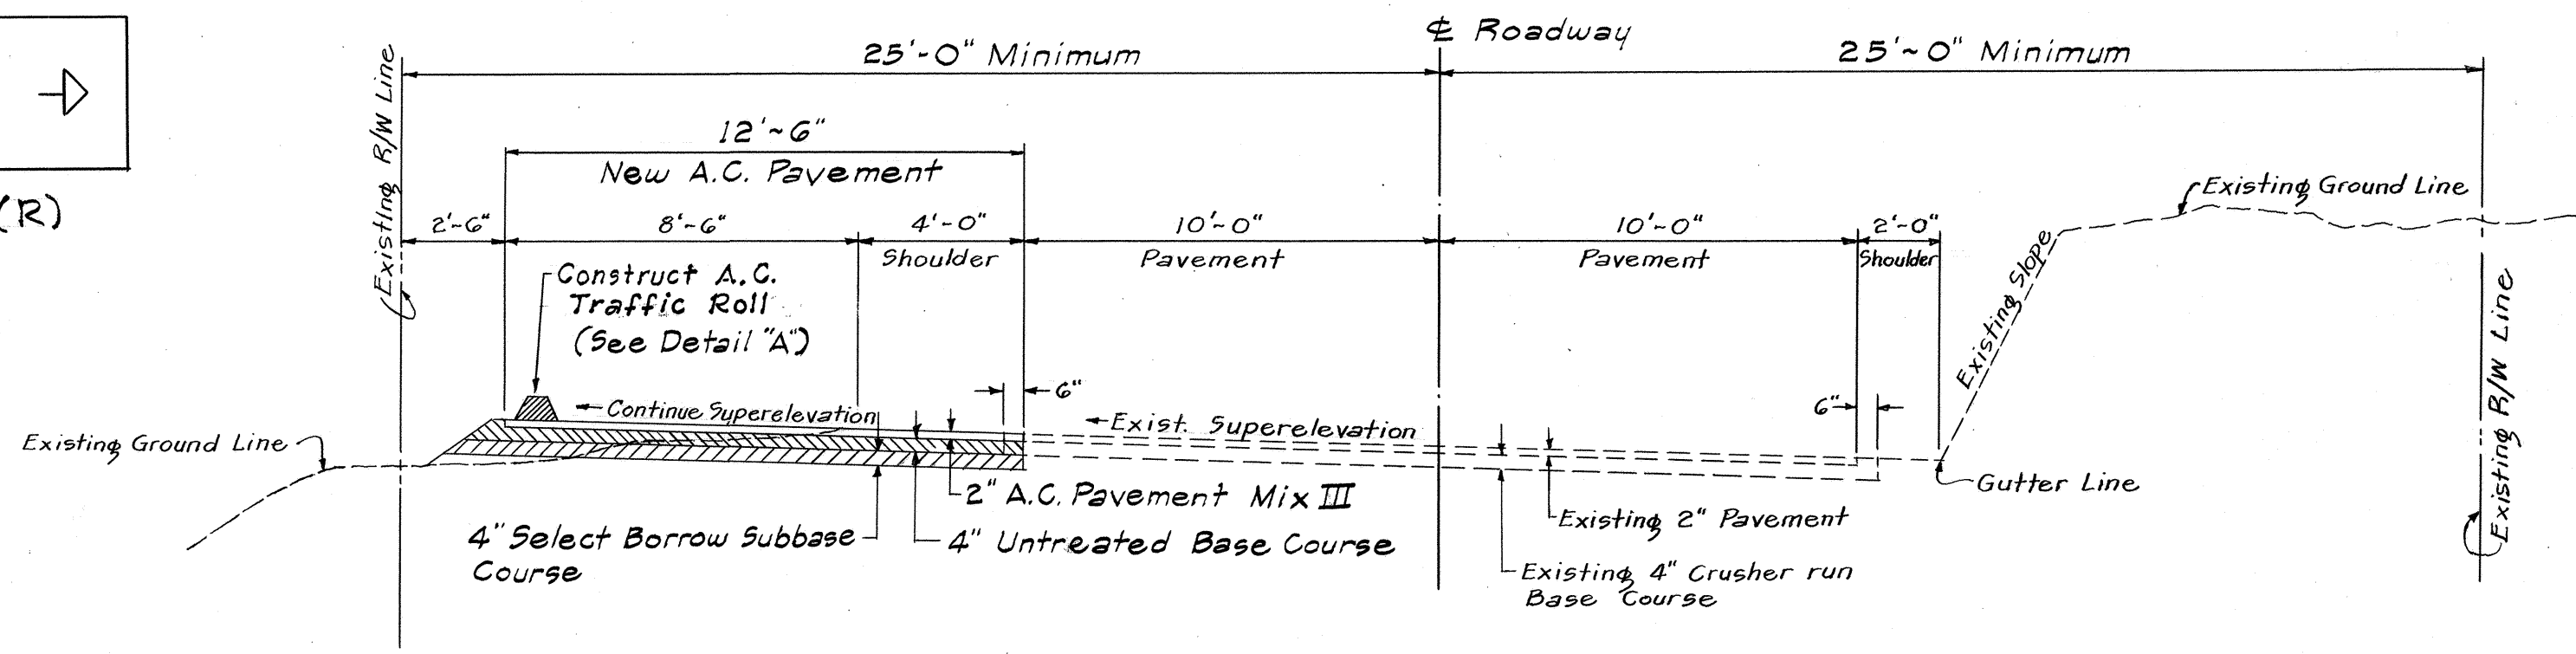

SECTION A-A
Scale: 1/4" = 1'-0"

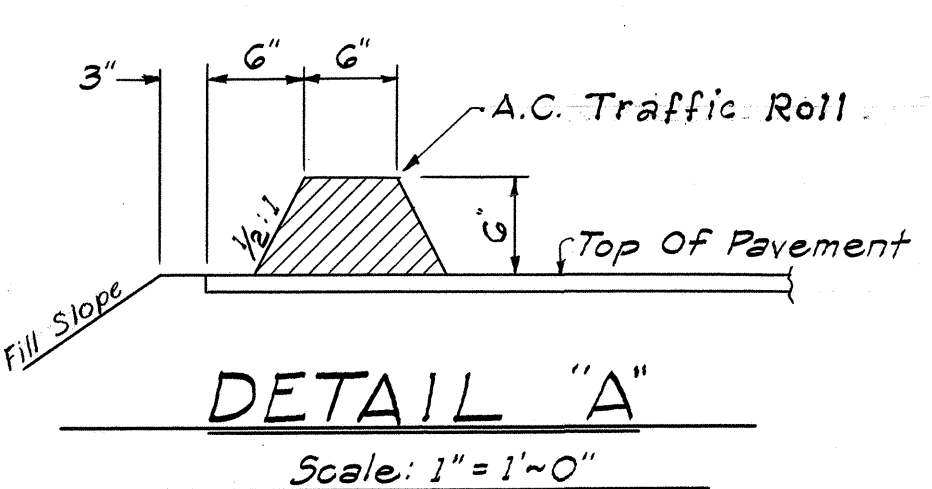

DETAIL "A"
Scale: 1" = 1'-0"

PLANS OF
KIHOLO BAY HIGHWAY BEAUTIFICATION
PROJECT NO LSF-019-1(1)
Scale: As Shown

STATE OF HAWAII
DEPARTMENT OF TRANSPORTATION
PROJECT NO LSF-011-1(1)
PROJECT NO LSF-019-1(1)
HIGHWAY BEAUTIFICATION
PLANS
Scale: As Shown
SHEET NO 2 OF 2 SHEETS

ORIGINAL PLAN	SURVEY PLOTTED BY	DATE
NOTE BOOK	DRAWN BY	
No.	QUANTITIES BY	
	CHECKED BY	