
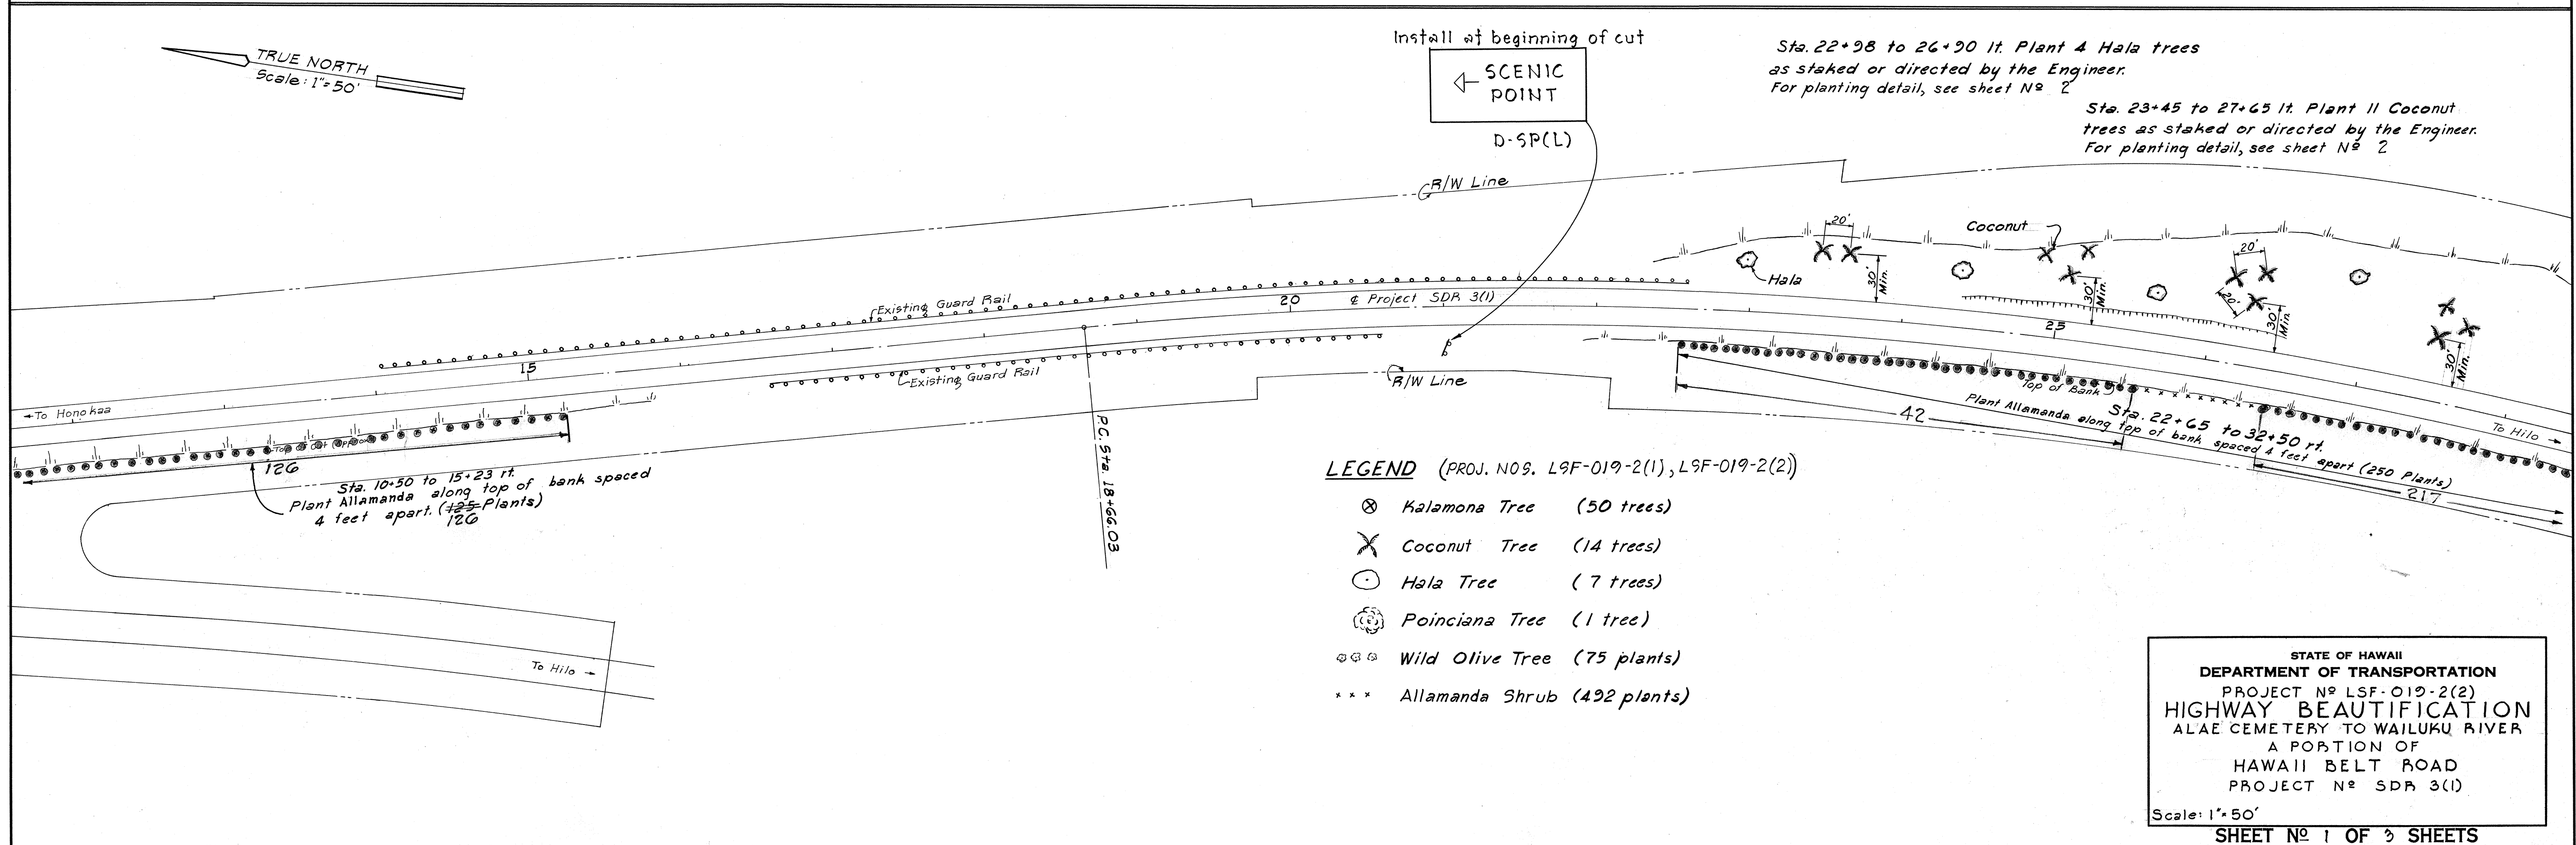


FED. ROAD DIST. NO.	STATE	FED. AID PROJ. NO.	FISCAL YEAR	SHEET NO.	TOTAL SHEETS
HAWAII	HAW.	LSF-019-2(2)	1967	5	9

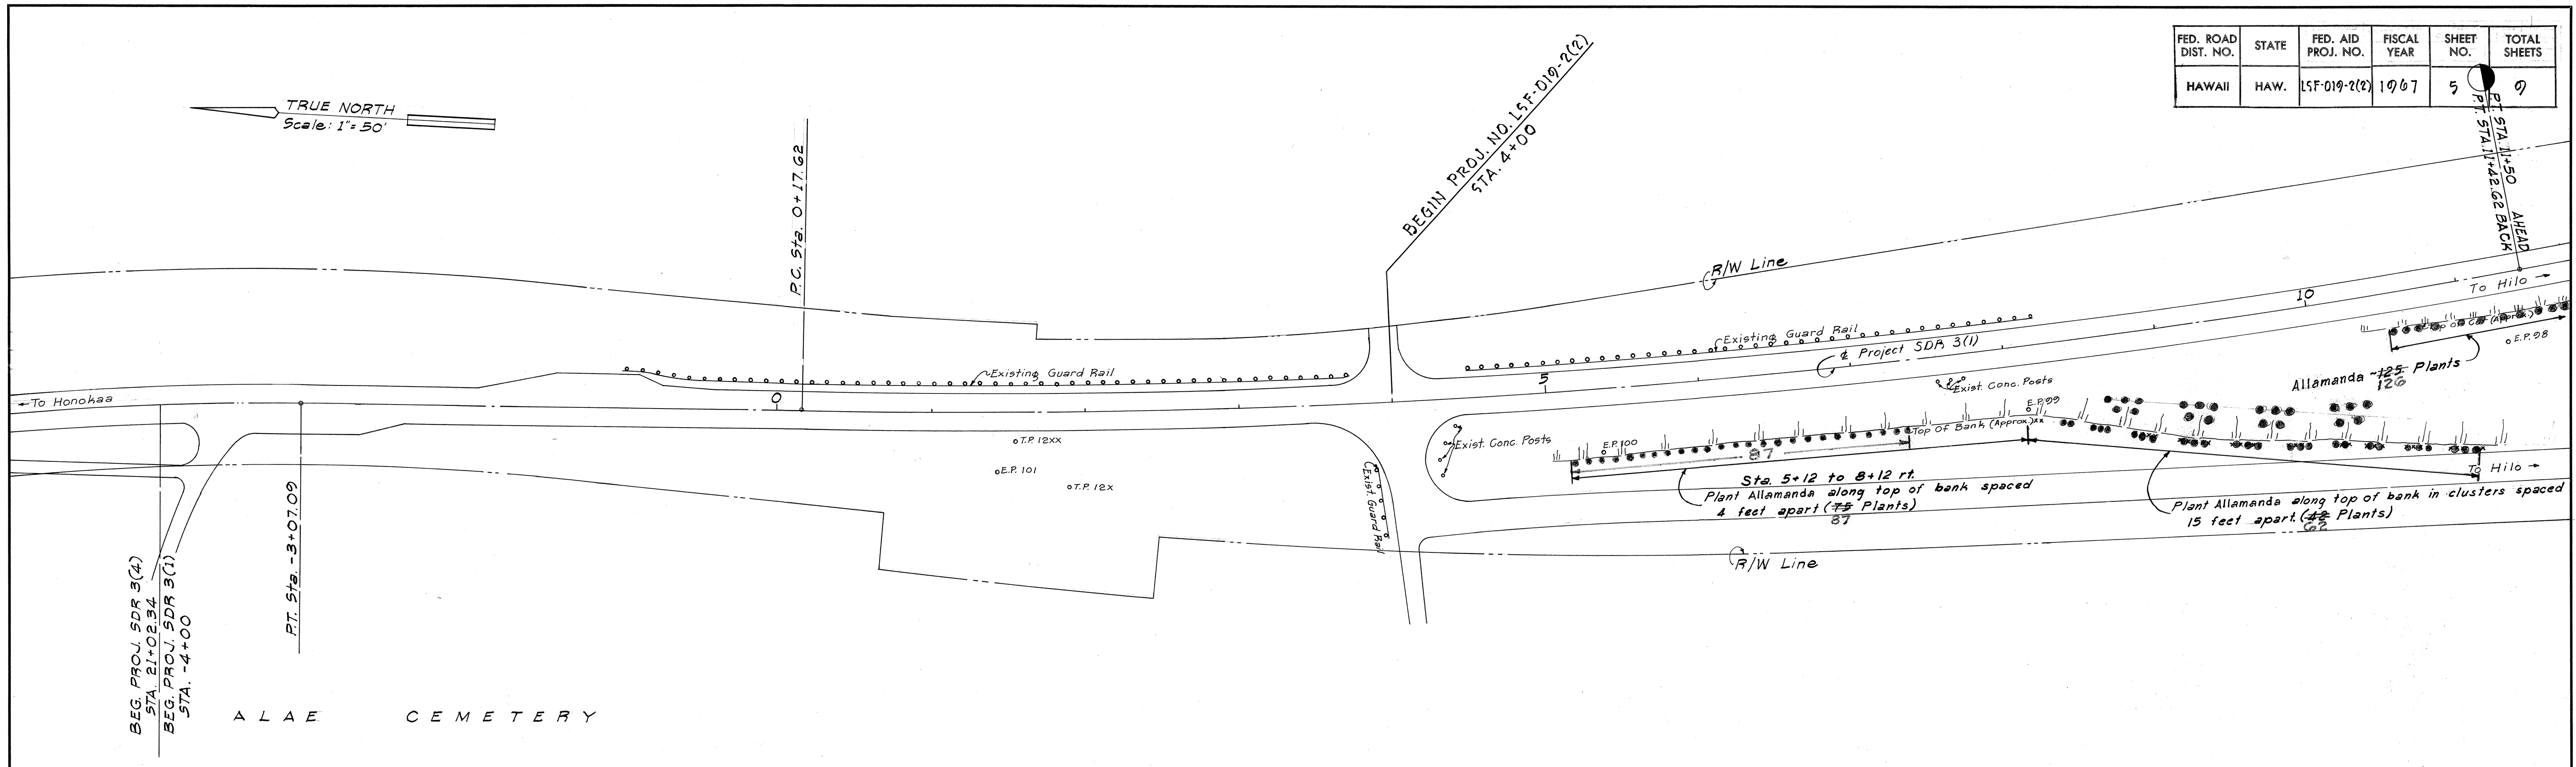



LEGEND (PROJ. NOS. L9F-019-2(1), L9F-019-2(2))

- ⊗ Kalamona Tree (50 trees)
- ✕ Coconut Tree (14 trees)
- Hala Tree (7 trees)
- ⊙ Poinciana Tree (1 tree)
- ⊙ Wild Olive Tree (75 plants)
- *** Allamanda Shrub (492 plants)

STATE OF HAWAII
DEPARTMENT OF TRANSPORTATION
PROJECT NO LSF-019-2(2)
HIGHWAY BEAUTIFICATION
ALAE CEMETERY TO WAILUKU RIVER
A PORTION OF
HAWAII BELT ROAD
PROJECT NO SDR 3(1)
Scale: 1"=50'
SHEET NO 1 OF 3 SHEETS



ORIGINAL PLAN	DATE
NOTED BY	DESIGNED BY
NOTED BY	DESIGNED BY
FED. ROAD DIST. NO.	STATE	FED. AID PROJ. NO.	FISCAL YEAR	SHEET NO.	TOTAL SHEETS
HAWAII	HAW.	LSF-019-2(2)	1967	6	9

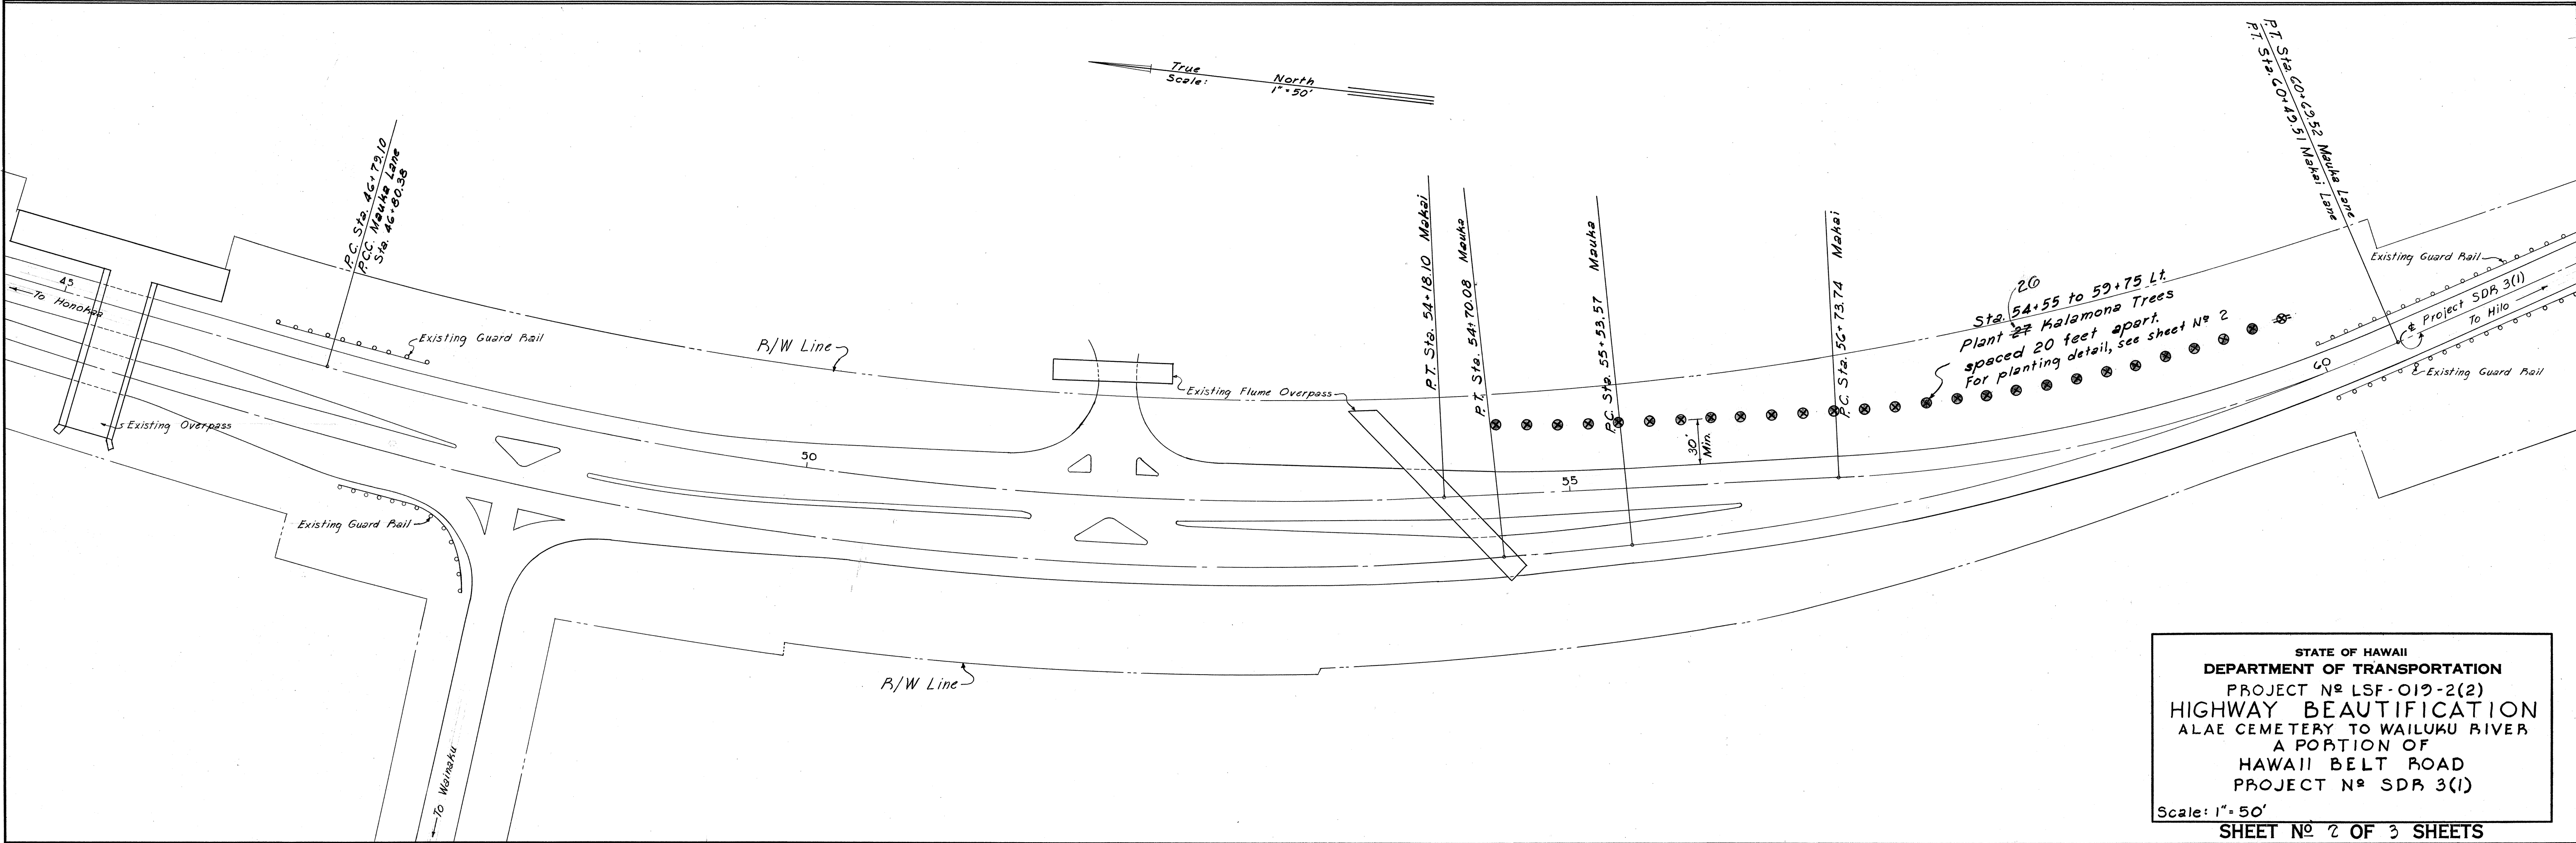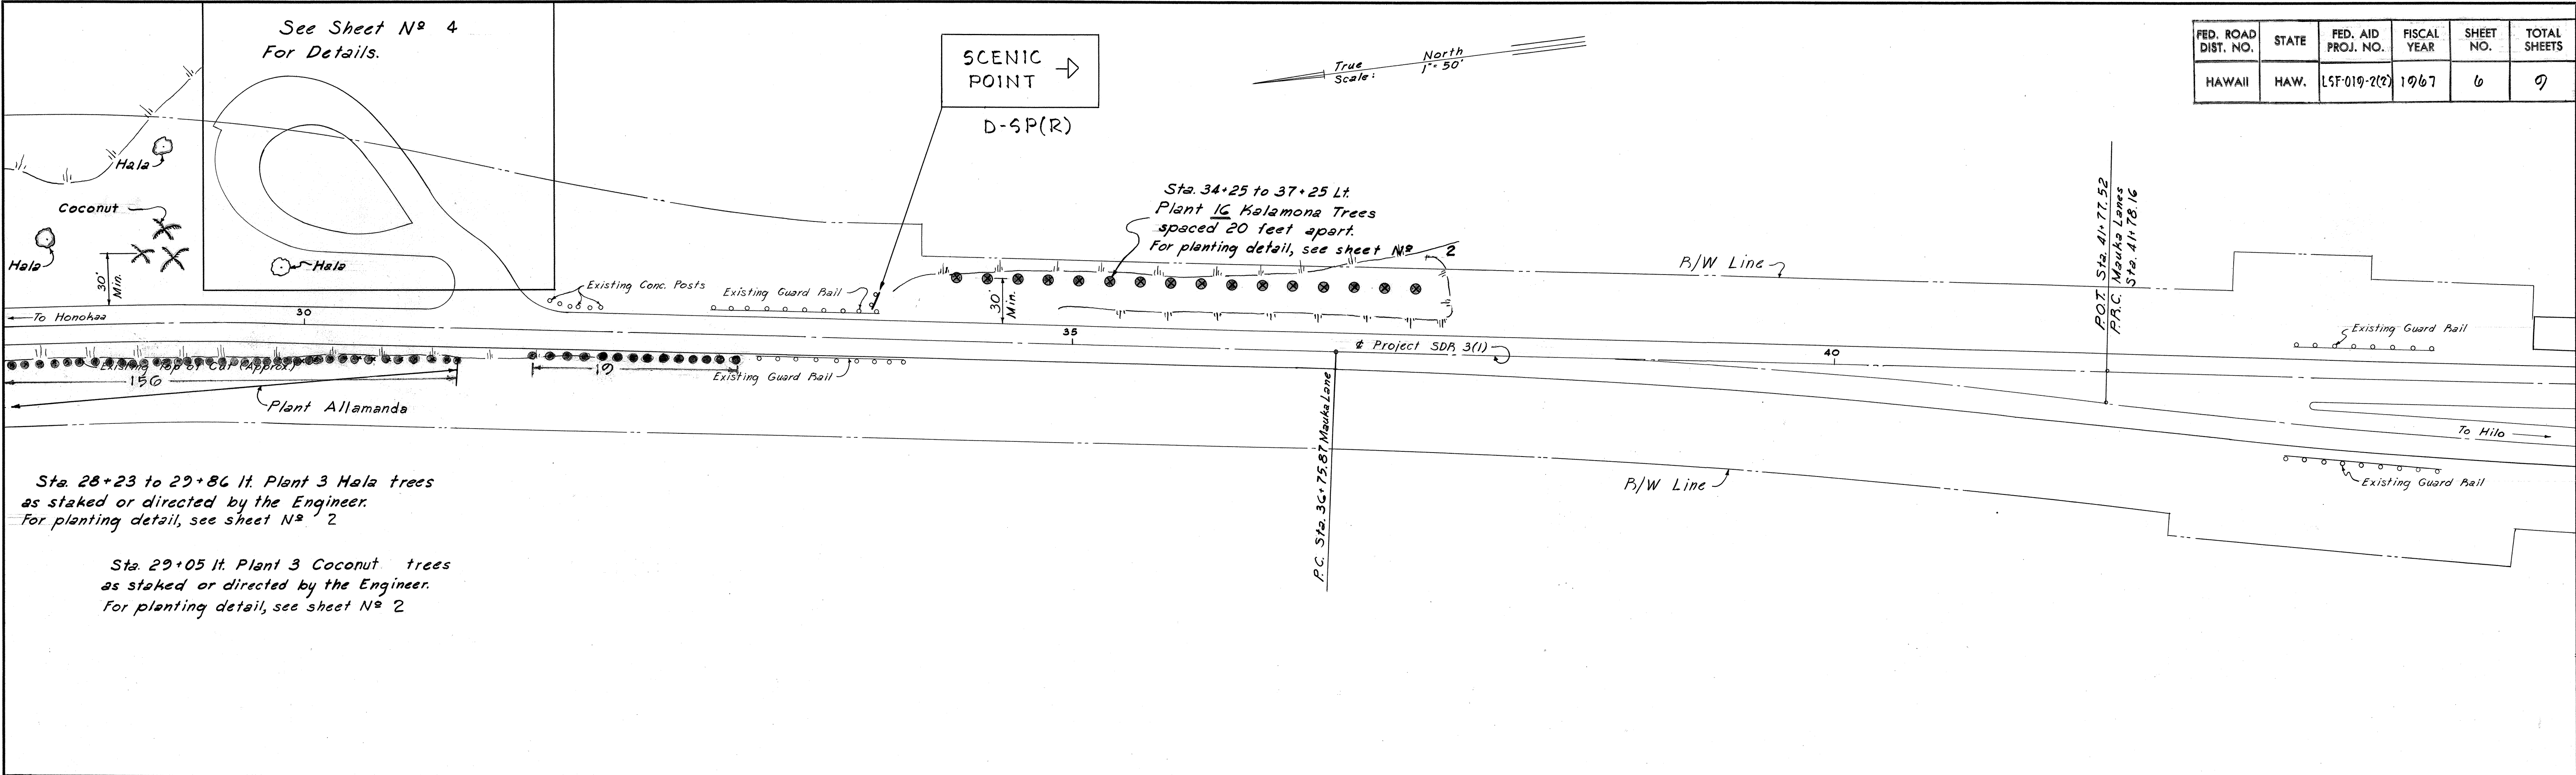

ORIGINAL PLAN	SURVEY PLOTTED BY	DATE
NOTE BOOK	DRAWN BY	
No.	DESIGNED BY	
	CHECKED BY	

FED. ROAD DIST. NO.	STATE	FED. AID PROJ. NO.	FISCAL YEAR	SHEET NO.	TOTAL SHEETS
HAWAII	HAW.	LSF-019-2(2)	1967	7	9

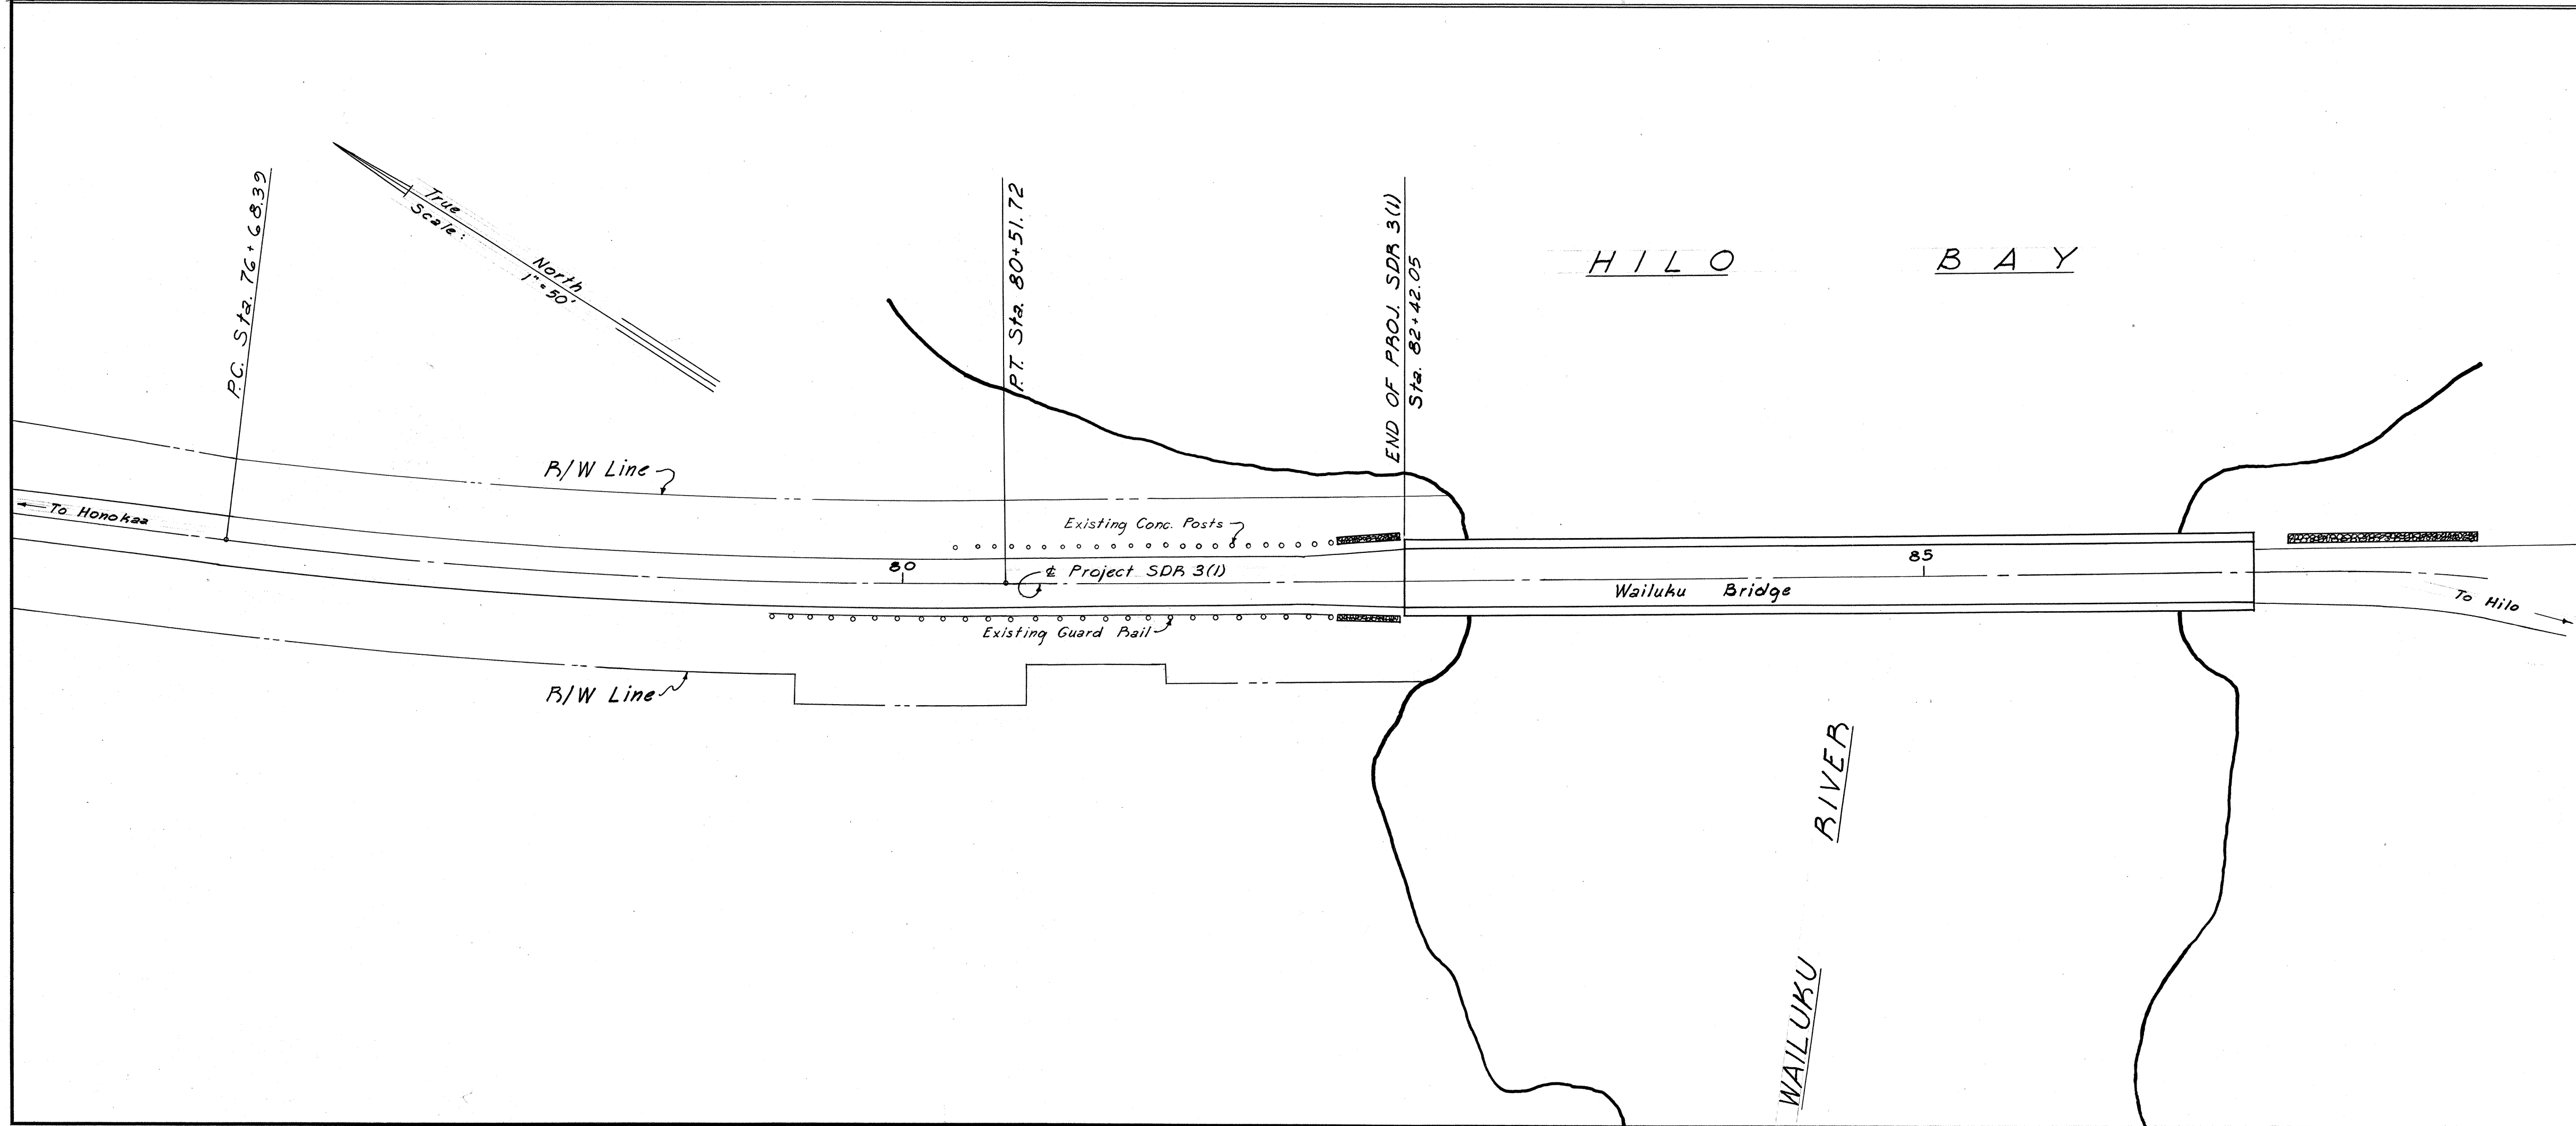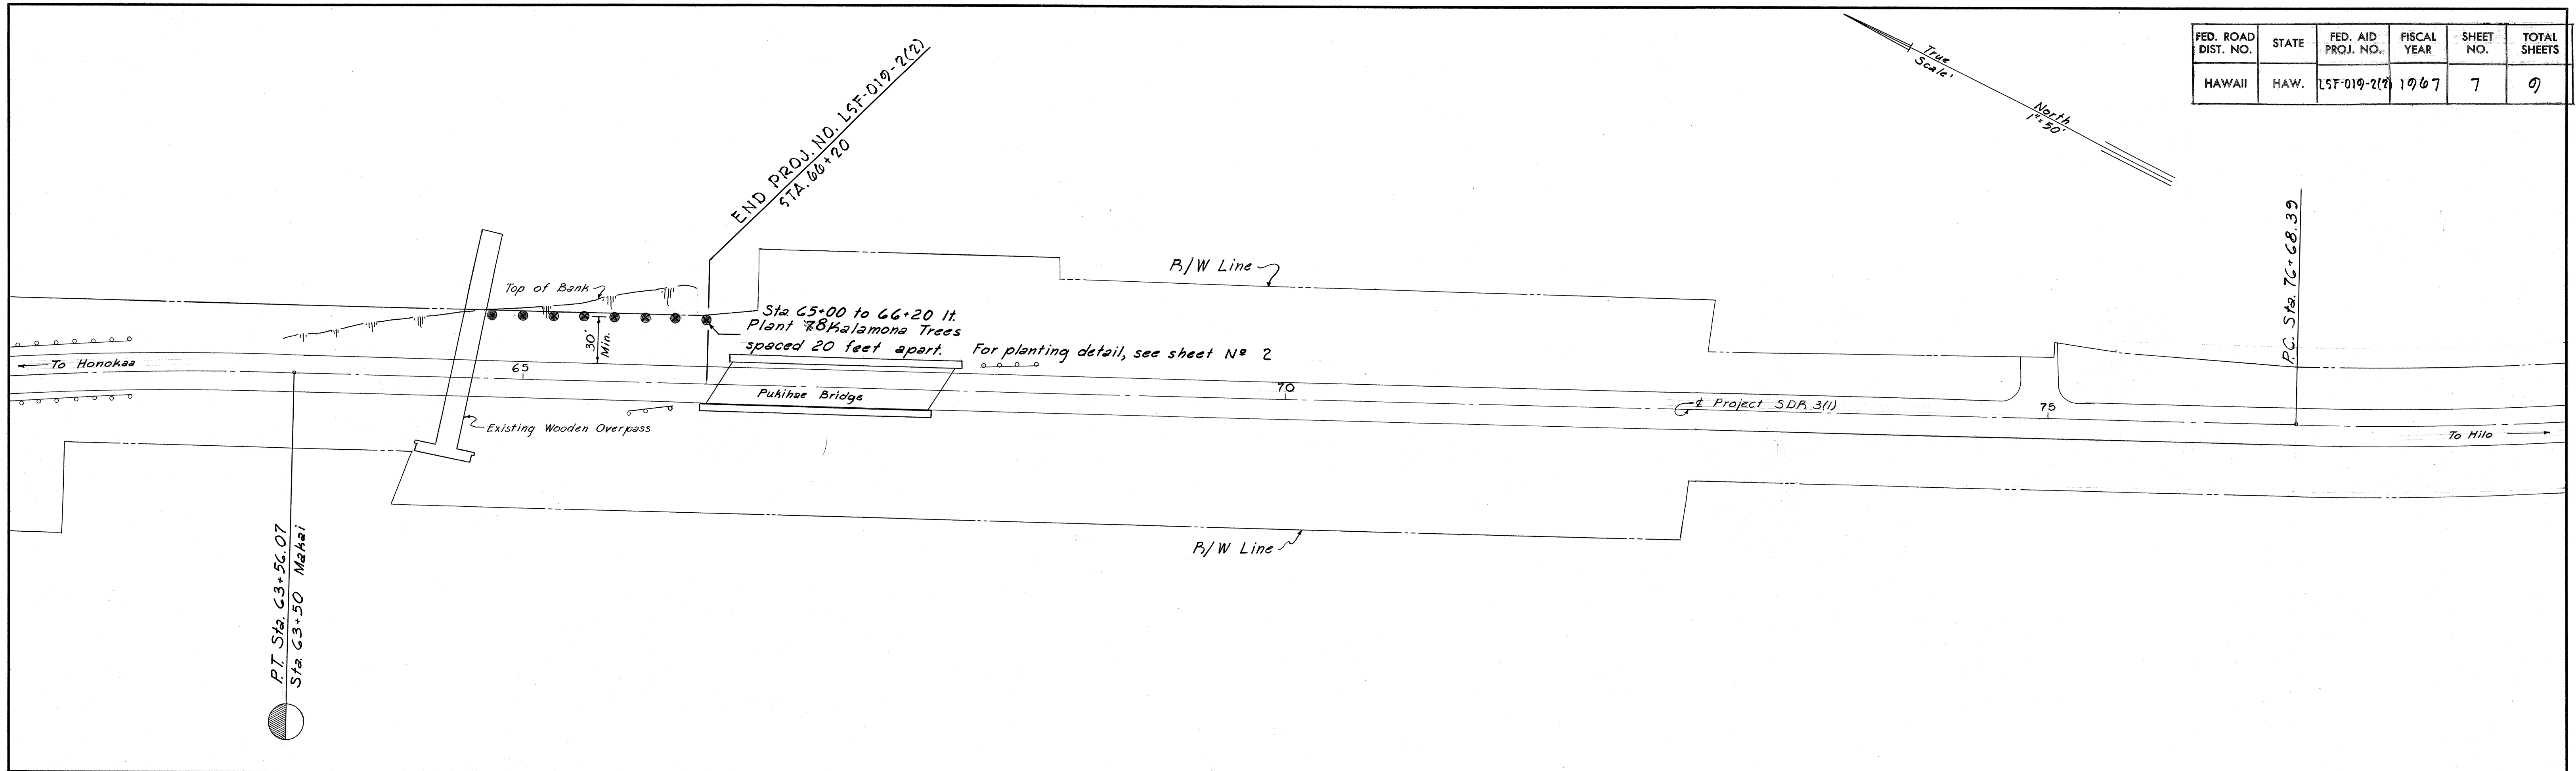

ORIGINAL PLAN	DATE
DESIGNED BY	
TRACED BY	
NOTE BOOK	
QUANTITIES BY	
CHECKED BY	
No.	

STATE OF HAWAII
DEPARTMENT OF TRANSPORTATION
PROJECT No LSF-019-2(2)
HIGHWAY BEAUTIFICATION
ALAE CEMETERY TO WAILUKU RIVER
A PORTION OF
HAWAII BELT ROAD
PROJECT No SDR 3(1)
Scale: 1"=50'
SHEET No. 3 OF 3 SHEETS