

INDEX TO DRAWINGS	
SHEET	DESCRIPTION
1	TITLE SHEET
2-3	PROJ. NO. LSF-011-1 (1) AND PROJ. NO. LSF-019-1 (1)
4	PROJ. NO. LSF-019-2 (1)
5-7	PROJ. NO. LSF-019-2 (2)
8-9	DIRECTIONAL SIGN AND STANDARD DETAILS

STATE OF HAWAII
DEPARTMENT OF TRANSPORTATION

"AS BUILT" PLANS OF
HAWAII FEDERAL AID
LANDSCAPING AND SCENIC ENHANCEMENT PROGRAM


ROUTE 11:
KUAKINI HIGHWAY
PROJ. NO. LSF - 011-1 (1)

ROUTE 19:
KIHOLO BAY
PROJ. NO. LSF-019-1 (1)

ROUTE 19:
WAINAKU
PROJ. NO. LSF-019-2 (1)

ROUTE 19:
ALAE CEMETERY TO WAILUKU RIVER
PROJ. NO. LSF-019-2 (2)

ISLAND OF HAWAII

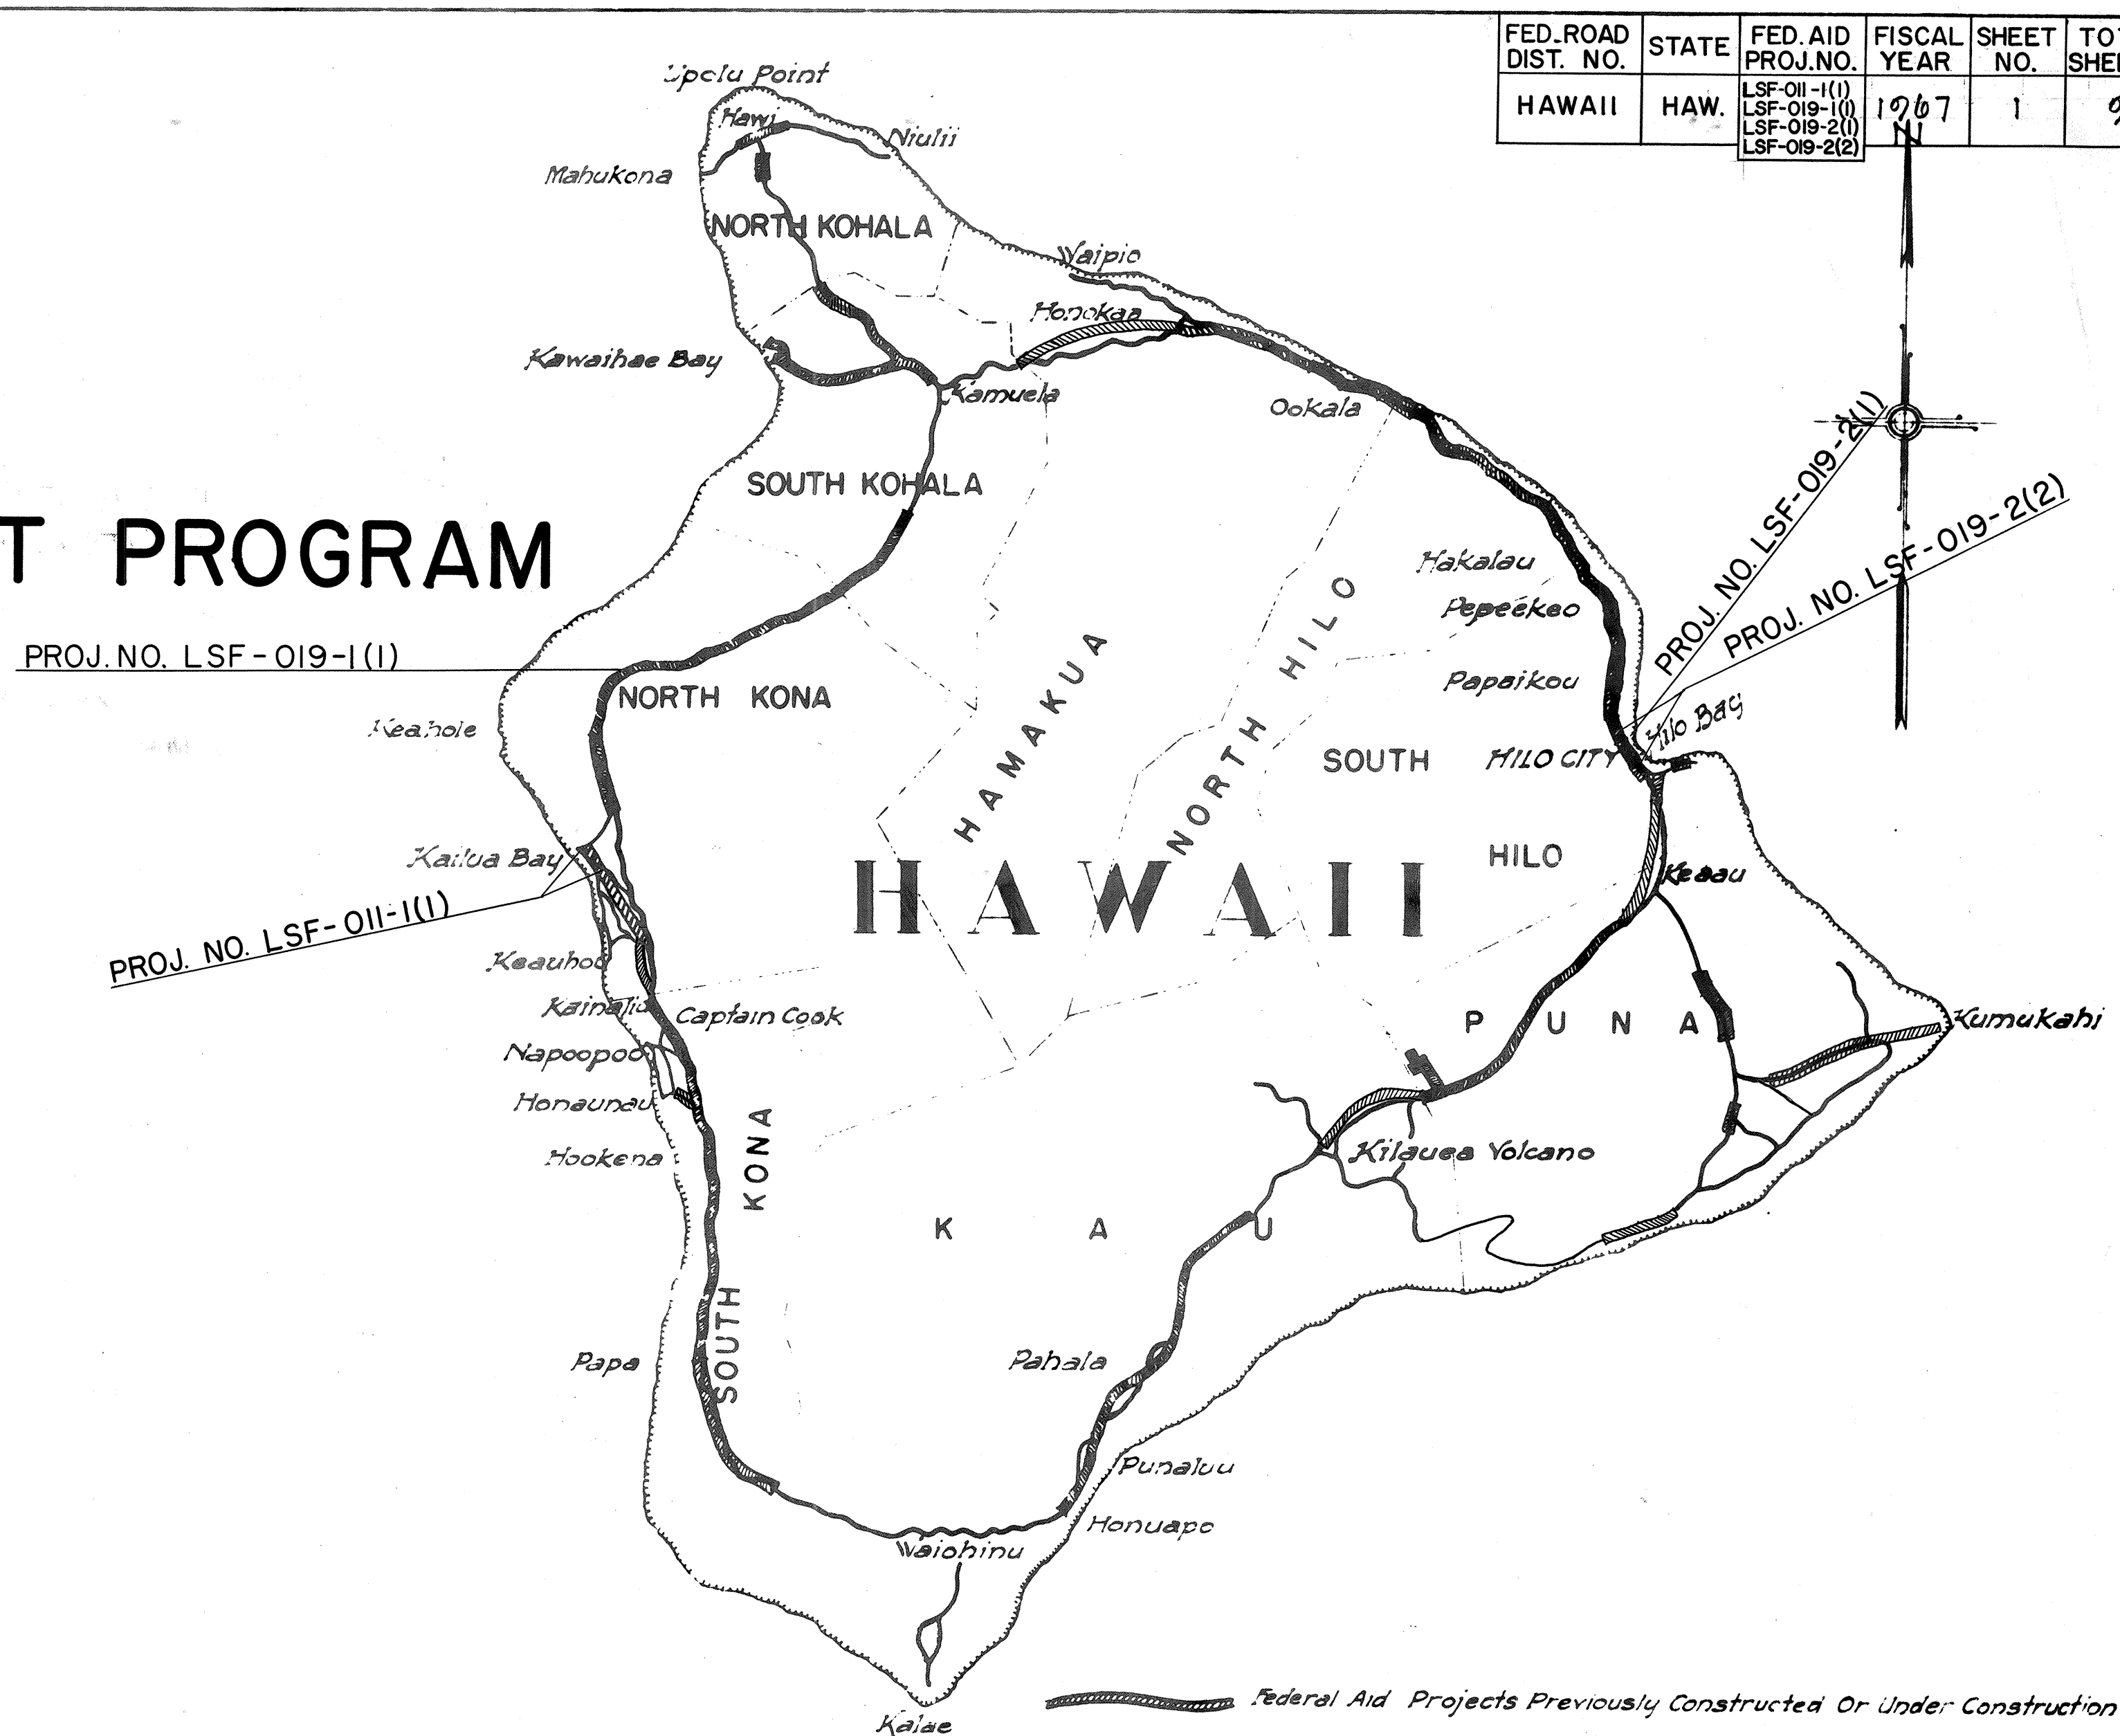

GENERAL LOCATION PLAN

NOTE:
ALL CHANGES MADE DURING CONSTRUCTION
HAVE BEEN NOTED IN RED ON THESE TRACINGS
AND CHECKED BY:

[Signature]
PROJECT ENGINEER
7/27/71
DATE

- GENERAL NOTES
1. PAINTING OF ASPHALTIC CONCRETE TRAFFIC ROLL TO BE DONE BY OTHERS.
 2. LOCATION OF "SCENIC POINT" AND "STOP" SIGNS ARE APPROXIMATE. EXACT LOCATION TO BE DETERMINED BY THE ENGINEER.
 3. TREES SHALL BE PLANTED AT A MINIMUM OF 30 FT. FROM THE EDGE OF PAVEMENT, UNLESS OTHERWISE NOTED ON THE PLANS.

LENGTH OF PROJECT NO. LSF-011-1 (1) 1.420 Miles
LENGTH OF PROJECT NO. LSF-019-1 (1) 0.066 Miles
LENGTH OF PROJECT NO. LSF-019-2 (1) 0.050 Miles
LENGTH OF PROJECT NO. LSF-019-2 (2) 1.178 Miles

APPROVED: *[Signature]* DATE 6-14-67
DIRECTOR OF TRANSPORTATION

DEPARTMENT OF TRANSPORTATION
BUREAU OF PUBLIC ROADS
APPROVED: *[Signature]* 6-30-67
DIVISION ENGINEER DATE

SEAL OF THE STATE OF HAWAII
DESIGNED BY: A. Marufani
DRAWN BY: A. Marufani
CHECKED BY: A. Marufani
DATE: June 67