

INDEX TO DRAWINGS	
SHEET NO.	DESCRIPTION
1	TITLE SHEET
2-3	INTERSECTION IMPROVEMENTS
4-7	MISCELLANEOUS DETAILS

STATE OF HAWAII

DEPARTMENT OF TRANSPORTATION

HIGHWAYS DIVISION

"AS BUILT"

PLANS FOR

CONSTRUCTION OF

INTERSECTION IMPROVEMENTS

ON


KAMEHAMEHA AVENUE

AT KANOELEHUA AVENUE


PROJ. NO. IIP-01-70(R)

DISTRICT OF SOUTH HILO

ISLAND OF HAWAII

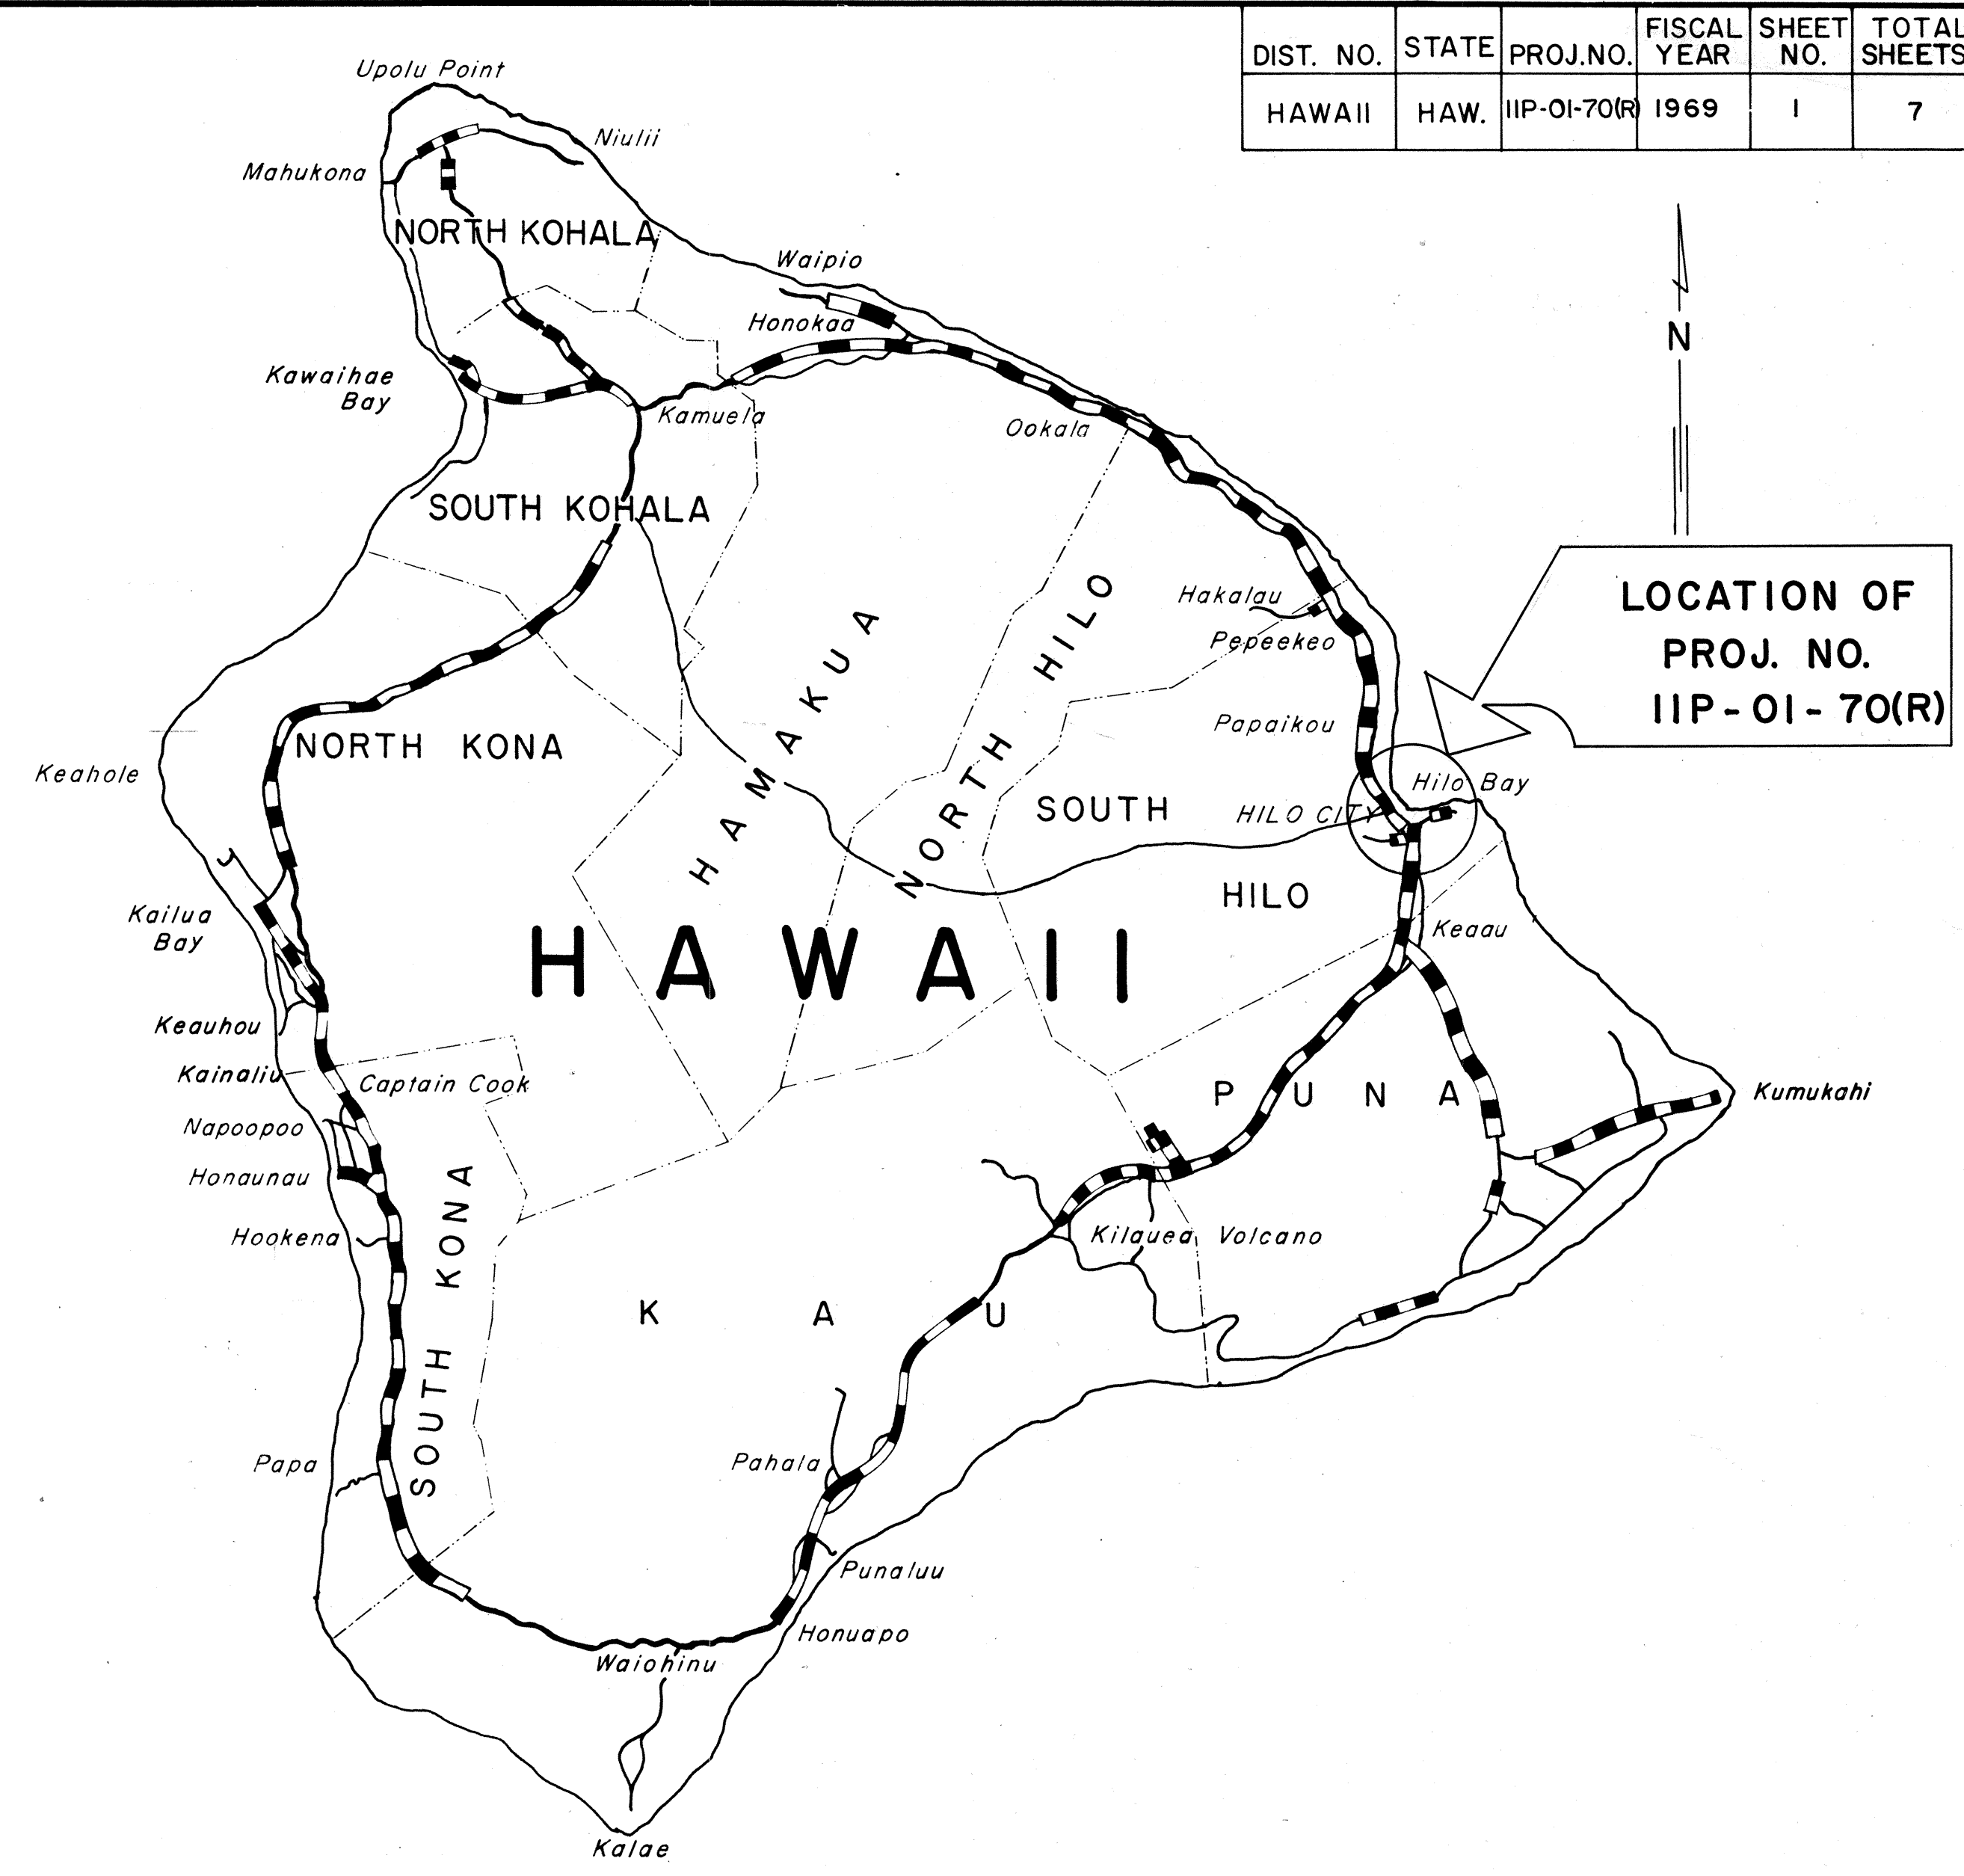

DIST. NO.	STATE	PROJ. NO.	FISCAL YEAR	SHEET NO.	TOTAL SHEETS
HAWAII	HAW.	IIP-01-70(R)	1969	1	7

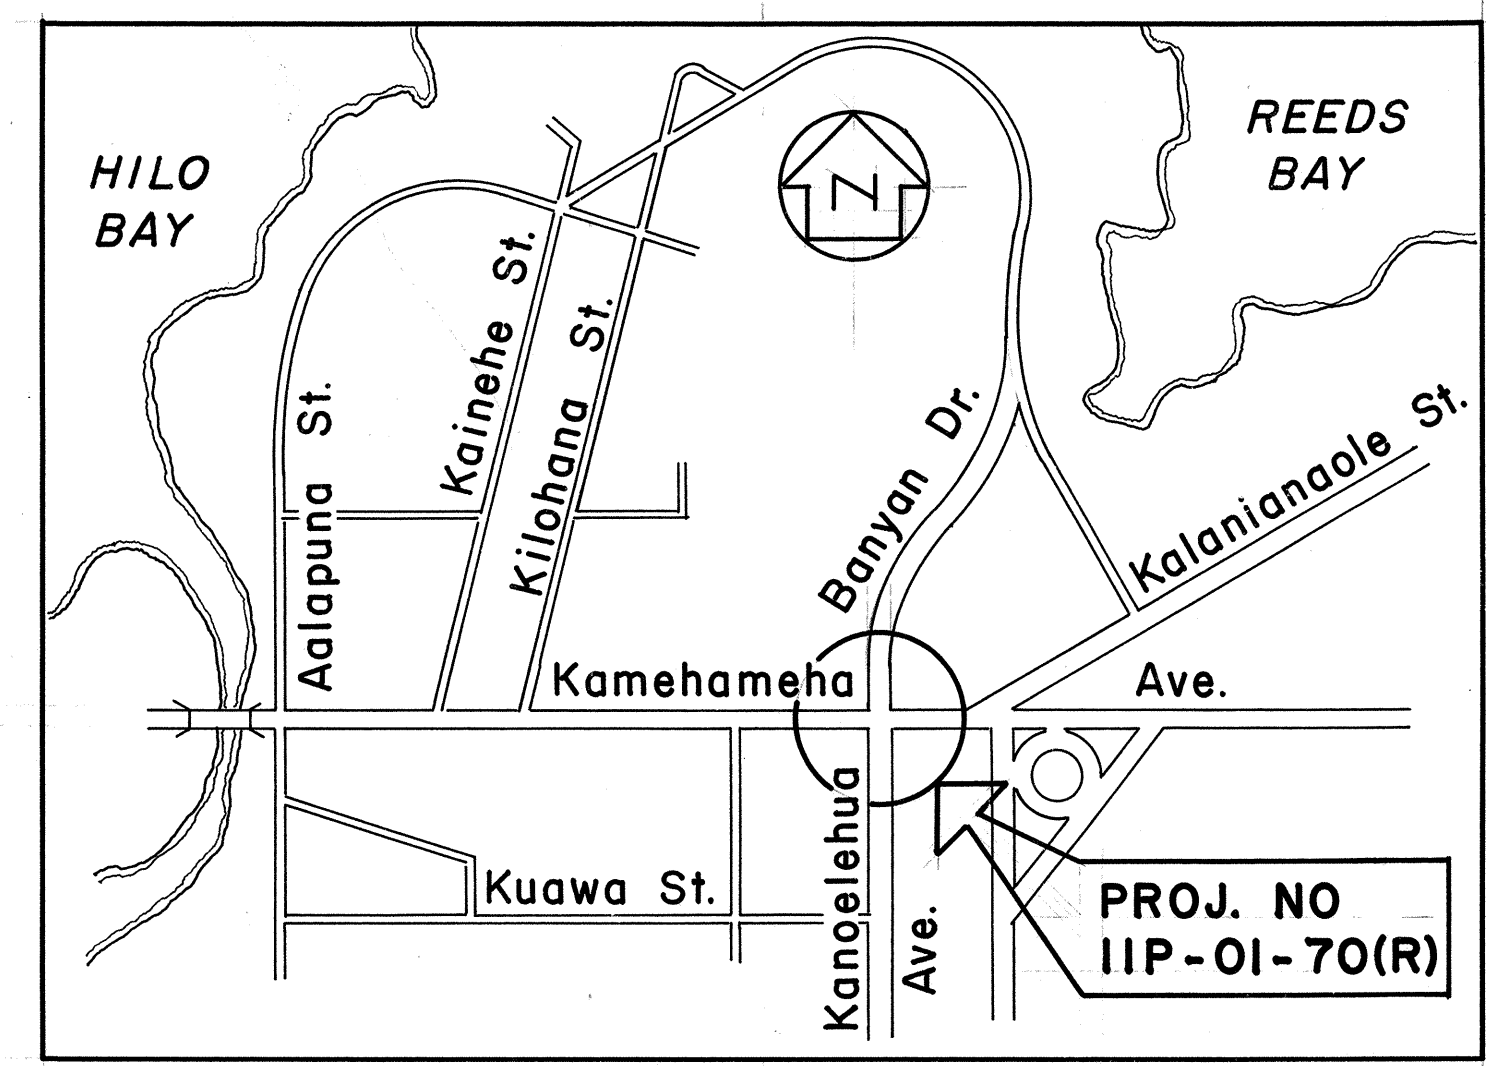

LAYOUT PLAN

SCALE IN MILES

Federal Aid Projects Previously Constructed Or Under Construction

ALL CHANGES MADE DURING CONSTRUCTION

HAVE BEEN NOTED IN RED ON THESE TRACINGS

AND CHECKED BY

Dan K. Kodani

RESIDENT ENGINEER

4-28-82

DATE

DEPARTMENT OF TRANSPORTATION

STATE OF HAWAII

APPROVED:

E. Alvey Wright

2/13/70

for DIR. OF TRANSPORTATION

DATE

DESIGNED BY: TRAFFIC DESIGN SECTION

P.S. & E. BY: M. Miura, Hwy. Design Unit "C"

Phone: 5482211 Local: 301

DESIGNED BY: