



FED. ROAD DIST. NO.	STATE	FED. AID PROJ. NO.	FISCAL YEAR	SHEET NO.	TOTAL SHEETS
HAWAII	HAW.	11M-01-71 19HJ-01-71 190B-01-71 190B-02-71	1971	3	7

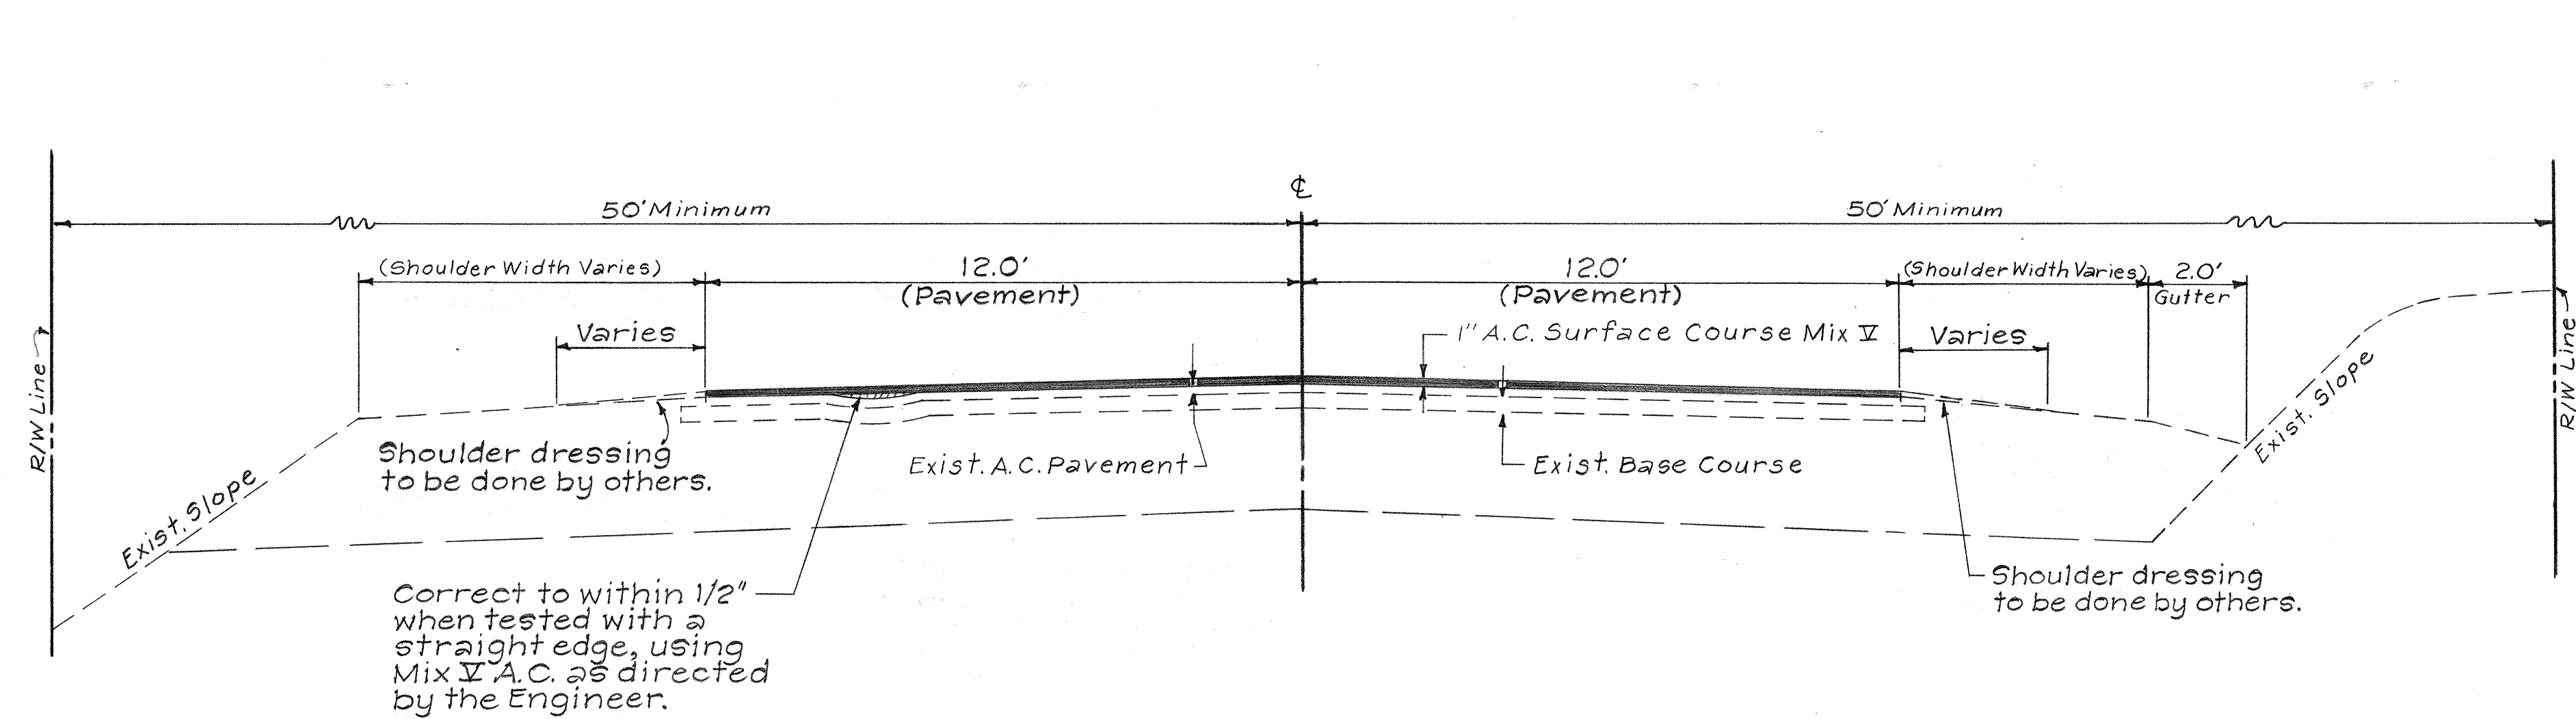


TYPICAL SECTION
Scale: 3/8"=1'-0"

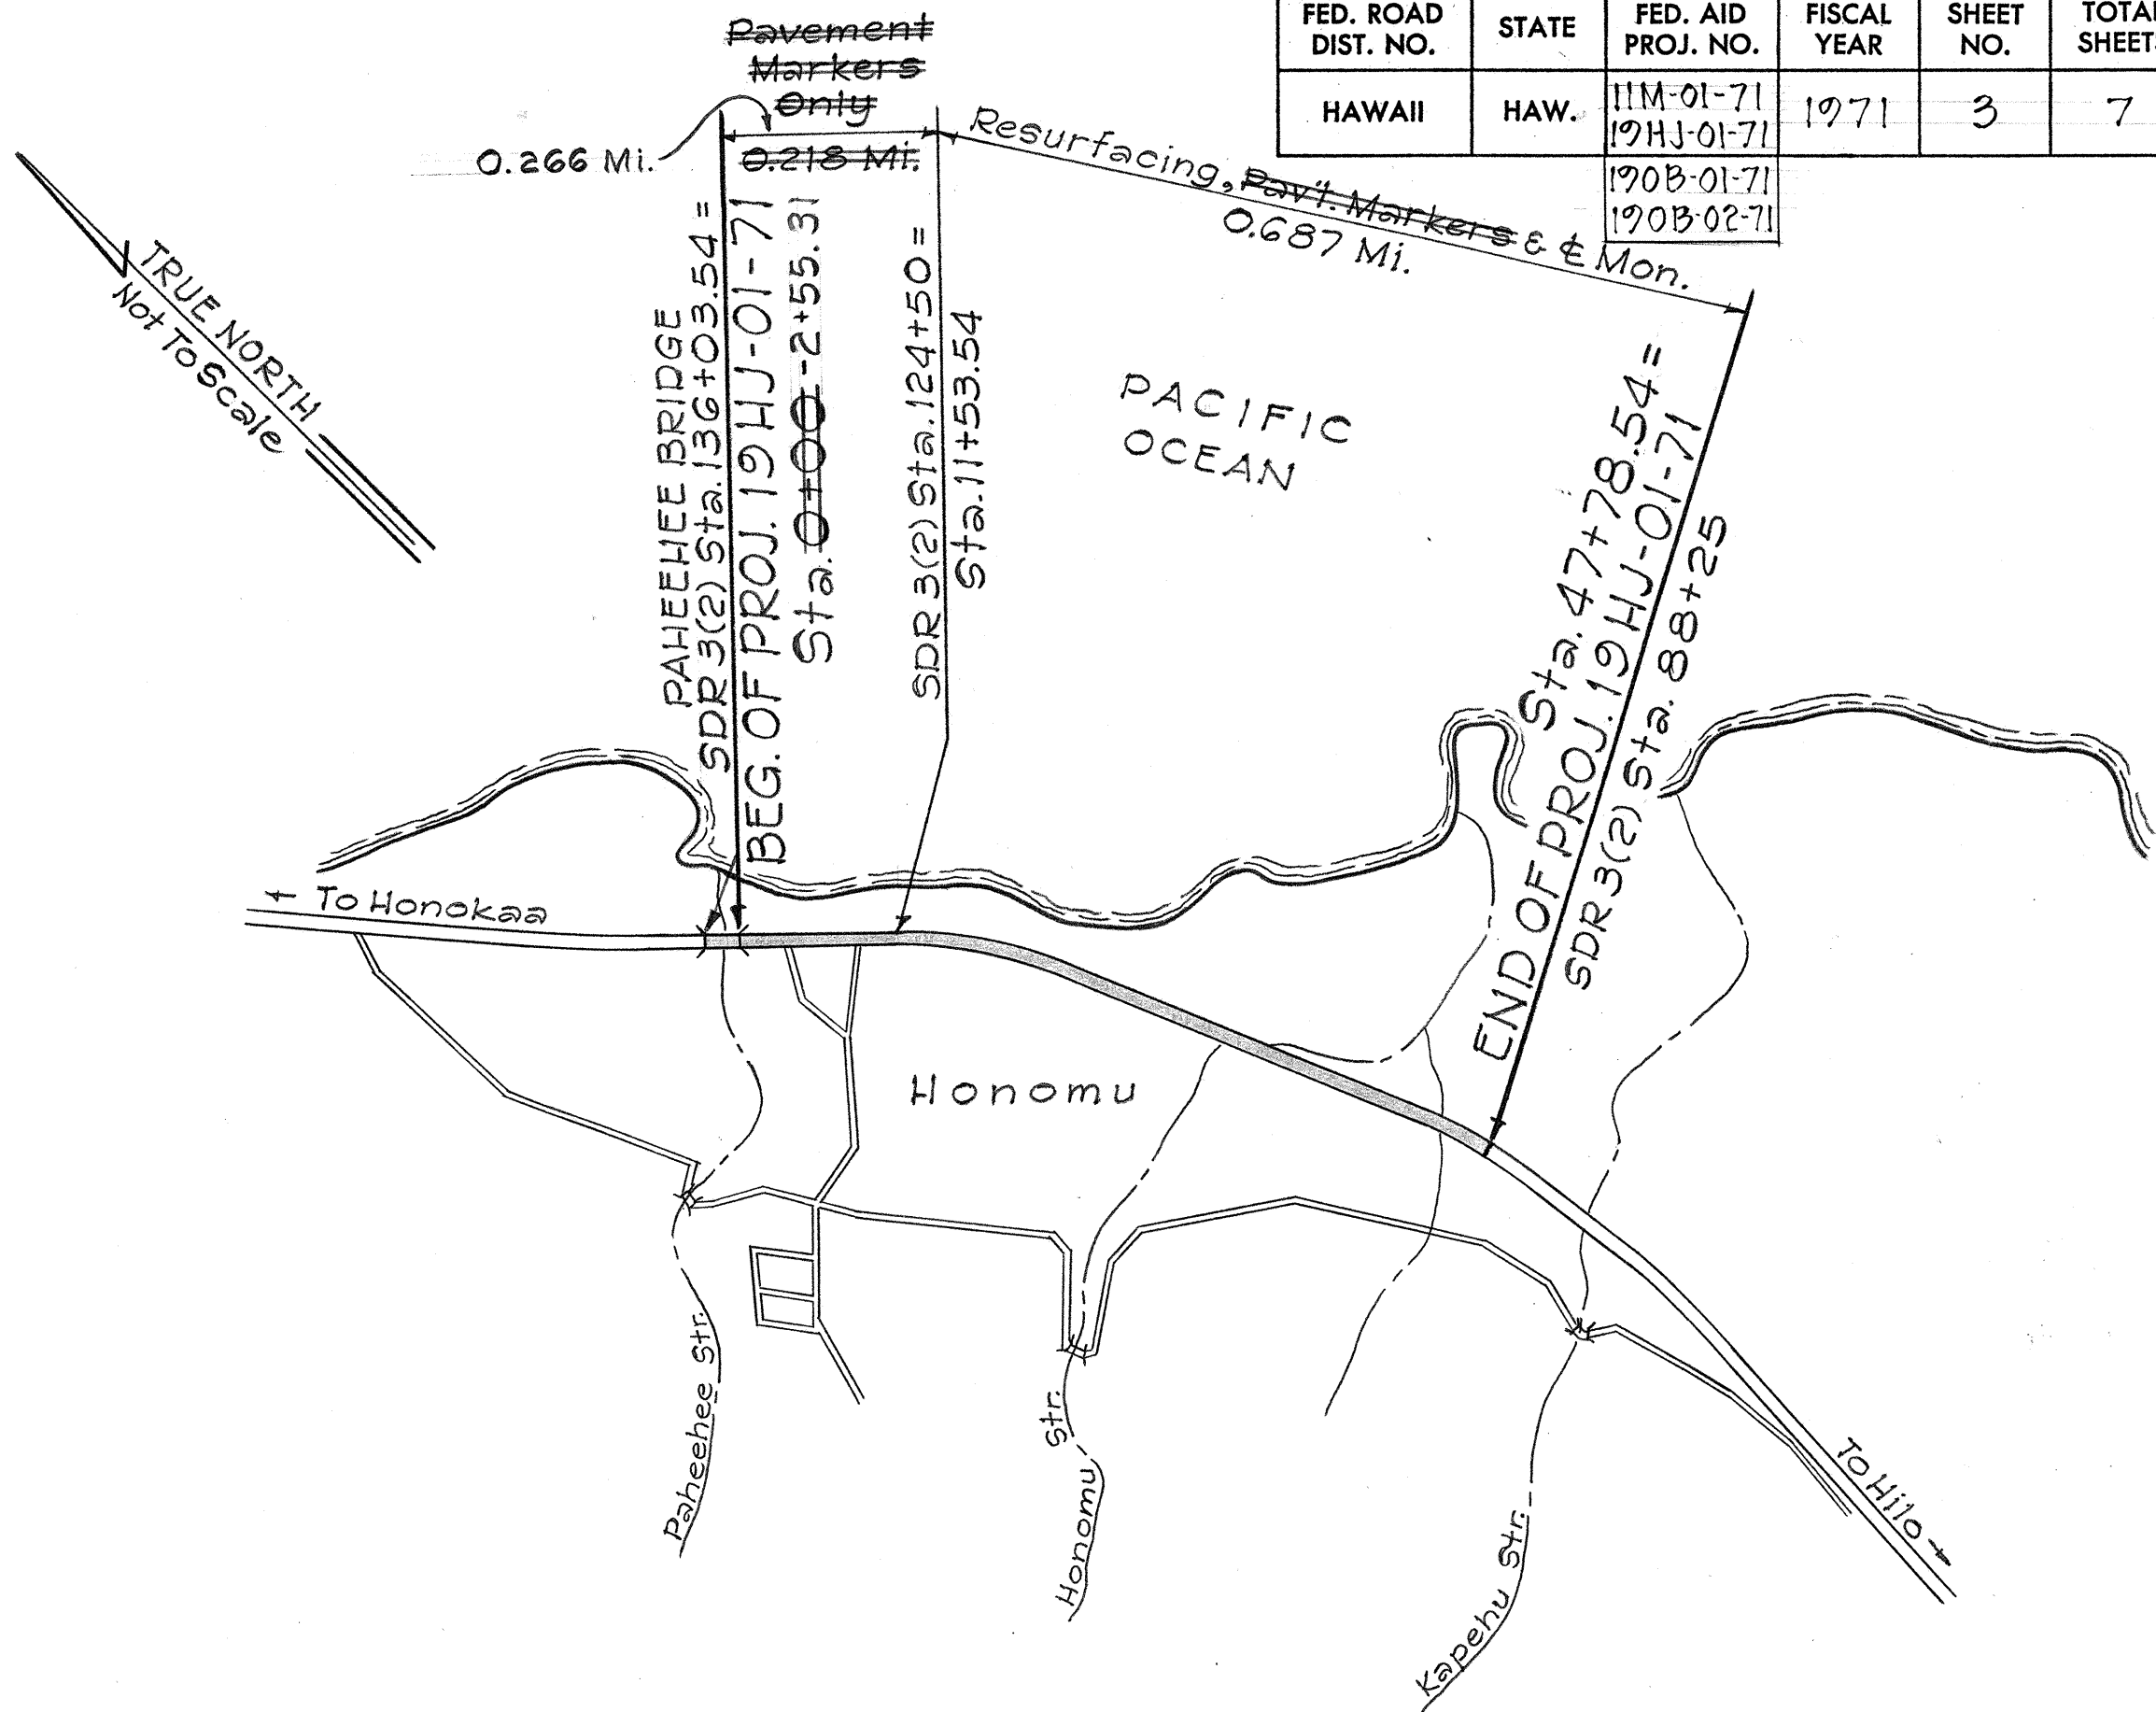


LAYOUT OF PROJECT
(Not to scale)


Gross and Net Length = 0.953 mi.

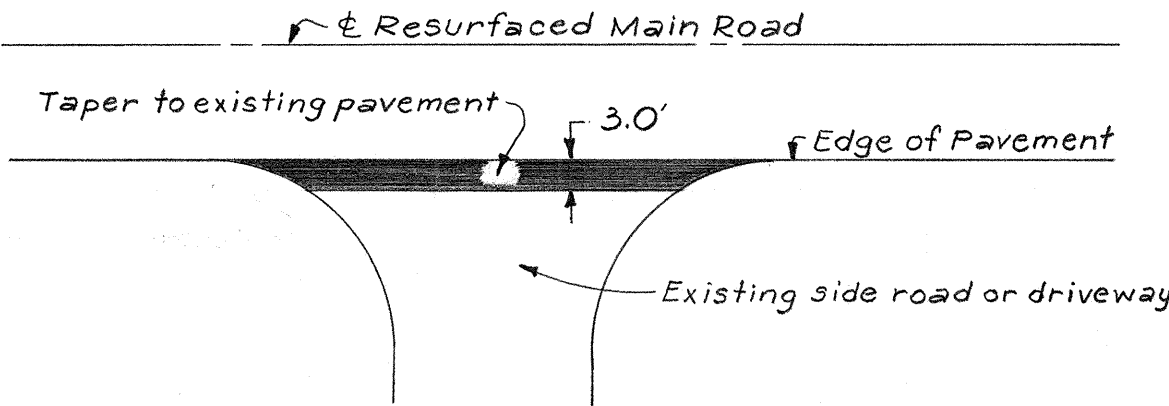

TYPICAL SIDEROAD & DRIVEWAY CONNECTION
(Not To Scale)

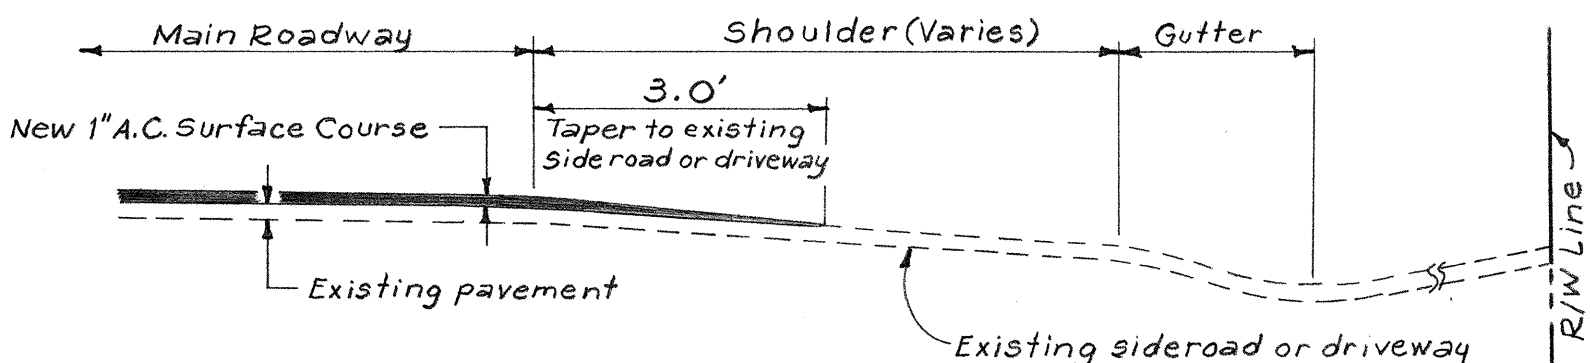

TYPICAL SECTION
SIDEROAD & DRIVEWAY CONNECTION
(Not To Scale)

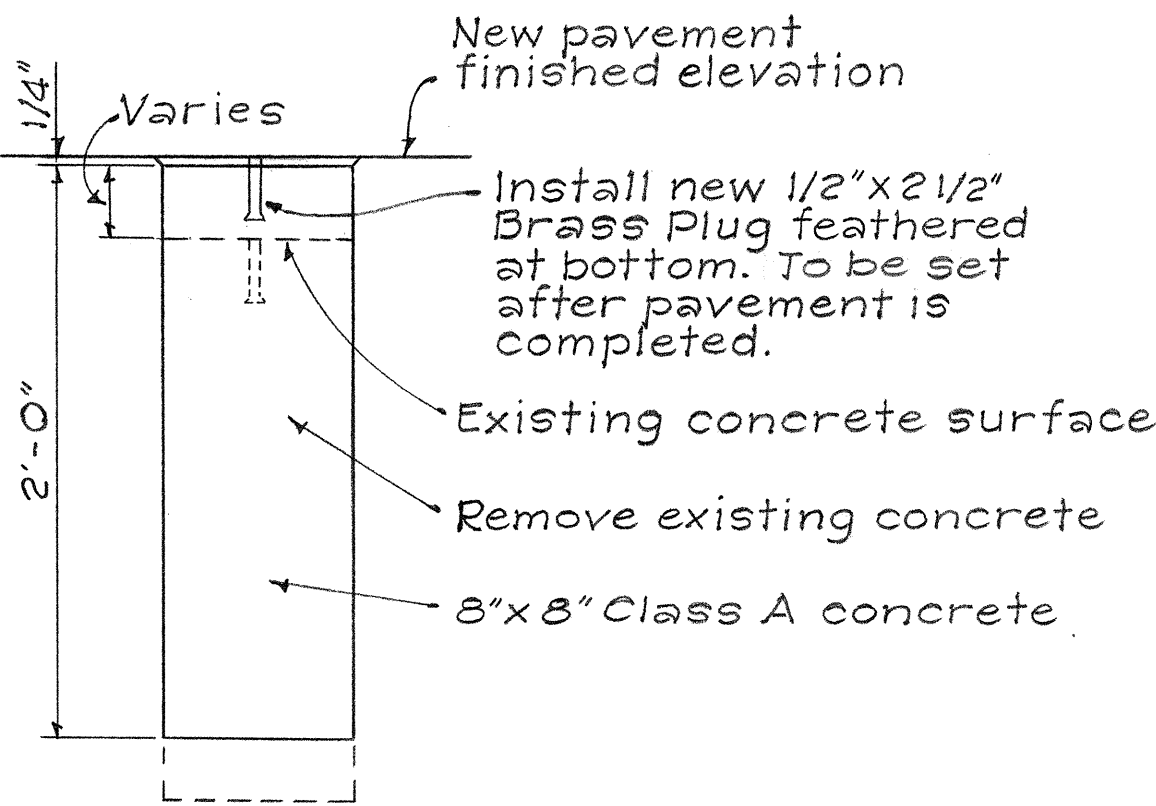

DETAIL FOR RECONSTRUCTED
& AND REFERENCE
SURVEY MONUMENT
Scale: 1 1/2"=1'-0"

RECONSTRUCTED CENTERLINE MONUMENT SCHEDULE	
PROJECT	LOCATION
SDR 3(2)	P.T. Sta. 92+50.32
	T.S. Sta. 103+48.12
	S.C. Sta. 105+48.12
	C.S. Sta. 108+62.91
	S.T. Sta. 110+62.91
	T.S. Sta. 115+43.74
	S.C. Sta. 117+43.74
	C.S. Sta. 124+18.46
Stationing based on Proj. SDR 3(2) "As Built"	

GENERAL NOTES:

- Existing pavement surface variable, surface indicated here is not intended to represent any specific location.
- Centerline and edge of pavement striping to be done by others.
- Pavement marker locations shall be furnished by the Engineer in the field.

STATE OF HAWAII

DEPARTMENT OF TRANSPORTATION

HIGHWAYS DIVISION

PLAN

For

RESURFACING AND INSTALLING PAVEMENT MARKERS

PROJECT No. 19HJ-01-71

HAWAII BELT ROAD SOUTH HILO

Scale: As Shown Date: Sept. 1970

SHEET No. 1 OF 1 SHEETS

SURVEY PLOTTED BY	DATE
DRAWN BY	
DESIGNED BY	
CHECKED BY	
ORIGINAL PLAN	
NOTE BOOK	
No.	