
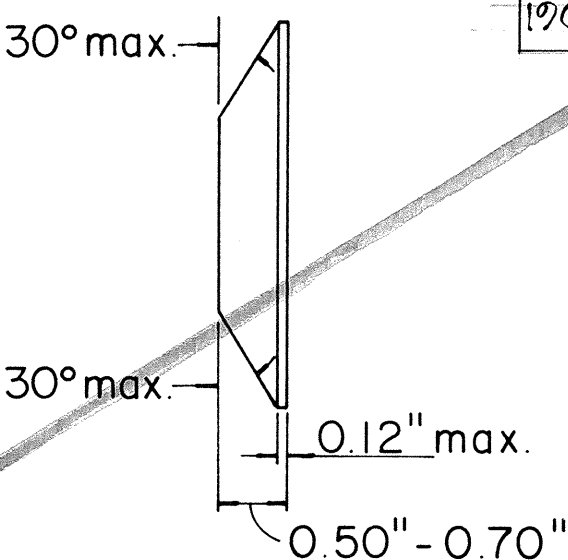
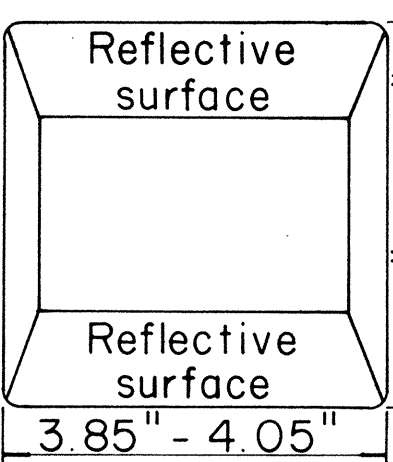
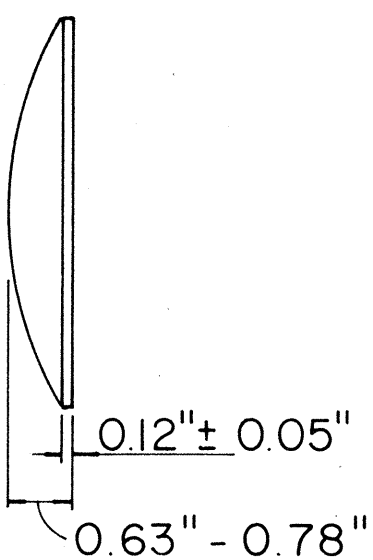
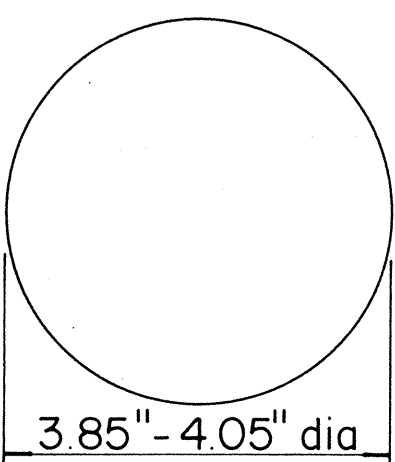


FED. ROAD DIST. NO.	STATE	FED. AID PROJ. NO.	FISCAL YEAR	SHEET NO.	TOTAL SHEETS
HAWAII	HAW.	11M-01-71 19HJ-01-71 190B-01-71 190B-02-71	1971	6	7

1 CENTER LINES ON TWO - LANE RURAL ROADS AND CITY STREETS

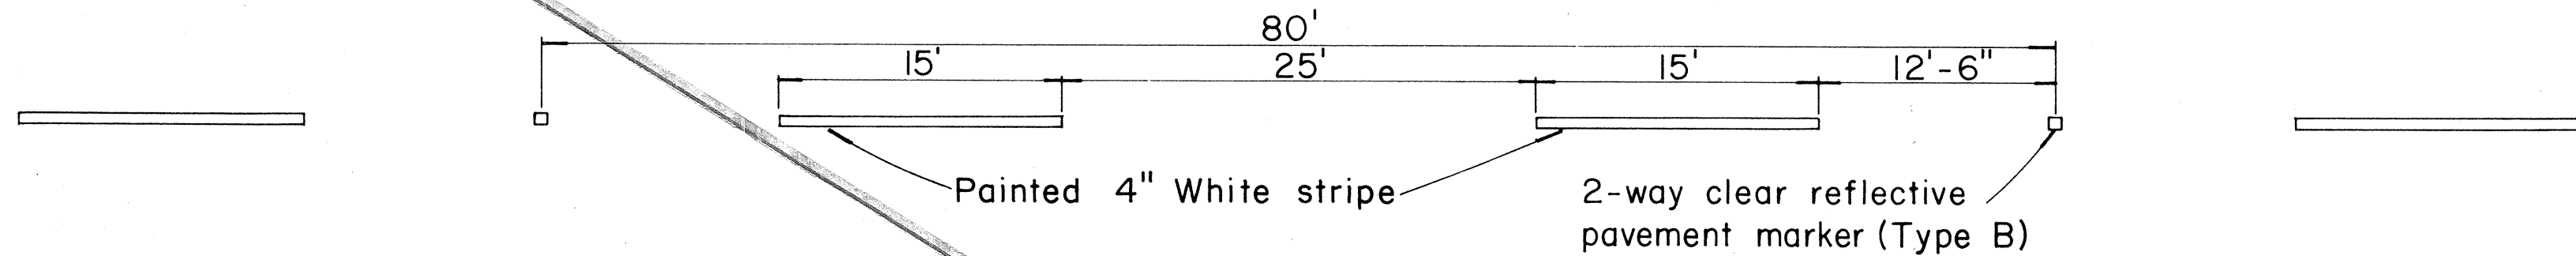

TYPE A

Non-reflective white marker

TYPE B

2-way clear reflective surface


TYPE J

Non-reflective yellow marker






TYPE D

2-way yellow reflective surface

2 LANE LINES

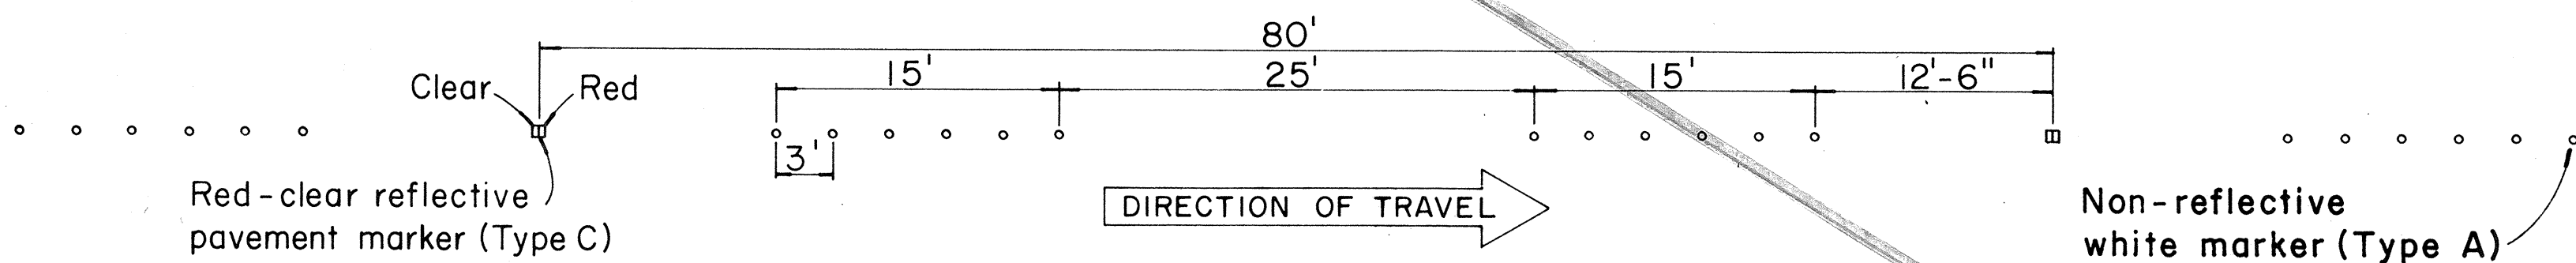

3 CHANNELIZING LINES

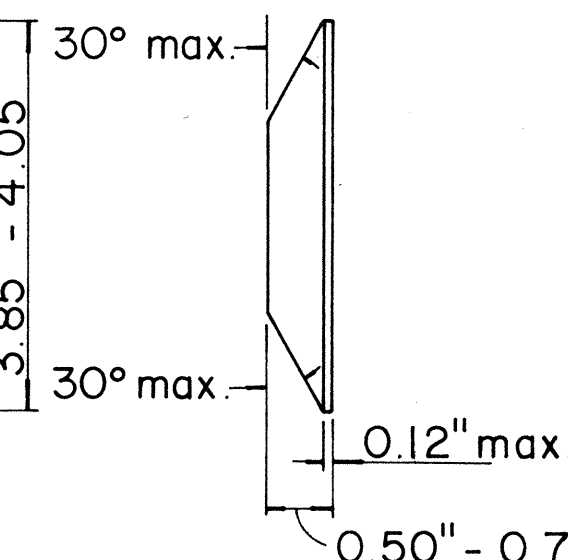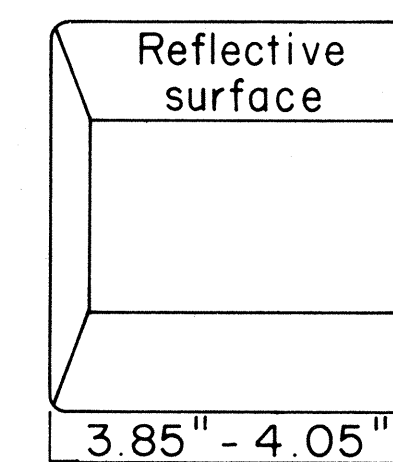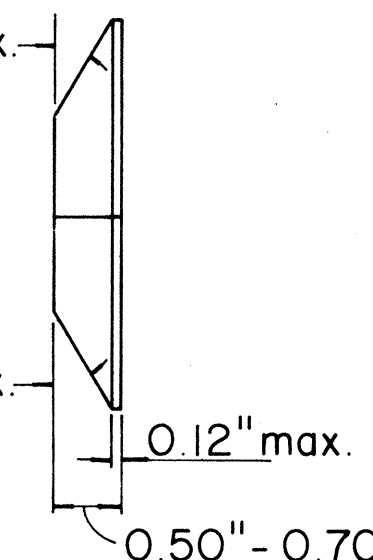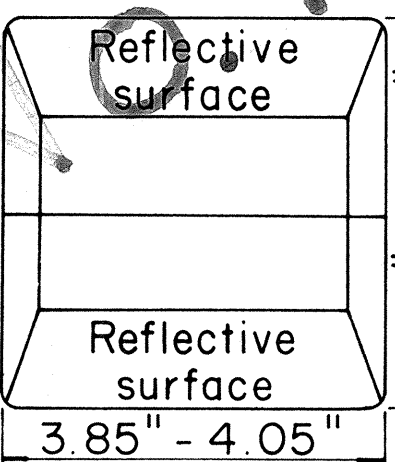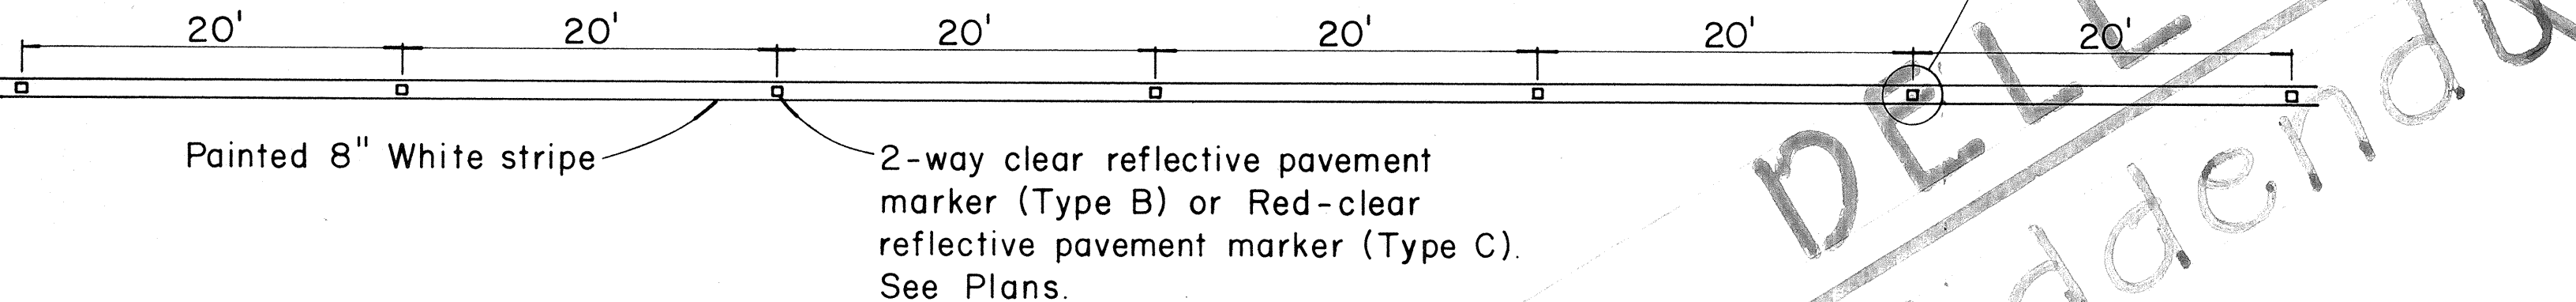

TYPE C

Red - clear reflective surface

TYPE H

One - way yellow reflective surface


TYPE E

Yellow - clear reflective surface


TYPE G

One - way clear reflective surface


4 YELLOW DOUBLE CENTER LINES

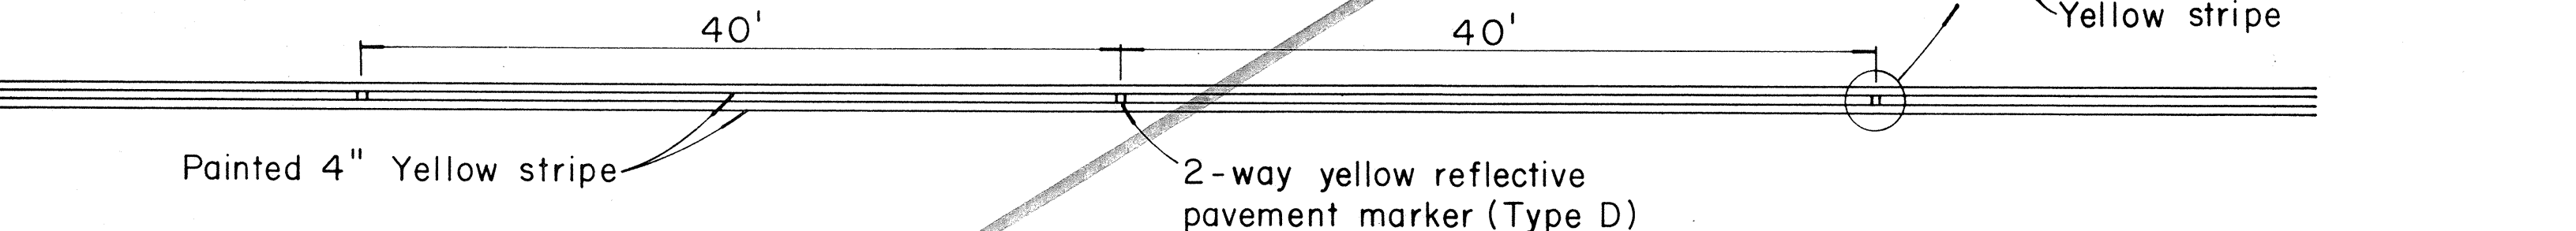

6 MEDIAN NOSE DELINEATION

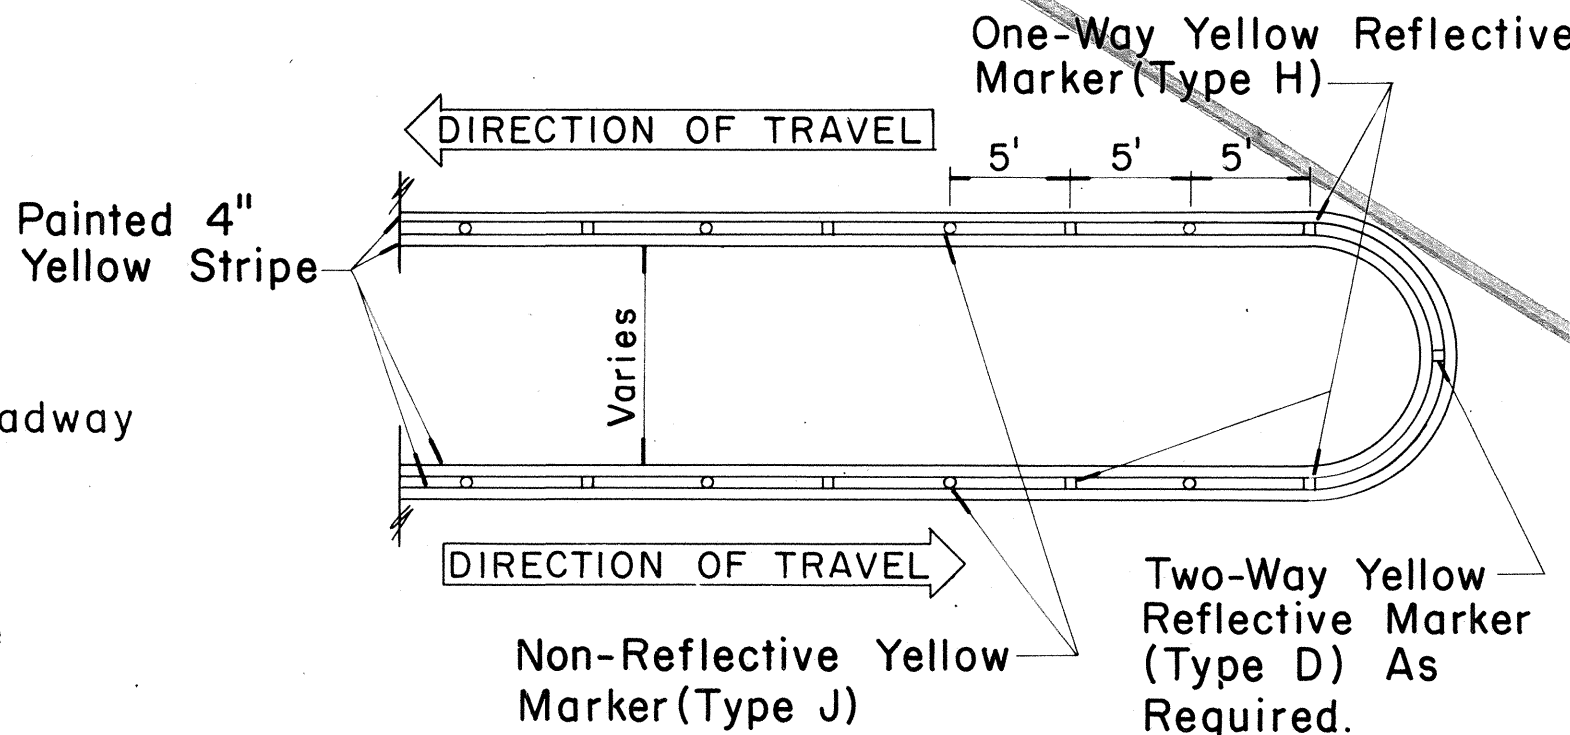

5 NO PASSING - PASSING ZONES ON TWO-LANE ROADS

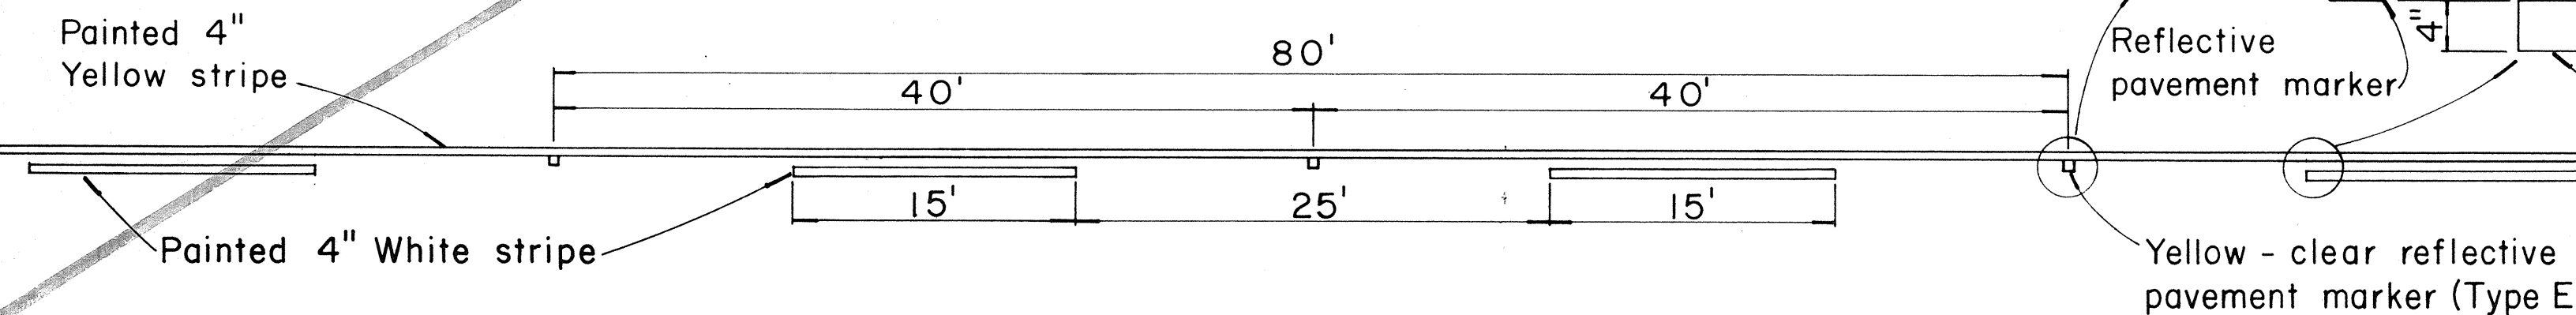

NOTE

Painted stripes to be done by State forces.

NO.	REVISION	APPROVED BY	DATE

STATE OF HAWAII
DEPARTMENT OF TRANSPORTATION
HIGHWAYS DIVISION

STANDARD DETAILS
RAISED PAVEMENT MARKERS

Not to Scale

Sept., 1967

SHEET No. 1 OF 1 SHEETS DT 300