

INDEX TO DRAWINGS	
SHEET NO.	DESCRIPTION
1	TITLE SHEET
2	PLANS FOR PROJ. No. IIM-01-71
3	PLANS FOR PROJ. No. 19HJ-01-71
4	PLANS FOR PROJ. No. 190B-01-71
5	PLANS FOR PROJ. No. 190B-02-71
6	STANDARD DETAILS
7	PROJECT INFORMATION SIGN

STATE OF HAWAII

DEPARTMENT OF TRANSPORTATION

HIGHWAYS DIVISION

"AS BUILT" PLANS FOR

RESURFACING AND REHABILITATION PROGRAM

OF HIGHWAYS

AT VARIOUS LOCATIONS ON THE

ISLAND OF HAWAII

ROUTE 11

HAWAII BELT ROAD

PROJ. NO. IIM-01-71

DISTRICT OF PUNA

ROUTE 19

HAWAII BELT ROAD

PROJ. NO. 19HJ-01-71

DISTRICT OF SOUTH HILO

ROUTE 190

HAWAII BELT ROAD

PROJ. NO. 190B-01-71

DISTRICT OF NORTH KONA

ROUTE 190

HAWAII BELT ROAD

PROJ. NO. 190B-02-71

DISTRICT OF NORTH KONA

GENERAL LOCATION PLAN

NOTE:

ALL CHANGES MADE DURING CONSTRUCTION

HAVE BEEN NOTED IN RED ON THESE TRACINGS

AND CHECKED BY:


[Signature]

PROJECT ENGINEER

DATE 7/21/71

LENGTH OF PROJECT No. IIM-01-71	2.148	MILES
LENGTH OF PROJECT No. 19HJ-01-71	0.905	MILES
LENGTH OF PROJECT No. 190B-01-71	7.023	MILES
LENGTH OF PROJECT No. 190B-02-71	4.507	MILES
TOTAL	21.062	MILES

FED. ROAD DIST. NO.	STATE	FED. AID PROJ. NO.	FISCAL YEAR	SHEET NO.	TOTAL SHEETS
HAWAII	HAW.	IIM-01-71 19HJ-01-71 190B-01-71 190B-02-71	1971	1	7

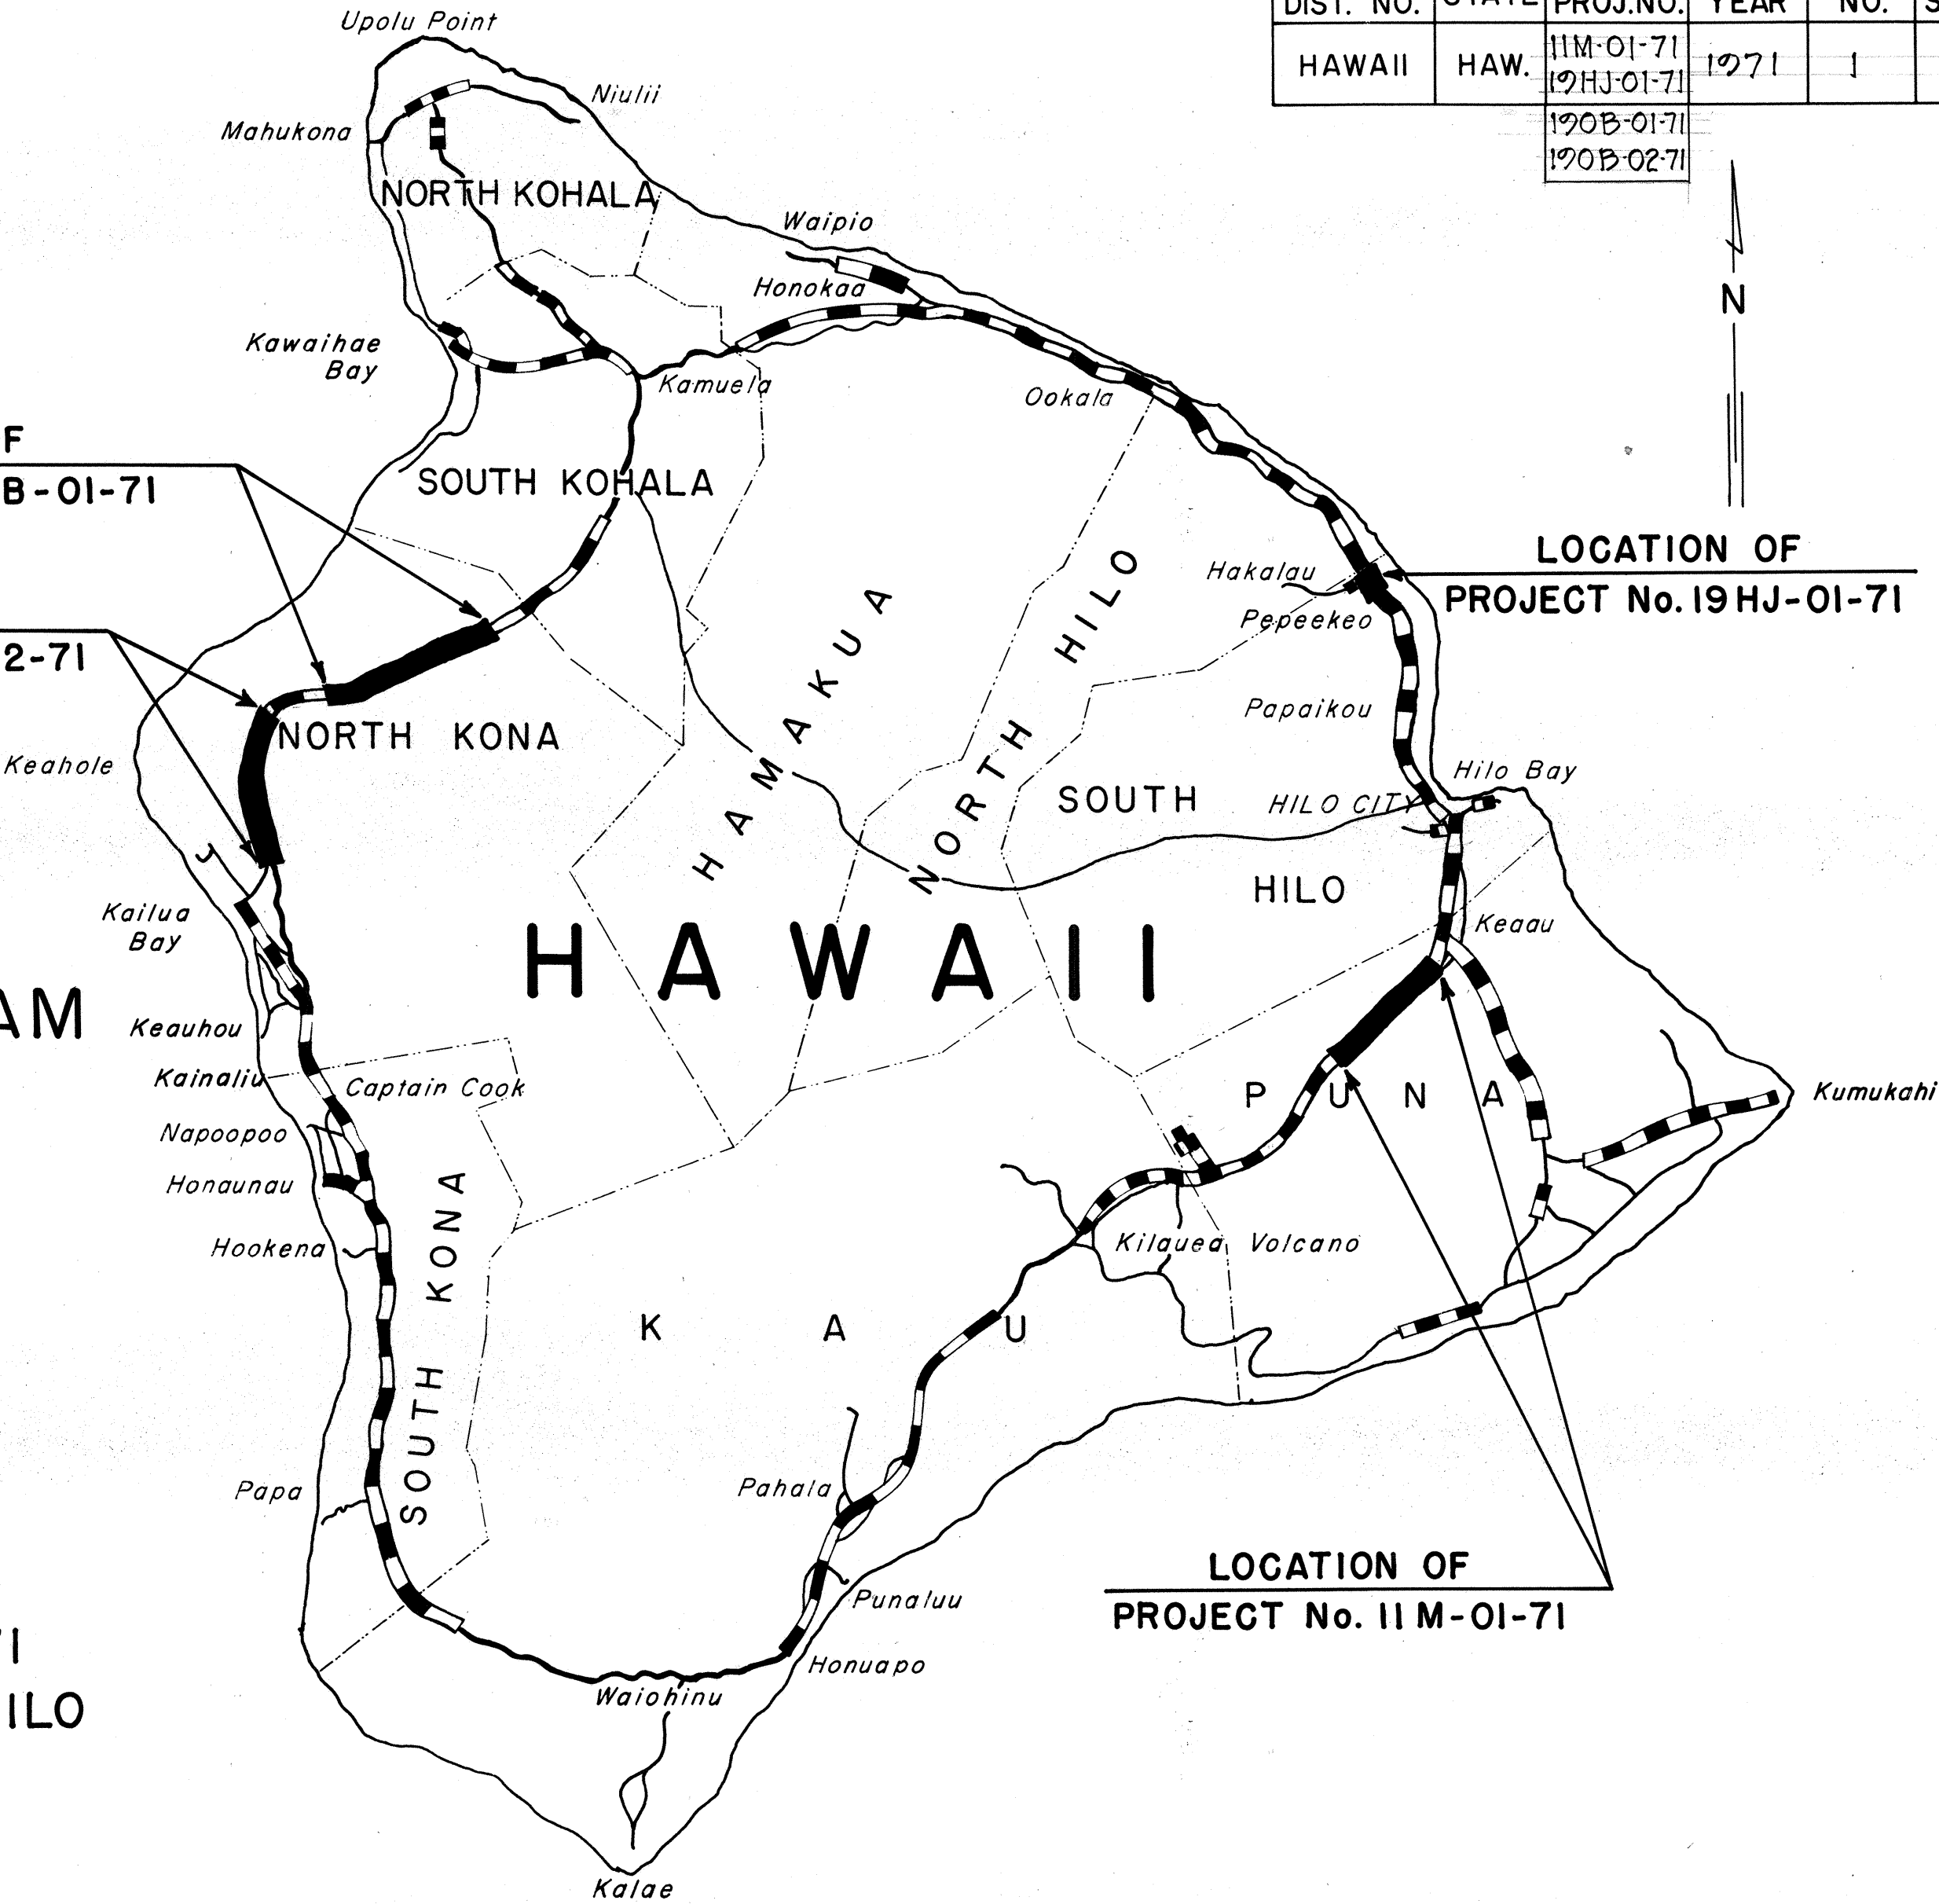

Federal Aid Projects Previously Constructed Or Under Construction

DEPARTMENT OF TRANSPORTATION STATE OF HAWAII	
APPROVED:	
<i>[Signature]</i>	11/25/70
for DIR. OF TRANSPORTATION	DATE

DESIGNED BY: HAWAII DISTRICT

PS&E

R. Mikami

DESIGN ENGINEER

5487534

PHONE

Nov. 1970

DATE