


INDEX TO DRAWINGS	
SHEET NO.	DESCRIPTION
1	TITLE SHEET
2	GENERAL LAYOUT
3-6	PLANS FOR PROJ. NO. 11G-01-71
7-8	PLANS FOR PROJ. NO. 130B-01-71
9-15	PLANS FOR PROJ. NO. HBR 11-270-71
16-17	PLANS FOR PROJ. NO. 130B-02-72
18-23	PLANS FOR PROJ. NO. HWY H-03-71
24-28	STANDARD DETAILS

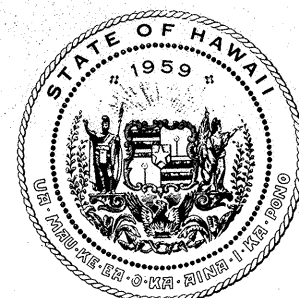

STATE OF HAWAII
DEPARTMENT OF TRANSPORTATION
HIGHWAYS DIVISION

"AS BUILT" PLANS FOR

THE CONSTRUCTION OF
DRAINAGE IMPROVEMENTS AT VARIOUS
LOCATIONS ON THE ISLAND OF HAWAII

DRAINAGE IMPROVEMENT
AT
KAU

PROJECT NO. 11G-01-71
DISTRICT OF KAU

CHANNEL IMPROVEMENT
AT
WAIPAHOEHOE STREAM

PROJECT NO. 130 B-01-71
DISTRICT OF PUNA

CONSTRUCTION OF DRYWELLS
AT VARIOUS LOCATIONS

PROJECT NO. HWY H-03-71
DISTRICTS OF SOUTH HILO
& PUNA


DRAINAGE IMPROVEMENT
ON
KAWAIHAE - MAHUKONA ROAD

PROJECT NO. HBR 11-270-71
DISTRICT OF NORTH KOHALA


N. I. C.

DRAINAGE IMPROVEMENT
ON
KEAAU - PAHOA ROAD

PROJECT NO. 130 B-02-72
DISTRICT OF PUNA

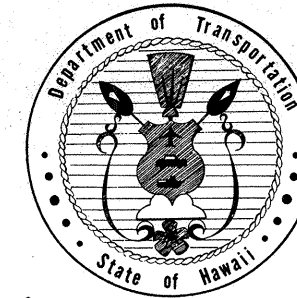

GENERAL LOCATION
PROJ. NO. HBR 11-270-71

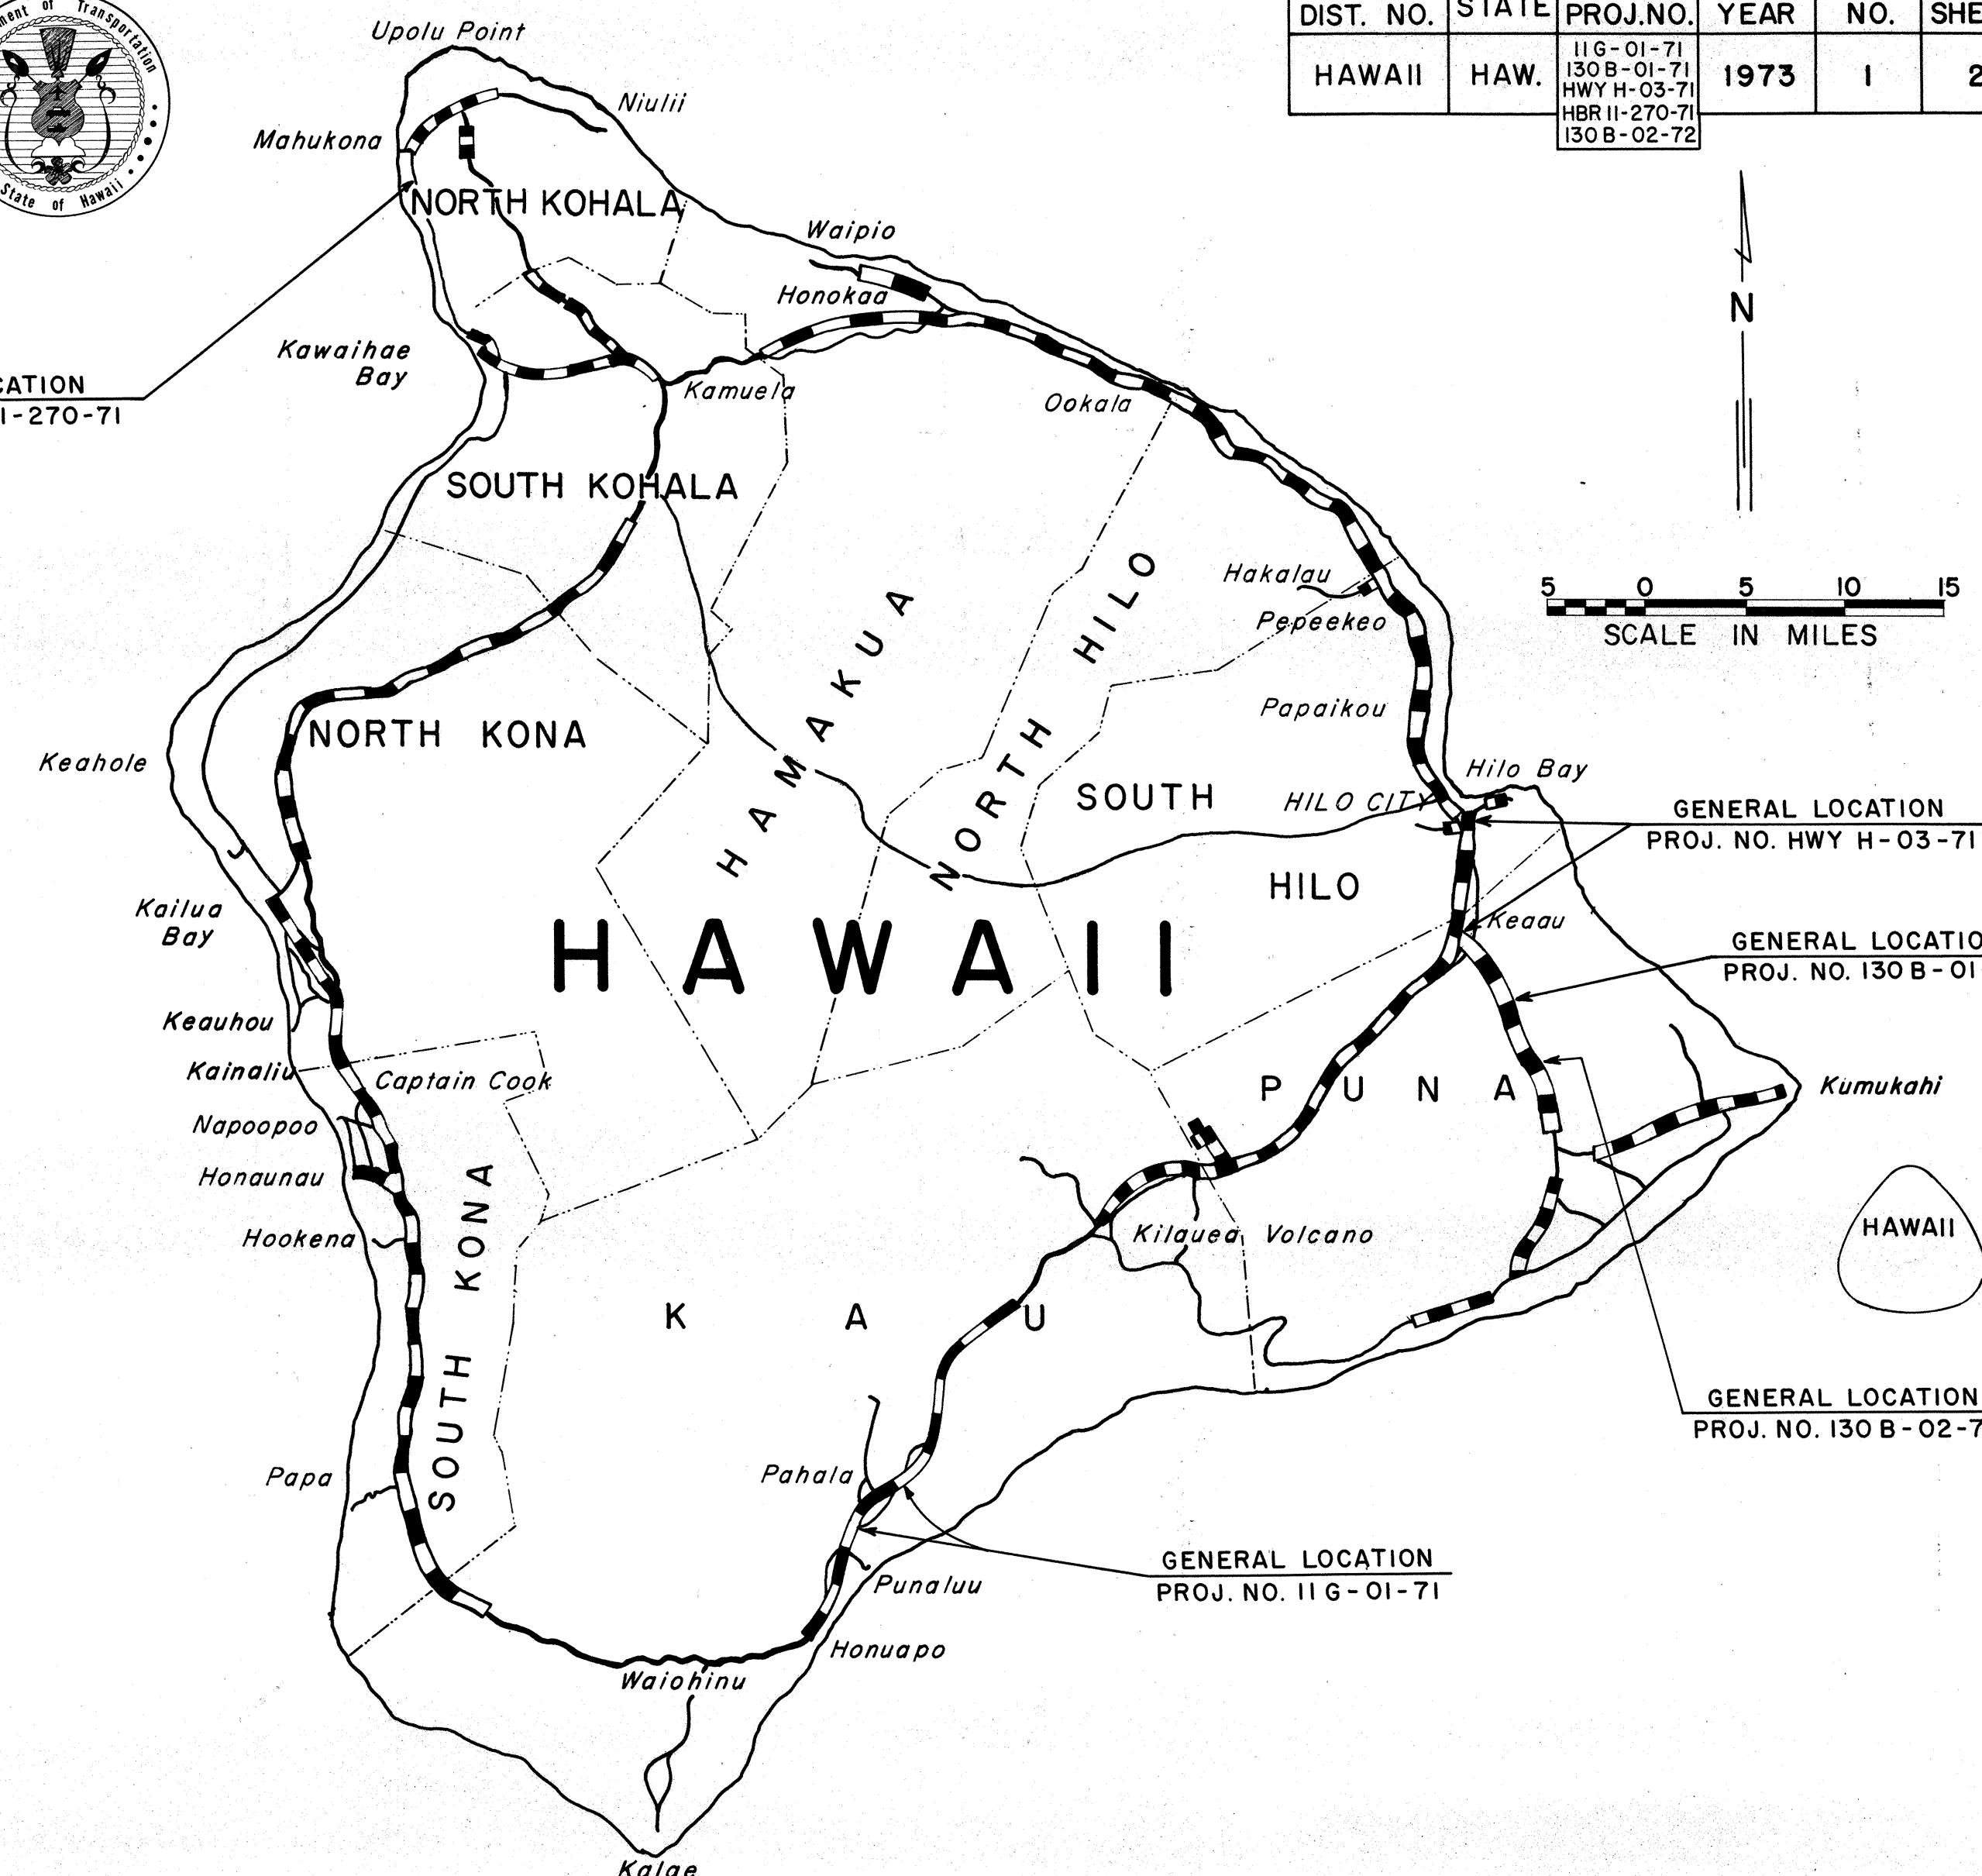

Federal Aid Projects Previously Constructed Or Under Construction

NOTE:
ALL CHANGES MADE DURING CONSTRUCTION HAVE
BEEN INCORPORATED ON THESE PLANS EXCEPT
CHANGES IN THE ORIGINAL THEORETICAL QUANTITIES.

Lloyd P. Lee
PROJECT ENGINEER

June 19, 1974
DATE

DEPARTMENT OF TRANSPORTATION STATE OF HAWAII	
APPROVED:	
<i>Munny Lee</i> FOR DIR. OF TRANSPORTATION	<i>7/13/73</i> DATE

HAWAII DISTRICT
DESIGNED BY
R. Mikami
P. S. & E. BY
548-7534
PHONE
July 1973
DATE