
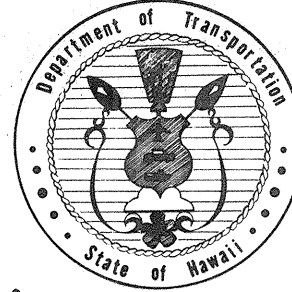


INDEX TO DRAWINGS	
SHEET NO.	DESCRIPTION
1	TITLE SHEET
2	TRAFFIC SIGNAL SYSTEM LEGEND AND NOTES
3	TRAFFIC SIGNAL LAYOUT AT PUAINAKO AVENUE INTERSECTION
4	INTERCONNECT CABLES AND SAMPLING DETECTORS LOCATION
5	TRAFFIC SIGNAL LAYOUT AT KAWILI STREET INTERSECTION
6	TRAFFIC SIGNAL LAYOUT AT LEILANI STREET INTERSECTION
7	TRAFFIC SIGNAL LAYOUT AT KEKUANAOA STREET INTERSECTION
8	STANDARD DETAILS: MISCELLANEOUS SIGN DETAILS
9	STANDARD DETAILS: REGULATORY SIGNS
10	STANDARD DETAILS: MISCELLANEOUS REGULATORY & WARNING SIGNS
11	TRAFFIC SIGNAL SYSTEM MISCELLANEOUS DETAILS
12	STANDARD DETAILS: PULLBOXES
13 - 14	TRAFFIC SIGNAL SYSTEM MISCELLANEOUS DETAILS

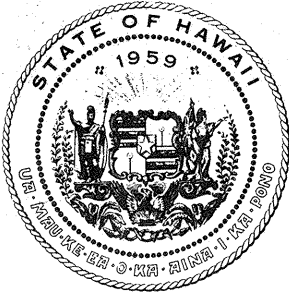

STATE OF HAWAII
DEPARTMENT OF TRANSPORTATION
HIGHWAYS DIVISION
"AS BUILT"
PLANS FOR

KANOELEHUA AVENUE,
TRAFFIC SIGNALS AT FOUR LOCATIONS
PROJECT NO. F-011-2(16)


DISTRICT OF SOUTH HILO
ISLAND OF HAWAII

NOTE:


ALL CHANGES MADE DURING CONSTRUCTION HAVE BEEN INCORPORATED ON THESE PLANS EXCEPT CHANGES IN THE ORIGINAL QUANTITIES.

David P. ...
PROJECT ENGINEER

June 27, 1978
DATE

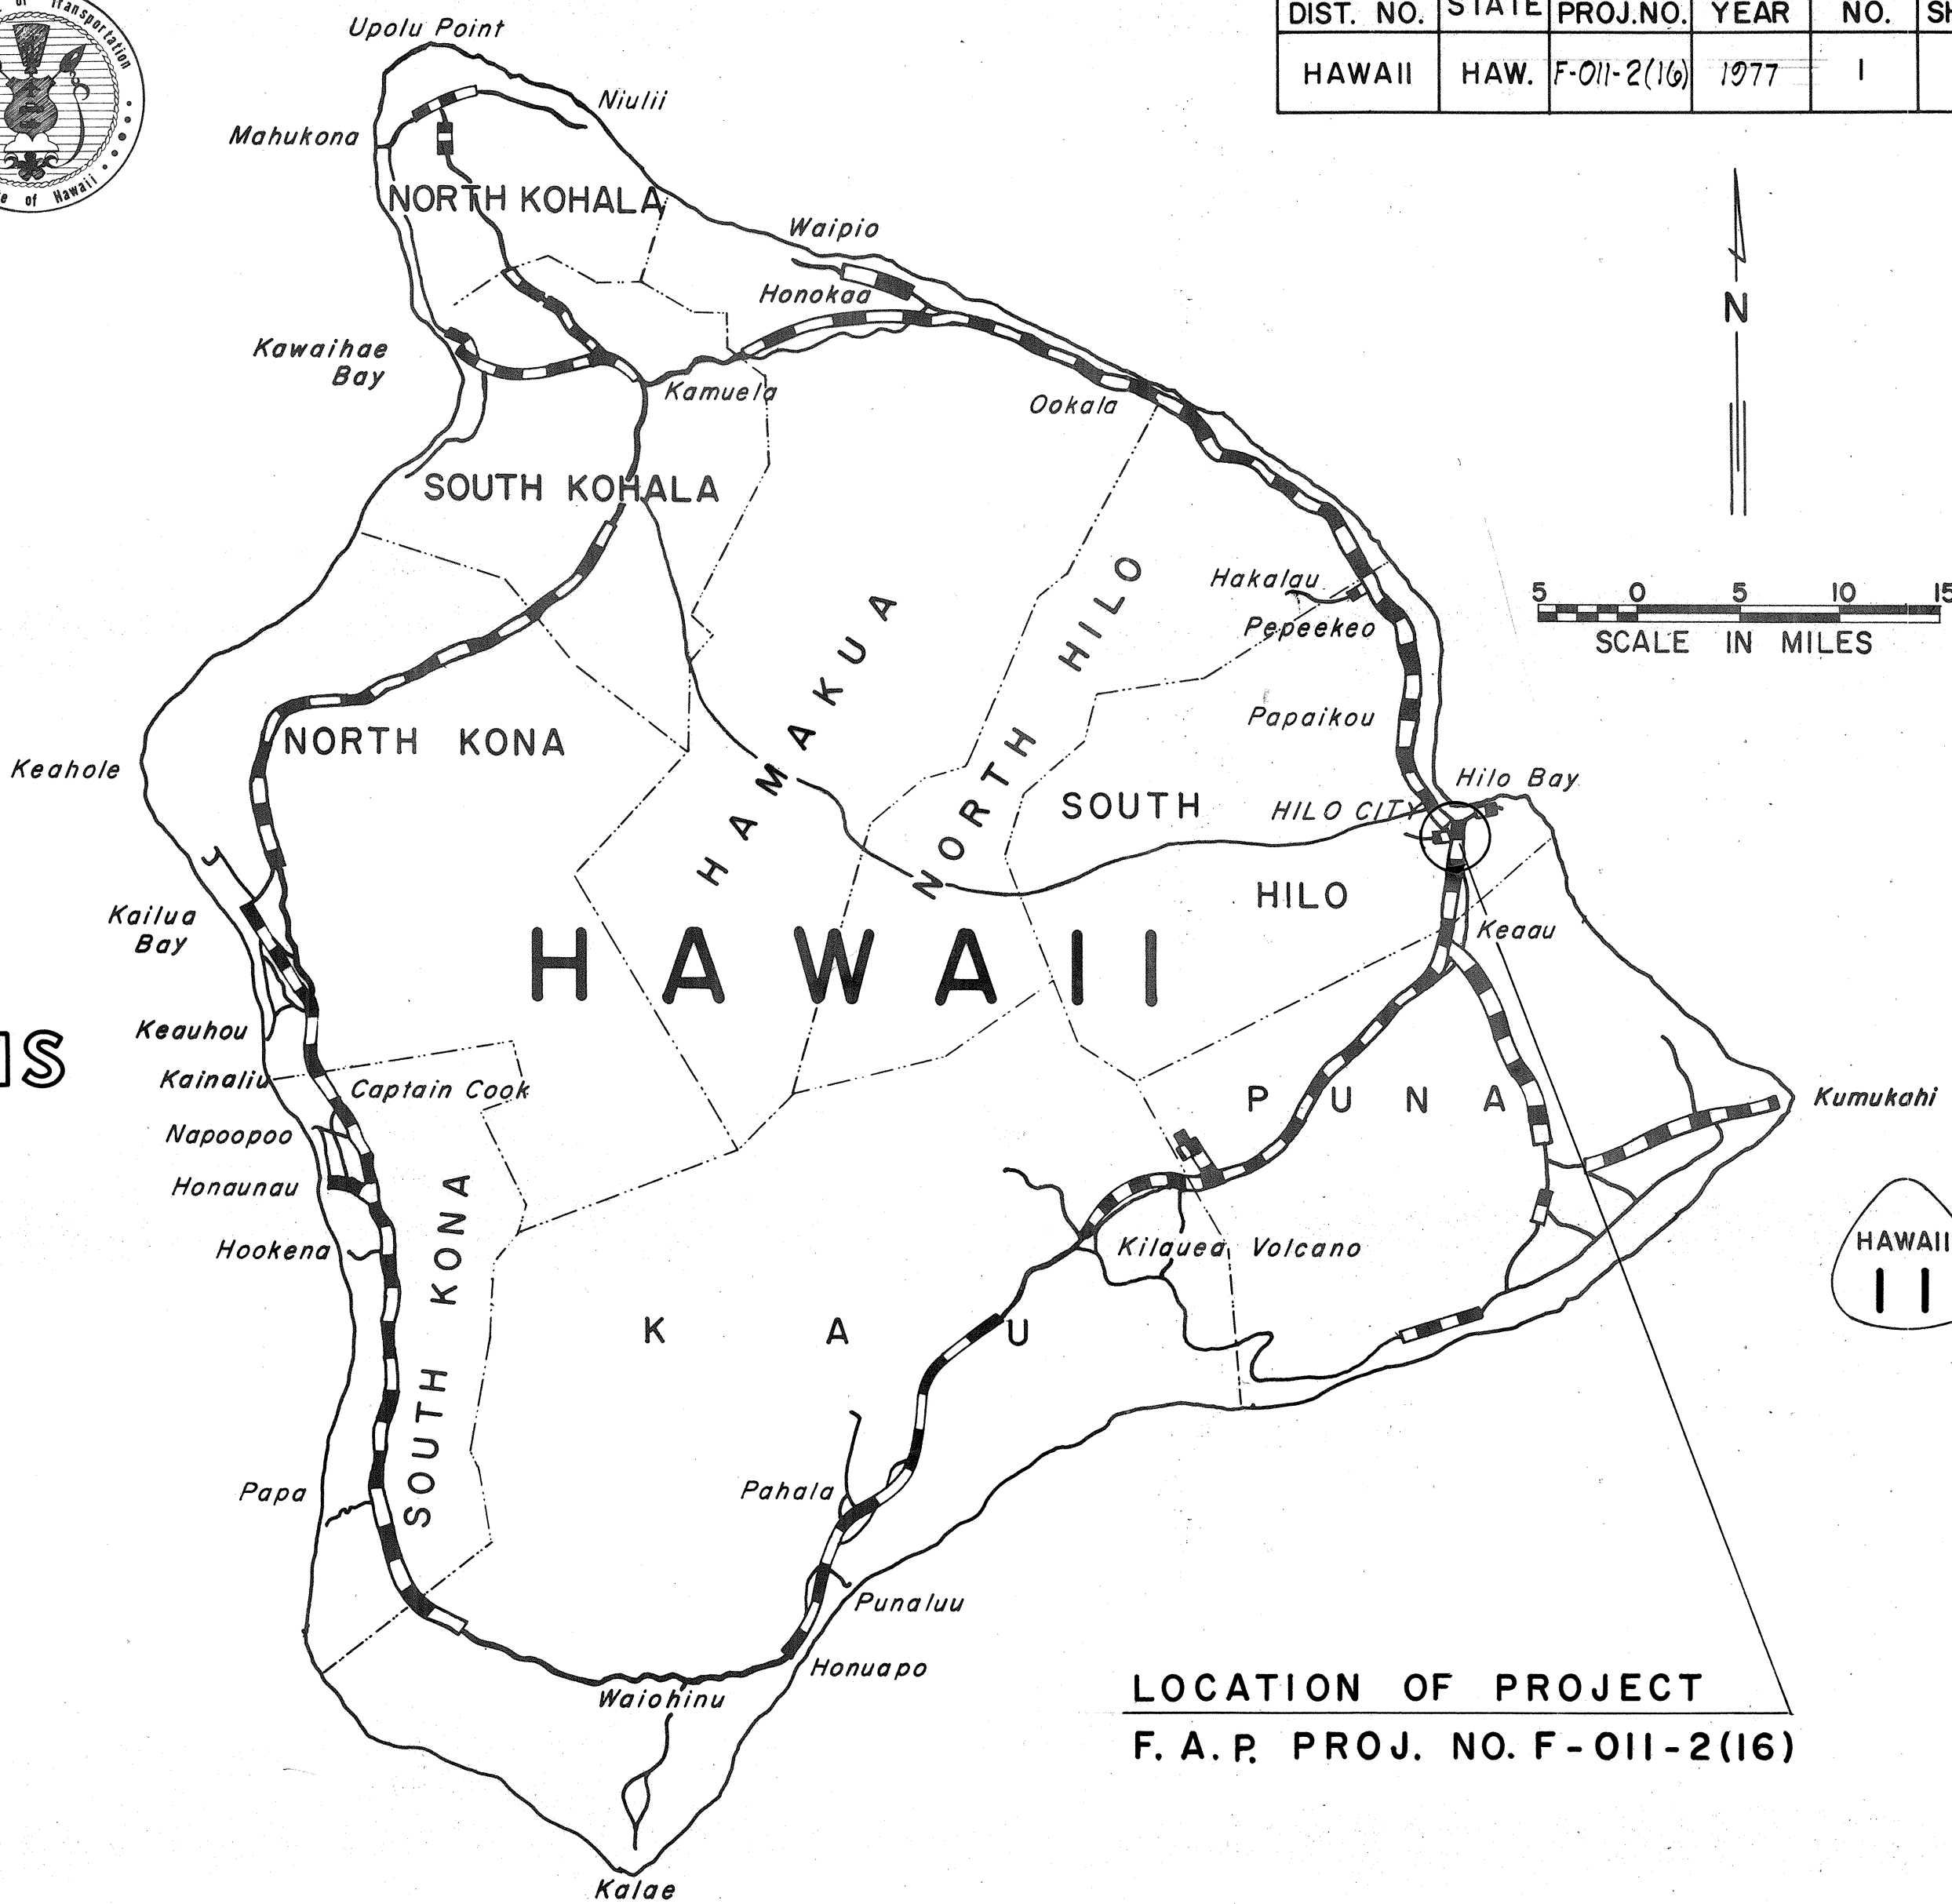

LOCATION OF PROJECT
F.A.P. PROJ. NO. F-011-2(16)

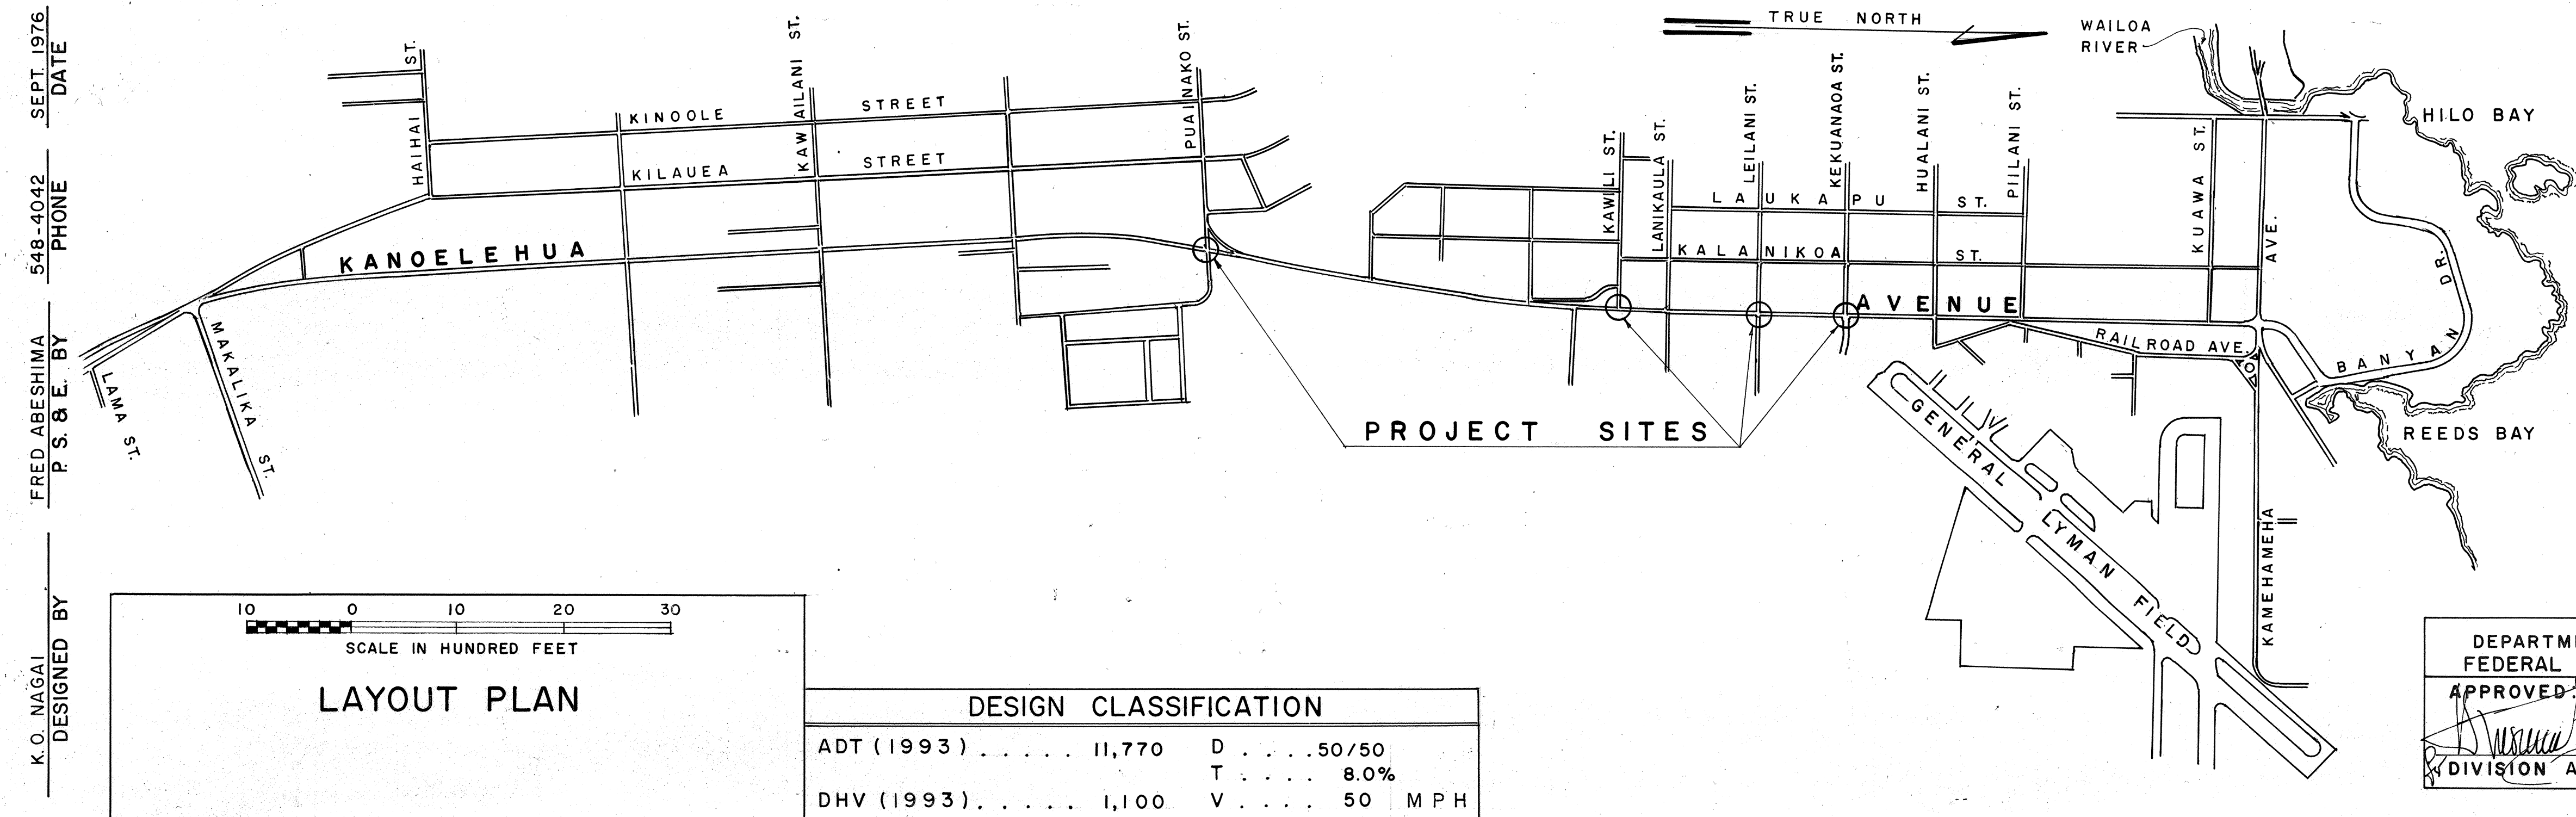

LAYOUT PLAN

DESIGN CLASSIFICATION			
ADT (1993)	11,770	D	50/50
		T	8.0%
DHV (1993)	1,100	V	50 MPH

Federal Aid Projects Previously Constructed Or Under Construction

WILSON OKAMOTO & ASSOCIATES
ENGINEERS AND ARCHITECTS
1150 SOUTH KING ST.
HONOLULU, HAWAII

DEPARTMENT OF TRANSPORTATION
FEDERAL HIGHWAY ADMINISTRATION
APPROVED: *[Signature]* 9-23-76
DIVISION ADMINISTRATOR DATE

DEPARTMENT OF TRANSPORTATION
STATE OF HAWAII
APPROVED: *R. Higashionna* 9-24-76
DIR. OF TRANSPORTATION DATE