
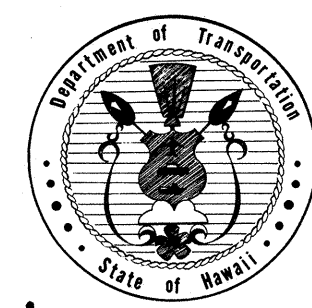


D-1-9
11 MN 6630-2122
200E 6631 "
270B 6632 "

INDEX TO DRAWINGS	
SHEET NO.	DESCRIPTION
1	TITLE SHEET
2	GENERAL LOCATION PLAN
3	TYPICAL DETAILS
4	TYPICAL DETAILS, PAVEMENT MARKERS SCHEDULE & PLANS FOR PROJ. NO. IIMN-01-77M
5-6	PLANS FOR PROJ. NO. IIMN-01-77M
7-8	PLANS FOR PROJ. NO. 200E-01-77M
9-11	PLANS FOR PROJ. NO. 270B-01-77M
12	STANDARD DETAILS

HAWAII DISTRICT
DESIGNED BY
ROY MIKAMI
P. S. & E. BY
548-7534
PHONE
DATE

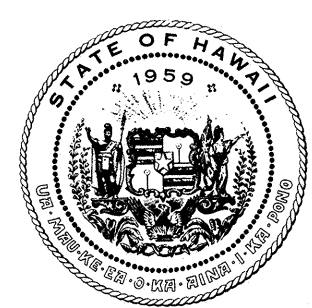

STATE OF HAWAII
DEPARTMENT OF TRANSPORTATION
HIGHWAYS DIVISION


PLANS FOR
CONSTRUCTION OF
"AS BUILT"
RESURFACING & REHABILITATION PROGRAM
OF HIGHWAYS AT VARIOUS LOCATIONS
ON THE ISLAND OF HAWAII

VOLCANO ROAD RESURFACING
PROJ. NO. IIMN-01-77M
DISTRICTS OF SOUTH HILO & PUNA

PUAINAKO STREET RESURFACING
PROJ. NO. 200E-01-77M
DISTRICT OF SOUTH HILO

KAPAAU - NIULII ROAD RESURFACING
PROJ. NO. 270B-01-77M
DISTRICT OF NORTH KOHALA

FED. ROAD DIST. NO.	STATE	PROJ. NO.	FISCAL YEAR	SHEET NO.	TOTAL SHEETS
HAWAII	HAW.		1977	1	12

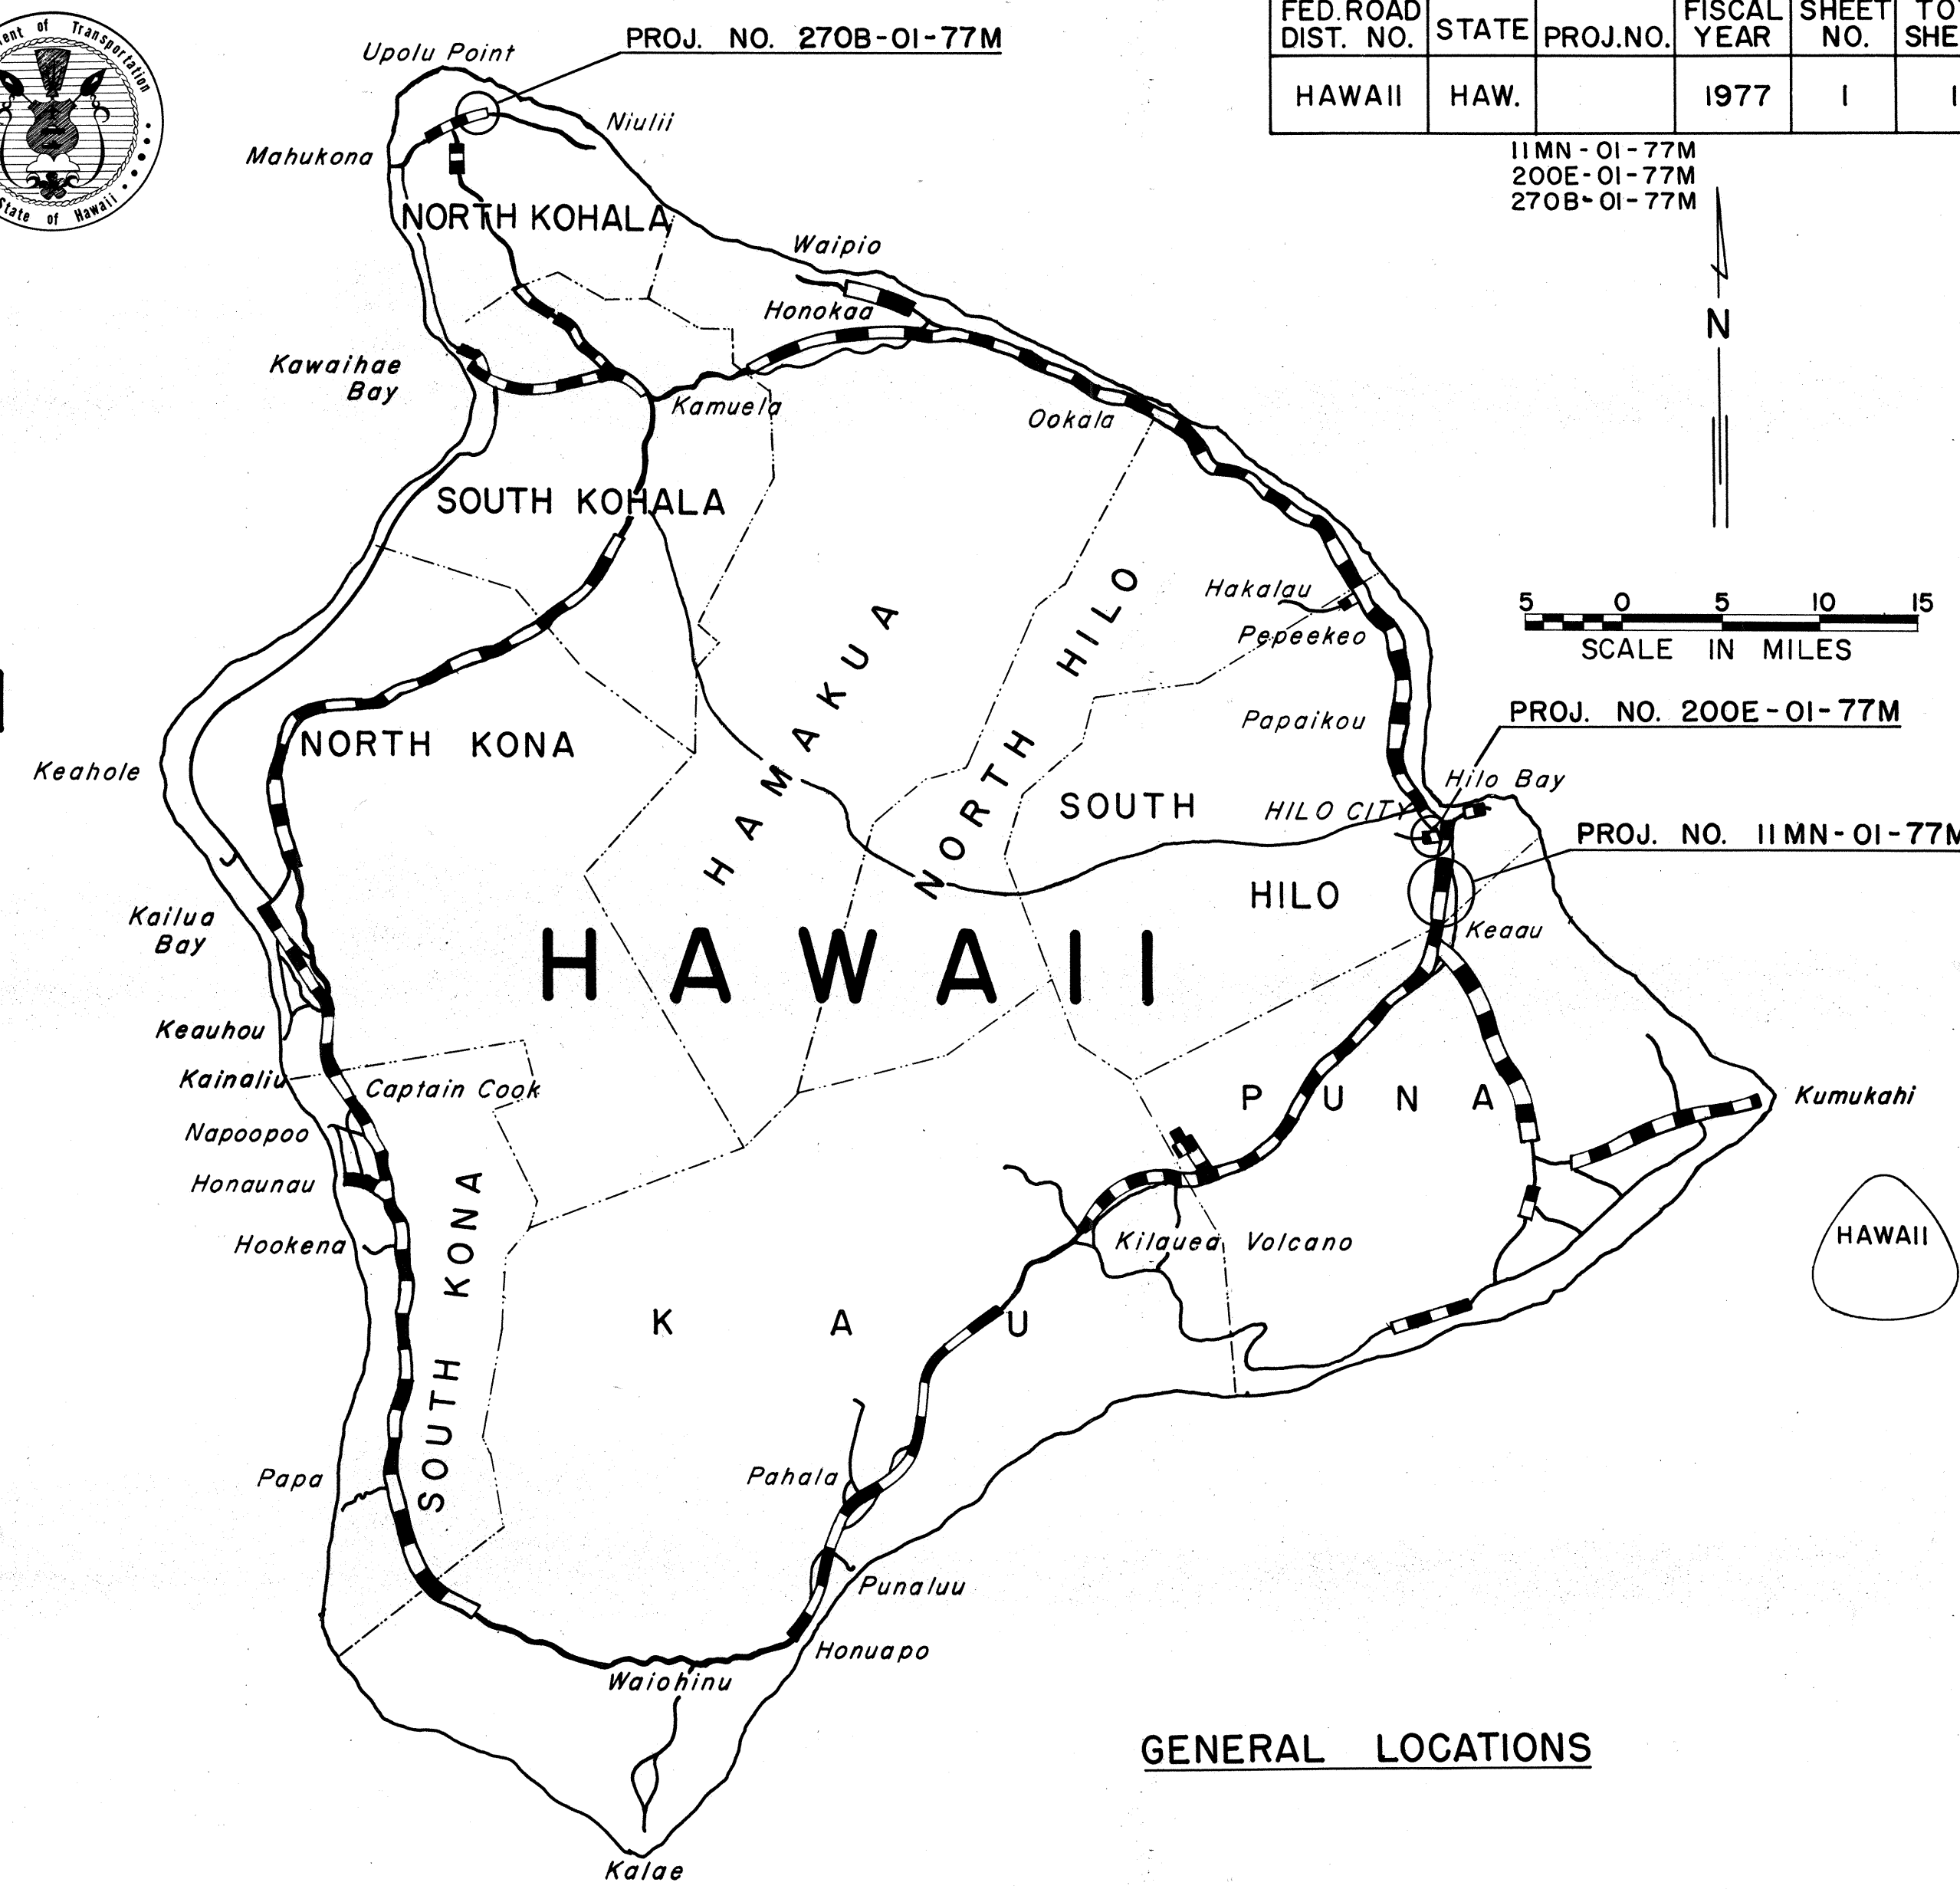

GENERAL LOCATIONS

Federal Aid Projects Previously Constructed Or Under Construction

NOTE:
ALL CHANGES MADE DURING CONSTRUCTION HAVE
BEEN INCORPORATED ON THESE PLANS IN RED
EXCEPT CHANGES IN THE ORIGINAL THEORETICAL
QUANTITIES.

PROJECT ENGINEER
DATE 7-6-77

DEPARTMENT OF TRANSPORTATION
STATE OF HAWAII
APPROVED:
for R Higashionna
DIR. OF TRANSPORTATION
DATE 10-19-76