


INDEX TO DRAWINGS	
SHEET NO.	DESCRIPTION
1	TITLE SHEET
2 - 3	PROJECT LOCATIONS & SCHEDULES
4	STANDARD DETAILS

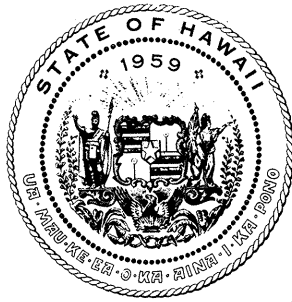

STATE OF HAWAII

DEPARTMENT OF TRANSPORTATION

HIGHWAYS DIVISION

"AS-BUILT"

PLANS FOR



PAVEMENT MARKING DEMONSTRATION PROGRAM

PROJECT NO. PMS-0100(6)

DISTRICTS OF KAU, NORTH & SOUTH KONA,

AND NORTH & SOUTH KOHALA

ISLAND OF HAWAII

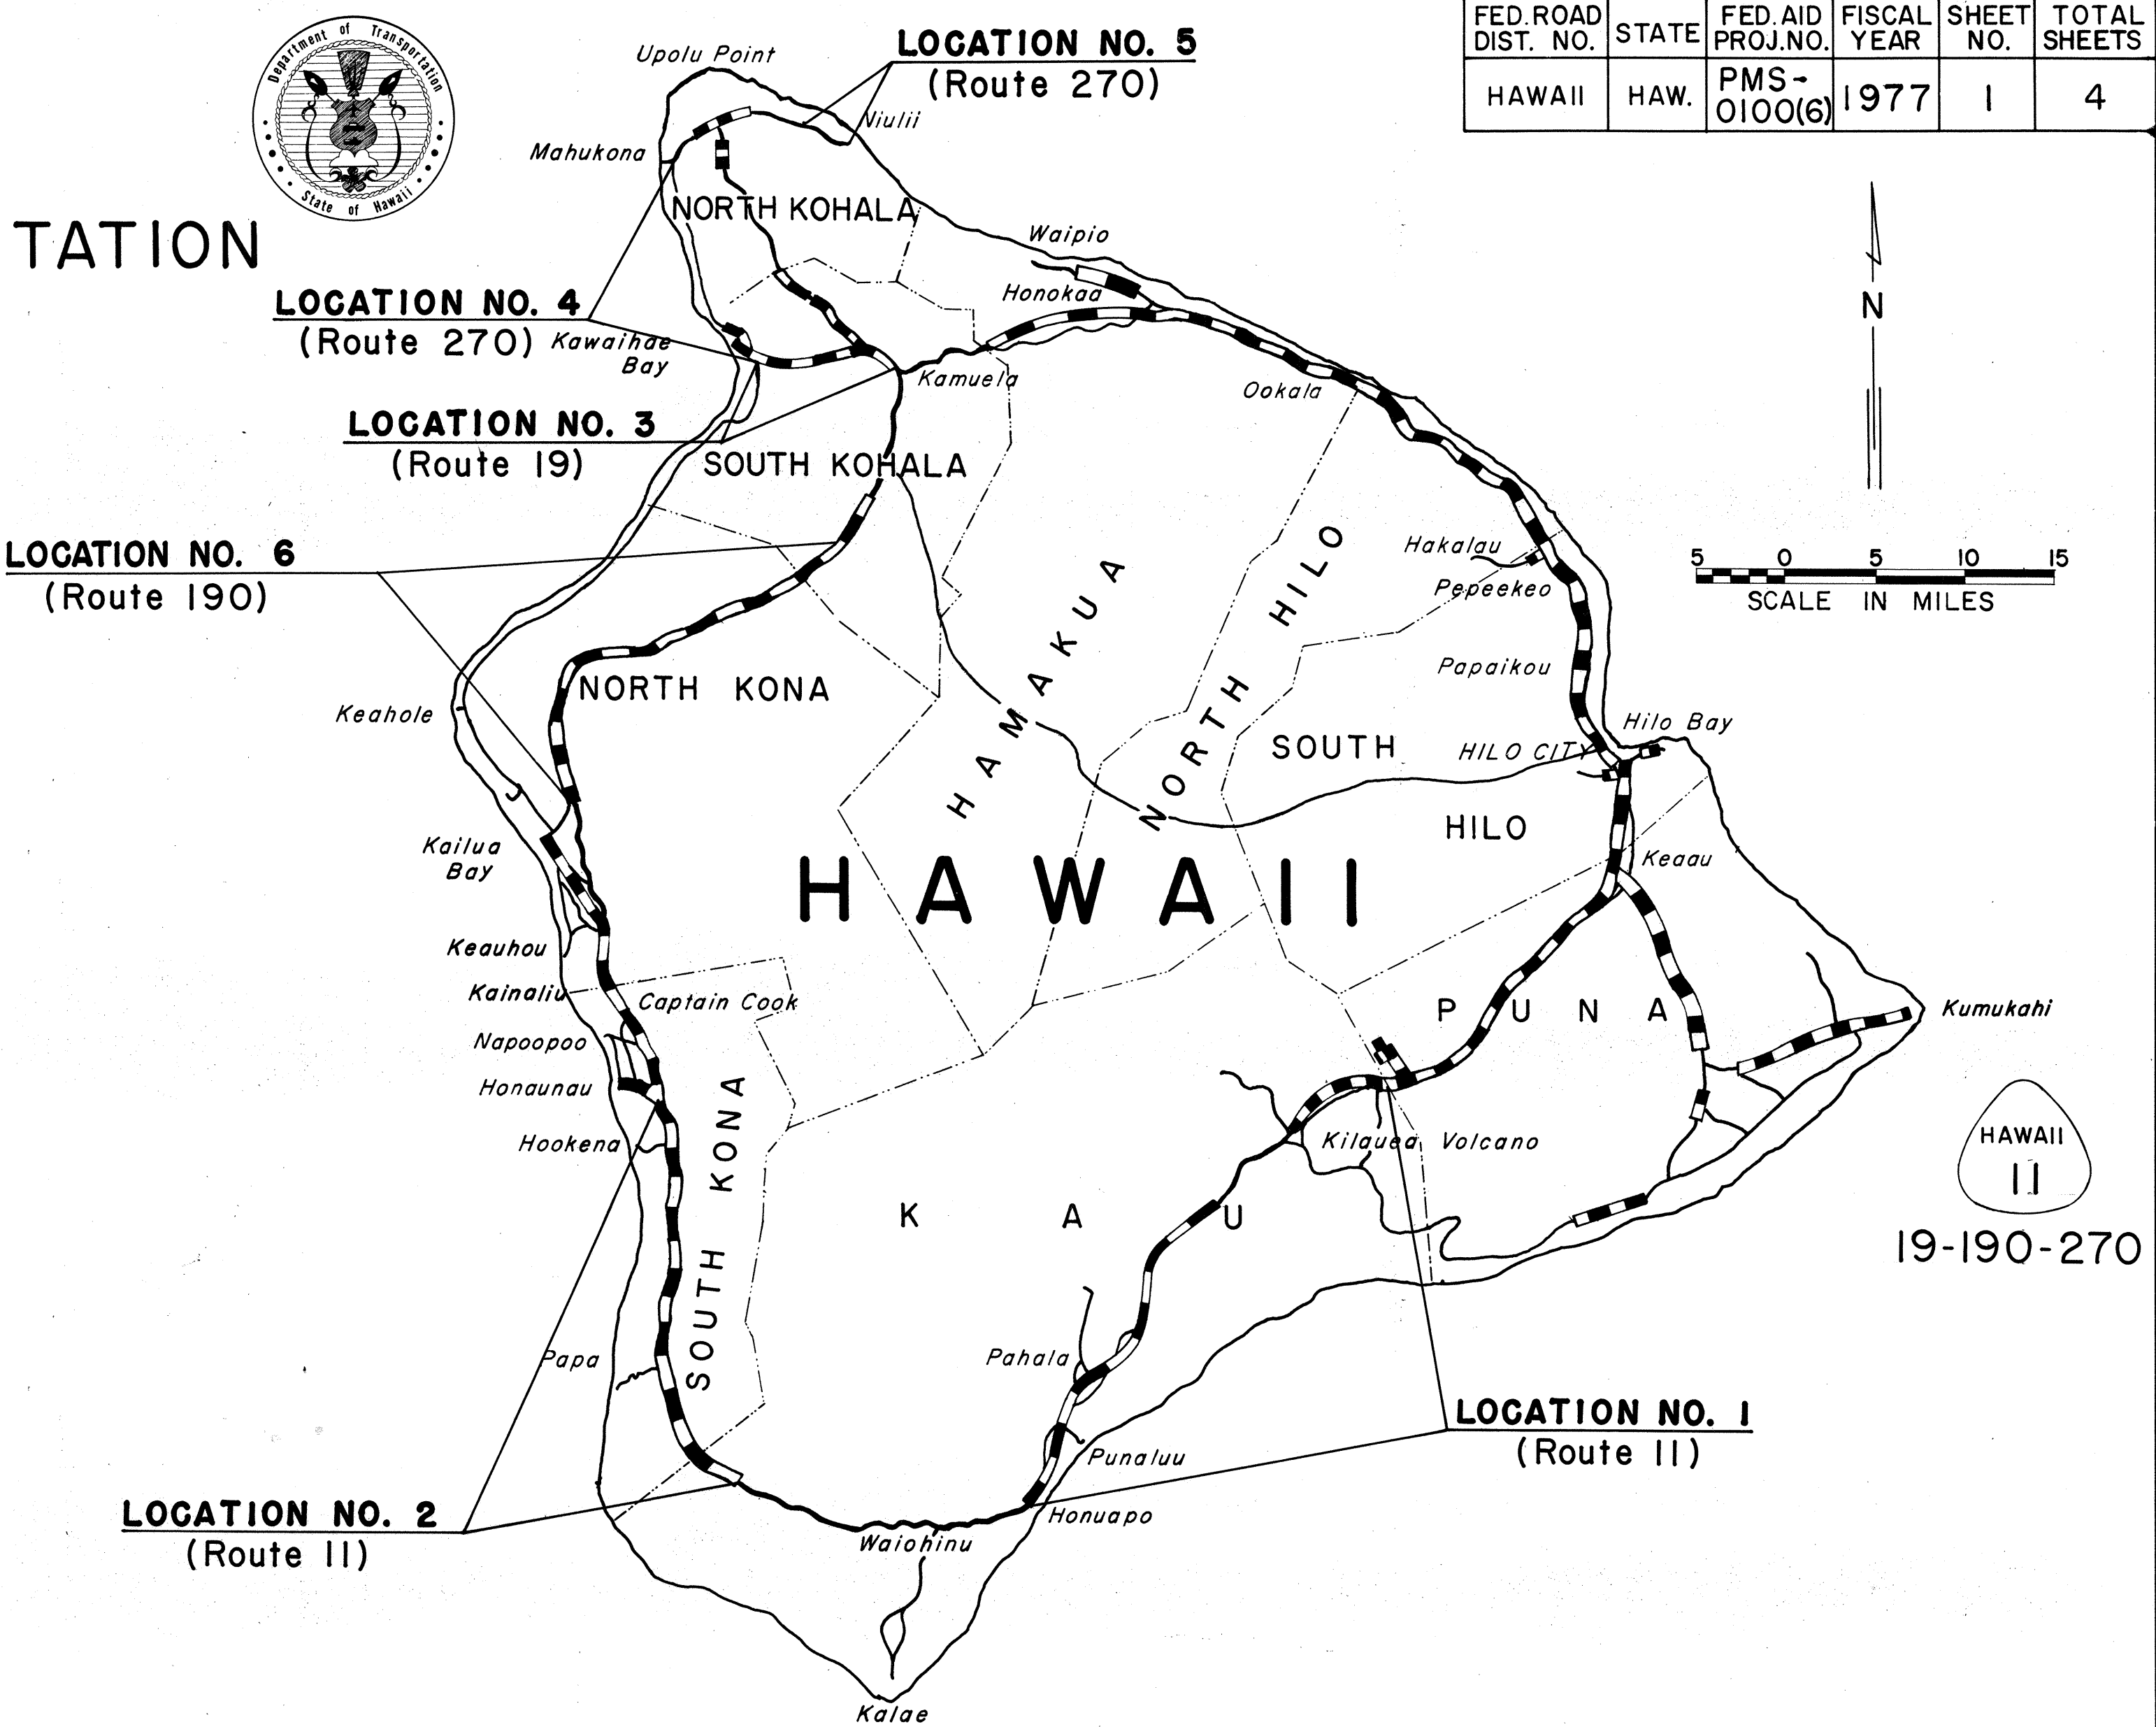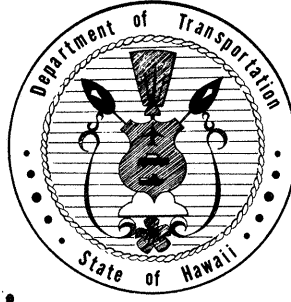

GENERAL LOCATIONS

PROJECT NO. PMS-0100(6)

Federal Aid Projects Previously Constructed Or Under Construction

NO CHANGES WERE MADE DURING CONSTRUCTION

ON THESE PLANS EXCEPT CHANGES IN THE

ORIGINAL THEORETICAL QUANTITIES. FOR ACTUAL

QUANTITIES, REFER TO PROJECT LEDGER AND/OR

COMPUTATION BOOK.

[Signature]

RESIDENT ENGINEER

[Signature]

DATE

DEPARTMENT OF TRANSPORTATION

FEDERAL HIGHWAY ADMINISTRATION

APPROVED:

[Signature]

DIVISION ADMINISTRATOR

[Signature]

DATE

DEPARTMENT OF TRANSPORTATION

STATE OF HAWAII

APPROVED:

[Signature]

for DIR. OF TRANSPORTATION

[Signature]

DATE

HAWAII DISTRICT

DESIGNED BY

A. Nishimura

P. S. & E. BY

548-7537

PHONE

Dec. 1976

DATE