

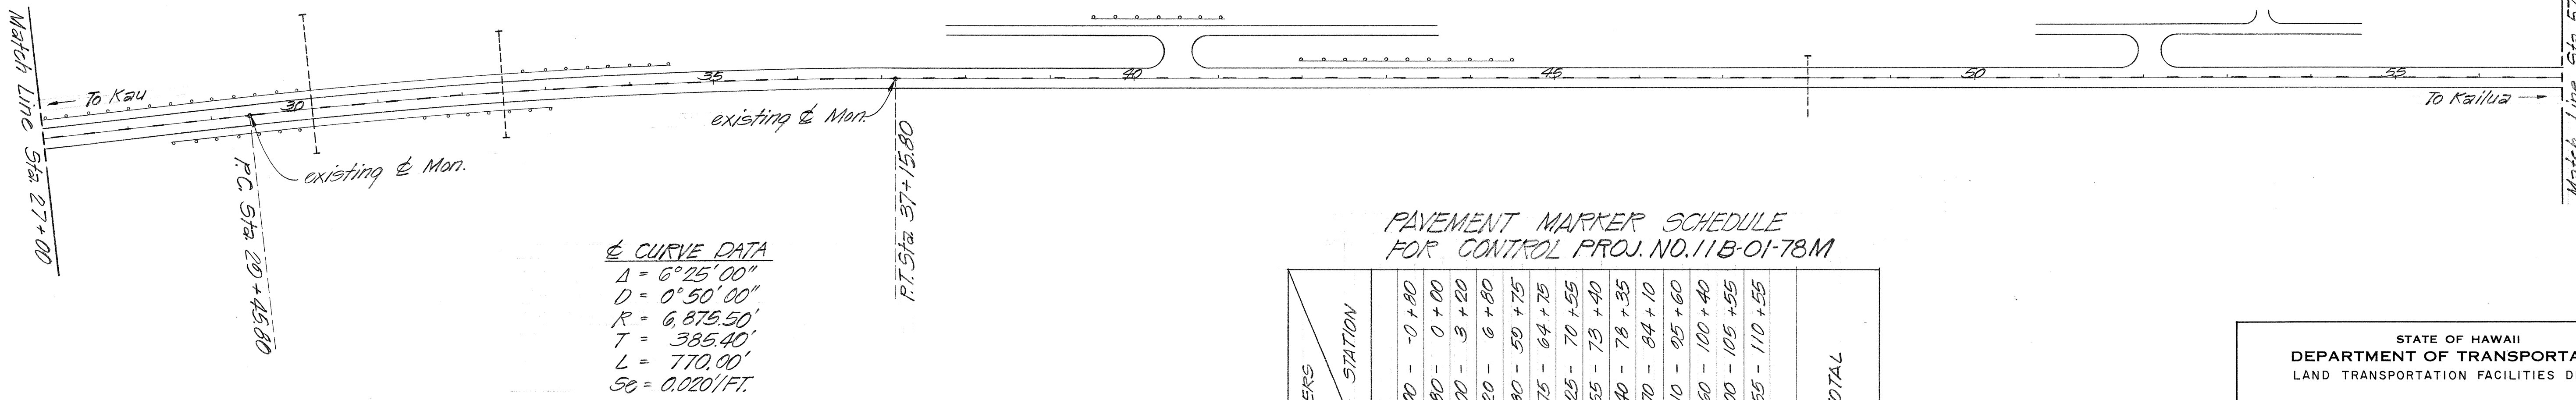


FED. ROAD DIST. NO.	STATE	PROJ. NO.	FISCAL YEAR	SHEET NO.	TOTAL SHEETS
HAWAII	HAW.	11B-0178M	1978	10	15

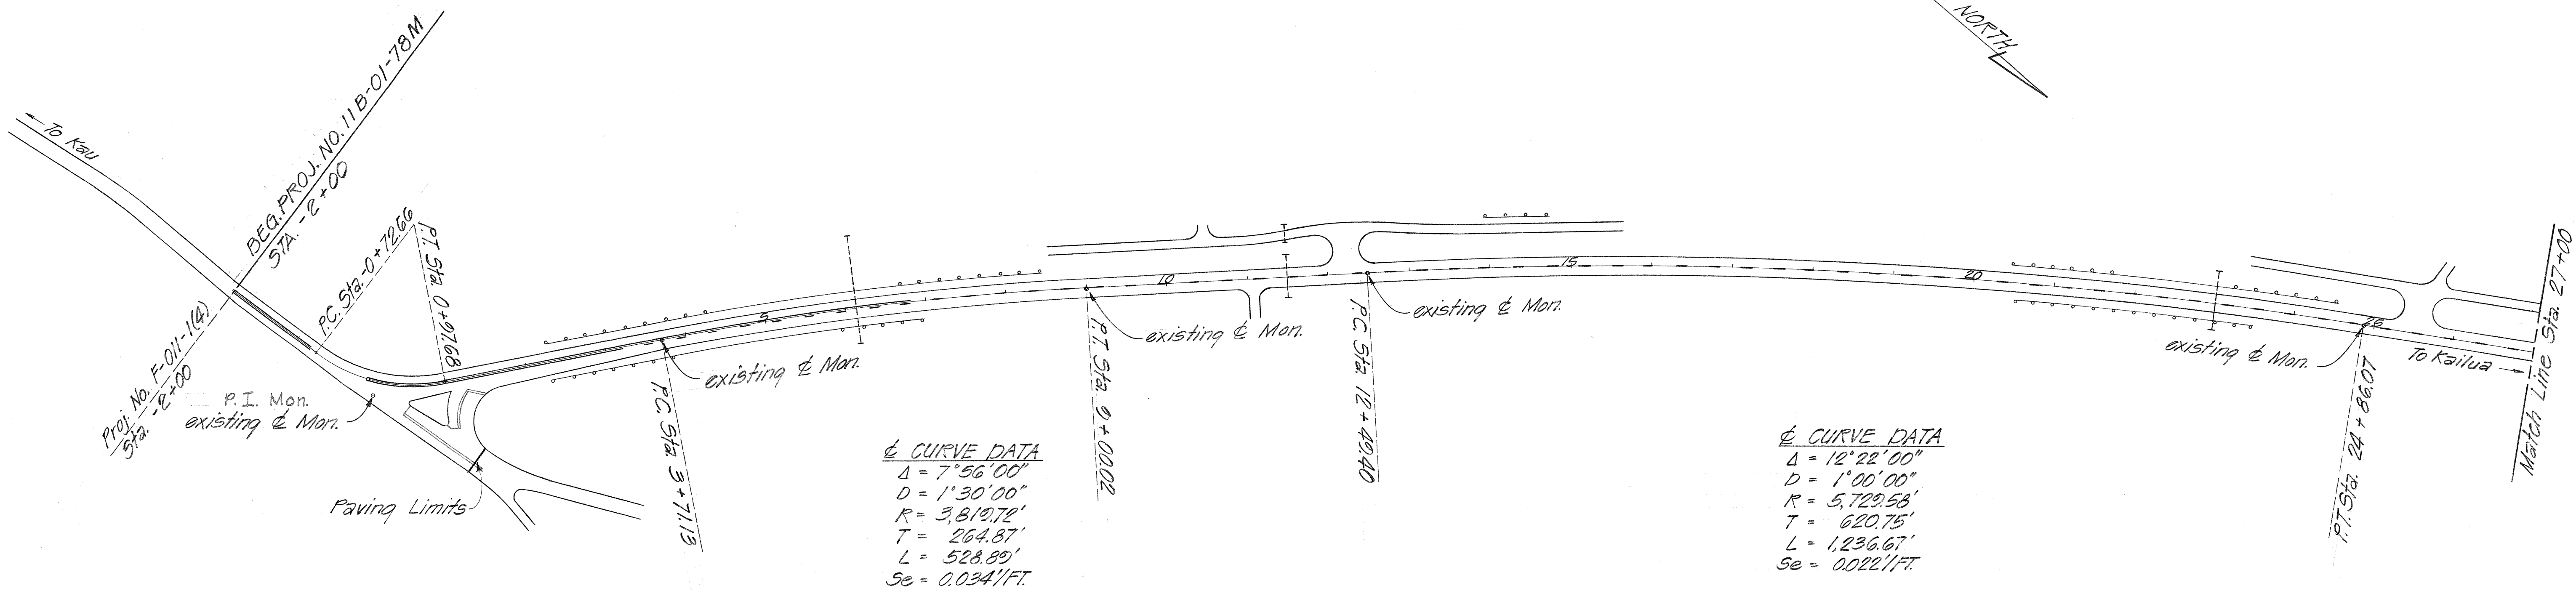


PAVEMENT MARKER SCHEDULE FOR CONTROL PROJ. NO. 11B-01-78M																												
MARKERS STATION																										TOTAL		
TYPE D		8	2	15	9	139	13	13	8	12	13	29	12	11	13											294	212	
TYPE H					9		14	14		13	14		13	12	13											102	75	
TYPE J						36	528	56	56	28	52	56	112	52	48	52											1,080	532

FED. ROAD DIST. NO.	STATE	PROJ. NO.	FISCAL YEAR	SHEET NO.	TOTAL SHEETS
HAWAII	HAW.	11B-01 78M	1978	11	15

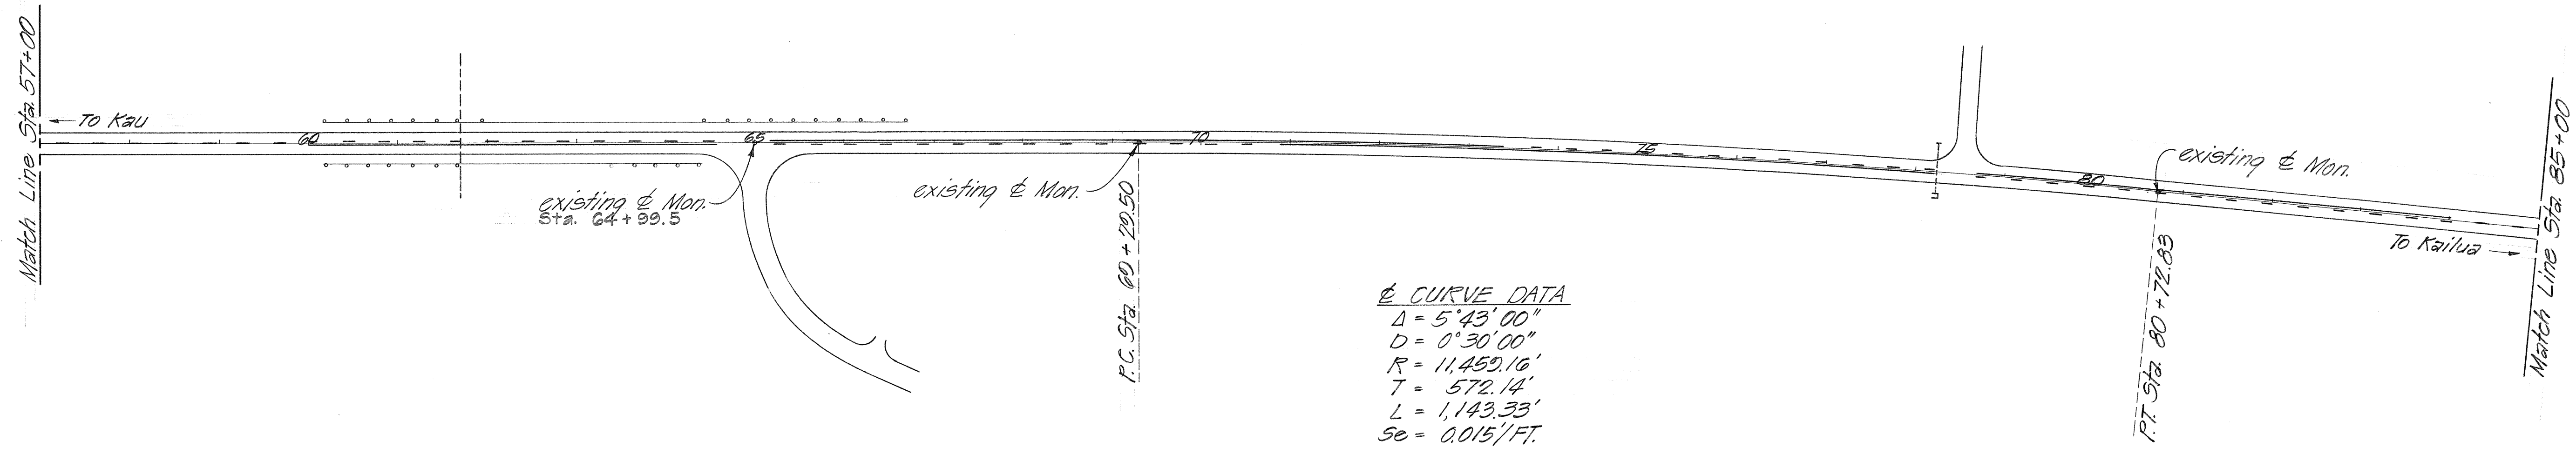

Δ = 5°43'00"
 D = 0°30'00"
 R = 11,459.16'
 T = 572.14'
 L = 1,143.33'
 Se = 0.015'/FT.

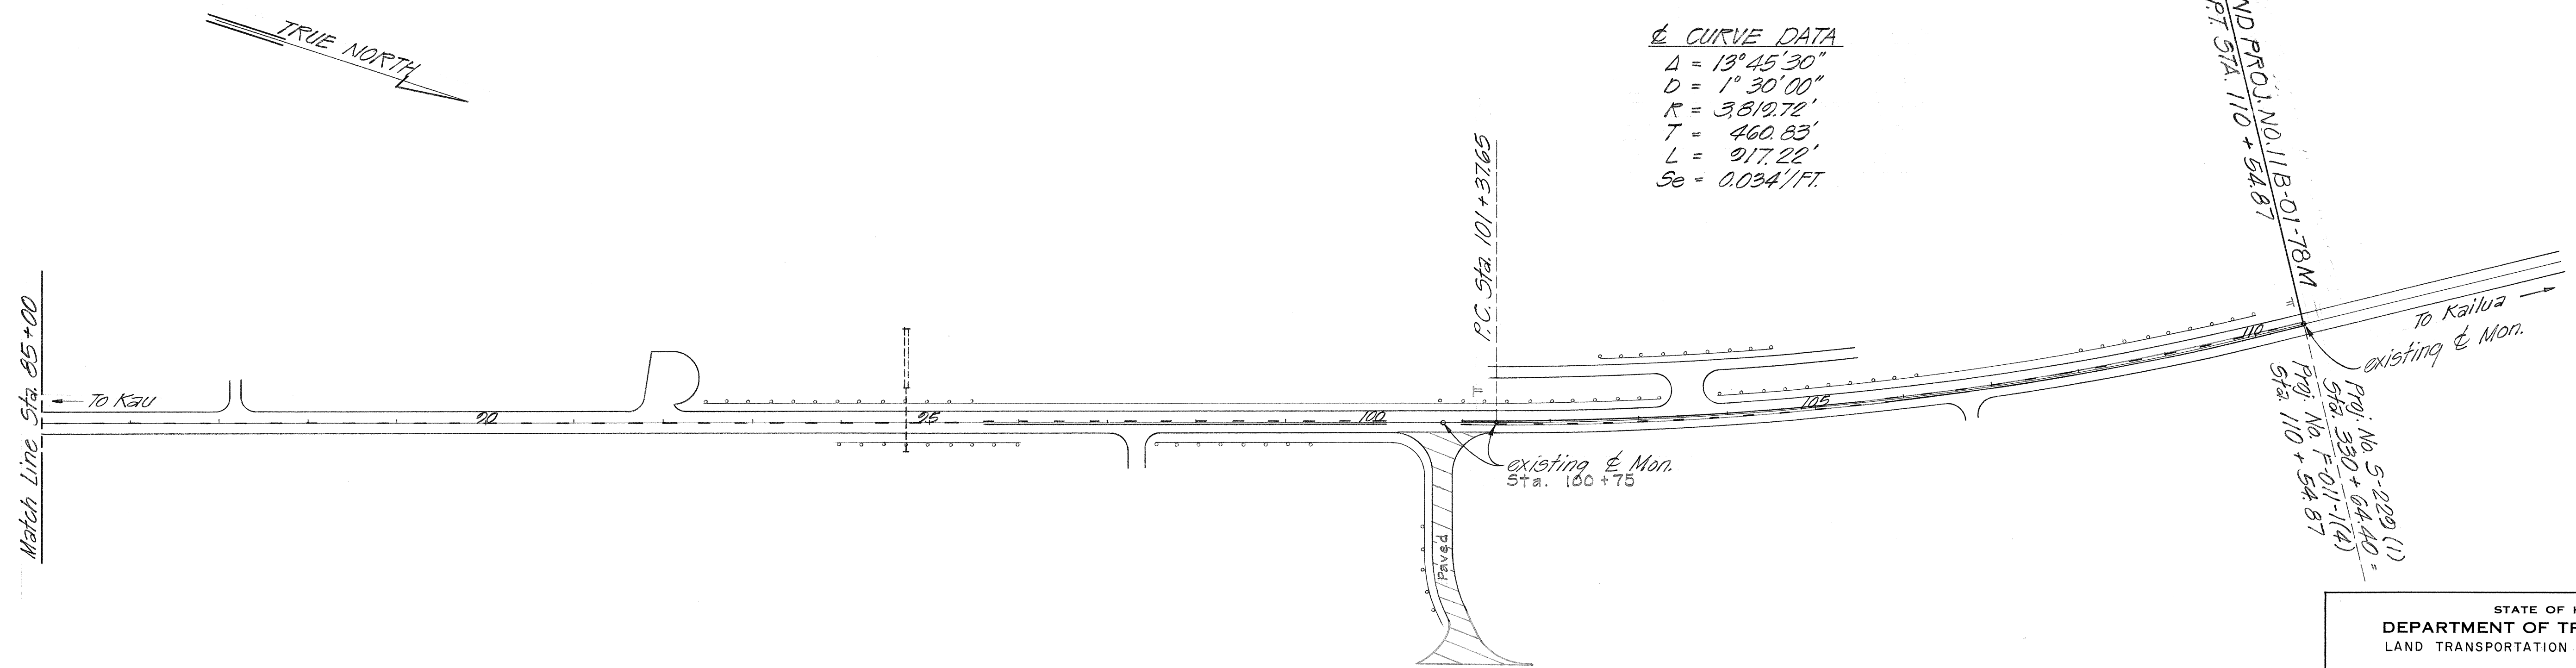

Δ = 13°45'30"
 D = 1°30'00"
 R = 3,819.72'
 T = 460.83'
 L = 917.22'
 Se = 0.034'/FT.

STATE OF HAWAII
 DEPARTMENT OF TRANSPORTATION
 LAND TRANSPORTATION FACILITIES DIVISION

ROADWAY PLAN
HAWAII BELT ROAD RESURFACING
KAINALIU TO KEAUHOU
PROJ. NO. 11B-01-78M
 Scale: 1"=100' Date: Sept. 1977
 SHEET No. 2 OF 2 SHEETS

SURVEY PLOTTED BY	DATE
DRAWN BY	
TRACED BY	
CHECKED BY	
NOTE BOOK	
No.	