
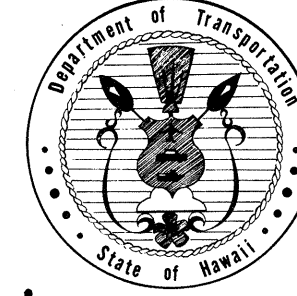


INDEX TO DRAWINGS	
SHEET NO.	DESCRIPTION
1	TITLE SHEET
2	GENERAL LOCATION PLAN
3	TYPICAL SECTIONS & DETAILS
4-9	ROADWAY PLANS, 19F-01-78M
10,11	ROADWAY PLANS, 11B-01-78M
12,13	ROADWAY PLANS, 19J-01-78M
14	STANDARD DETAIL
15	CONSTRUCTION SIGNS DETAILS

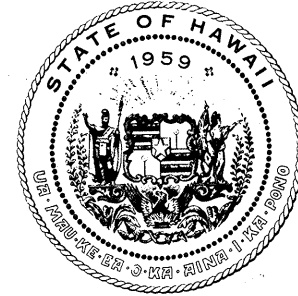

STATE OF HAWAII
DEPARTMENT OF TRANSPORTATION
LAND TRANSPORTATION FACILITIES DIVISION
PLANS FOR
HAWAII BELT ROAD
REFLECTIVE PAVEMENT MARKING PROGRAM (PHASE III)
FEDERAL AID PROJECT NO. PMS-0100(10)
AND
RESURFACING AND REHABILITATION PROGRAM
OF HIGHWAYS AT VARIOUS LOCATIONS
ON THE ISLAND OF HAWAII


"AS BUILT"

HAWAII BELT ROAD RESURFACING
MUD LANE TO HONOKAA
PROJECT NO. 19F-01-78M
DISTRICTS OF SOUTH KOHALA & HAMAKUA

HAWAII BELT ROAD RESURFACING
KAINALIU TO KEAUHOU
PROJECT NO. 11B-01-78M
DISTRICT OF NORTH KONA

HAWAII BELT ROAD RESURFACING
PEPEEKEO TO HONOMU
PROJECT NO. 19J-01-78M
DISTRICT OF SOUTH HILO

FED. ROAD DIST. NO.	STATE	PROJ. NO.	FISCAL YEAR	SHEET NO.	TOTAL SHEETS
HAWAII	HAW.	19F-01-78M 11B-01-78M 19J-01-78M	1978	1	15

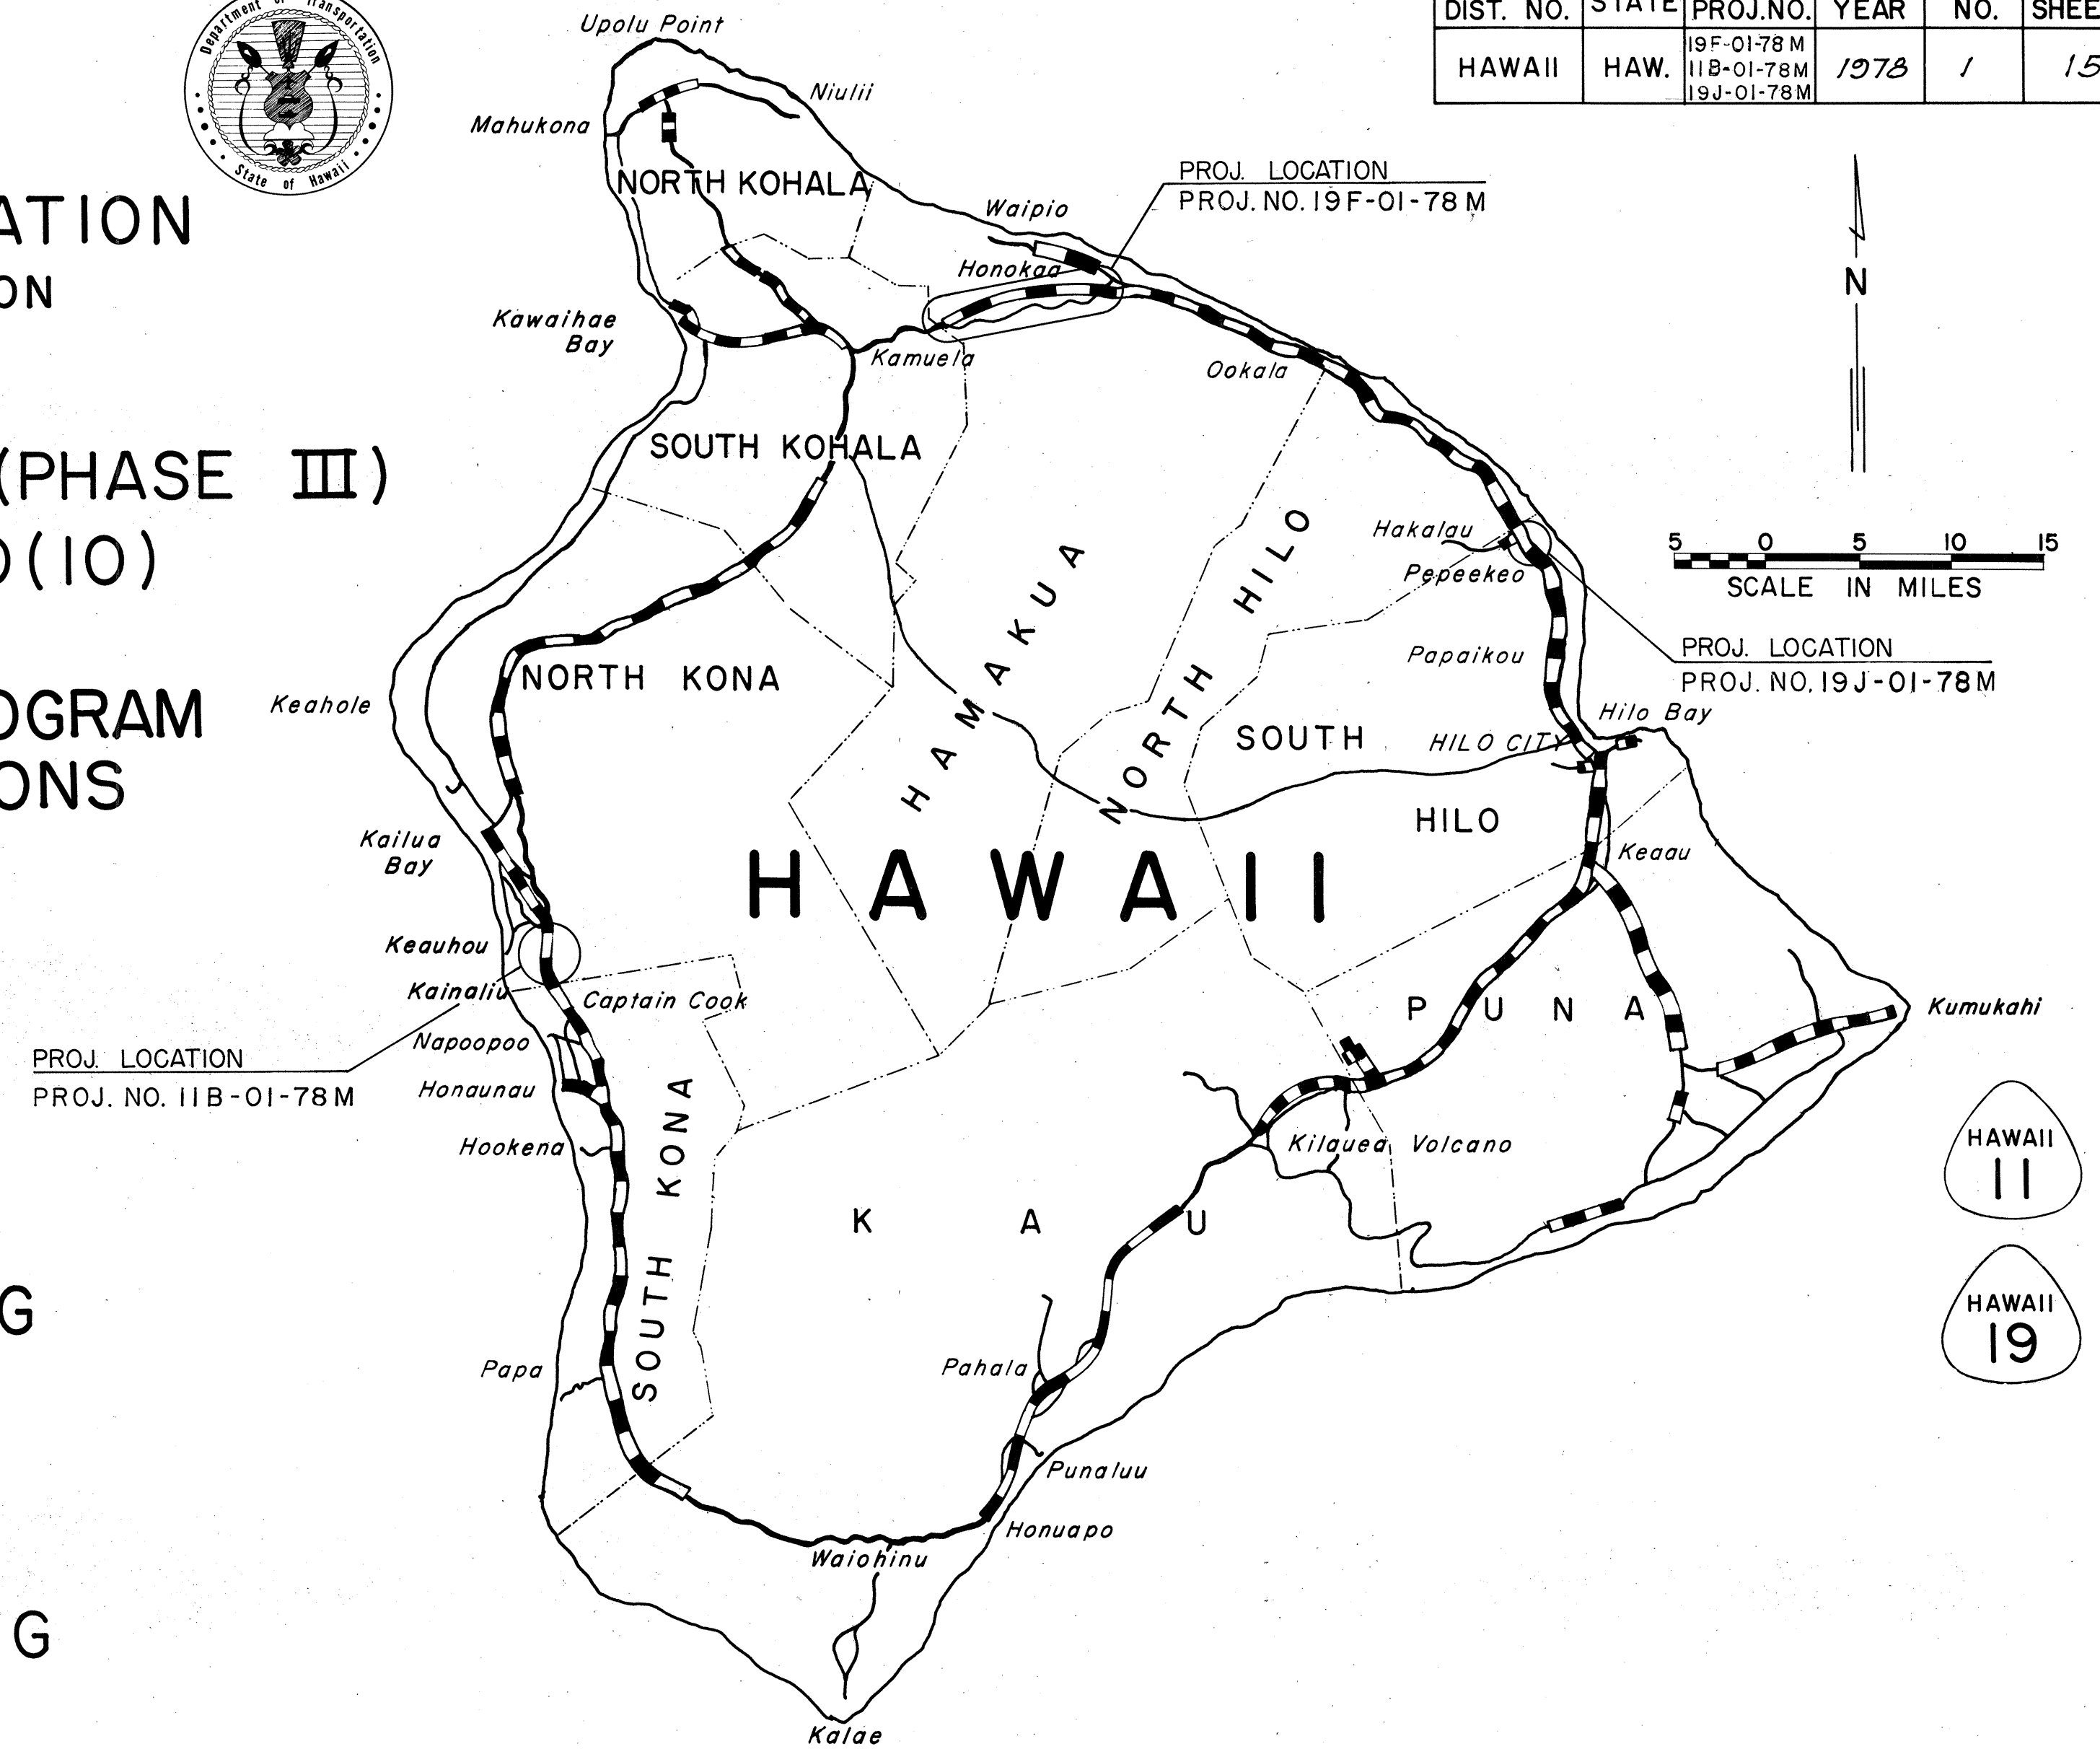

Federal Aid Projects Previously Constructed Or Under Construction

ALL CHANGES MADE DURING CONSTRUCTION
HAVE BEEN INCORPORATED ON THESE PLANS
EXCEPT CHANGES IN THE ORIGINAL
THEORETICAL QUANTITIES.

[Signature]
PROJECT ENGINEER

10-24-78
DATE

DEPARTMENT OF TRANSPORTATION STATE OF HAWAII	
APPROVED:	
<i>R. Higashionna</i>	11-14-77
DIR. OF TRANSPORTATION	DATE

HAWAII DISTRICT DESIGNED BY ROY MIKAMI 548-7534 NOV. 15, 1977
P. S. & E. BY PHONE DATE