




FED. ROAD DIST. NO.	STATE	PROJ. NO.	FISCAL YEAR	SHEET NO.	TOTAL SHEETS
HAWAII	HAW.	11G-01-78	1978	6	9

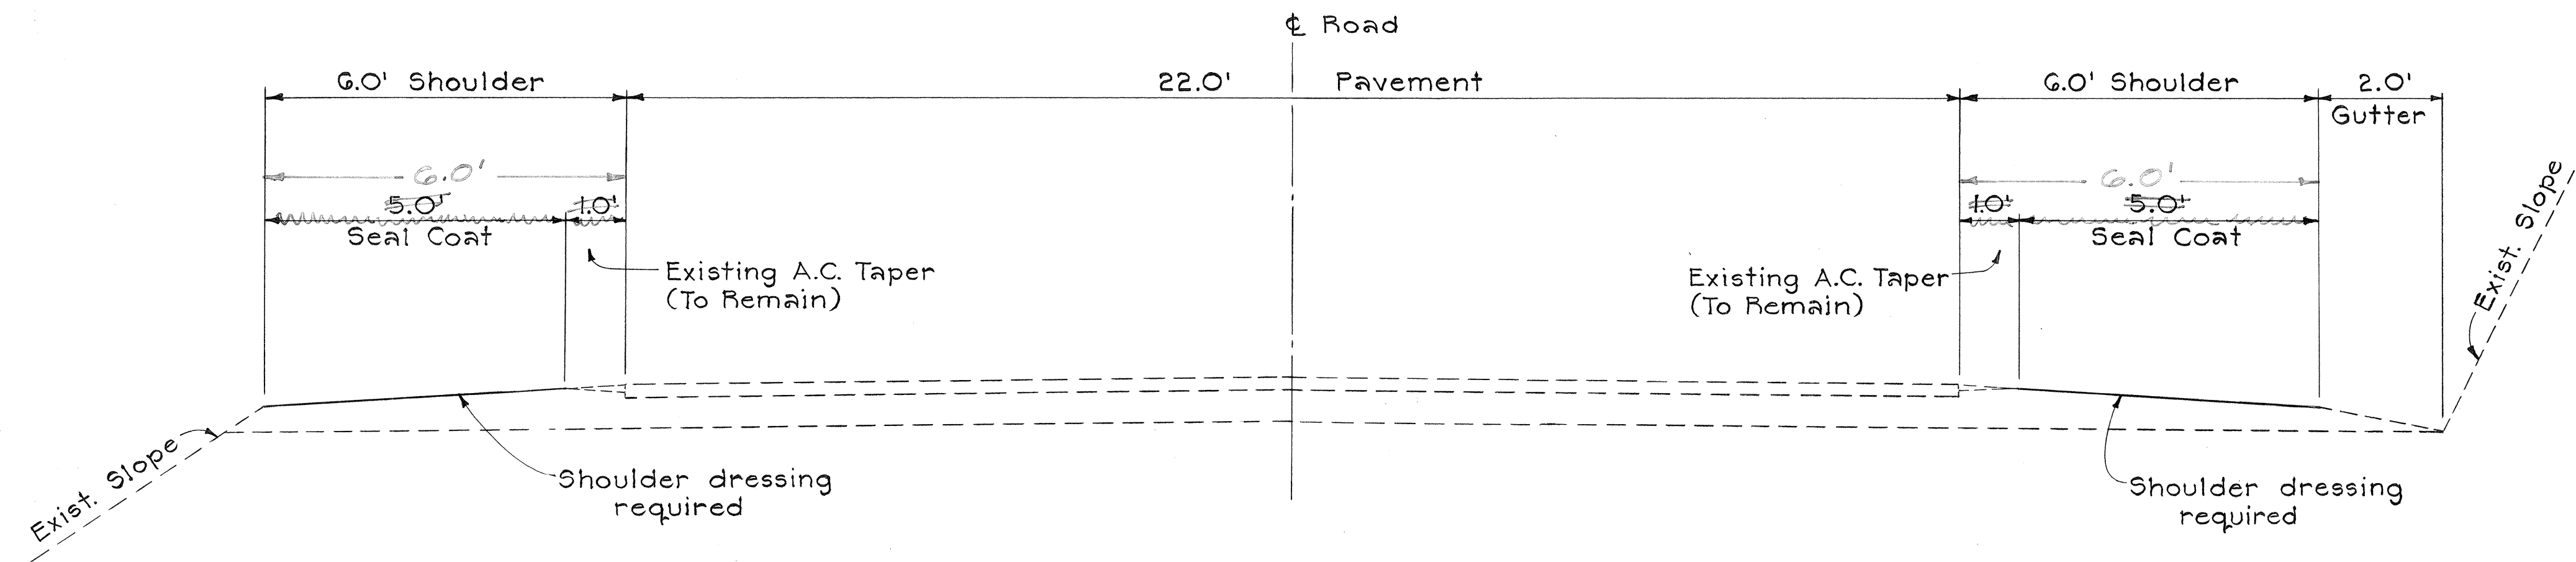

TYPICAL SECTION
Scale: 1/2" = 1'-0"

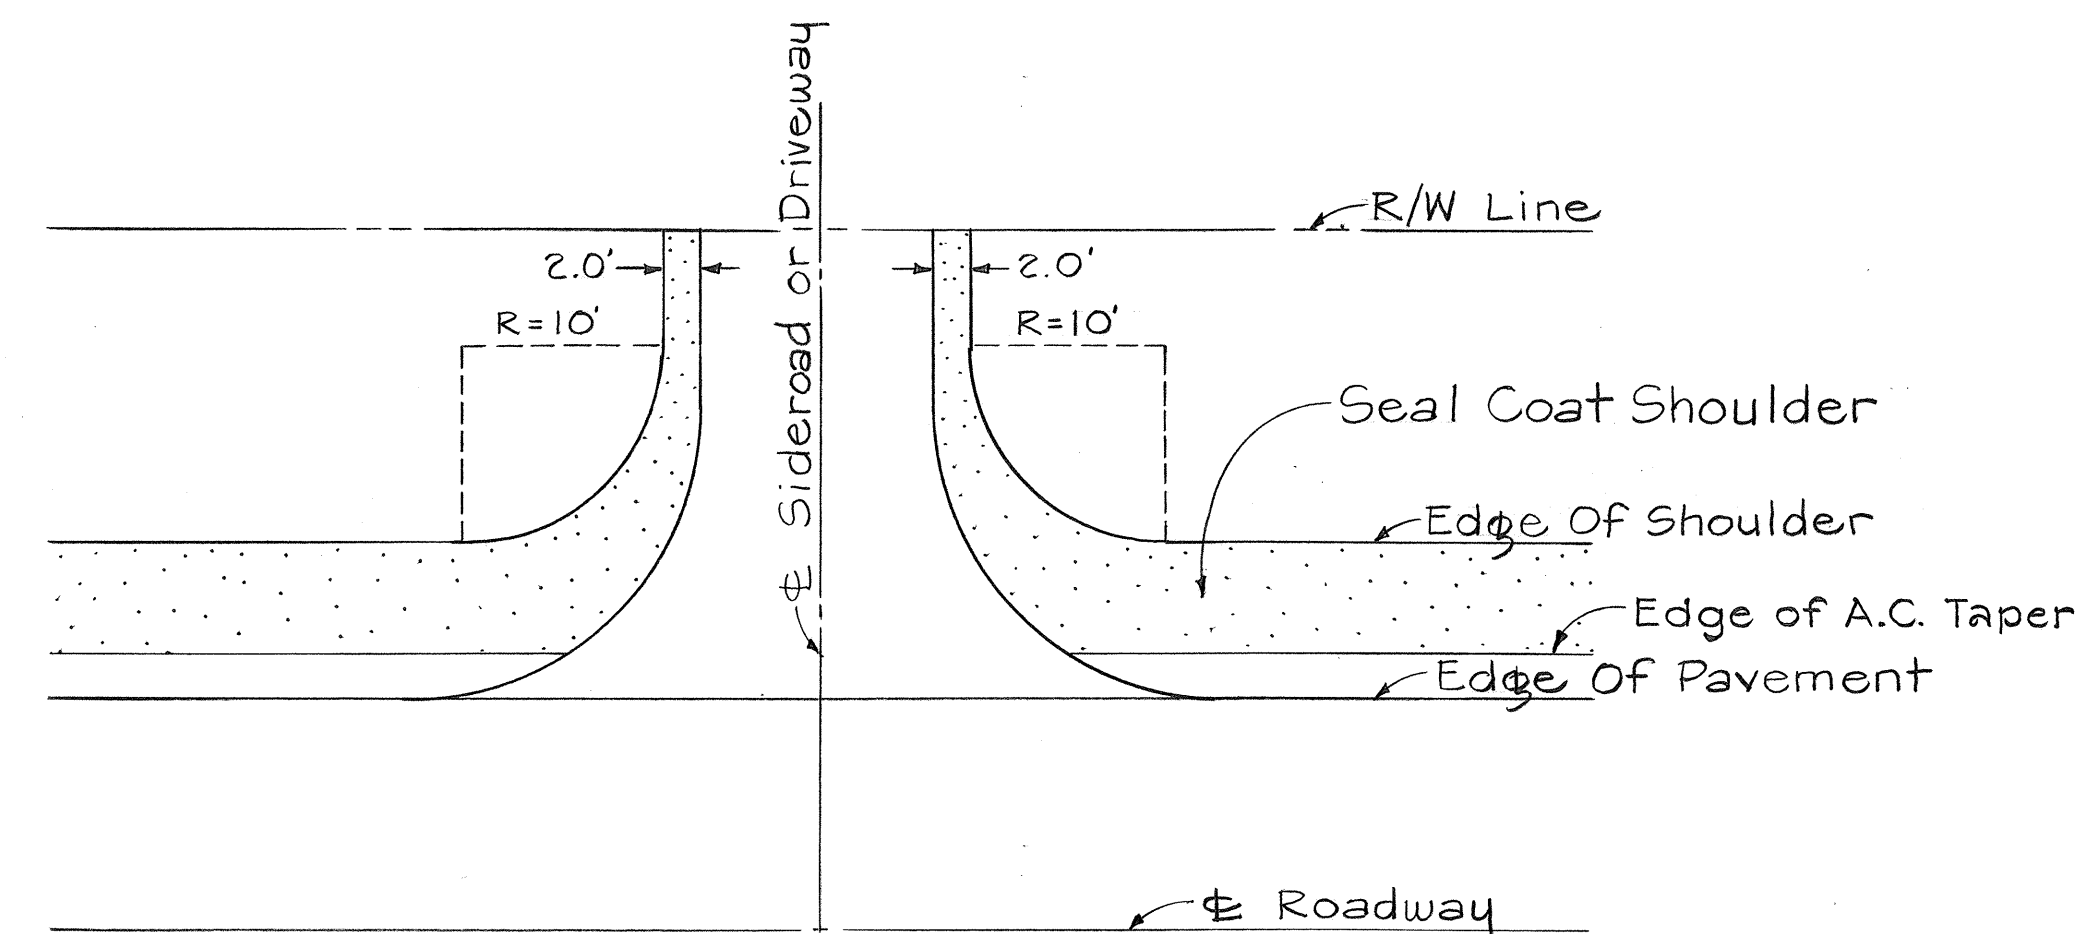

TYPICAL PLAN - SIDEROAD OR DRIVEWAY SHOULDER CONNECTION
Not To Scale

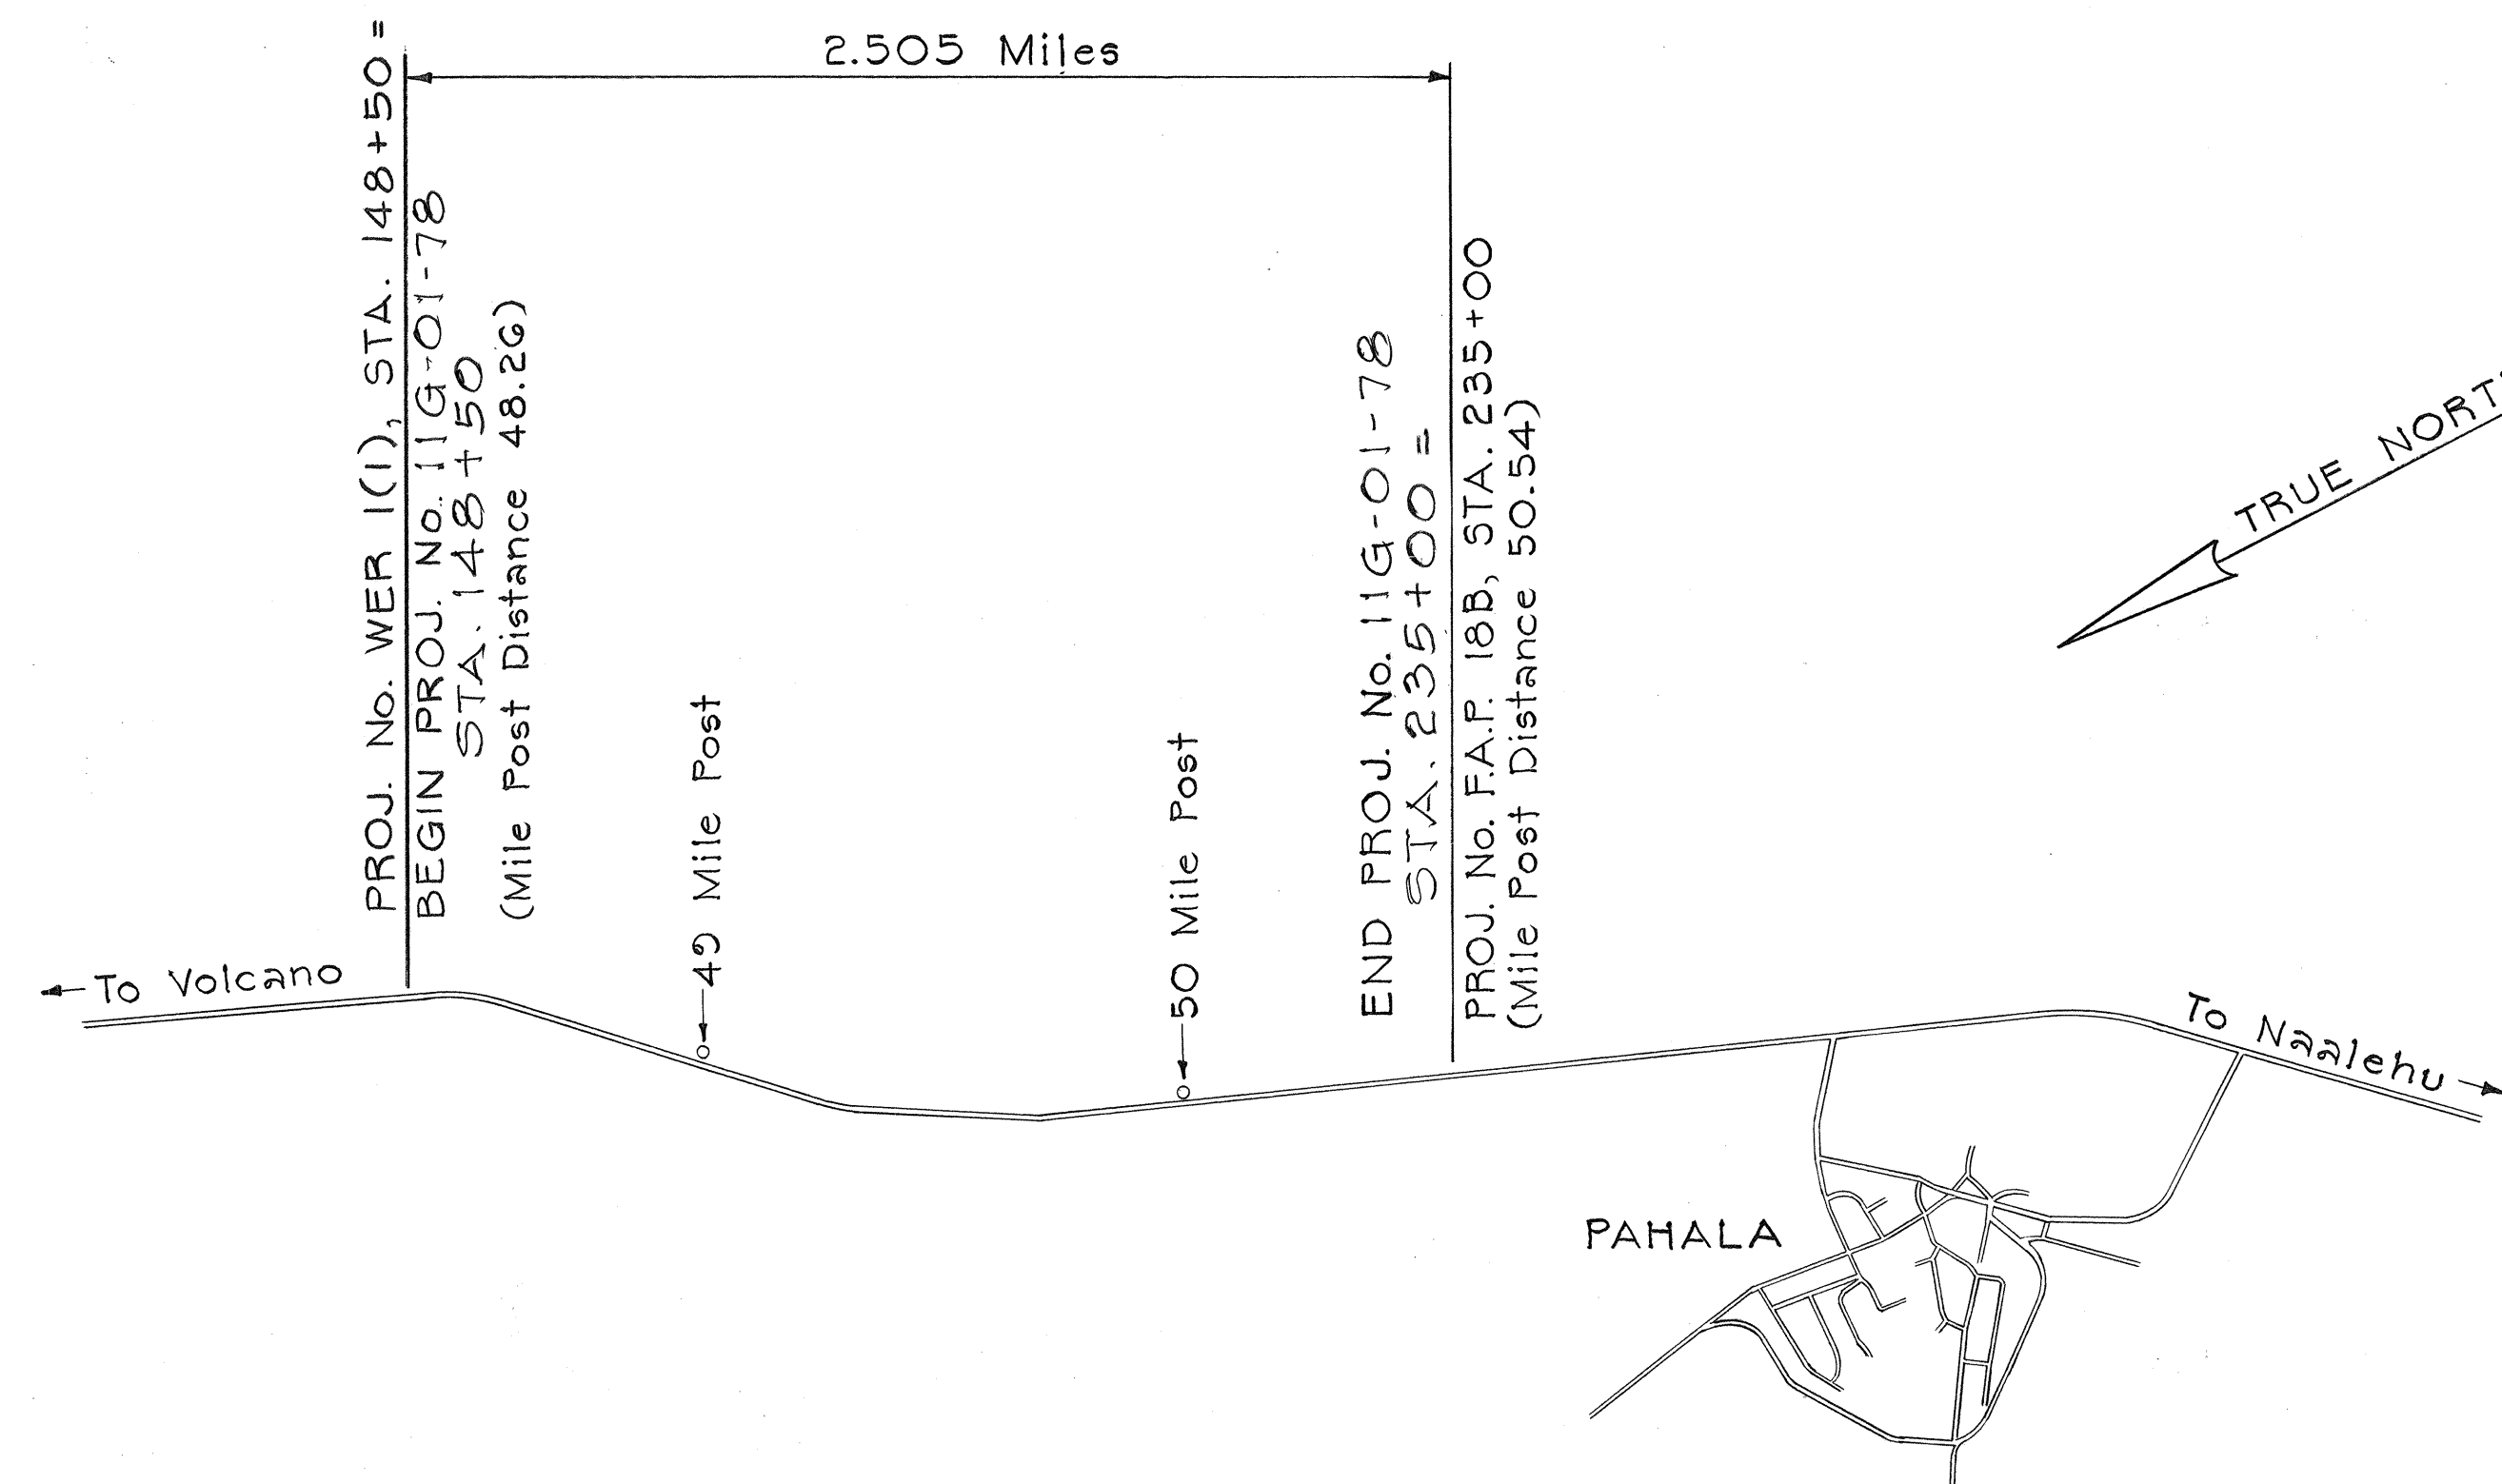

LAYOUT OF PROJECT
Scale: 1" = 2000'

GENERAL NOTES


- Existing pavement and structures in shoulder areas shall be excepted from shoulder treatment and the Contractor shall exercise reasonable care to prevent disturbing any such existing pavement and structures within the limits of work.
- Edge of pavement striping to be done by others.
- Herbicide treatment by others-refer to sub-section 306.03 for coordination requirements.

STATE OF HAWAII
DEPARTMENT OF TRANSPORTATION
LAND TRANSPORTATION FACILITIES DIVISION


SHOULDER IMPROVEMENTS
HAWAII VOLCANOES NATIONAL PARK
TOWARDS PAHALA
PROJECT No. 11G-01-78
KAU, HAWAII
Scale: As Noted Date: Jan. 1978
SHEET No. 1 OF 3 SHEETS

ORIGINAL PLAN	SURVEY PLOTTED BY	DATE
NOTE BOOK	DRAWN BY	
No.	DESIGNED BY	
	CHECKED BY	

ORIGINAL	SURVEY PLOTTED BY	DATE
PLAN	DRAWN BY	"
	TRACED BY	"
NOTE BOOK	DESIGNED BY	"
	QUANTITIES BY	"
No.	CHECKED BY	"

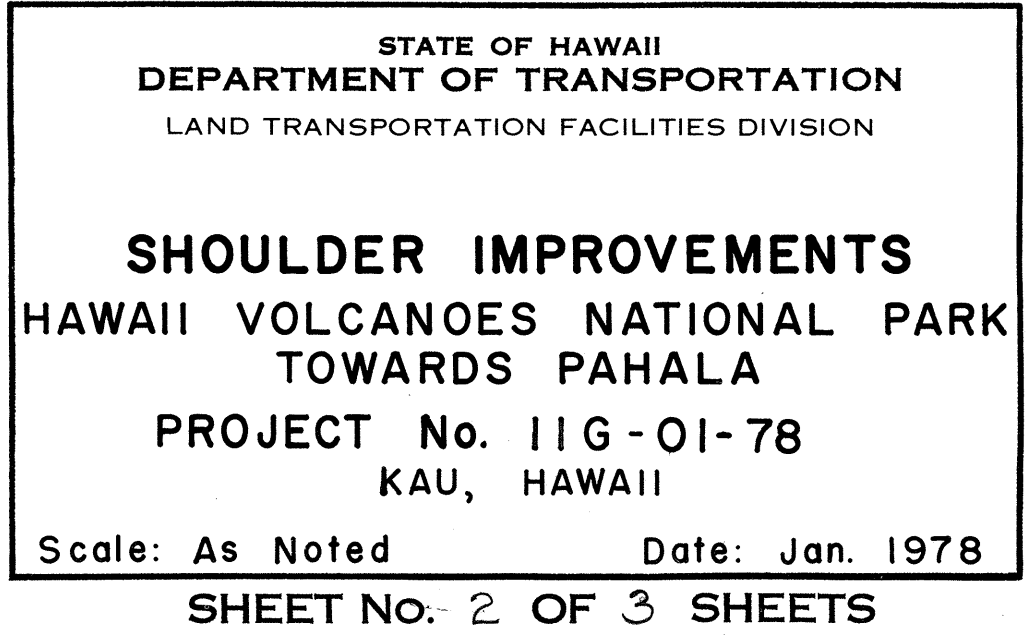

FED. ROAD DIST. NO.	STATE	FED-AID PROJ. NO.	FISCAL YEAR	SHEET NO.	TOTAL SHEETS
HAWAII	HAW.	116-01-78	1978	8	9

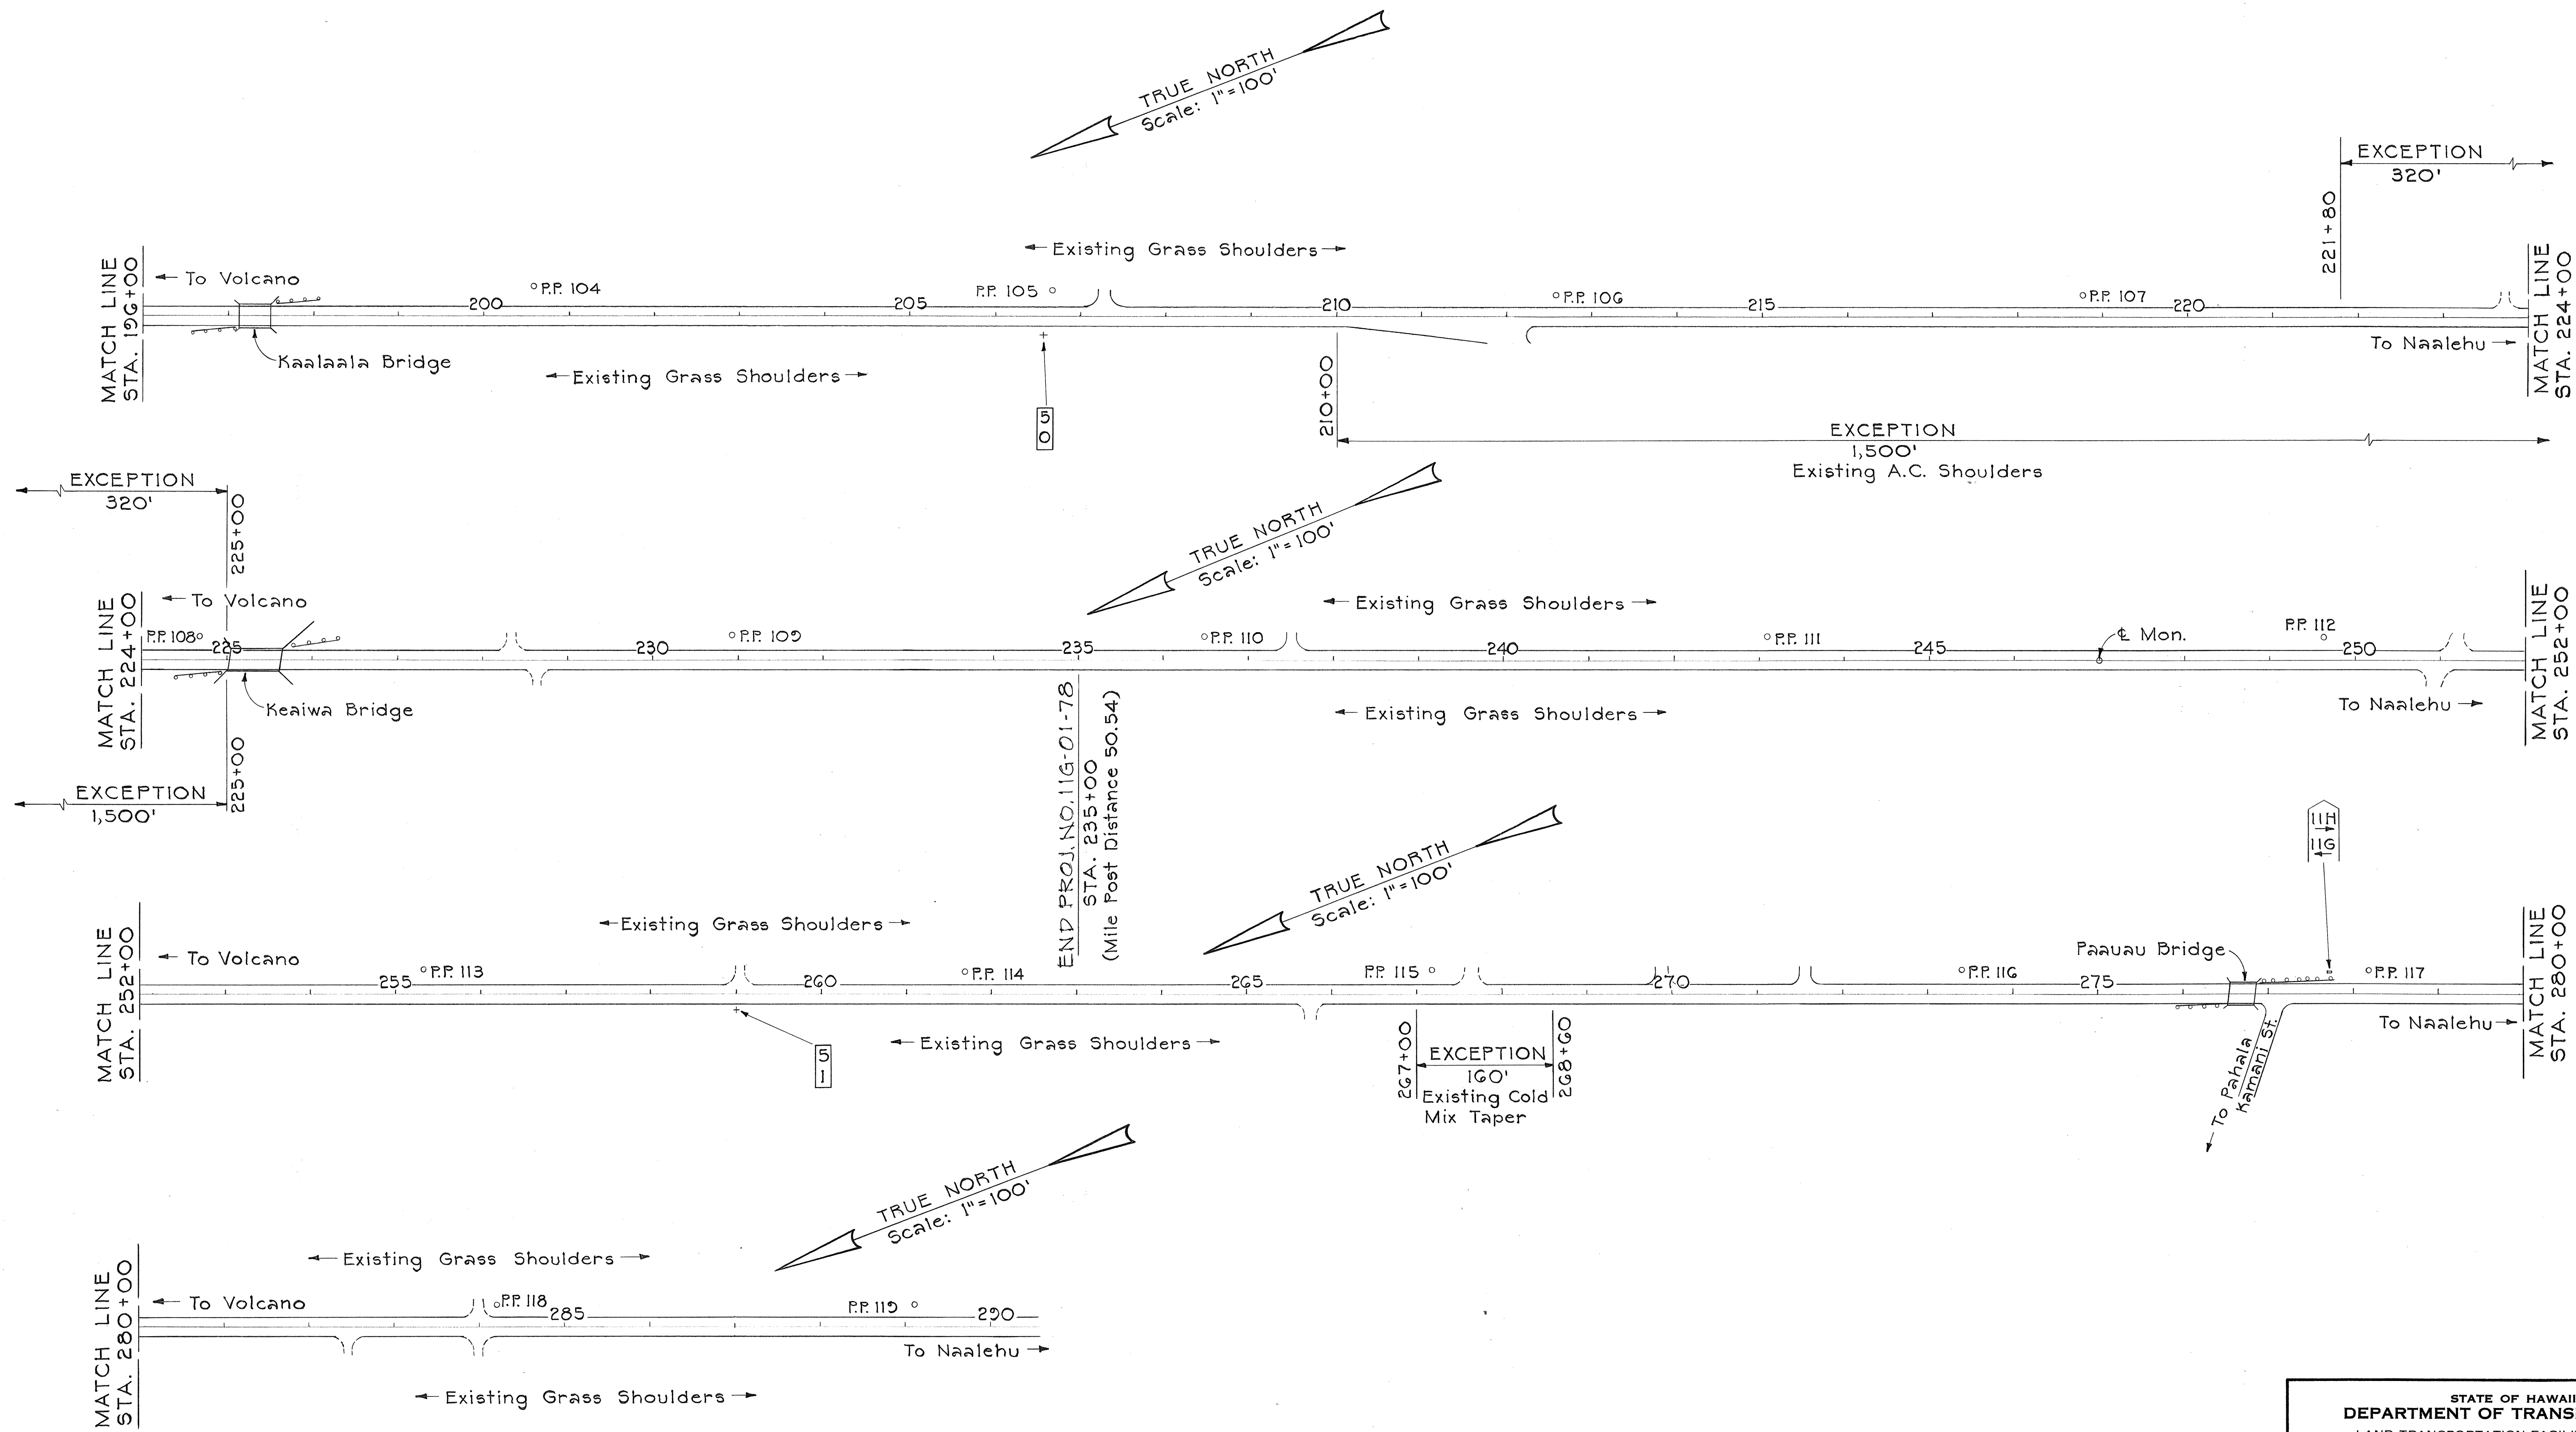

ORIGINAL PLAN	SURVEY PLOTTED BY	DATE
NOTED BY	DRAWN BY	
DESIGNED BY	TRACED BY	
QUANTITIES BY	CHECKED BY	
NO.		

STATE OF HAWAII
DEPARTMENT OF TRANSPORTATION
LAND TRANSPORTATION FACILITIES DIVISION

SHOULDER IMPROVEMENTS
HAWAII VOLCANOES NATIONAL PARK
TOWARDS PAHALA
PROJECT No. 116-01-78
KAU, HAWAII

Scale: As Noted Date: Jan. 1978
SHEET No. 3 OF 3 SHEETS