
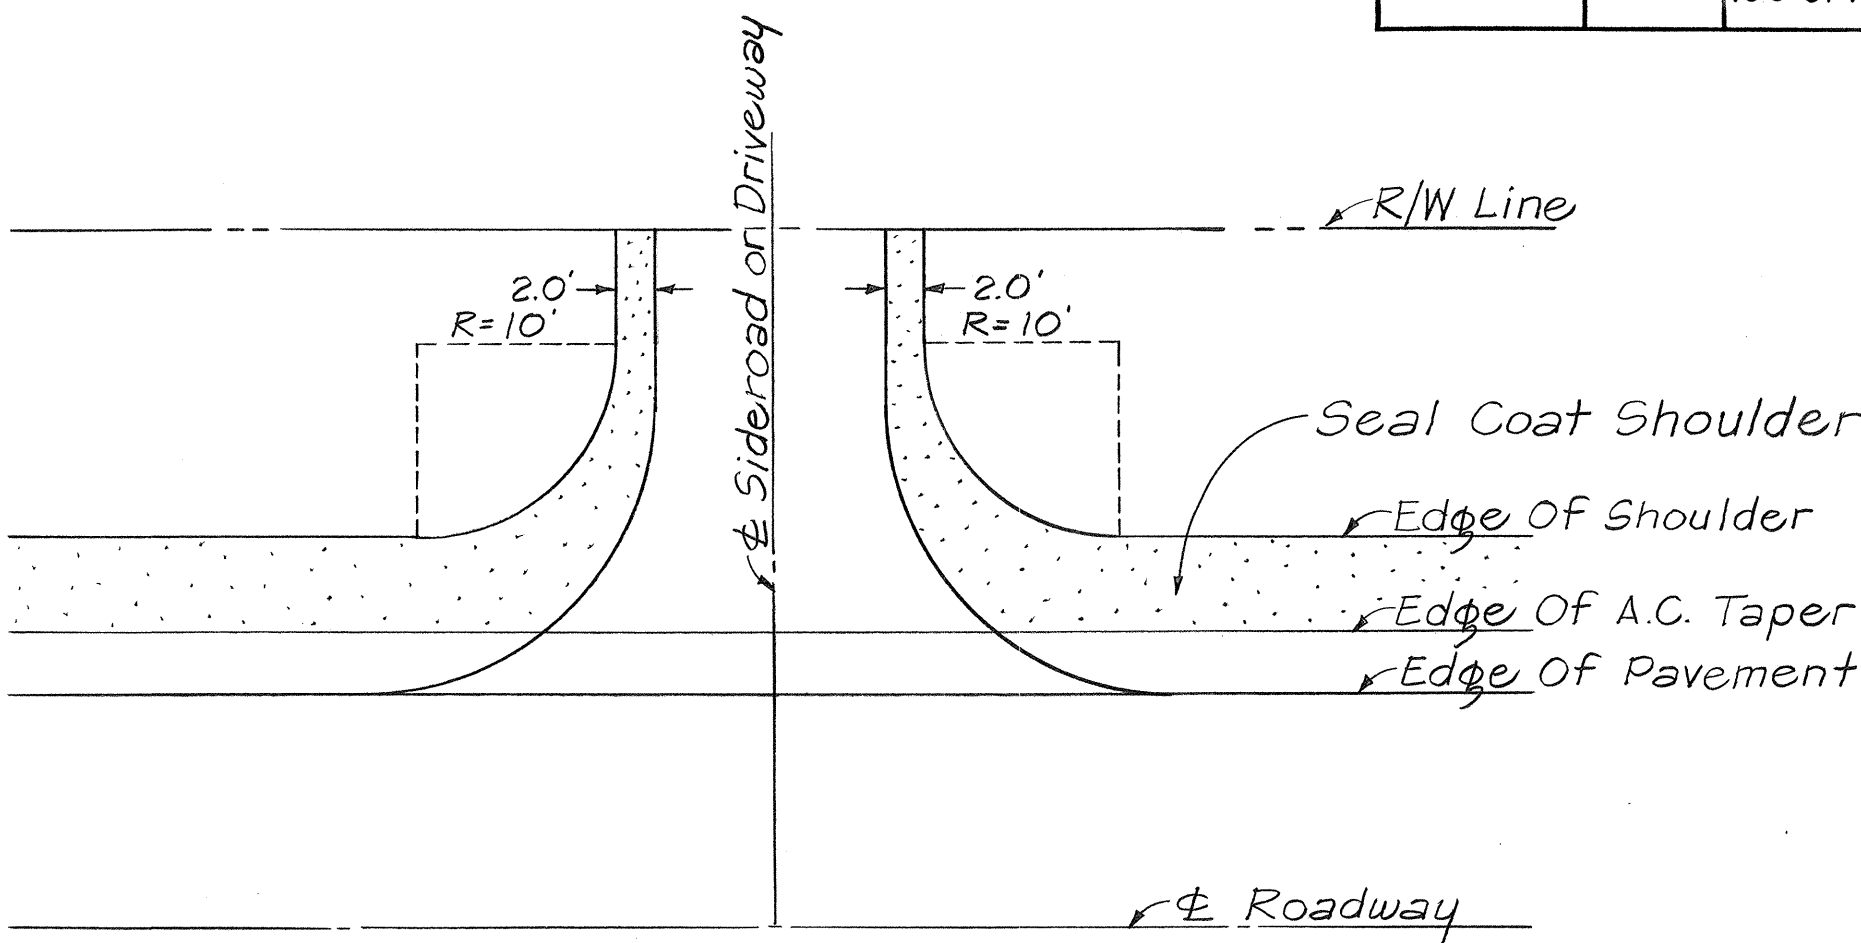


FED. ROAD DIST. NO.	STATE	PROJ. NO.	FISCAL YEAR	SHEET NO.	TOTAL SHEETS
HAWAII	HAW.	19C-01-78	1978	4	9

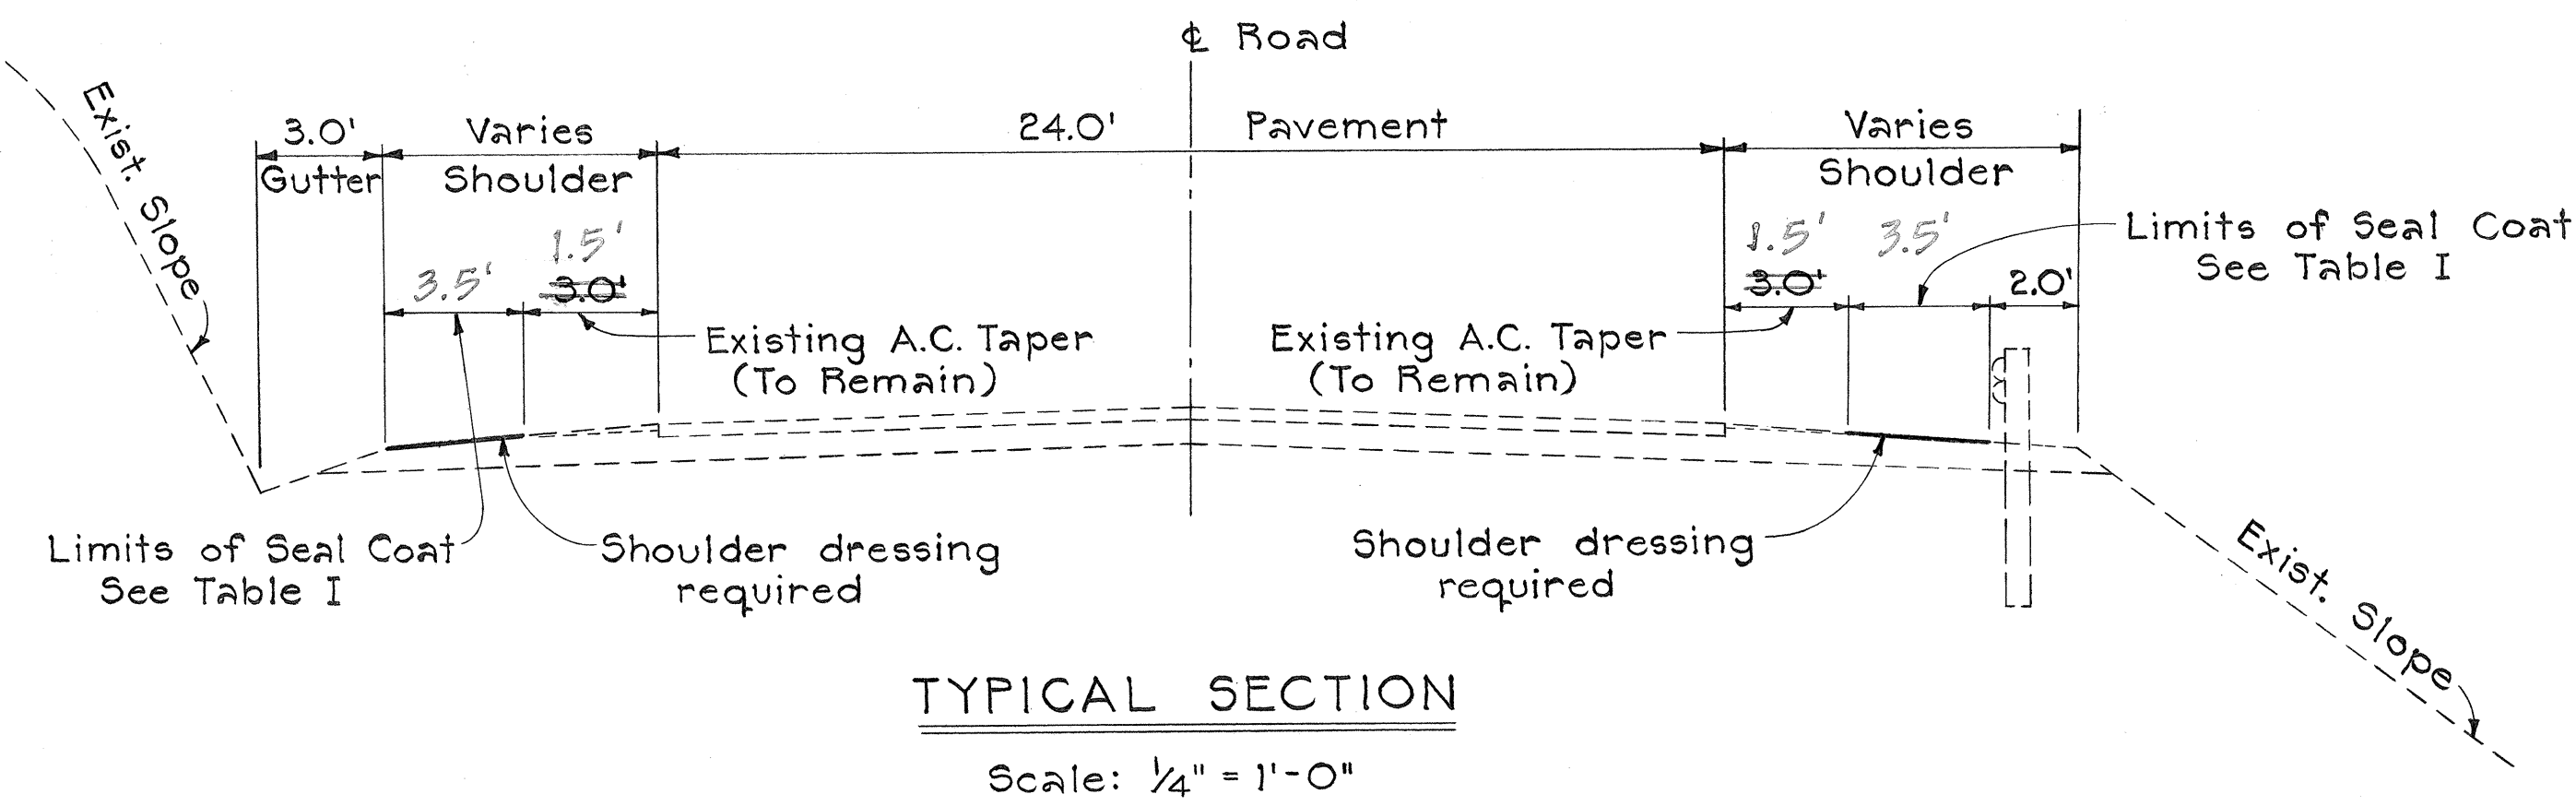

- GENERAL NOTES**
- Existing pavement and structures in shoulder areas shall be excepted from shoulder treatment and the Contractor shall exercise reasonable care to prevent disturbing any such existing pavement and structures within the limits of work.
 - Edge of pavement striping to be done by others.

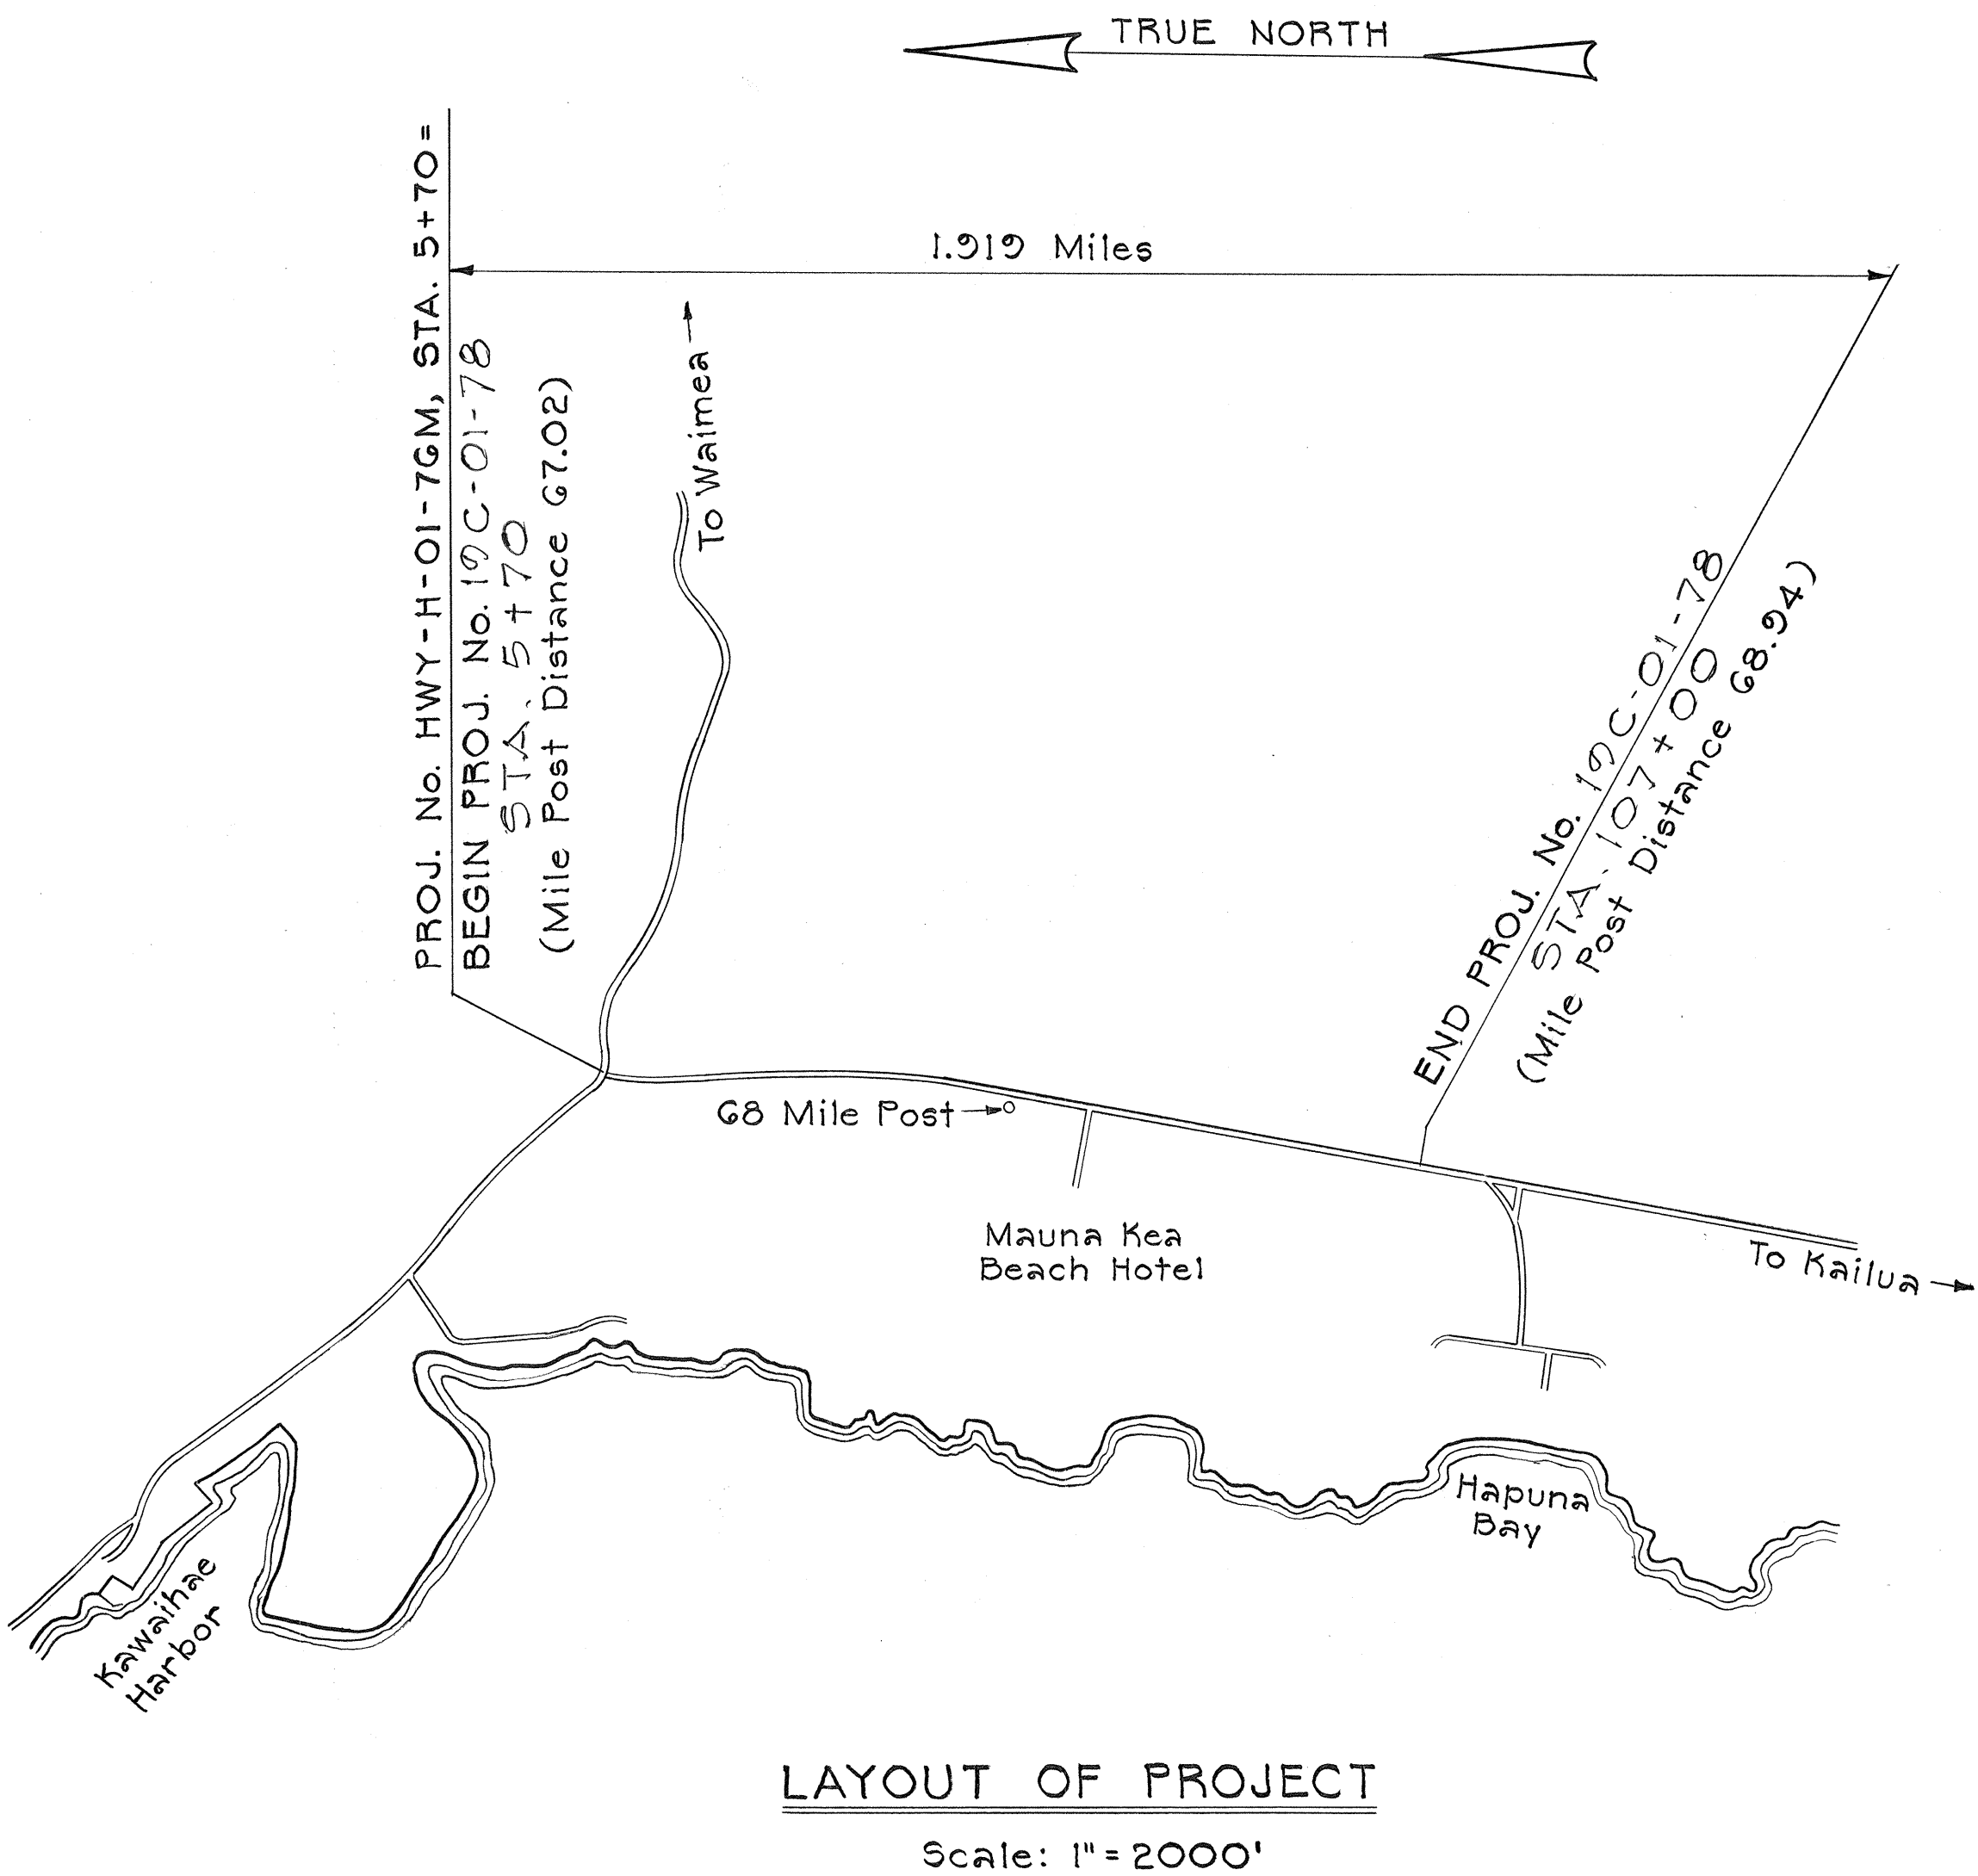


TABLE I		
LIMITS OF SEAL COAT		
STATIONS		WIDTH
FROM	TO	
<u>LEFT SIDE</u>		
5+70	19+65	3.0' 5'
20+45	45+50	3.0' 5'
47+85	97+00	3.0' 5'
97+00	107+00	3.0' 5'
<u>RIGHT SIDE</u>		
5+70	7+00	3.5'
7+00	11+40	3.0' 5'
11+40	19+65	3.5'
20+45	45+00	3.5'
47+35	56+50	3.5'
56+50	66+00	3.0' 5'
66+00	107+00	3.5'

STATE OF HAWAII

DEPARTMENT OF TRANSPORTATION

LAND TRANSPORTATION FACILITIES DIVISION

SHOULDER IMPROVEMENTS

KAWAIHAE TOWARDS HAPUNA

PROJECT No. 19C-01-78

SOUTH KOHALA, HAWAII

Scale: As Noted

Date: Jan. 1978

SHEET No. 1 OF 2 SHEETS

ORIGINAL PLAN	SURVEY PLOTTED BY	DATE
NOTE BOOK	DRAWN BY	
	DESIGNED BY	
	CHECKED BY	

FED. ROAD DIST. NO.	STATE	PROJ. NO.	FISCAL YEAR	SHEET NO.	TOTAL SHEETS
HAWAII	HAW.	19C-01-78	1978	5	9

BEG. PROJ. NO. 19C-01-78
STA. 5+70
(Mile Post Distance 67.02)

→ To Maimea
Road

P.C. Sta. 7+00

Existing Metal Guard Rail w/ Posts

10

± Mon.

P.T. Sta. 15+00

TRUE NORTH
Scale: 1" = 100'

Sta. 19+70
EXCEPTION
(No Work)
Left & Right
Sta. 20+55

R/W Line

30

± Mon.

MATCH LINE
STA. 34+00

MATCH LINE
STA. 34+00

← To Kawaihae

P.C. Sta. 35+79.80

40

24'

± Mon.

45

EXCEPTION
(No Work)
Left & Right

Sta. 45+55

Sta. 47+90

50

24'

TRUE NORTH
Scale: 1" = 100'

55

± Mon.

R/W Line

60

± Mon.

To Hapuna

MATCH LINE
STA. 63+00

MATCH LINE
STA. 63+00

← To Kawaihae

Mauna Kea Beach Hotel Entrance

24'

40'

70

R/W Line

± Mon.

75

80

40'

R/W Line

85

± Mon.

90

To Hapuna

MATCH LINE
STA. 93+00

MATCH LINE
STA. 93+00

← To Kawaihae

R/W Line

95

40'

± Mon.

Existing Metal Guard Rail w/ Posts

100

105

END PROJ. NO. 19C-01-78
STA. 107+00
(Mile Post Distance 68.94)

TRUE NORTH
Scale: 1" = 100'

To Kailua

STATE OF HAWAII
DEPARTMENT OF TRANSPORTATION
LAND TRANSPORTATION FACILITIES DIVISION

SHOULDER IMPROVEMENTS
KAWAIHAE TOWARDS HAPUNA
PROJECT No. 19C-01-78
SOUTH KOHALA, HAWAII

Scale: As Noted Date: Jan. 1978

SHEET No. 2 OF 2 SHEETS

ORIGINAL PLAN	SURVEY PLOTTED BY	DATE
NOTE BOOK	DRAWN BY	
No.	DESIGNED BY	
	QUANTITIES BY	
	CHECKED BY	