
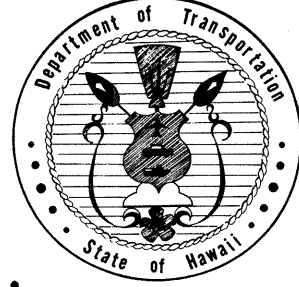


INDEX TO DRAWINGS	
SHEET NO.	DESCRIPTION
1	TITLE SHEET
2-3	PROJ. NO. 19F-02-78
4-5	PROJ. NO. 19C-01-78
6-8	PROJ. NO. 11G-01-78
9	STANDARD DETAILS

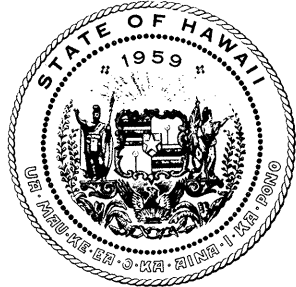

FED. ROAD DIST. NO.	STATE	PROJ. NO.	FISCAL YEAR	SHEET NO.	TOTAL SHEETS
HAWAII	HAW.	19F-02-78 19C-01-78 11G-01-78	1978	1	9

STATE OF HAWAII
DEPARTMENT OF TRANSPORTATION
LAND TRANSPORTATION FACILITIES DIVISION

PLANS FOR


STABILIZATION OF SHOULDERS AT VARIOUS LOCATIONS ON THE ISLAND OF HAWAII

"AS BUILT"

GENERAL LOCATION
19C-01-78

GENERAL LOCATION
19F-02-78

GENERAL LOCATION
11G-01-78

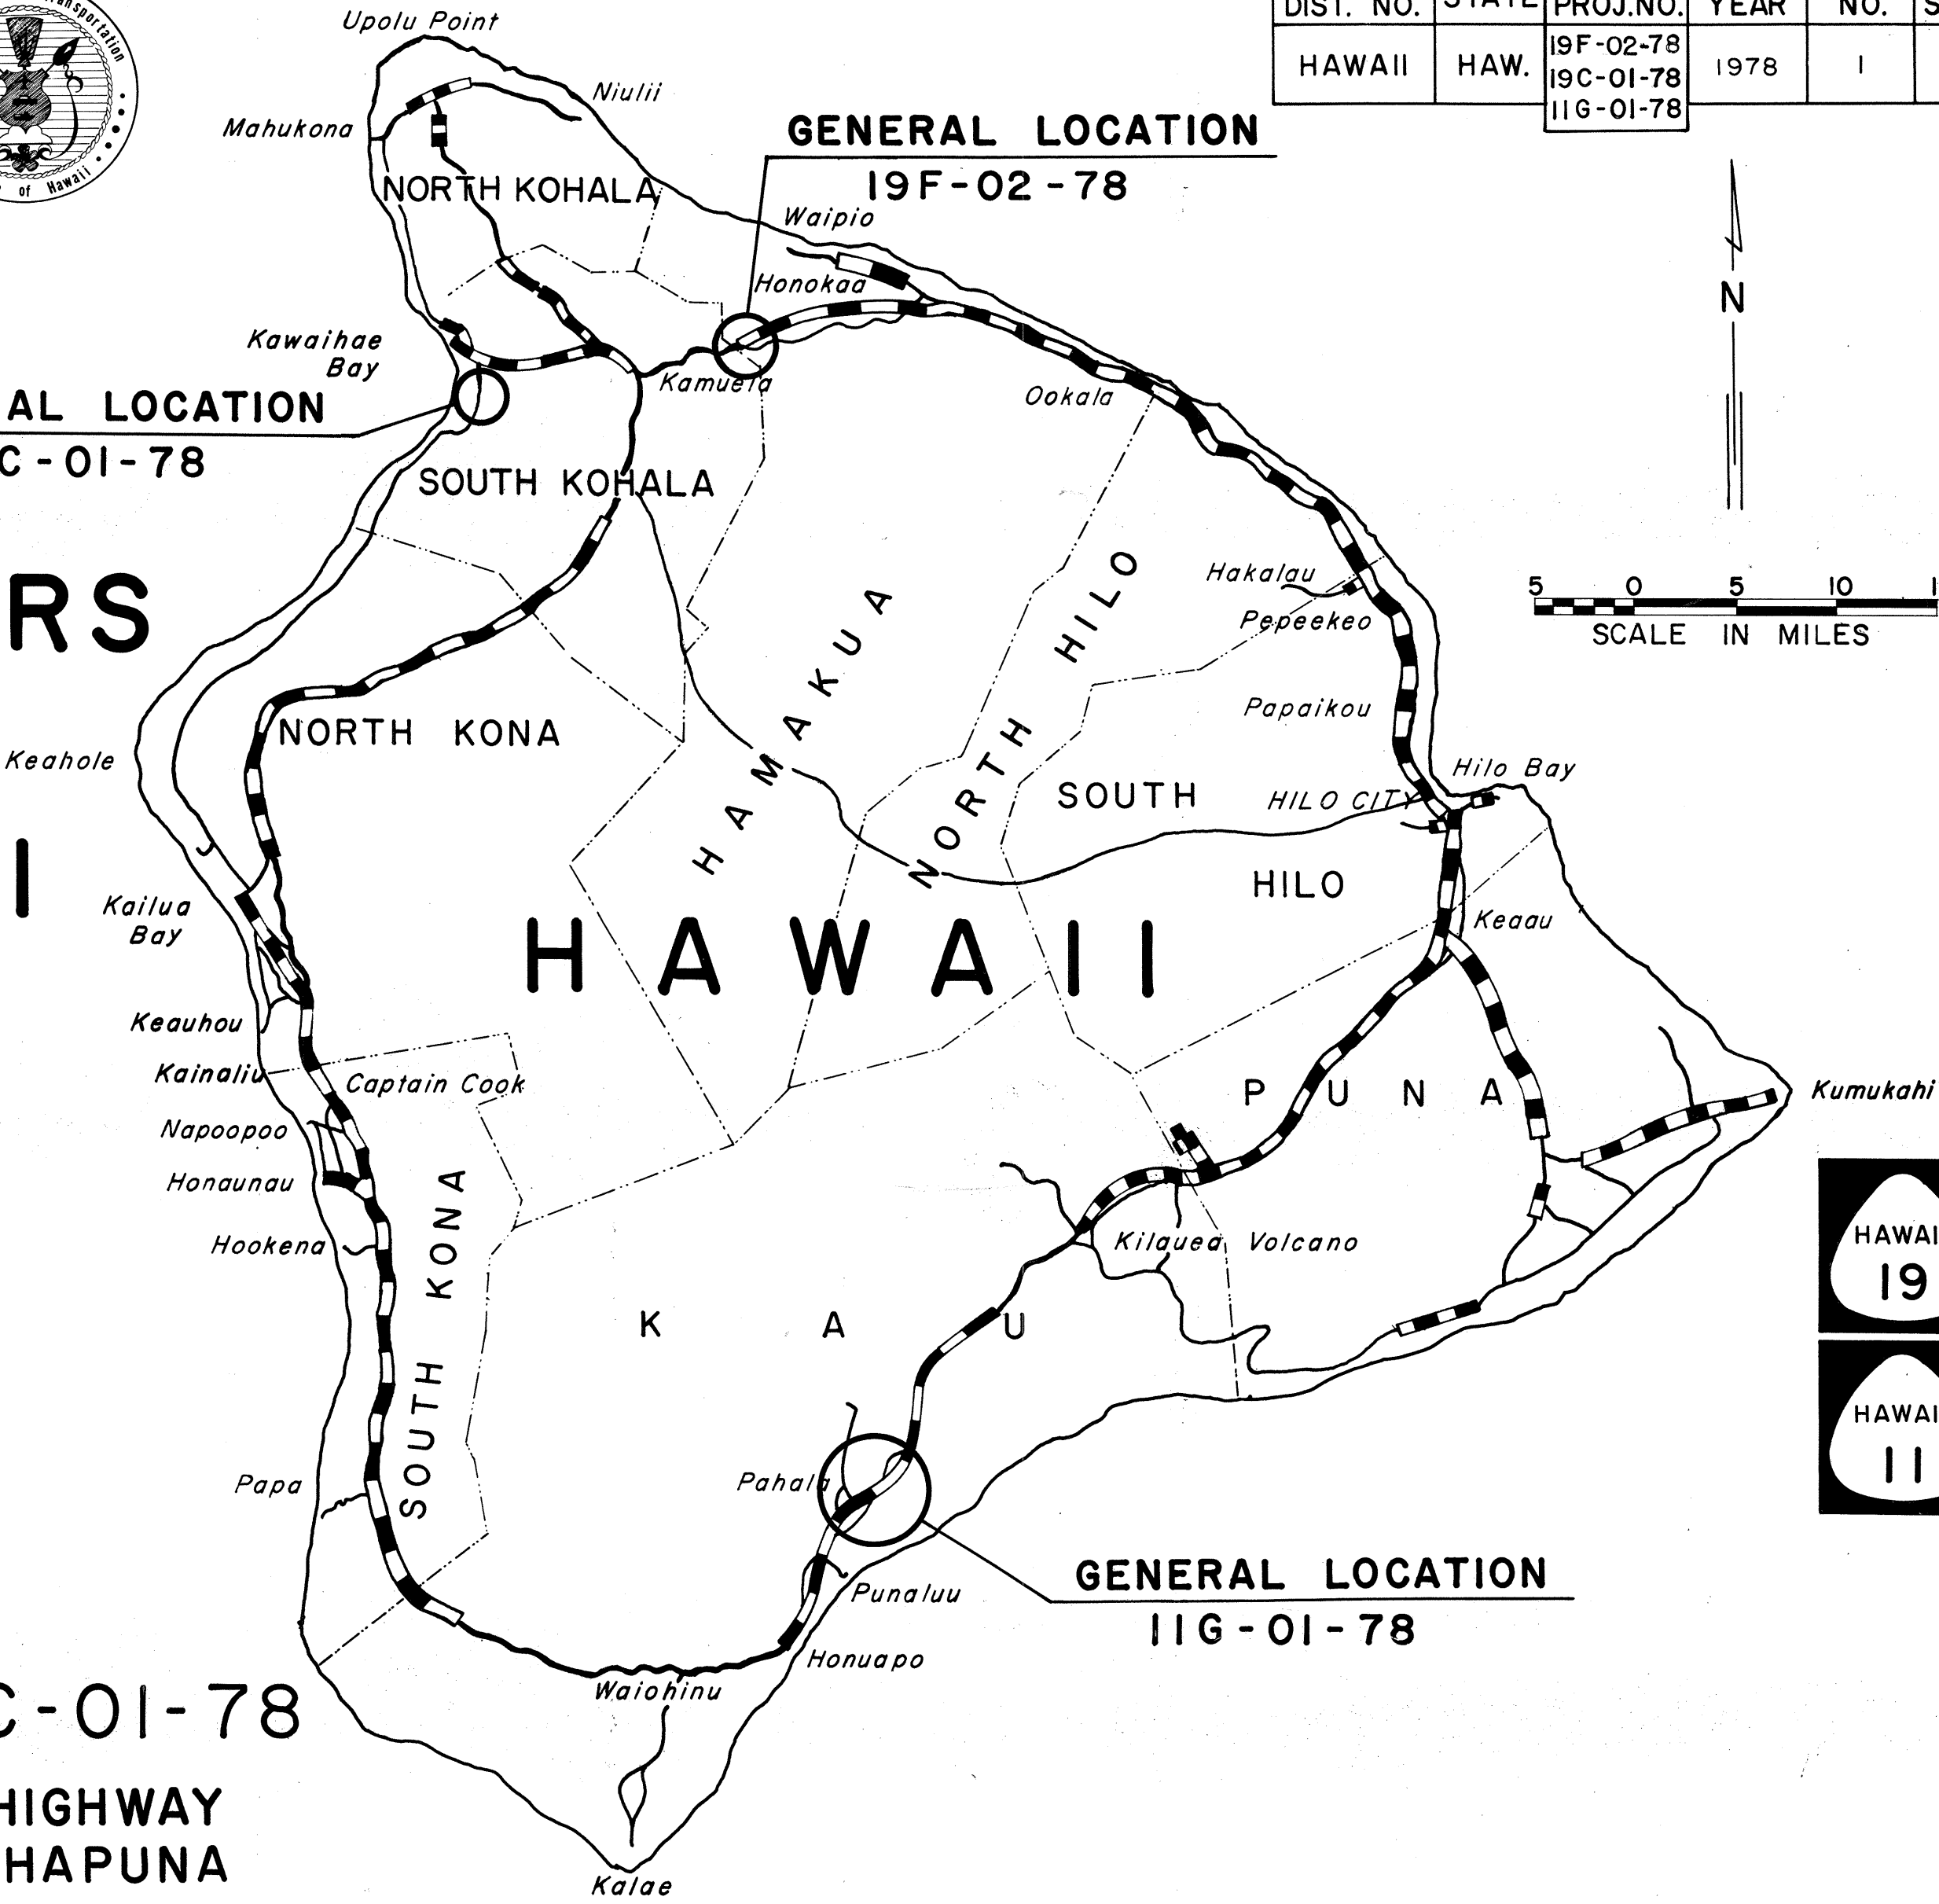

PROJECT NO. 19F-02-78
HAWAII BELT ROAD
MUD LANE TOWARDS HONOKAA
DISTRICTS OF HAMAKUA & SOUTH KOHALA

PROJECT NO. 19C-01-78
QUEEN KAAHUMANU HIGHWAY
KAWAIHAE TOWARDS HAPUNA
DISTRICT OF SOUTH KOHALA

PROJECT NO. 11G-01-78
HAWAII BELT ROAD
HAWAII VOLCANOES NATIONAL PARK
TOWARDS PAHALA
DISTRICT OF KAU

Federal Aid Projects Previously Constructed Or Under Construction

NOTE:
ALL CHANGES MADE DURING CONSTRUCTION HAVE
BEEN INCORPORATED ON THESE PLANS IN RED
EXCEPT CHANGES IN THE ORIGINAL THEORETICAL
QUANTITIES.

[Signature]
PROJECT ENGINEER

Sept. 18, 1978
DATE

DEPARTMENT OF TRANSPORTATION STATE OF HAWAII	
APPROVED:	
<i>[Signature]</i> DIR. OF TRANSPORTATION	5/1/78 DATE

HAWAII DISTRICT
DESIGNED BY

R. MIKAMI
P. S. & E. BY

548-7634
PHONE

MAY 1, 1978
DATE