
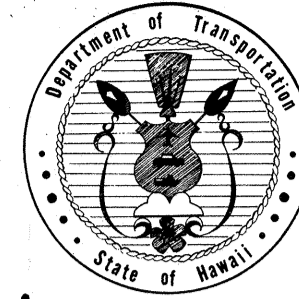


INDEX TO DRAWINGS	
SHEET NO.	DESCRIPTION
1	TITLE SHEET
2	GENERAL LOCATION PLAN
3	TYPICAL SECTIONS & DETAILS
4 - 9	ROADWAY PLANS
10	STANDARD DETAIL

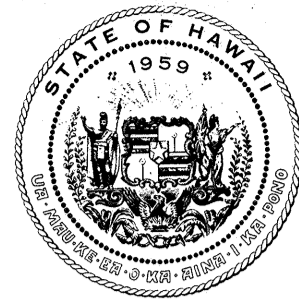

FED. ROAD DIST. NO.	STATE	PROJ. NO.	FISCAL YEAR	SHEET NO.	TOTAL SHEETS
HAWAII	HAW.	11KL-01-78M 19GHJ-01-78M PMS-0100(II)	1978	1	10

STATE OF HAWAII
DEPARTMENT OF TRANSPORTATION
LAND TRANSPORTATION FACILITIES DIVISION

PLANS FOR
RESURFACING AND REHABILITATION PROGRAM
OF HIGHWAYS AT VARIOUS LOCATIONS
ON THE ISLAND OF HAWAII

HAWAII BELT ROAD
HAWAII NATIONAL PARK BY-PASS ROAD
PROJECT NO. 11KL-01-78M
DISTRICT OF KAU

HAWAII BELT ROAD
PROJECT NO. 19GHJ-01-78M


SECTION I
KAPEU BRIDGE TO KALAOA BRIDGE
DISTRICT OF SOUTH HILO

SECTION II
PAAUILO TO KUKAIAU
DISTRICT OF HAMAKUA

SECTION III
KAAWALII GULCH TO WAIPUNALEI
DISTRICT OF NORTH HILO

SECTION IV
KUKAIAU BRIDGE TO KEALAKAHA BRIDGE
DISTRICT OF HAMAKUA

REFLECTIVE PAVEMENT MARKING PROGRAM (PHASE IV)
ISLAND OF HAWAII
FEDERAL AID PROJECT NO. PMS-0100(II),
UNIT I AND UNIT II

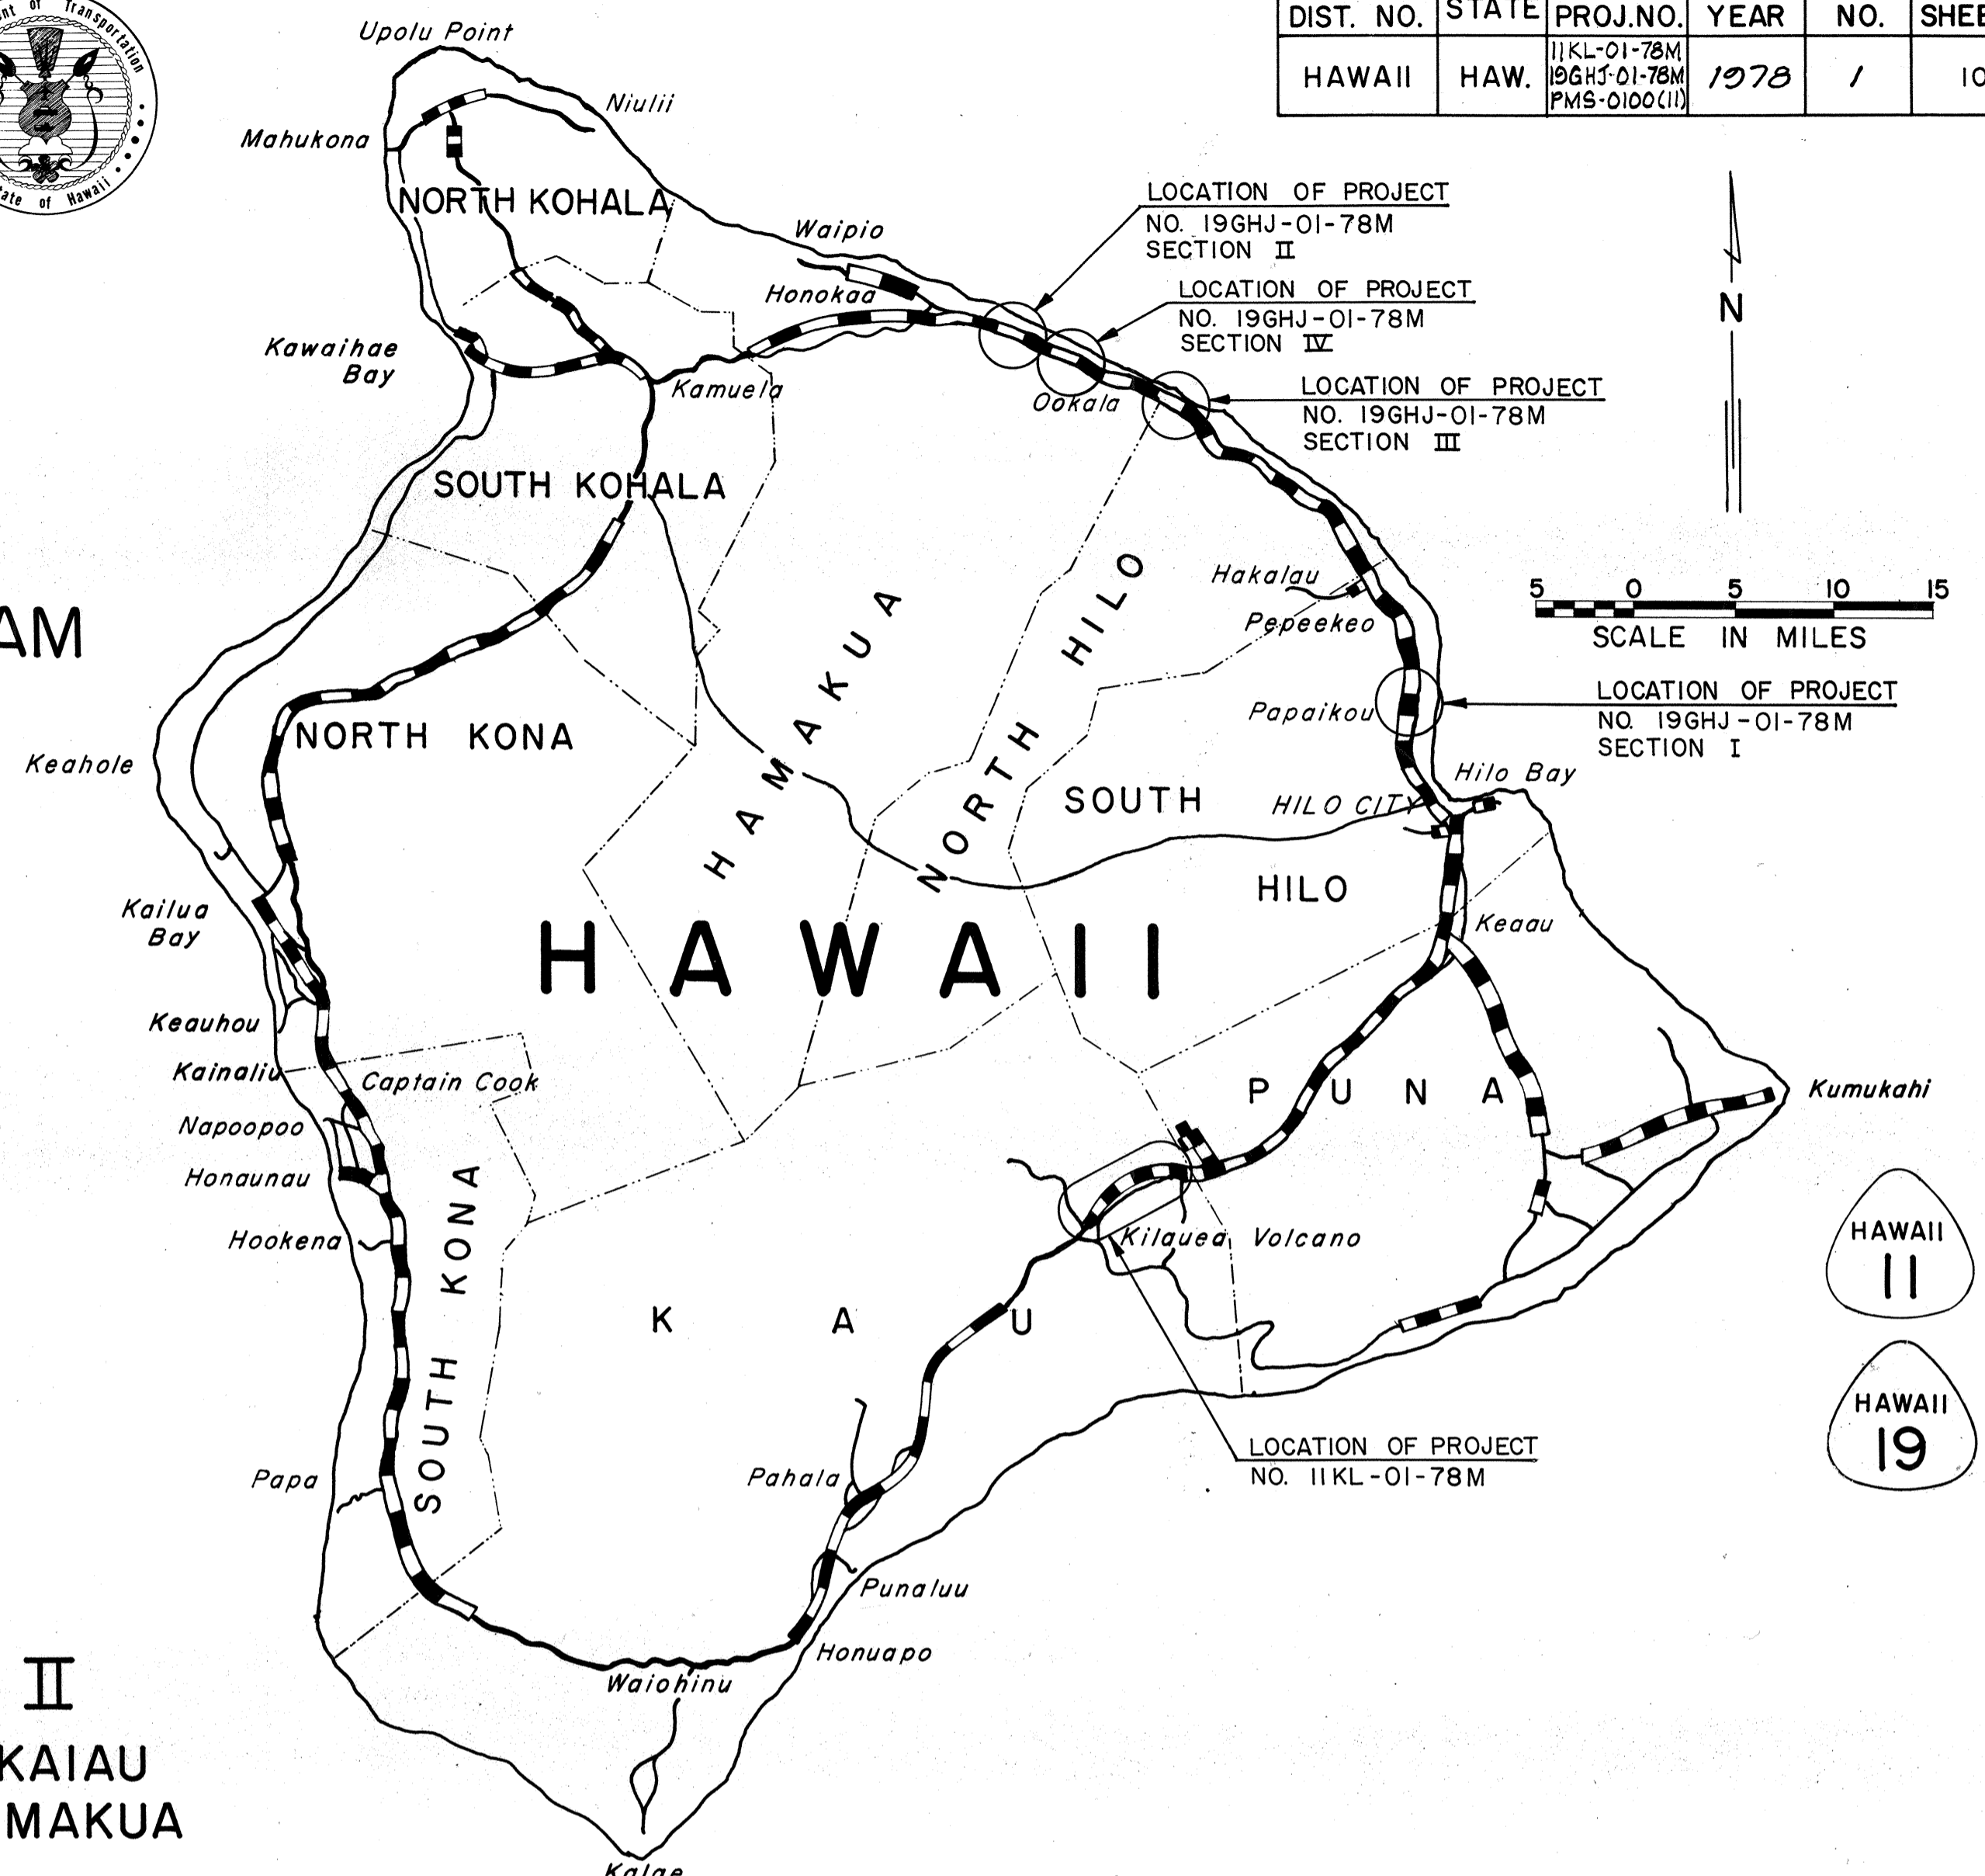

NO AS-BUILT CHANGES MADE
DURING CONSTRUCTION.

August Y. Ono 10-9-80
PROJECT ENGINEER DATE

HAWAII DISTRICT DESIGNED BY R. MIKAMI P.S. & E. BY 548-7534 PHONE 5/11/78 DATE

DEPARTMENT OF TRANSPORTATION
FEDERAL HIGHWAY ADMINISTRATION
APPROVED: *[Signature]* 5/12/78
DIVISION ADMINISTRATOR DATE

DEPARTMENT OF TRANSPORTATION
STATE OF HAWAII
APPROVED: *Robert Higashimura* 5/11/78
DIR. OF TRANSPORTATION DATE