
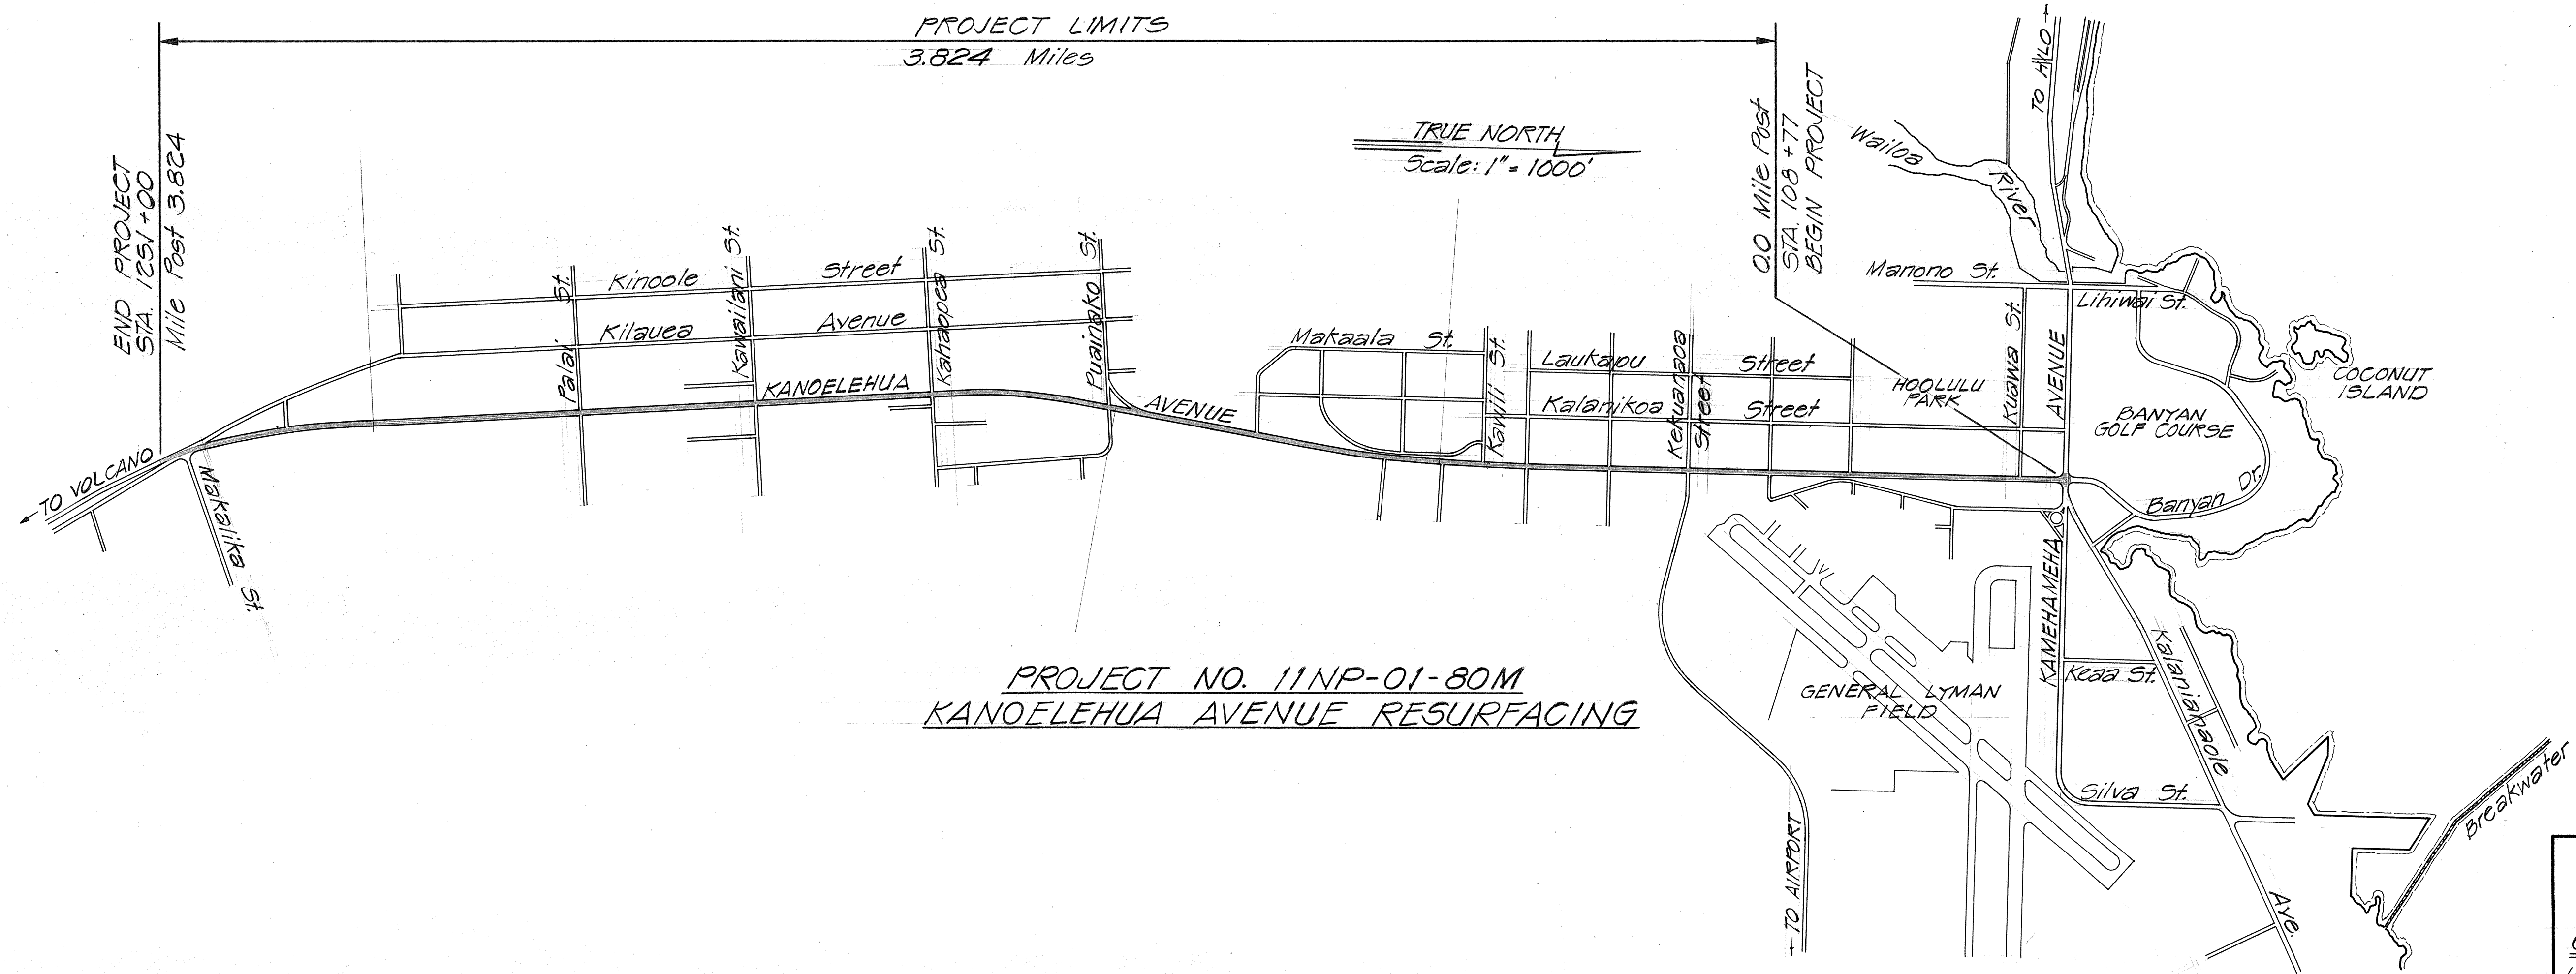


FED. ROAD DIST. NO.	STATE	FED. AID PROJ. NO.	FISCAL YEAR	SHEET NO.	TOTAL SHEETS
HAWAII	HAW.	111H-01-80M 111H-01-80M	1980	2	10

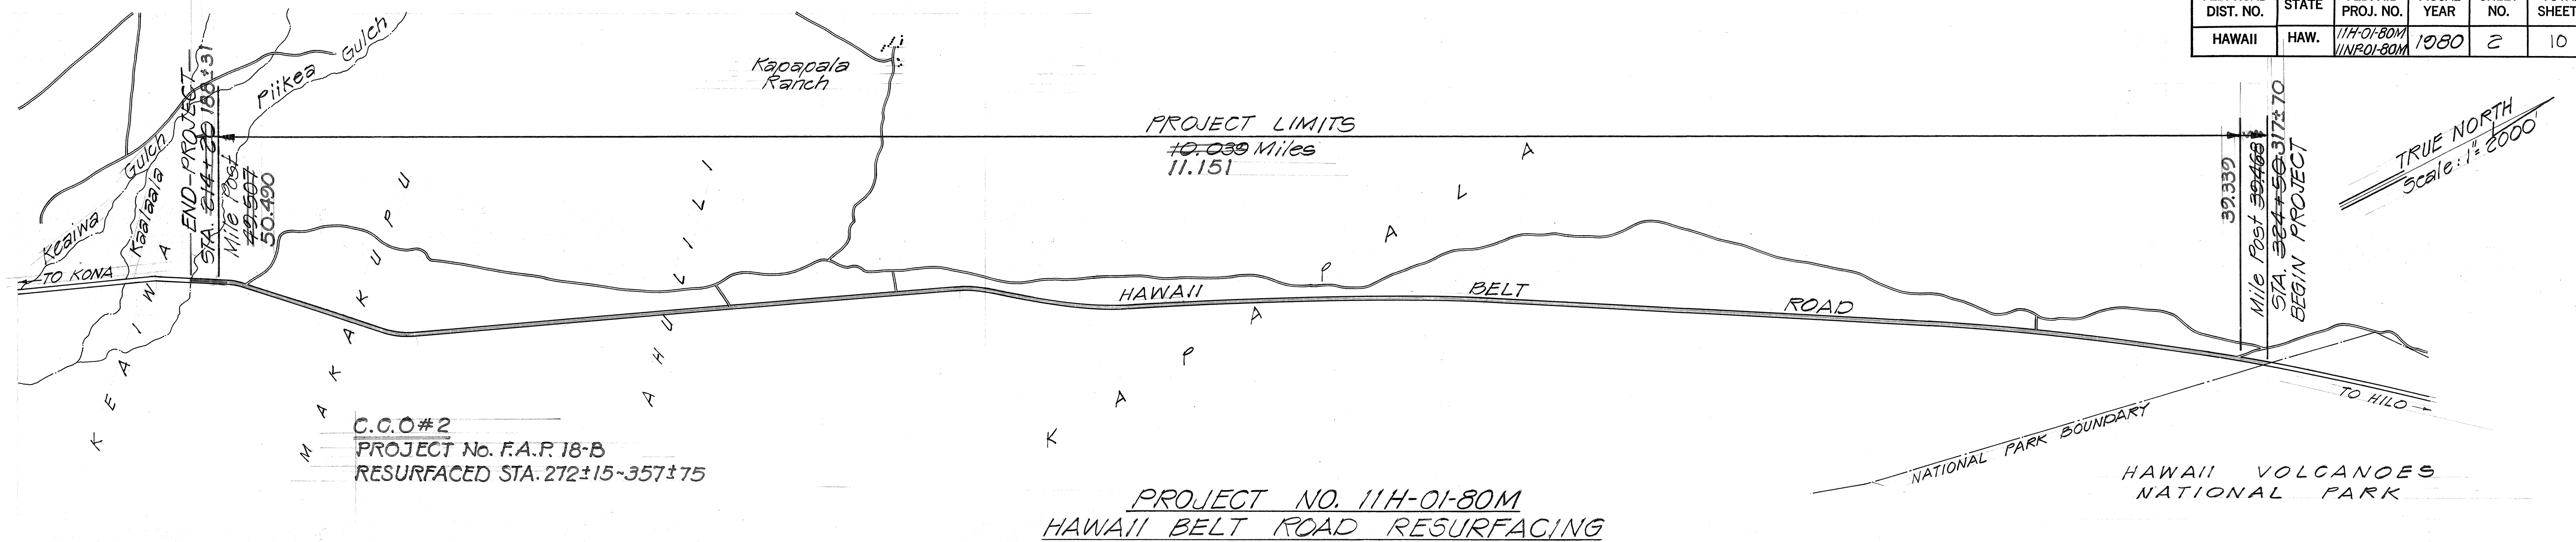

STATE OF HAWAII
DEPARTMENT OF TRANSPORTATION
HIGHWAYS DIVISION

GENERAL LOCATION PLANS


HAWAII BELT ROAD RESURFACING
PROJECT NO. 11H-01-80M

KAOELEHUA AVENUE RESURFACING
PROJECT NO. 11NP-01-80M


Scale: As Noted Date: May 1979

SHEET No. 1 OF 2 SHEETS

FED. ROAD DIST. NO.	STATE	FED. AID PROJ. NO.	FISCAL YEAR	SHEET NO.	TOTAL SHEETS
HAWAII	HAW.	19A-01-80M 11H-01-80M RS-0160(6)	1980	3	10

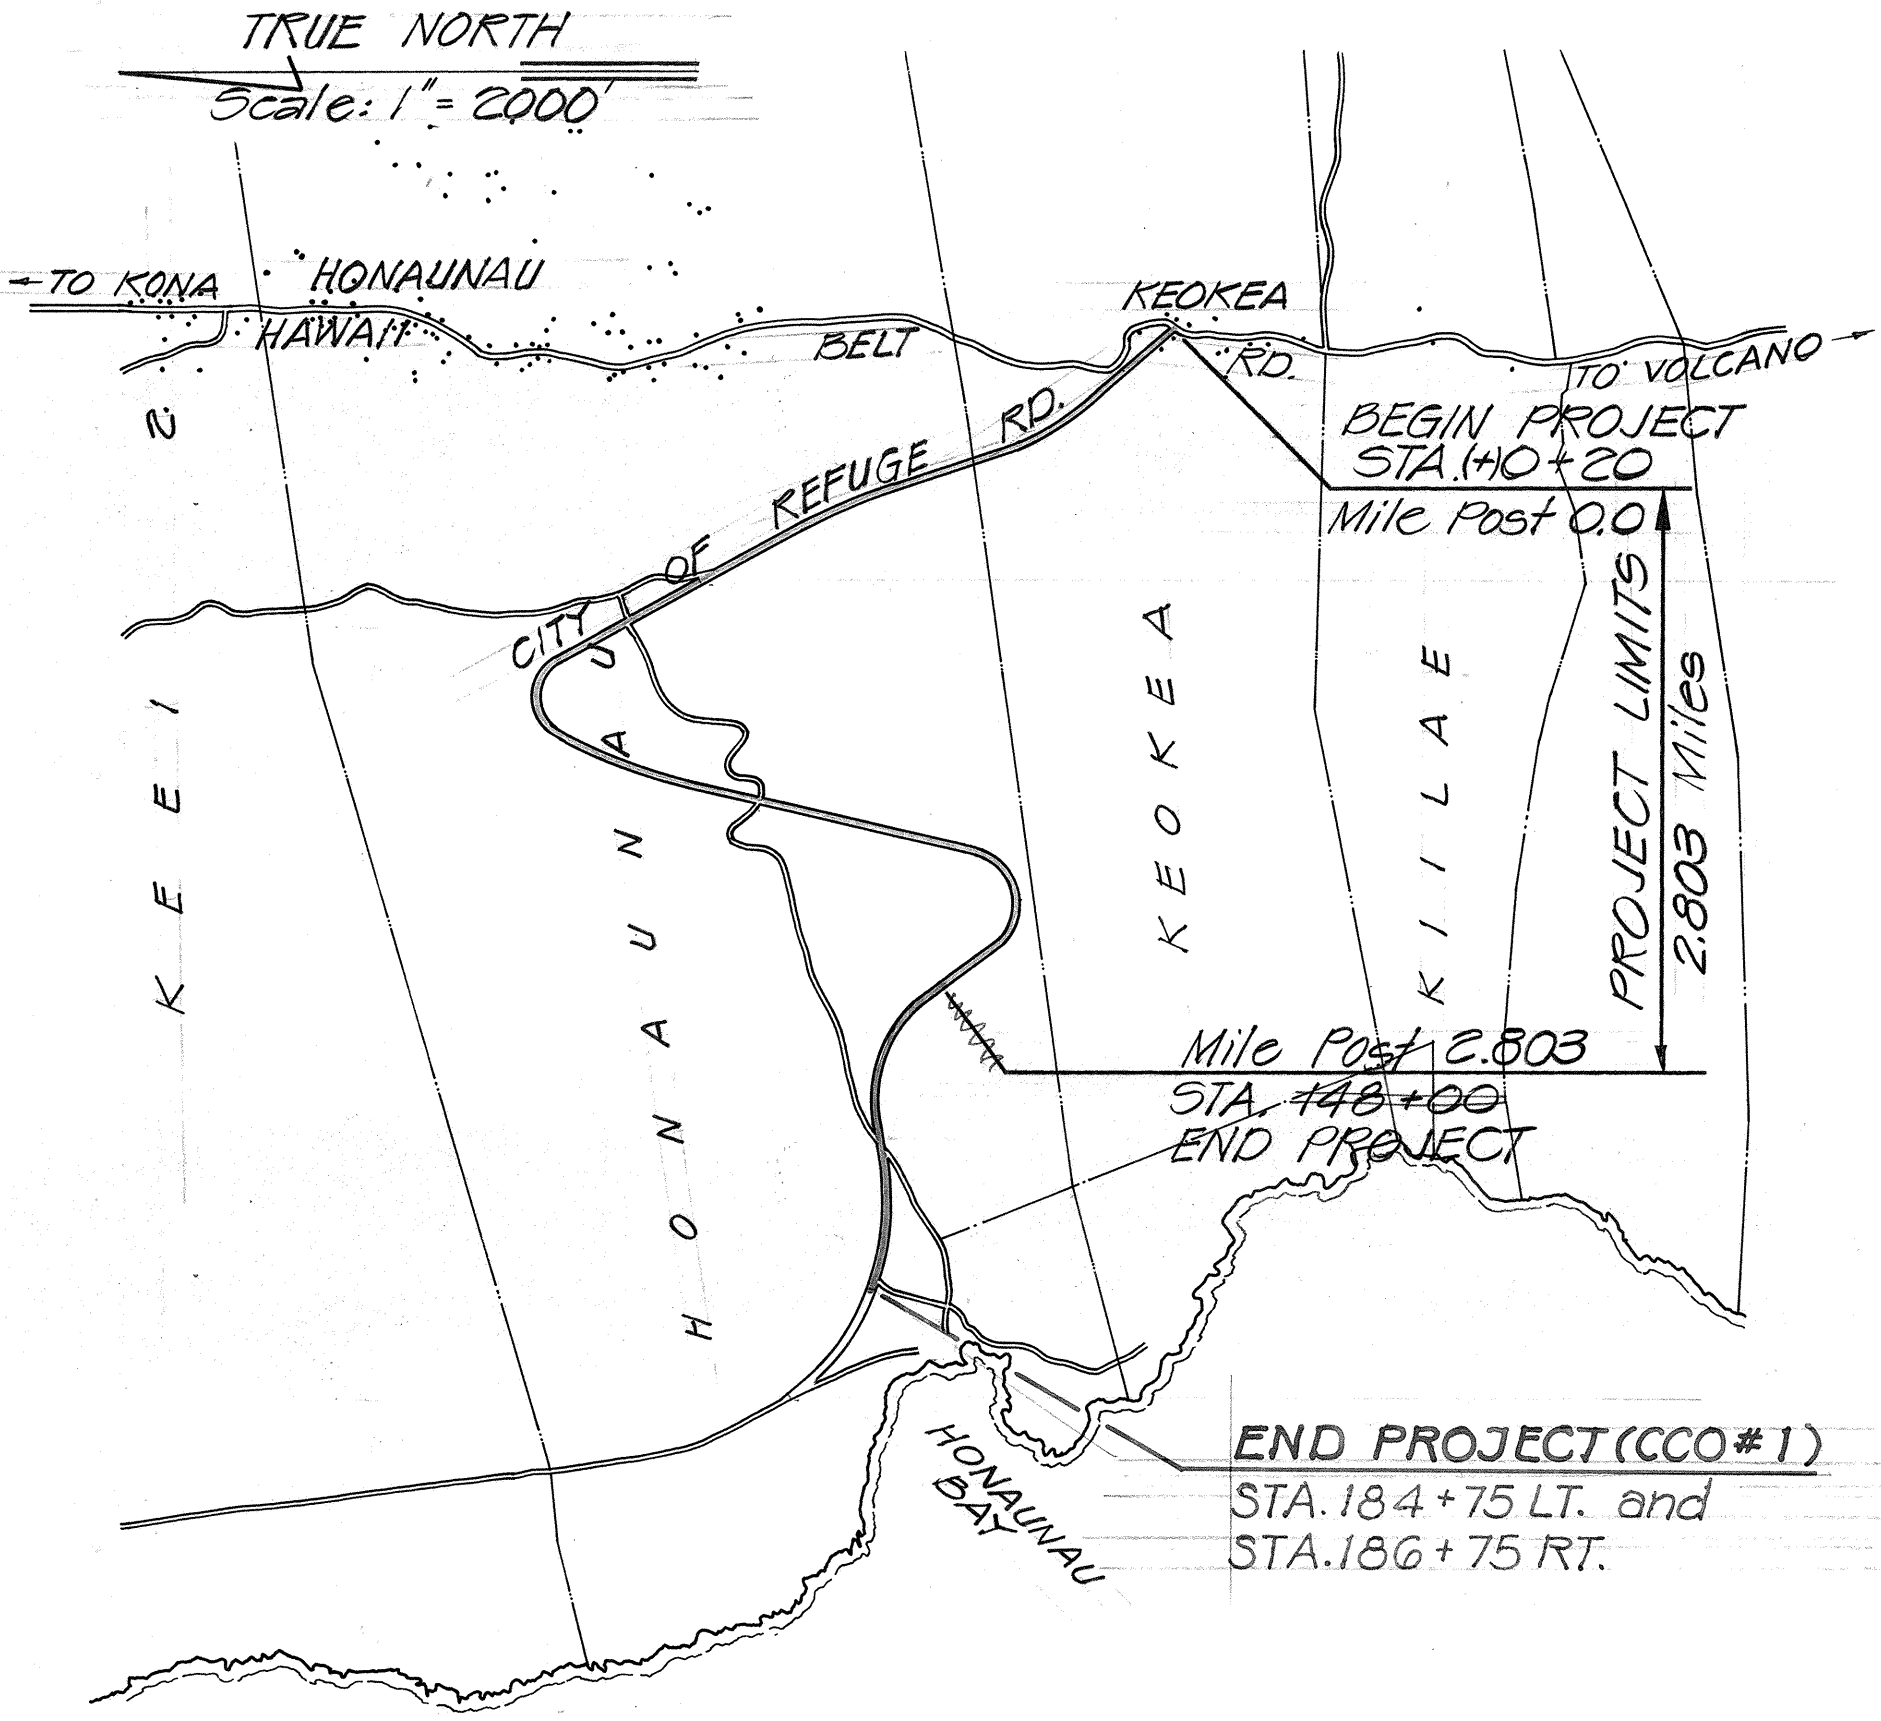

FEDERAL AID SECONDARY PROJECT NO. RS-0160 (6)
CITY OF REFUGE ROAD RESURFACING

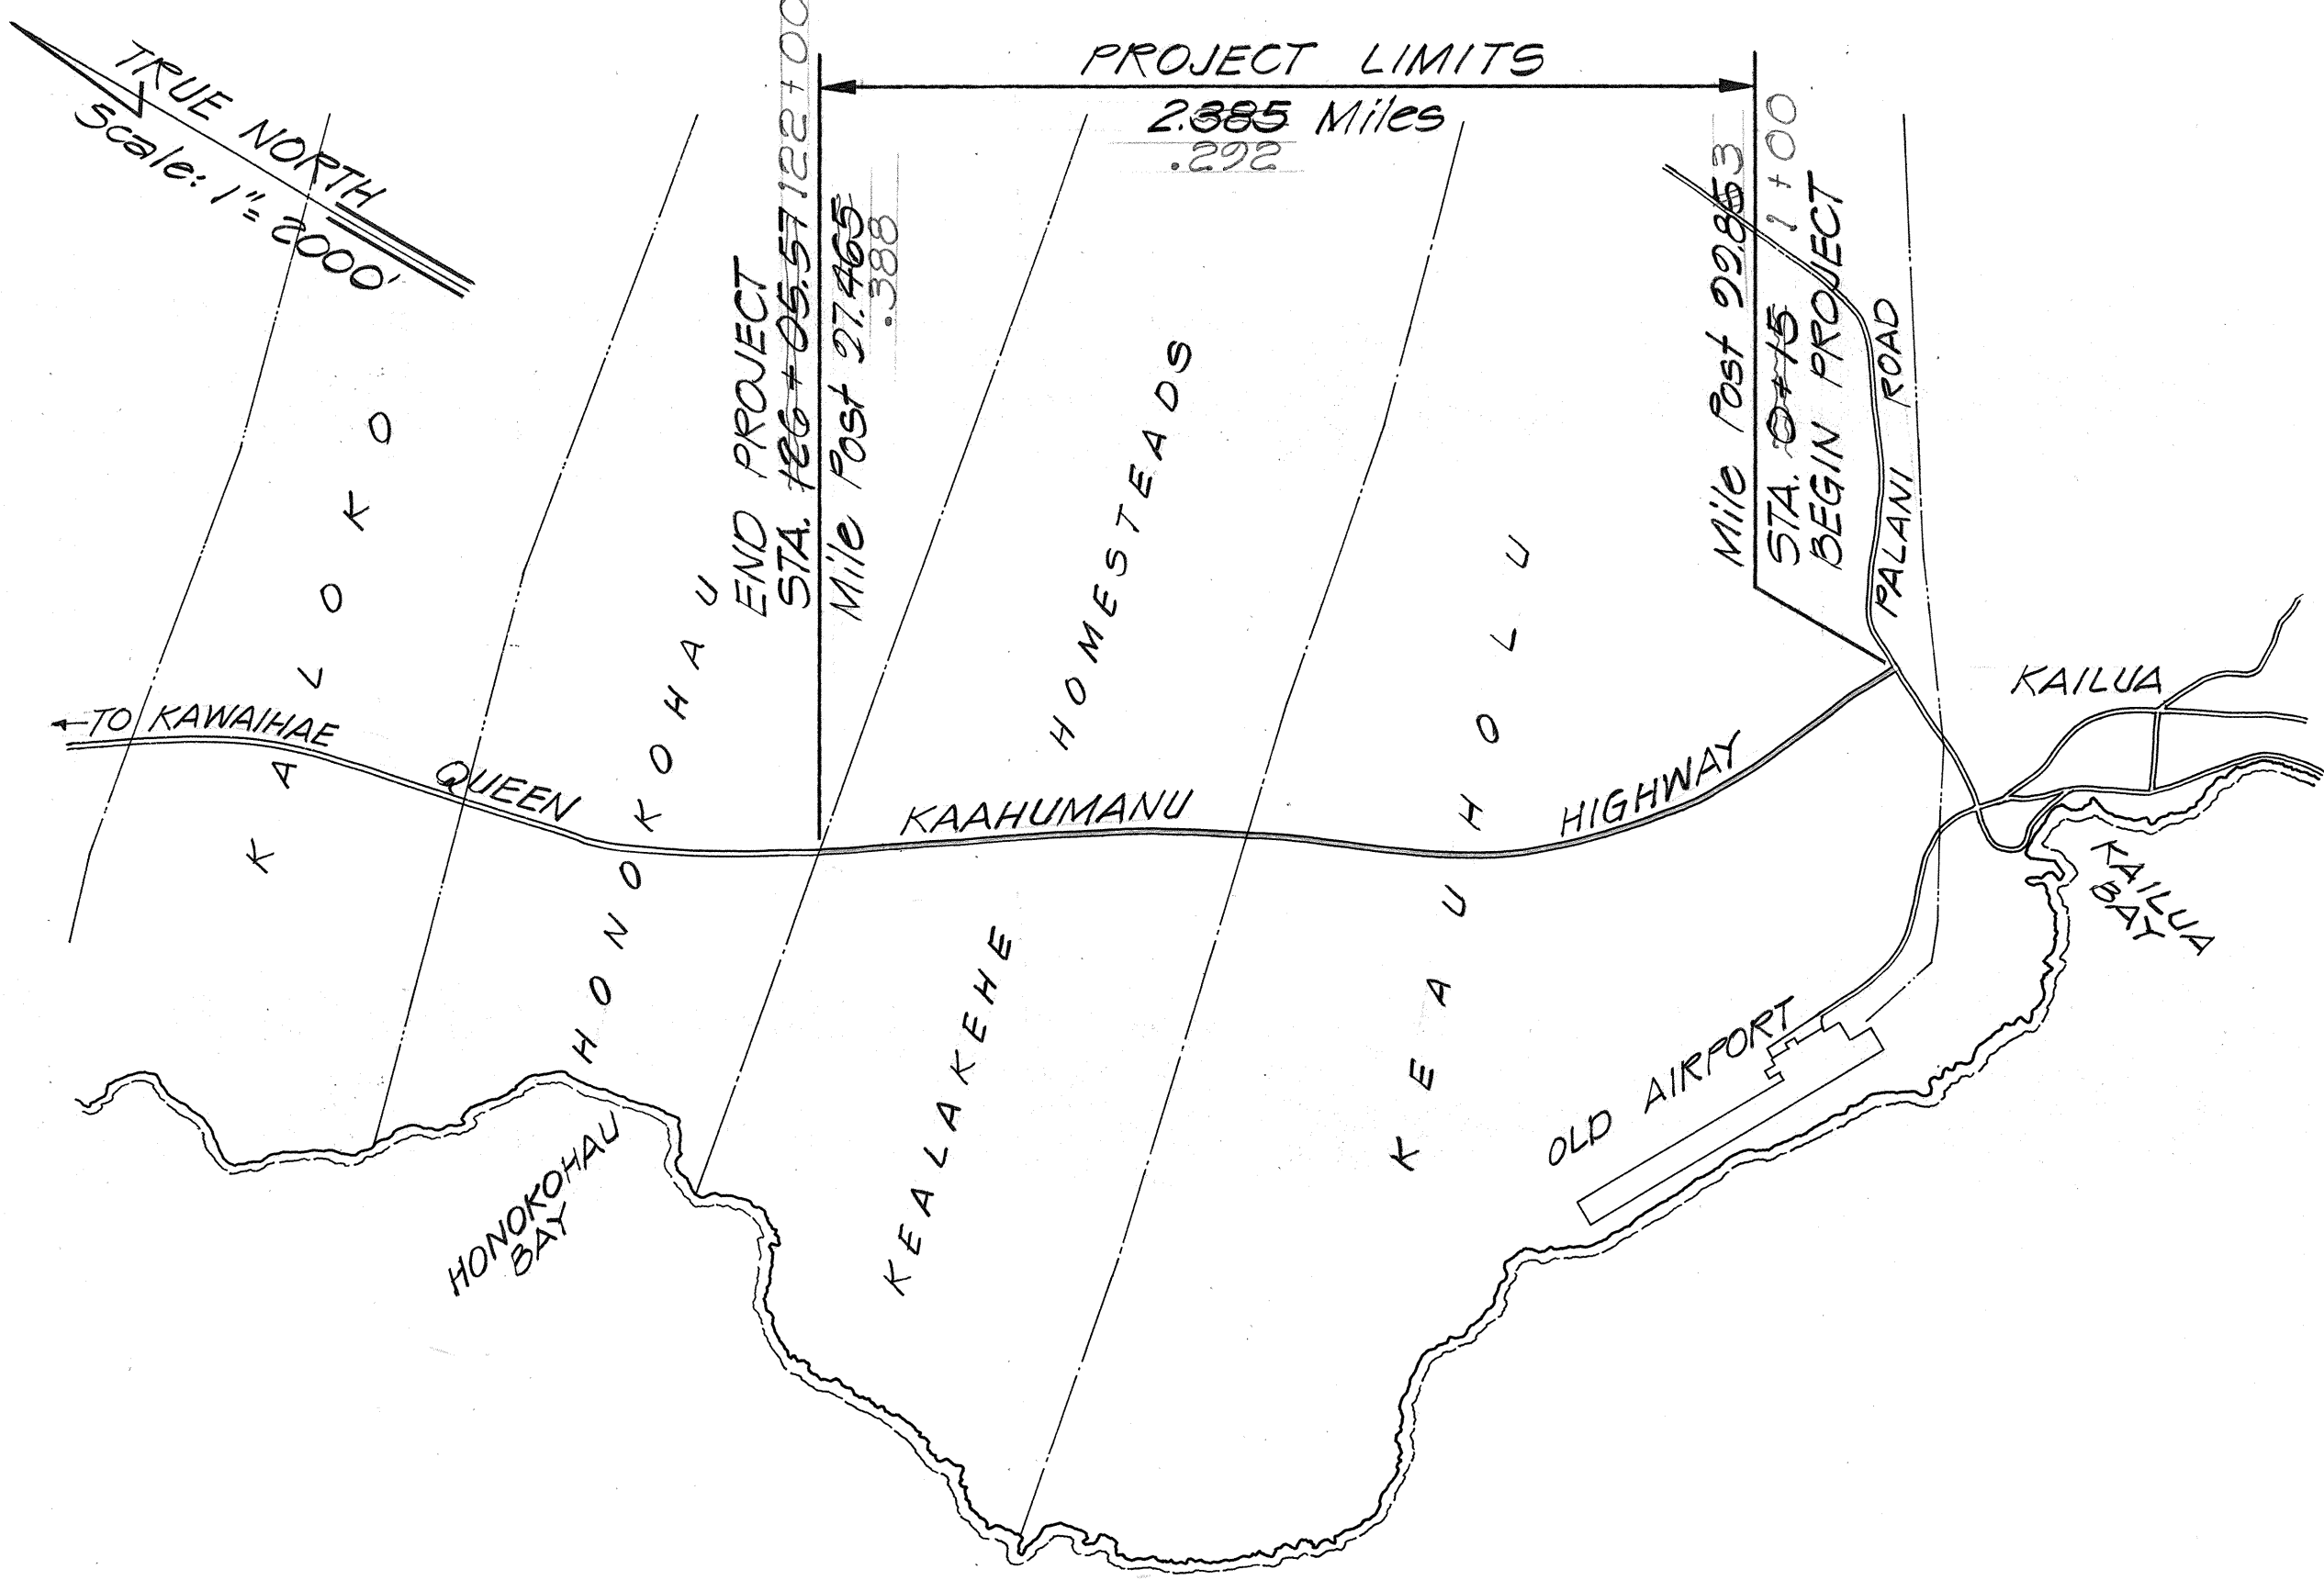

PROJECT NO. 19A-01-80M
QUEEN KAAHUMANU HIGHWAY RESURFACING

E AND REFERENCE SURVEY MON. SCHEDULE (RECOVER)		
11H-01-80M	RS-0160 (6)	19A-01-80M
Nail Only P.O.T. STA. 214+20	P.C. STA. 4+69.93	E MON. STA. 0+00
Nail Only P.T. STA. 206+36.60	P.T. STA. 10+77.71	E MON. STA. 10+00
Nail Only P.C. STA. 198+91.97	P.C. STA. 12+92.04	P.C. STA. 21+13
P.T. STA. 164+77.58	P.T. STA. 15+93.37	P.O.C. STA. 30+00
P.C. STA. 155+72.58	P.C. STA. 20+08.90	P.O.C. STA. 40+00
P.O.T. STA. 148+00	P.T. STA. 28+12.85	P.O.C. STA. 50+00
P.O.T. STA. 80+00	P.C. STA. 30+34.59	P.T. STA. 55+95.01
P.T. STA. 20+06.30	P.T. STA. 35+26.02	P.O.T. STA. 67+00
P.O.C. STA. 0+00	P.C. STA. 51+73.31	P.C. STA. 77+50.12
P.T. STA. 8+11.20	E MON. STA. 53+50	P.T. STA. 84+26.44
P.C. STA. 10+40.70	P.T. STA. 58+26.64	P.O.T. STA. 95+00
P.T. STA. 38+63.56	T.S. STA. 73+04	P.O.T. STA. 105+00
P.C. STA. 60+78.79	S.C. STA. 75+04	P.O.T. STA. 115+00
P.C. STA. 141+78.79	C.S. STA. 82+53.49	P.O.T. STA. 126+05.57
P.O.T. STA. 148+00	S.T. STA. 84+53.49	P.O.T. STA. 121+50
P.C. STA. 236+67.98	P.C. STA. 87+83.90	
P.T. STA. 314+07.98	P.T. STA. 98+97.23	
E MON. STA. 324+50	T.S. STA. 127+77.91	
STA. 129+57	S.C. STA. 129+77.91	
STA. 34+27	C.S. STA. 140+86.28	
STA. 62+82	S.T. STA. 142+86.25	
(CCO#2) P.T. STA. 312+91.53	(CCO#1) T.S. STA. 145+139.12	
	(CCO#1) S.C. STA. 149+89.12	
(CCO#2) P.C. STA. 298+32.61	(CCO#1) P.C. STA. 0+00	
	(CCO#1) E MON. STA. 12+50	
TOTAL = 18 EA. 17	TOTAL = 21 EA. 24	TOTAL = 14 EA. 13

STATE OF HAWAII
DEPARTMENT OF TRANSPORTATION
HIGHWAYS DIVISION

GENERAL LOCATION PLANS
AND MONUMENTS SCHEDULE
PROJECT NOS. 19A-01-80M
11H-01-80M
11H-01-80M
RS-0160(6)
Scale: As Noted Date: May 1979

SHEET No. 2 OF 2 SHEETS

ORIGINAL PLAN	SURVEY PLOTTED BY	DATE
NOTE BOOK	DRAWN BY	
	DESIGNED BY	
	CHECKED BY	
No.		